


EROSION AND SEDIMENT CONTROL PLAN

EASTERN PANHANDLE EXPANSION PROJECT

WASHINGTON COUNTY, MARYLAND

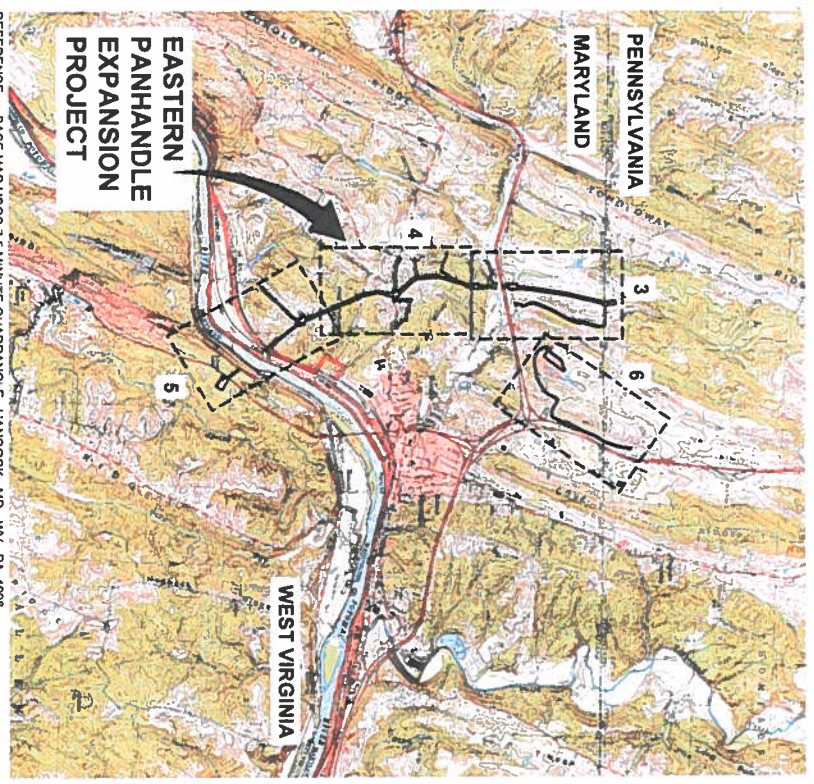

**COLUMBIA GAS TRANSMISSION, LLC.,
 A TRANSCANADA COMPANY
 HOUSTON, TEXAS**

MARCH 2017
 REVISED SEPTEMBER 2017

PLANS APPROVED BY: *[Signature]*
 DATE: _____
 WATER AND SCIENCE ADMINISTRATION
 MARYLAND DEPARTMENT OF THE ENVIRONMENT



ARCADIS U.S., INC.



KEY CONTACTS:
 OWNER:
 COLUMBIA GAS TRANSMISSION, LLC. A TRANSCANADA COMPANY
 5151 SAN FELIPE, SUITE 2400
 HOUSTON, TX 77056
 TELEPHONE: 713.386.3302
 CONTACT: CLIFFORD ABBOTT
 ENGINEERING FIRM:
 ARCADIS U.S., INC.
 6041 WALLACE ROAD EXTENSION, SUITE 300
 WEXFORD, PA 15090
 TELEPHONE: 724.934.9562
 CONTACT: ALLEN LONG, P.E.
 MARYLAND ONE-CALL
 TELEPHONE: 811 OR 1 800 257 7777

INDEX TO DRAWINGS

- 1. COVER SHEET
- 2. GENERAL NOTES
- 3. GENERAL NOTES AND LEGEND
- 4. OVERALL SITE PLAN (STA. 0+00 TO 59+00)
- 5. OVERALL SITE PLAN (STA. 59+00 TO 126+00)
- 6. OVERALL SITE PLAN (CONTRACTOR STAGING AREA AND TEMPORARY ACCESS ROAD TAR-1)
- 7. SITE PLAN (STA. 0+00 TO 6+50)
- 8. SITE PLAN (6+50 TO 16+00)
- 9. SITE PLAN (16+00 TO 25+50)
- 10. SITE PLAN (25+50 TO 34+50)
- 11. SITE PLAN (34+50 TO 44+00)
- 12. SITE PLAN (44+00 TO 53+50)
- 13. SITE PLAN (53+50 TO 69+00)
- 14. SITE PLAN (69+00 TO 78+00)
- 15. SITE PLAN (78+00 TO 88+00)
- 16. SITE PLAN (88+00 TO 94+00)
- 17. SITE PLAN (CATHODIC PROTECTION ANODE GROUNDED AT STA. 94+25)
- 18. SITE PLAN (CATHODIC PROTECTION ANODE GROUNDED AT STA. 94+00)
- 19. SITE PLAN (94+00 TO 105+00)
- 20. SITE PLAN (105+00 TO 120+50)
- 21. SITE PLAN (120+50 TO 136+00)
- 22. SITE PLAN (136+00 TO 151+50)
- 23. SITE PLAN (CATHODIC PROTECTION ANODE GROUNDED AT STA. 136+00)
- 24. SITE PLAN (151+50 TO 167+00)
- 25. SITE PLAN (167+00 TO 177+74)
- 26. SITE PLAN (CONTRACTOR STAGING AREA AND TEMPORARY ACCESS ROAD TAR-1)
- 27. SITE PLAN (TEMPORARY ACCESS ROAD TAR-1)
- 28. SITE PLAN (TEMPORARY ACCESS ROAD TAR-1)
- 29. SITE PLAN (TEMPORARY ACCESS ROAD TAR-1)
- 30. PROPOSED STREAMS S1, S1E AND S86 CULVERT REPLACEMENTS PLANS AND PROFILES
- 31. PROPOSED STREAM CROSSINGS S6 AND S13 PLANS AND PROFILES
- 32. PROPOSED STREAM CROSSING S4 AND WETLAND CROSSING W6 PLANS AND PROFILES
- 33. MISCELLANEOUS DETAILS
- 34. MISCELLANEOUS DETAILS
- 35. MISCELLANEOUS DETAILS
- 36. MISCELLANEOUS DETAILS
- 37. MISCELLANEOUS DETAILS

XREFS: CPGL00EP-X00

THIS BAR REPRESENTS ONE ORIGINAL DRAWING		USE TO VERIFY FIGURE REVISION SCALE	
No.	Date	Description	By
1	7/11/17	ISSUE FOR PERMITS	ALS
2	7/11/17	ISSUE FOR PERMITS	ALS
3	7/11/17	ISSUE FOR PERMITS	ALS
4	7/11/17	ISSUE FOR PERMITS	ALS
5	7/11/17	ISSUE FOR PERMITS	ALS
6	7/11/17	ISSUE FOR PERMITS	ALS
7	7/11/17	ISSUE FOR PERMITS	ALS
8	7/11/17	ISSUE FOR PERMITS	ALS
9	7/11/17	ISSUE FOR PERMITS	ALS
10	7/11/17	ISSUE FOR PERMITS	ALS


DESCRIPTION	QUANTITY	UNIT
PROJECT/DISTURBED AREA	53.2	ACRES
PIPELINE LENGTH	16,542	LINEAR FEET
SILT FENCE	9,250	LINEAR FEET
SUPER SILT FENCE	8,840	LINEAR FEET
PLASTIC MESH TREE PROTECTION FENCE	25,000	LINEAR FEET
STABILIZED CONSTRUCTION ENTRANCE (SCE)	12	EACH
SCE WITH WASH RACK	AS REQUIRED FOR SEDIMENT REMOVAL	
STONE PER SCE	15	CUBIC YARDS
GEOTEXTILE UNDERLAYMENT PER SCE	750	SQUARE FEET
INTERCEPTOR DIVERSIONS	55	EACH
TRENCH PLUGS	16	EACH
SOIL STABILIZATION MATTING	125,000	SQUARE FEET
TEMPORARY ACCESS BRIDGE	4	EACH
TIMBER MATS FOR WETLAND CROSSING	60	LINEAR FEET
WEIGHTED SEDIMENT FILTER TUBE	17	LOCATIONS
DAM AND PUMP BYPASS STREAM CROSSING	6	EACH
RIPRAP BASIN ENERGY DISSIPATOR	45	CUBIC YARDS
MOUNTABLE BERMS	7	EACH
HORIZONTAL DIRECTION DRILLING ENTRY/EXIT	2	EACH
TEMPORARY SEEDING (SOIL STOCKPILES)	2.6	ACRES
PERMANENT SEEDING (WETLAND SEED MIX)	0.1	ACRES
PERMANENT SEEDING (RESIDENTIAL AREAS)	1.7	ACRES
PERMANENT SEEDING (UTILITY RIGHT-OF-WAY)	51.4	ACRES

EAS CONTROL MEASURE	INSPECTION REQUIREMENT	MAINTENANCE/REPAIR REQUIREMENT
STABILIZED CONSTRUCTION ENTRANCE	CONTINUOUSLY DURING WORK DAY AND THE NEXT DAY AFTER EACH RAIN EVENT	CONSTANTLY MAINTAIN IN A CONDITION THAT MINIMIZES TRACKING OF SEDIMENT BY ADDING STONE OR MAKING OTHER REPAIRS AS CONDITIONS DEMAND TO MAINTAIN A CLEAN SURFACE. THE MOUNTABLE BERM, ADJACENT ROADWAY MUST BE REMOVED IMMEDIATELY BY VACUUMING, SCRAPING, AND/OR SWEEPING. WASHING THE ROADWAY TO REMOVE SEDIMENT TRACKED ONTO PAVEMENT IS NOT ACCEPTABLE. INSTALL WITH WASH RACKS AS NEEDED.
ADEQUATE VEGETATIVE STABILIZATION	WEEKLY AND THE NEXT DAY AFTER EACH RAIN EVENT	ADEQUATE VEGETATIVE STABILIZATION REQUIRES 95% GROUND COVER. IF AN AREA HAS LESS THAN 40% GROUND COVER, RESTORABLE FOLLOWING THE PREVIOUS RECOMMENDATIONS FOR THE FERTILIZER, SEEDBED PREPARATION, AND SEEDING. IF AN AREA HAS 40% TO 94% GROUND COVER, OVER-SEED AND FERTILIZE USING HALF OF THE RATES ORIGINALLY SPECIFIED. ESTABLISH AND MAINTAIN VEGETATIVE STABILIZATION SO THAT ADEQUATE VEGETATIVE STABILIZATION (95% GROUND COVER) IS CONTINUOUSLY MET.
SOIL STABILIZATION MATTING	WEEKLY AND THE NEXT DAY AFTER EACH RAIN EVENT	REMOVE ACCUMULATED SEDIMENT AND DEBRIS WHEN BULGES DEVELOP IN THE SILT FENCE OR WHEN UNDERMINING OCCURS.
SILT FENCE	WEEKLY AND THE NEXT DAY AFTER EACH RAIN EVENT	REPLACE CLOGGED FILTER BAGS. REPLACE THE FILTER BAG IF THE BAG IS RIPPED, TORN, AND/OR PUNCTURED. KEEP THE CONNECTION BETWEEN THE PUMP HOSE AND FILTER BAG WATER TIGHT DURING OPERATION. REPLACE BEDDING THAT BECOMES DISPLACED.
FILTER BAG	WEEKLY AND THE NEXT DAY AFTER EACH RAIN EVENT	REPLACE CLOGGED FILTER BAGS. REPLACE THE FILTER BAG IF THE BAG IS RIPPED, TORN, AND/OR PUNCTURED. KEEP THE CONNECTION BETWEEN THE PUMP HOSE AND FILTER BAG WATER TIGHT DURING OPERATION. REPLACE BEDDING THAT BECOMES DISPLACED.
INTERCEPTOR DIVERSIONS / MOUNTABLE BERMS	WEEKLY AND THE NEXT DAY AFTER EACH RAIN EVENT	MAINTAIN THE LINE GRADE, AND CROSS-SECTION OF THE INTERCEPTOR DIVERSION. REMOVE ACCUMULATED SEDIMENT AND DEBRIS AND MAINTAIN POSITIVE DRAINAGE. KEEP INTERCEPTOR DIVERSION FREE OF EROSION WITH VEGETATIVE STABILIZATION.
TRENCH PLUGS	WEEKLY AND THE NEXT DAY AFTER EACH RAIN EVENT	REMOVE WATER THAT ACCUMULATES BEHIND TRENCH PLUGS WITH DEWATERING PUMPS DISCHARGING THROUGH PUMPED WATER FILTER BAGS.
TEMPORARY ACCESS BRIDGE	DAILY AND THE NEXT DAY AFTER EACH RAIN EVENT	STABILIZE THE APPROACH TO THE BRIDGE AND KEEP FREE OF EROSION. CLEAN DECKING AND CURBS OF SEDIMENT DAILY BY SCRAPING, SWEEPING, AND/OR VACUUMING. MAINTAIN THE DECKING AND CURBS TIGHTLY BOLTED WITHOUT GAPS. REMOVE DEBRIS FROM THE BRIDGE. MAINTAIN AREAS ADJACENT TO THE CROSSING TO MEET THE REQUIREMENTS OF ADEQUATE VEGETATIVE STABILIZATION.
WEIGHTED SEDIMENT FILTER TUBE	WEEKLY AND THE NEXT DAY AFTER EACH RAIN EVENT	REPLACE DAMAGED TUBES WITHIN 24 HOURS OF INSPECTION. REMOVE SEDIMENT WHEN ACCUMULATION REACHES 1/2 ABOVE GROUND HEIGHT OF TUBE AND UPON REMOVAL FOR EQUIPMENT CROSSING.
WETLAND CROSSING	WEEKLY AND THE NEXT DAY AFTER EACH RAIN EVENT	REPAIR DAMAGES WITHIN 24 HOURS OF INSPECTION AND PRIOR TO ANY SUBSEQUENT USE. REMOVE SEDIMENT DEPOSITS ON CROSSING OR APPROACHES TO CROSSING WITHIN 24 HOURS OF INSPECTION.
DAM AND PUMP BYPASS STREAM CROSSING	WEEKLY AND THE NEXT DAY AFTER EACH RAIN EVENT	IMMEDIATELY REPAIR OR REPLACE ANY FAILED PUMP OR LEAKS IN PIPING AND/OR IMPROPER CONNECTION TO THE PUMP. REPAIR AND EROSION AT THE DISCHARGE POINT AND INSTALL MEASURES TO PREVENT FURTHER EROSION IMMEDIATELY REPAIR LEAKS OR DAMAGES TO THE IMPERVIOUS DAM.



ARCADIS
Design & Consultancy
Infrastructure and
Civil Works


ARCADIS U.S., INC.

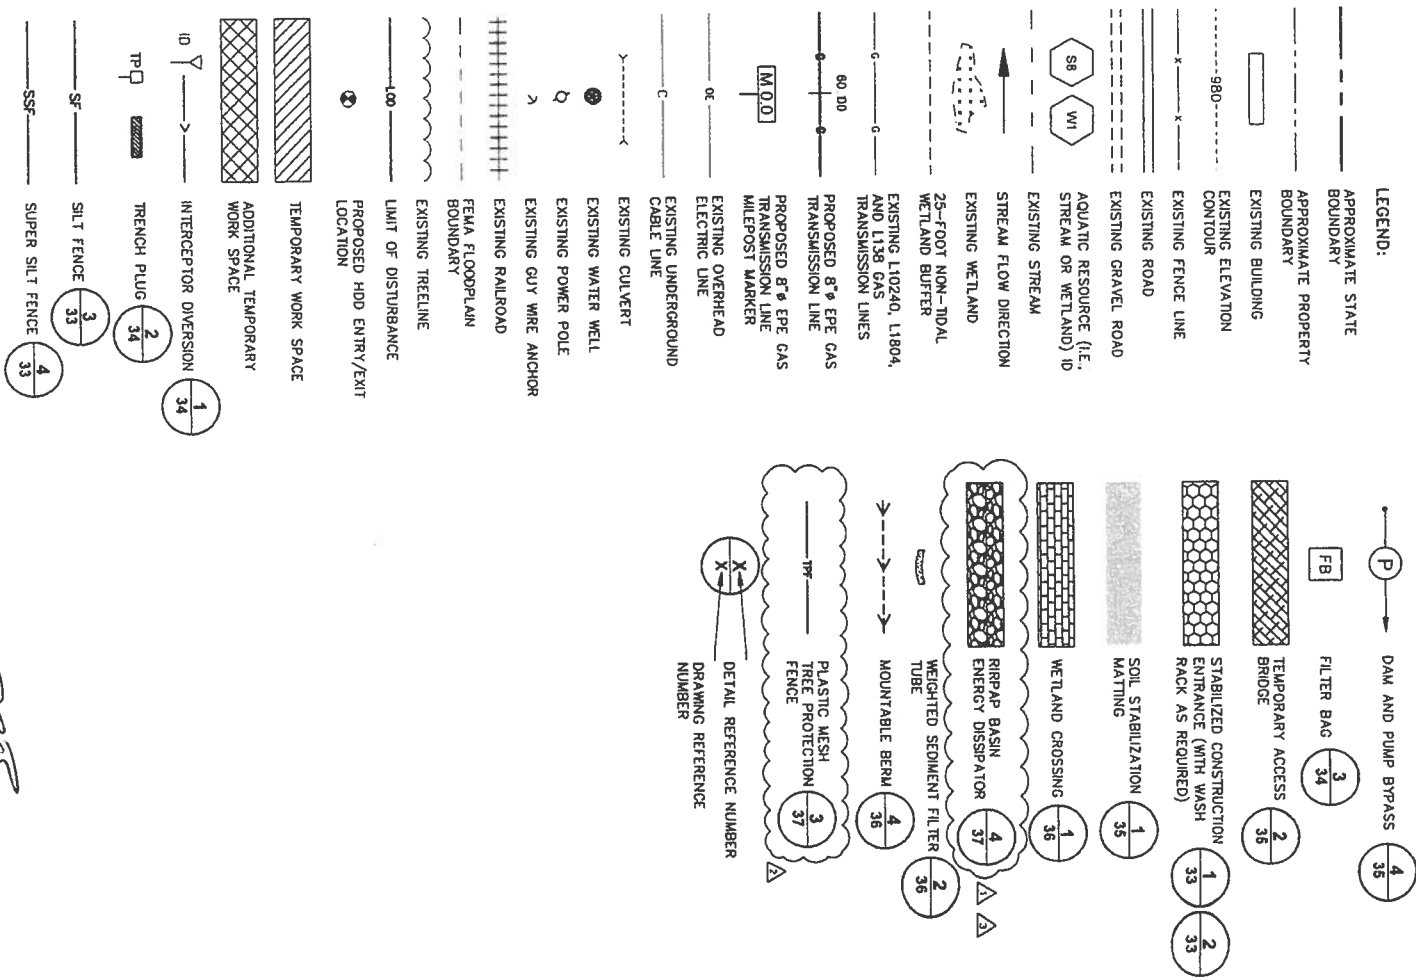

PLANS APPROVED BY: *[Signature]*
DATE: *[Date]*
WATER AND SCIENCE ADMINISTRATION
WATERWAY CONSTRUCTION DIVISION
MARYLAND DEPARTMENT OF THE ENVIRONMENT

COLUMBIA GAS TRANSMISSION, LLC, A TRANSCANADA COMPANY • HOUSTON, TEXAS
EASTERN PANHANDLE EXPANSION PROJECT
GENERAL NOTES AND LEGEND

ARCADIS Project No. CPGL00EP-0001-10008A
Date: MARCH 2017
ARCADIS 8041 Wallace Road Edinburg, Maryland, PA 15090
Tel: 724.762.9180

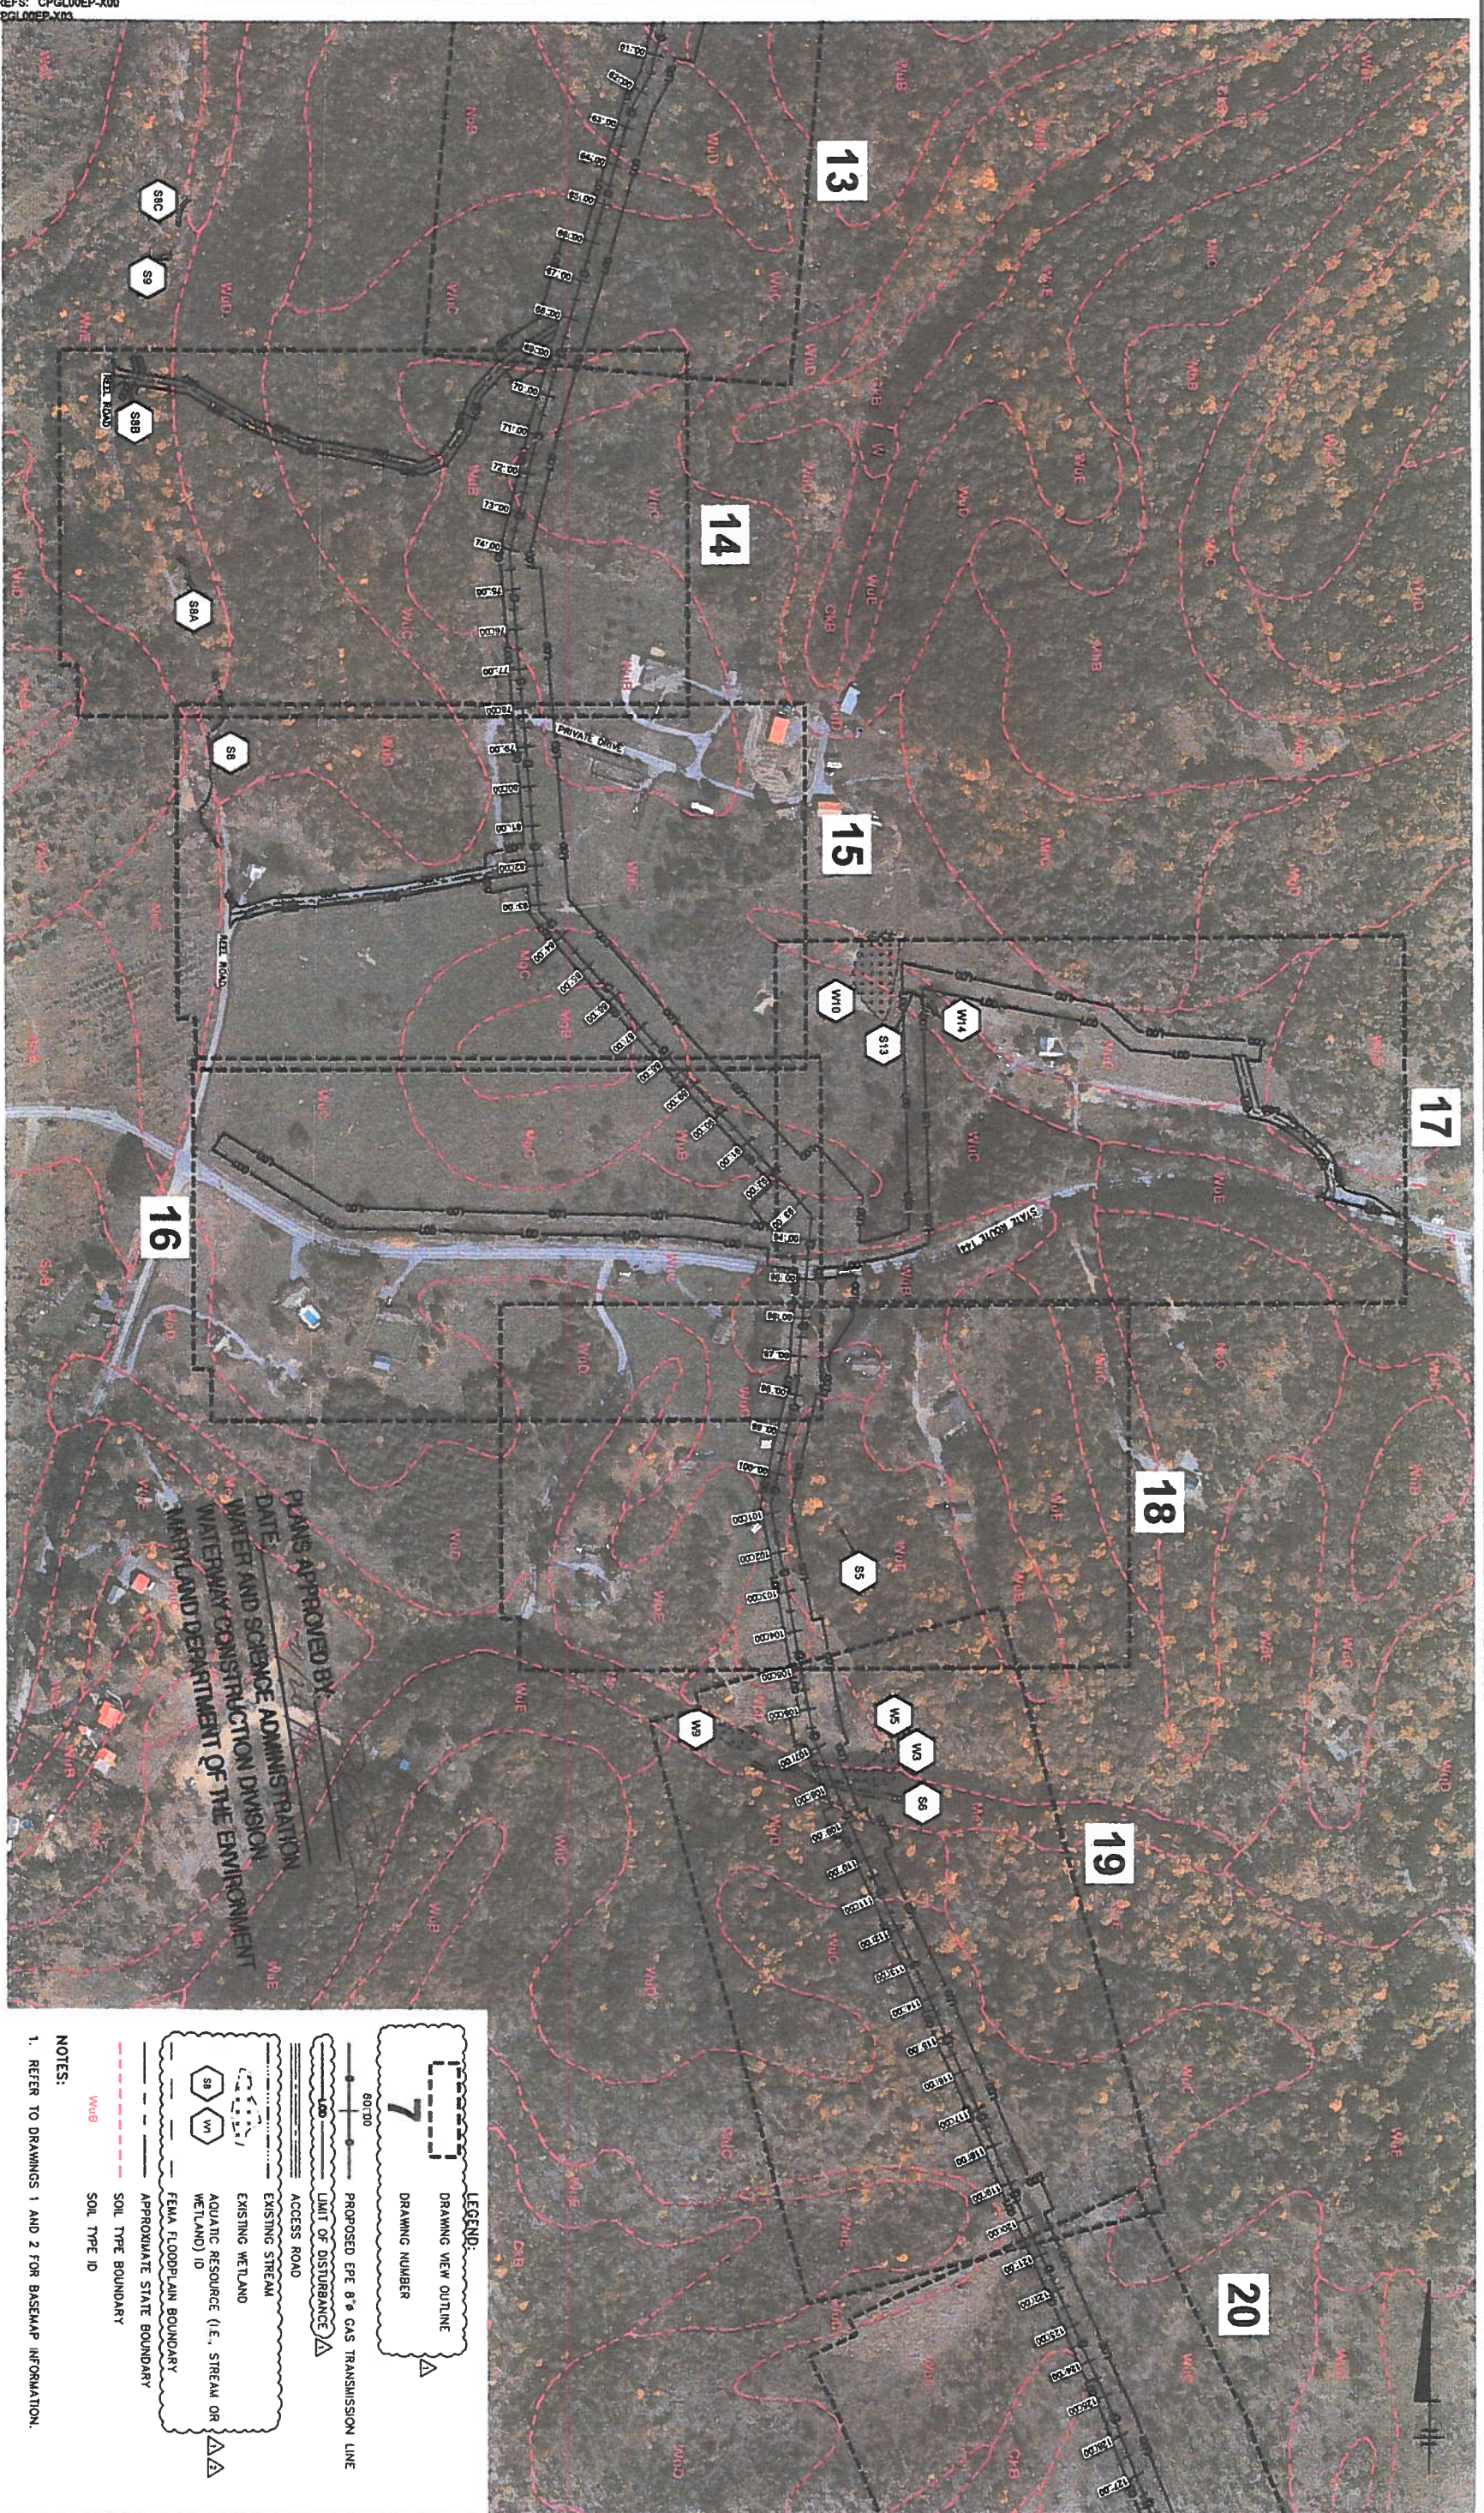

1"=200'

0 200' 400'

THIS BAR REPRESENTS ONE INCH ON THE ORIGINAL DRAWING

USE TO VERIFY FIGURE REPRODUCTION SCALE

No.	Date	By	Checked by
01/17/17	01/17/17	ALS/ARL	ALS/ARL
02/17/17	02/17/17	ALS/ARL	ALS/ARL
03/17/17	03/17/17	ALS/ARL	ALS/ARL
04/17/17	04/17/17	ALS/ARL	ALS/ARL
05/17/17	05/17/17	ALS/ARL	ALS/ARL
06/17/17	06/17/17	ALS/ARL	ALS/ARL
07/17/17	07/17/17	ALS/ARL	ALS/ARL
08/17/17	08/17/17	ALS/ARL	ALS/ARL
09/17/17	09/17/17	ALS/ARL	ALS/ARL
10/17/17	10/17/17	ALS/ARL	ALS/ARL
11/17/17	11/17/17	ALS/ARL	ALS/ARL
12/17/17	12/17/17	ALS/ARL	ALS/ARL



ARCADIS | Design & Consulting
 Building the world better
 together

ARCADIS U.S., INC.

PLANS APPROVED BY
 DATE: 8/18/2017
 WATER AND SCIENCE ADMINISTRATION
 WATERWAY CONSTRUCTION DIVISION
 PENNSYLVANIA DEPARTMENT OF THE ENVIRONMENT

COLUMBIA GAS TRANSMISSION, L.L.C., A TRANSCANADA COMPANY • HOUSTON, TEXAS
 EASTERN PANHANDLE EXPANSION PROJECT
**OVERALL SITE PLAN -
 STA. 59+00 TO 126+00**

ARCADIS Project No. CPGL00EP-0001-0008A
 Date: MARCH 2017
 ARCADIS
 6041 Weavers Road Extension
 Wexford, PA 15090
 Tel: (781) 428-7100

LEGEND:

7 DRAWING VIEW OUTLINE
 DRAWING NUMBER

60+00 PROPOSED 8" x 8" GAS TRANSMISSION LINE
 LIMIT OF DISTURBANCE

ACCESS ROAD

EXISTING STREAM

EXISTING WETLAND

AQUATIC RESOURCE (I.E., STREAM OR WETLAND) ID


FEWA FLOODPLAIN BOUNDARY

APPROXIMATE STATE BOUNDARY

SOIL TYPE BOUNDARY

SOIL TYPE ID

NOTES:
 1. REFER TO DRAWINGS 1 AND 2 FOR BASEMAP INFORMATION.

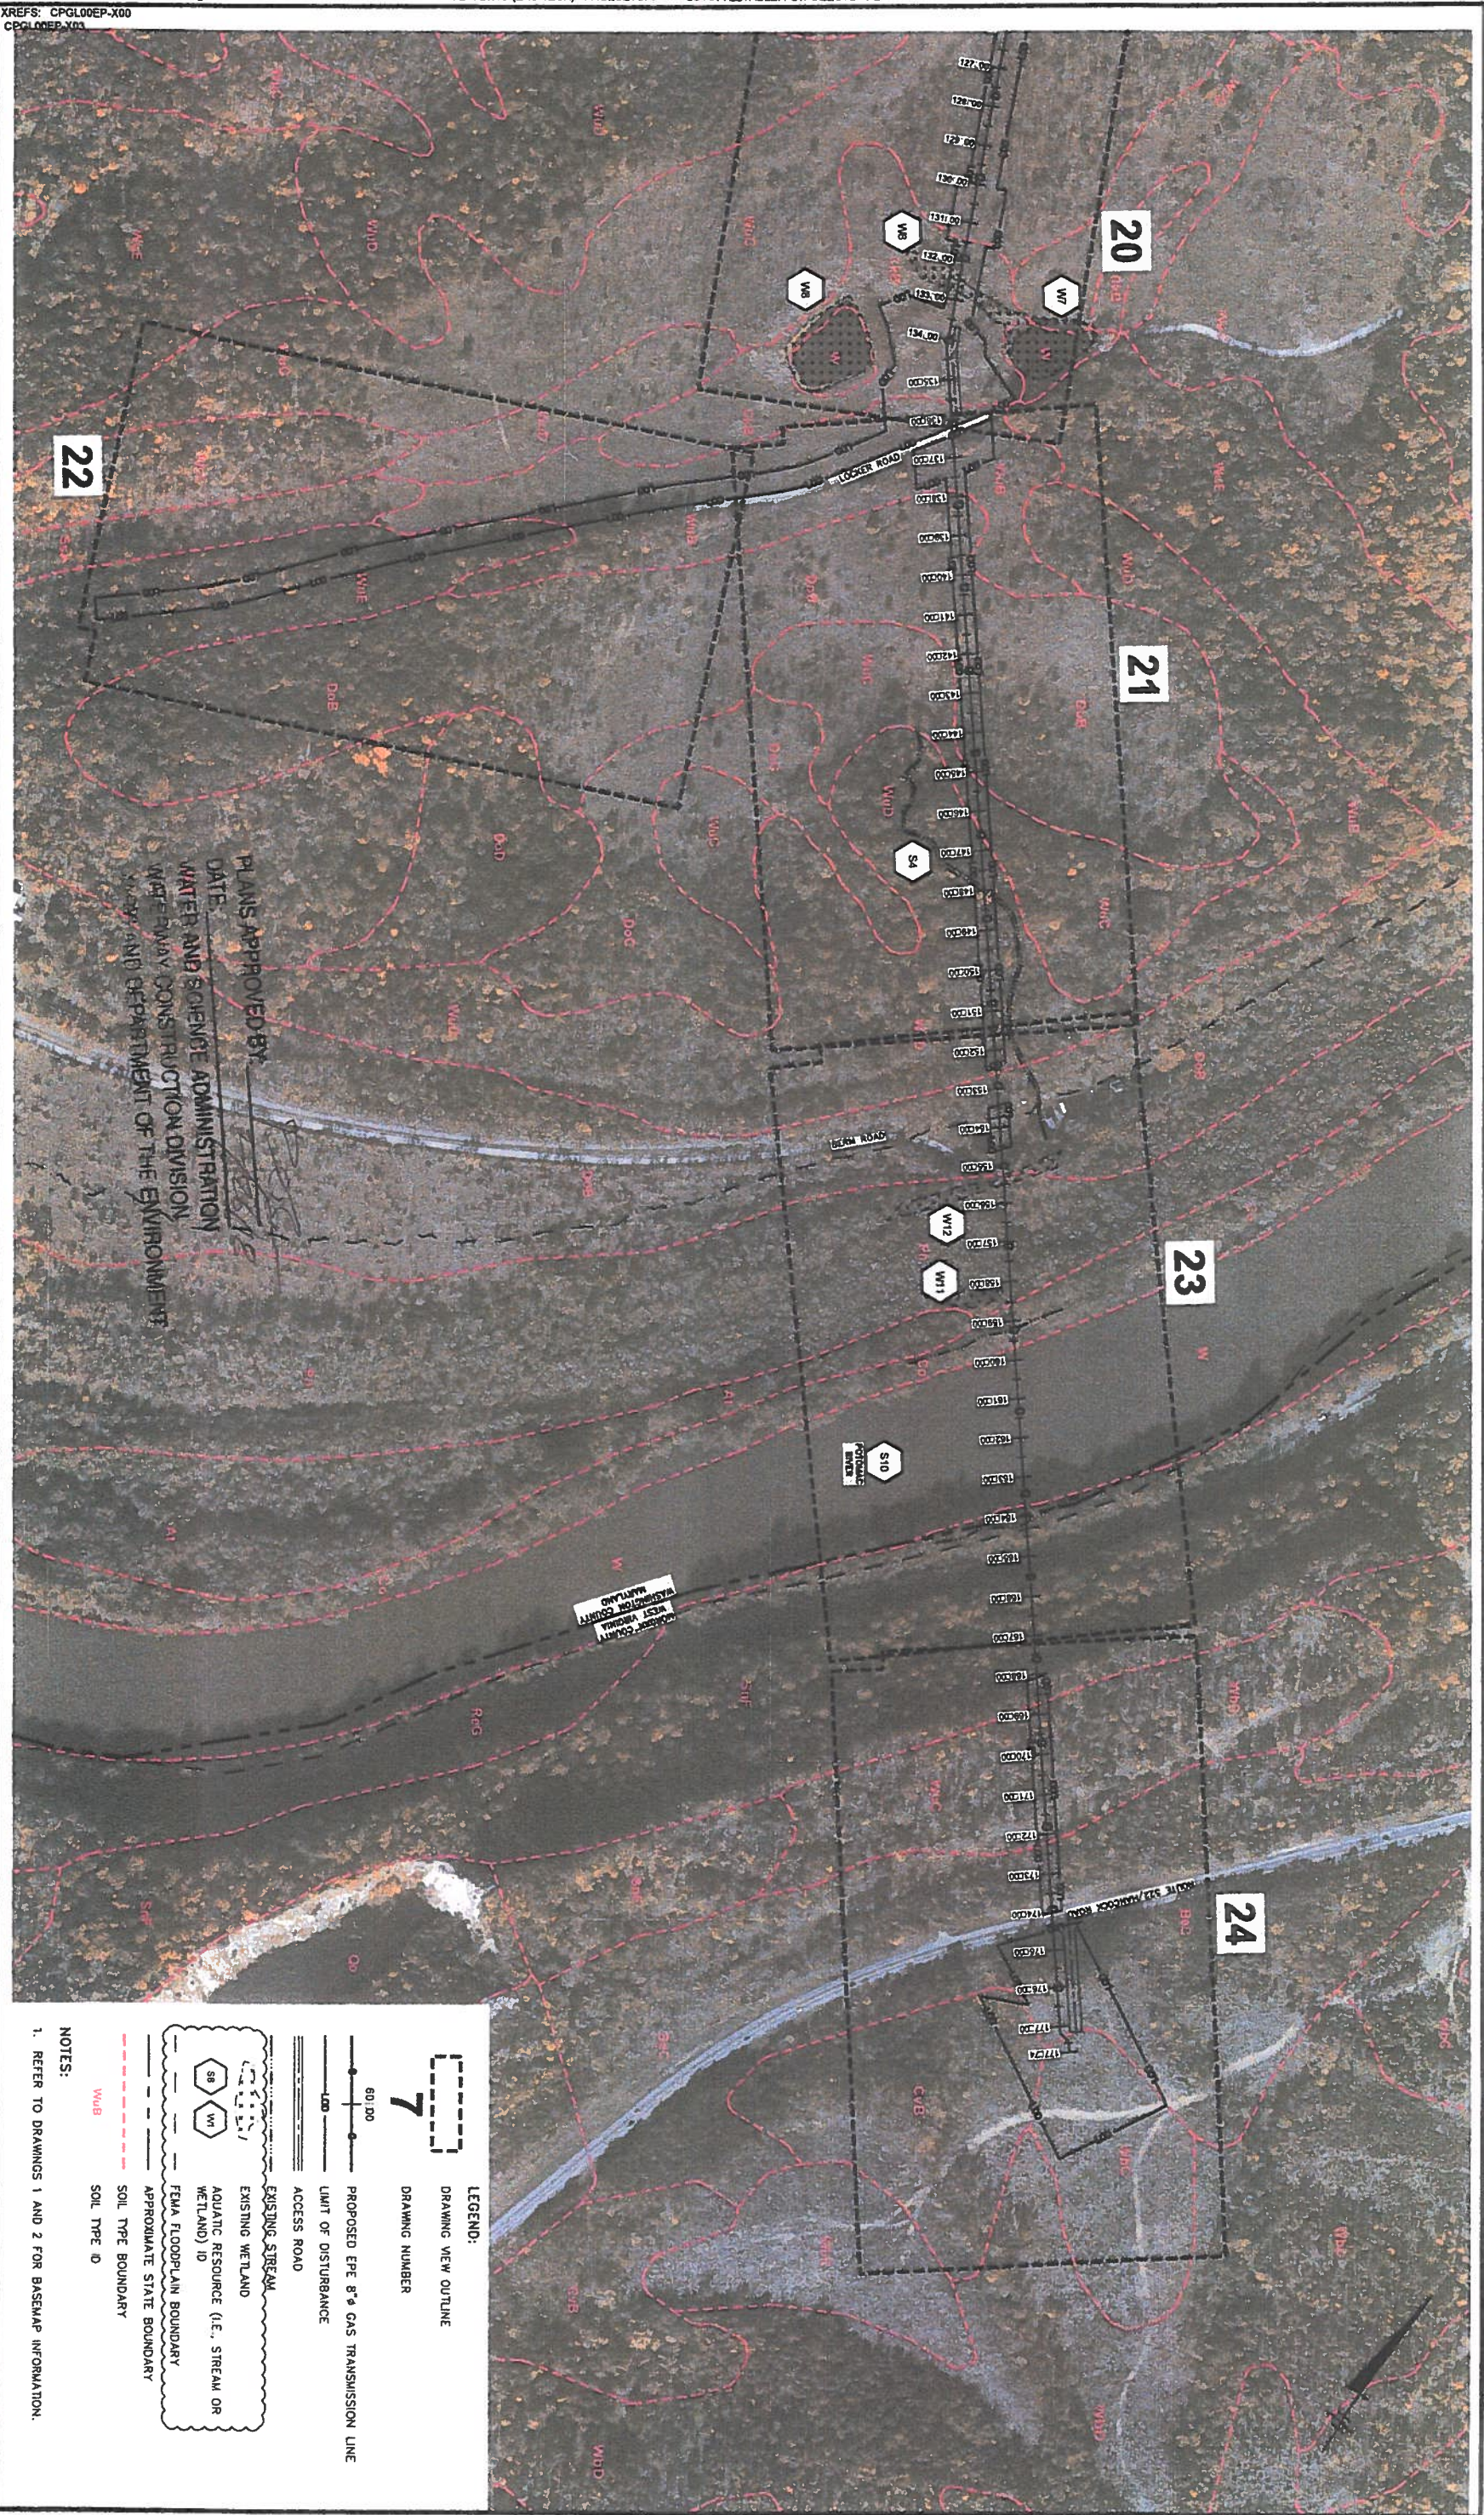

PLANS APPROVED BY
 DATE: _____
 WATER AND SCIENCE ADMINISTRATION
 WASHINGTON COUNTY
 WEST VIRGINIA
 DEPARTMENT OF THE ENVIRONMENT

LEGEND:

- DRAWING VIEW OUTLINE
- DRAWING NUMBER: 7
- PROPOSED 8" GAS TRANSMISSION LINE
- LIMIT OF DISTURBANCE
- ACCESS ROAD
- EXISTING STREAM
- EXISTING WETLAND
- AQUATIC RESOURCE (I.E. STREAM OR WETLAND) ID
- FEMA FLOODPLAIN BOUNDARY
- APPROXIMATE STATE BOUNDARY
- SOIL TYPE BOUNDARY
- SOIL TYPE ID

NOTES:

- REFER TO DRAWINGS 1 AND 2 FOR BASEMAP INFORMATION.

1"=200'

200'

400'

USE TO VERIFY REPRODUCTION SCALE

No.	Date	MOE COMMENT RESPONSE	Revisions	ALS ARL	By	Checkd by
1	7/17/17			ALS ARL	JD	ARL

THIS DRAWING IS THE PROPERTY OF THE AGENCY. ANY REVISIONS TO THIS DRAWING MUST BE MADE ON THIS DRAWING AND NOT BE REPRODUCED OR TRANSMITTED IN ANY FORM OR BY ANY MEANS, ELECTRONIC OR MECHANICAL, INCLUDING PHOTOCOPYING, RECORDING, OR BY ANY INFORMATION STORAGE AND RETRIEVAL SYSTEM.



COLUMBIA GAS TRANSMISSION, L.L.C., A TRANSCANADA COMPANY • HOUSTON, TEXAS
 EASTERN PANHANDLE EXPANSION PROJECT
OVERALL SITE PLAN - STA. 126+00 TO 177+74

ARCADIS Project No. CPGL00EP-0001-0008A
 Date: MARCH 2017
 ARCADIS
 6041 Walden Road Extension
 Suite 300
 Wexford, PA 15090
 Tel: 724.742.8180

5

XREFS: CPGL00EP-X00
CPGL00EP-X03

- NOTES:
1. REFER TO DRAWINGS 1 AND 2 FOR BASEMAP INFORMATION.

LEGEND:

DRAWING VIEW OUTLINE
DRAWING NUMBER **7**

PROPOSED EPE 8" GAS TRANSMISSION LINE
LIMIT OF DISTURBANCE
ACCESS ROAD
EXISTING STREAM
EXISTING WETLAND
AQUATIC RESOURCE (I.E. STREAM OR WETLAND) ID
FEMA FLOODPLAIN BOUNDARY
APPROXIMATE STATE BOUNDARY
SOIL TYPE BOUNDARY
SOIL TYPE ID

THIS BAR REPRESENTS ONE INCH ON THE ORIGINAL DRAWING

USE TO VERIFY FIGURE REPRODUCTION SCALE

No	Date	Revisions

Professional Engineer's Name	ALLEN LONG
Professional Engineer's No.	MD 34882
State	MD
Designed by	AS
Date Signed	AS
Checked by	AS
Project Mgr.	AS
JD	AS
ARL	AS



ARCADIS Design & Consultancy
Engineering, Architecture and Construction

ARCADIS U.S., INC.

COLUMBIA GAS TRANSMISSION, LLC, A TRANSCANADA COMPANY • HOUSTON, TEXAS
EASTERN PANHANDLE EXPANSION PROJECT

OVERALL SITE PLAN - CONTRACTOR STAGING AREA AND TEMPORARY ACCESS ROAD TAR-1


PLANS APPROVED BY: *AS*
DATE: *8/18/17*


WATER AND SCIENCE ADMINISTRATION
WATERWAY CONSTRUCTION DIVISION
MARYLAND DEPARTMENT OF THE ENVIRONMENT

ARCADIS Project No. CPGL00EP-0001-0008A
Date: MARCH 2017

ARCADIS
6041 Walker Road Extension
Suite 300
Wexford, PA 15090
Tel: 724-742-9180

6

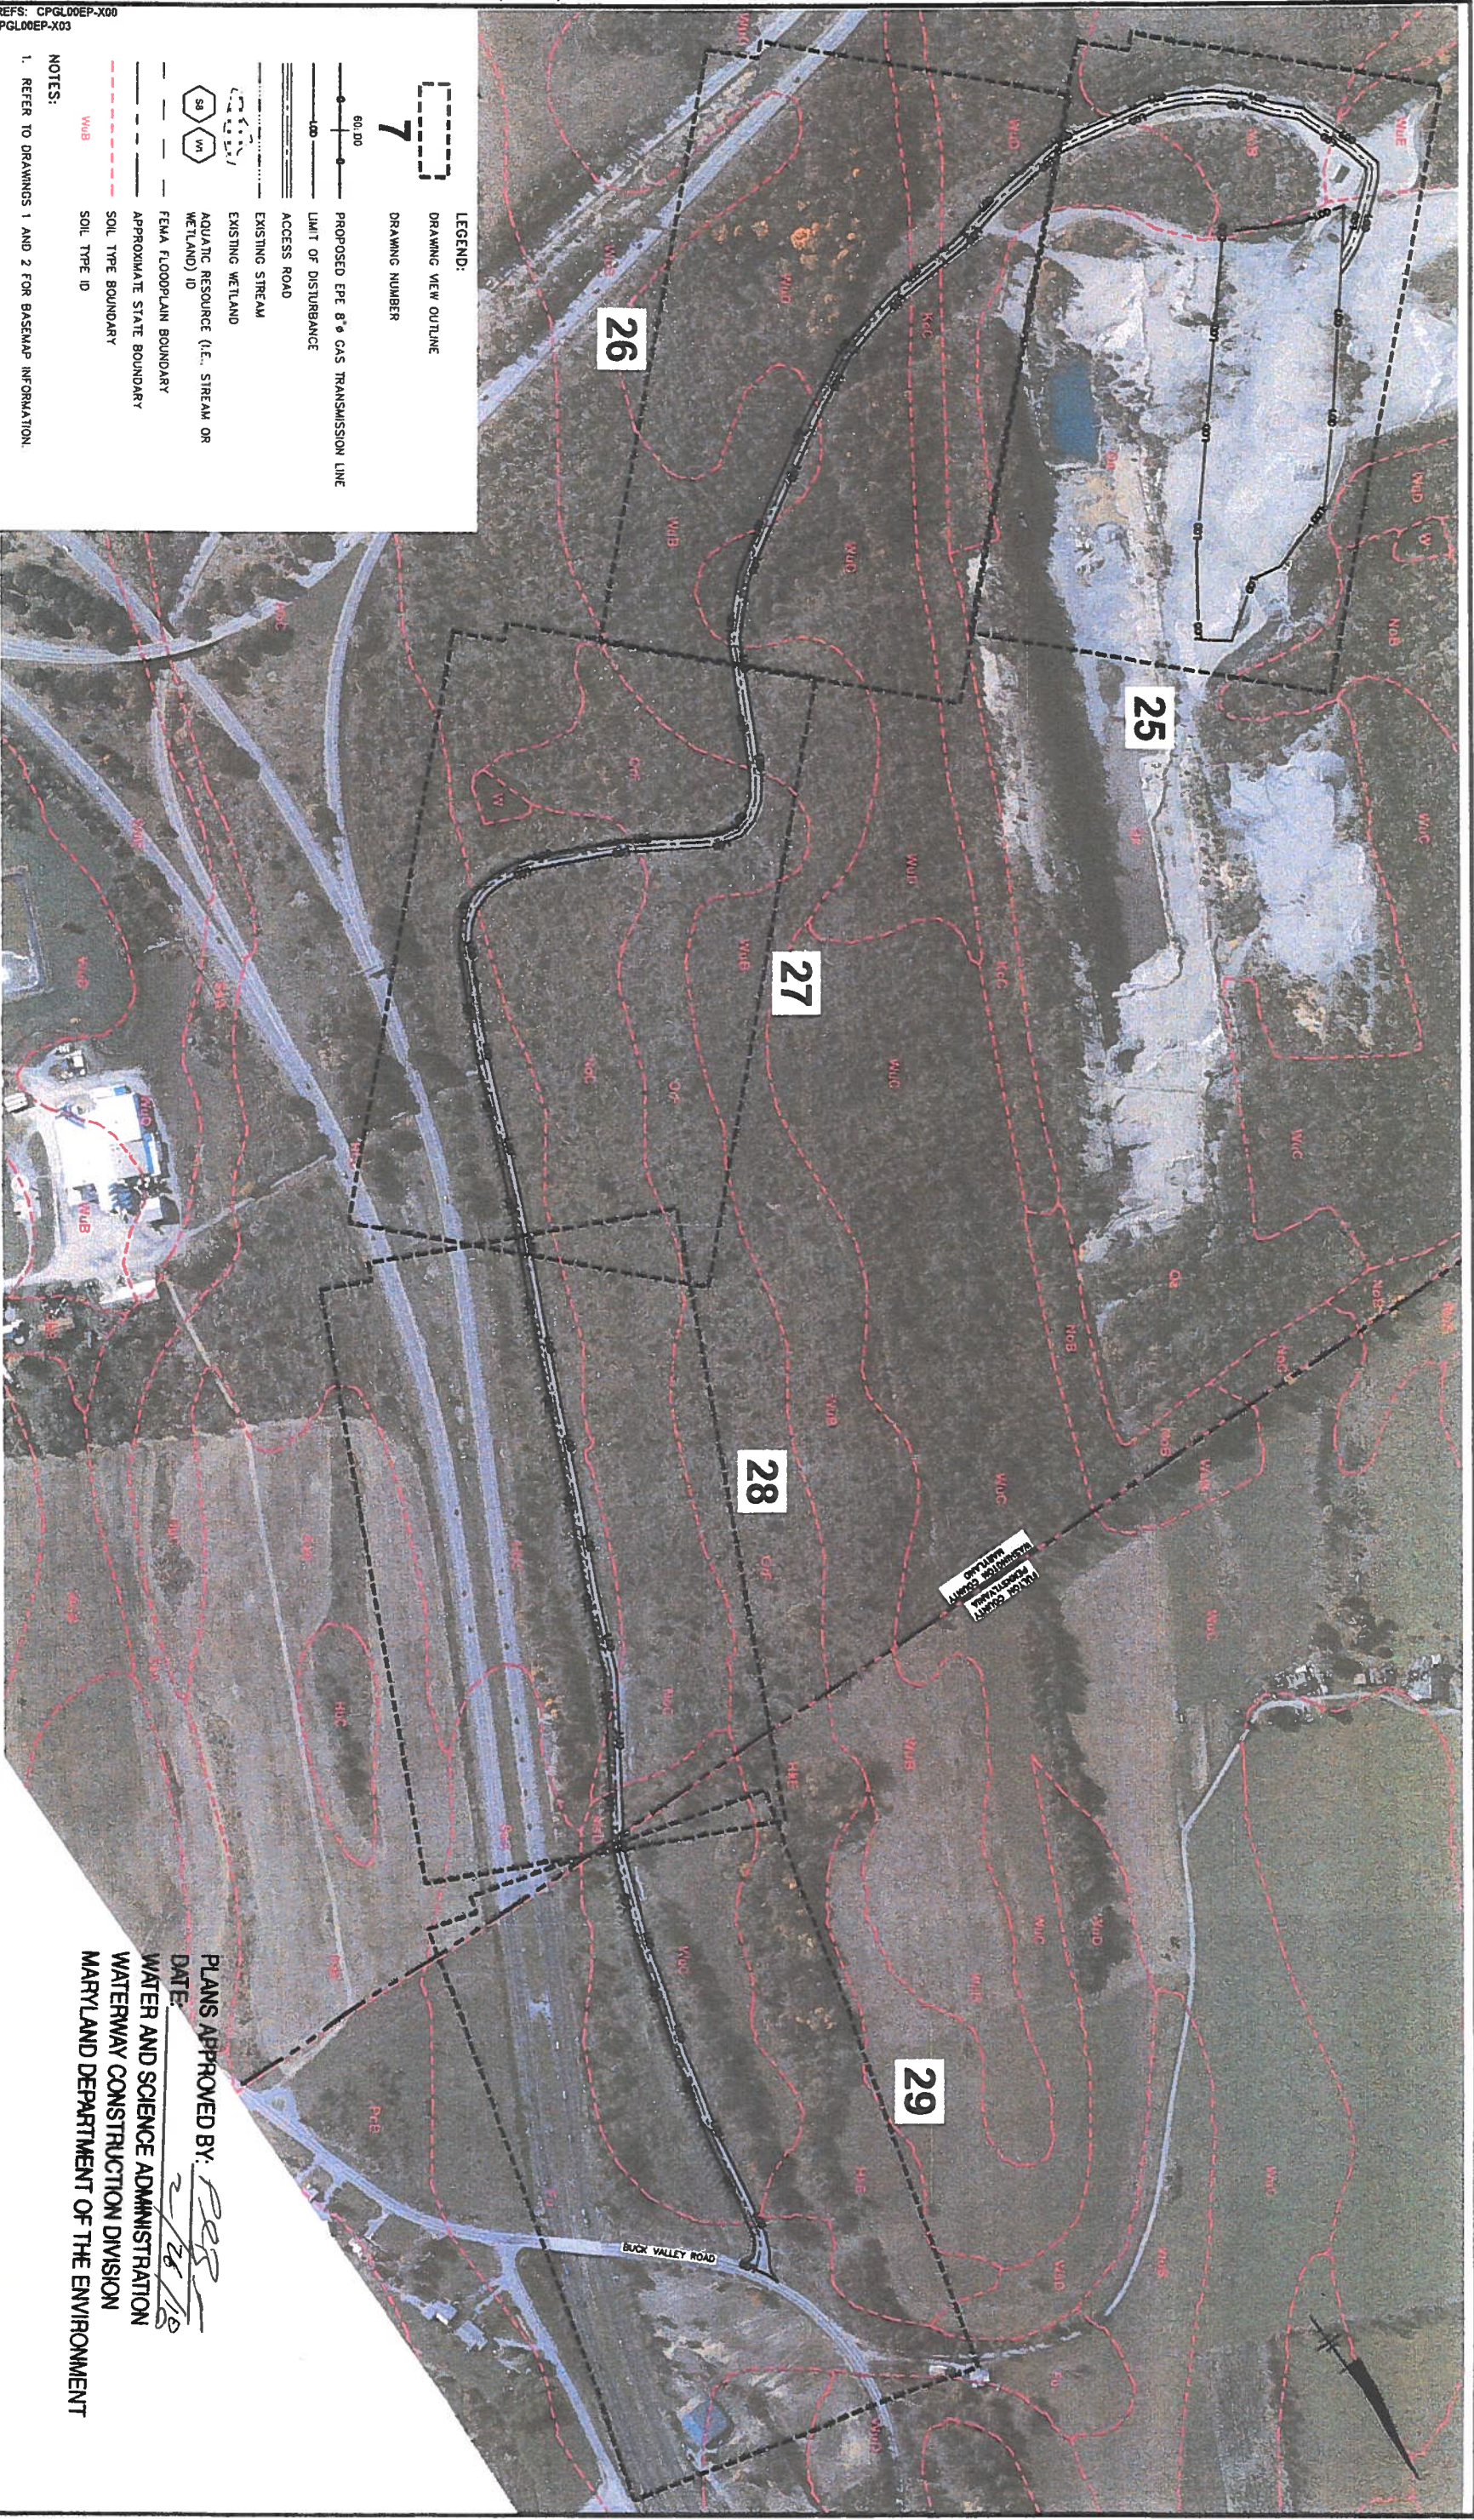

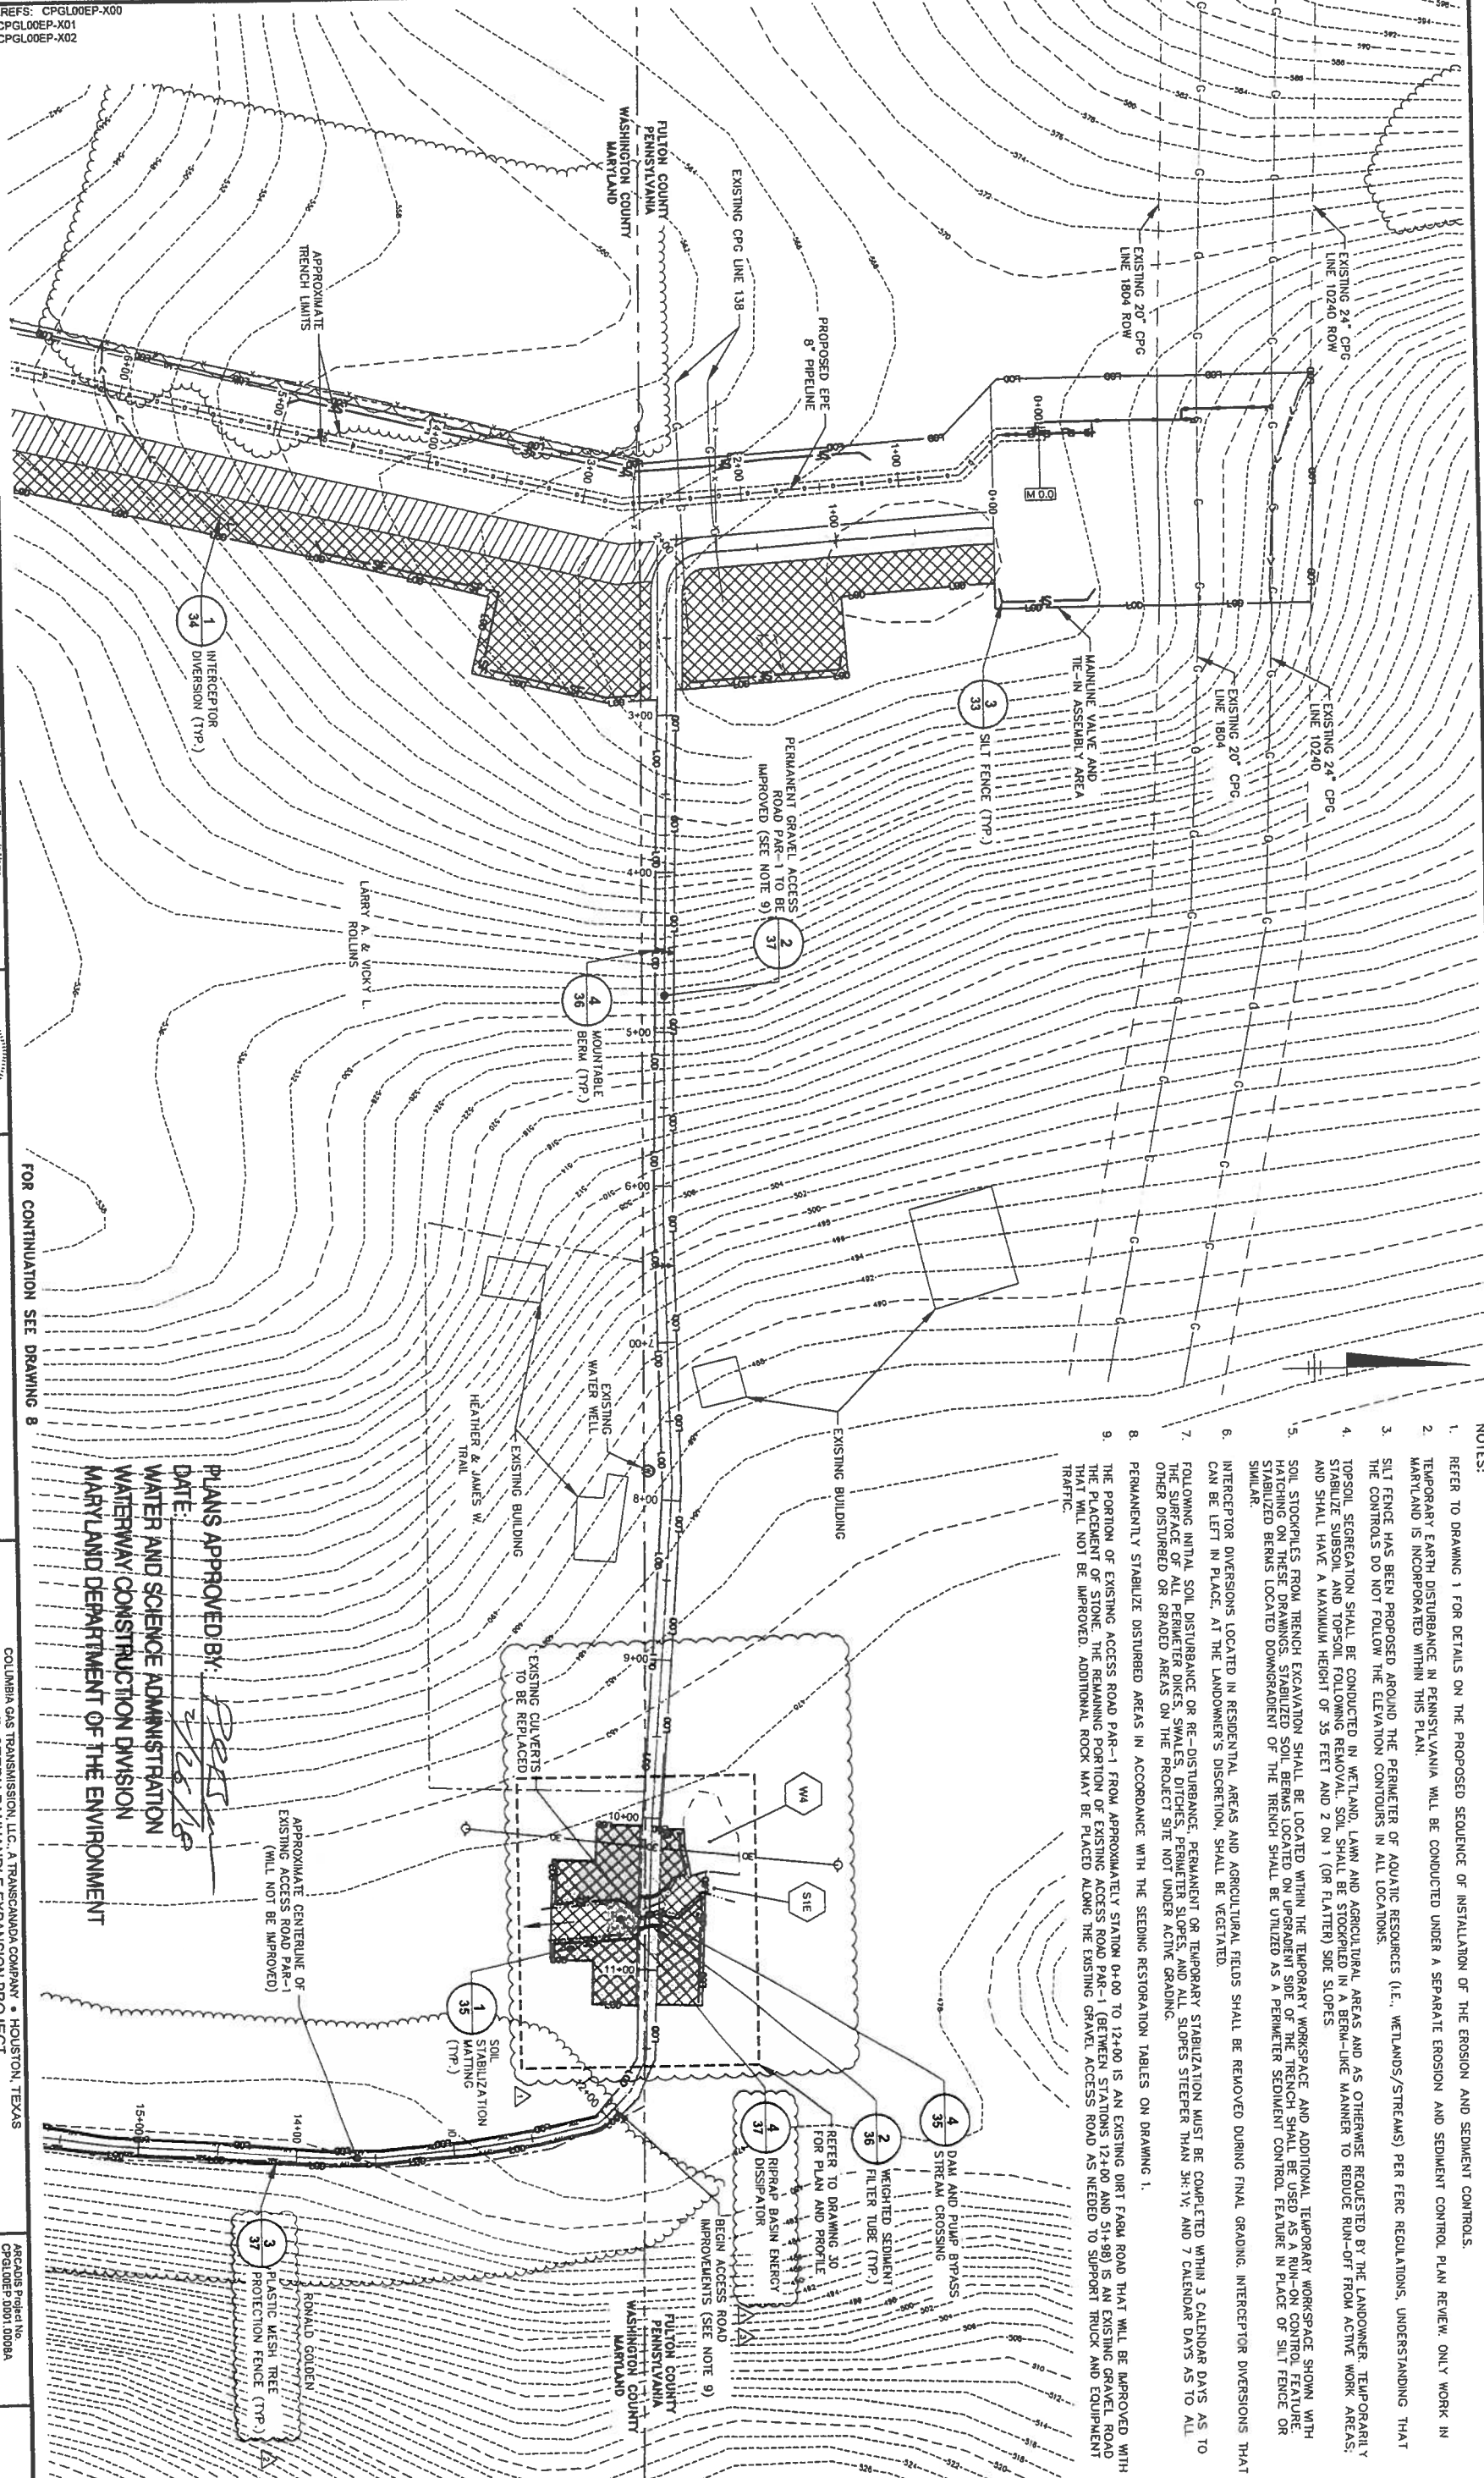

- NOTES:**
- REFER TO DRAWING 1 FOR DETAILS ON THE PROPOSED SEQUENCE OF INSTALLATION OF THE EROSION AND SEDIMENT CONTROLS.
 - TEMPORARY EARTH DISTURBANCE IN PENNSYLVANIA WILL BE CONDUCTED UNDER A SEPARATE EROSION AND SEDIMENT CONTROL PLAN REVIEW. ONLY WORK IN MARYLAND IS INCORPORATED WITHIN THIS PLAN.
 - SILT FENCE HAS BEEN PROPOSED AROUND THE PERIMETER OF AQUATIC RESOURCES (I.E., WETLANDS/STREAMS) PER FERC REGULATIONS, UNDERSTANDING THAT THE CONTROLS DO NOT FOLLOW THE ELEVATION CONTOURS IN ALL LOCATIONS.
 - TOPSOIL SEGREGATION SHALL BE CONDUCTED IN WETLAND, LAWN AND AGRICULTURAL AREAS AND AS OTHERWISE REQUESTED BY THE LANDOWNER. TEMPORARILY STABILIZE SUBSOIL AND TOPSOIL FOLLOWING REMOVAL. SOIL SHALL BE STOCKPILED IN A BERM-LIKE MANNER TO REDUCE RUN-OFF FROM ACTIVE WORK AREAS, AND SHALL HAVE A MAXIMUM HEIGHT OF 35 FEET AND 2 ON 1 (OR FLATTER) SIDE SLOPES.
 - SOIL STOCKPILES FROM TRENCH EXCAVATION SHALL BE LOCATED WITHIN THE TEMPORARY WORKSPACE AND ADDITIONAL TEMPORARY WORKSPACE SHOWN WITH HATCHING ON THESE DRAWINGS. STABILIZED SOIL BERMS LOCATED ON UPGRADABLE SIDE OF THE TRENCH SHALL BE USED AS A PERIMETER SEDIMENT CONTROL FEATURE IN PLACE OF SILT FENCE OR STABILIZED BERMS LOCATED DOWNGRADABLE OF THE TRENCH SHALL BE UTILIZED AS A PERIMETER SEDIMENT CONTROL FEATURE IN PLACE OF SILT FENCE OR SIMILAR.
 - INTERCEPTOR DIVERSIONS LOCATED IN RESIDENTIAL AREAS AND AGRICULTURAL FIELDS SHALL BE REMOVED DURING FINAL GRADING. INTERCEPTOR DIVERSIONS THAT CAN BE LEFT IN PLACE, AT THE LANDOWNER'S DISCRETION, SHALL BE VEGETATED.
 - FOLLOWING INITIAL SOIL DISTURBANCE OR RE-DISTURBANCE, PERMANENT OR TEMPORARY STABILIZATION MUST BE COMPLETED WITHIN 3 CALENDAR DAYS AS TO THE SURFACE OF ALL PERIMETER DIKES, SWALES, DITCHES, PERMETER SLOPES, AND ALL SLOPES STEEPER THAN 3H:1V, AND 7 CALENDAR DAYS AS TO ALL OTHER DISTURBED OR GRADED AREAS ON THE PROJECT SITE NOT UNDER ACTIVE GRADING.
 - PERMANENTLY STABILIZE DISTURBED AREAS IN ACCORDANCE WITH THE SEEDING RESTORATION TABLES ON DRAWING 1.
 - THE PORTION OF EXISTING ACCESS ROAD PAR-1 FROM APPROXIMATELY STATION 0+00 TO 12+00 IS AN EXISTING DIRT FARM ROAD THAT WILL BE IMPROVED WITH THE PLACEMENT OF STONE. THE REMAINING PORTION OF EXISTING ACCESS ROAD PAR-1 (BETWEEN STATIONS 12+00 AND 51+98) IS AN EXISTING GRAVEL ROAD THAT WILL NOT BE IMPROVED. ADDITIONAL ROCK MAY BE PLACED ALONG THE EXISTING GRAVEL ACCESS ROAD AS NEEDED TO SUPPORT TRUCK AND EQUIPMENT TRAFFIC.

PLANS APPROVED BY: *[Signature]*
DATE: 7/26/16
WATER AND SCIENCE ADMINISTRATION
WATERWAY CONSTRUCTION DIVISION
MARYLAND DEPARTMENT OF THE ENVIRONMENT

FOR CONTINUATION SEE DRAWING 8

KREFS: CPGL00EP-X00
 CPGL00EP-X01
 CPGL00EP-X02

THIS BAR REPRESENTS ONE ORIGINAL DRAWING

USE TO VERIFY FIGURE REFERENCE SCALE

No.	Date	Revisions
1	7/17/17	FOREST CONSERVATION ACT RE. URELEMENT
2	7/17/17	FOREST CONSERVATION ACT RE. URELEMENT
3	7/17/17	FOREST CONSERVATION ACT RE. URELEMENT
ARCADIS
 Design & Consultancy
 for natural and built assets

ARCADIS U.S., INC.


COLUMBIA GAS TRANSMISSION, LLC, A TRANSCANADA COMPANY • HOUSTON, TEXAS
 EASTERN PANHANDLE EXPANSION PROJECT

SITE PLAN (STA. 0+00 TO 6+50)

ARCADIS Project No. CPGL00EP-0001.0008A
 Date: MARCH 2017
 ARCADIS
 6011 Wilshire Road Extension
 Suite 300
 Westfield, PA 15960
 Tel: 724.762.9780

7

XREFS: CPGL00EP-X00
CPGL00EP-X01
CPGL00EP-X02

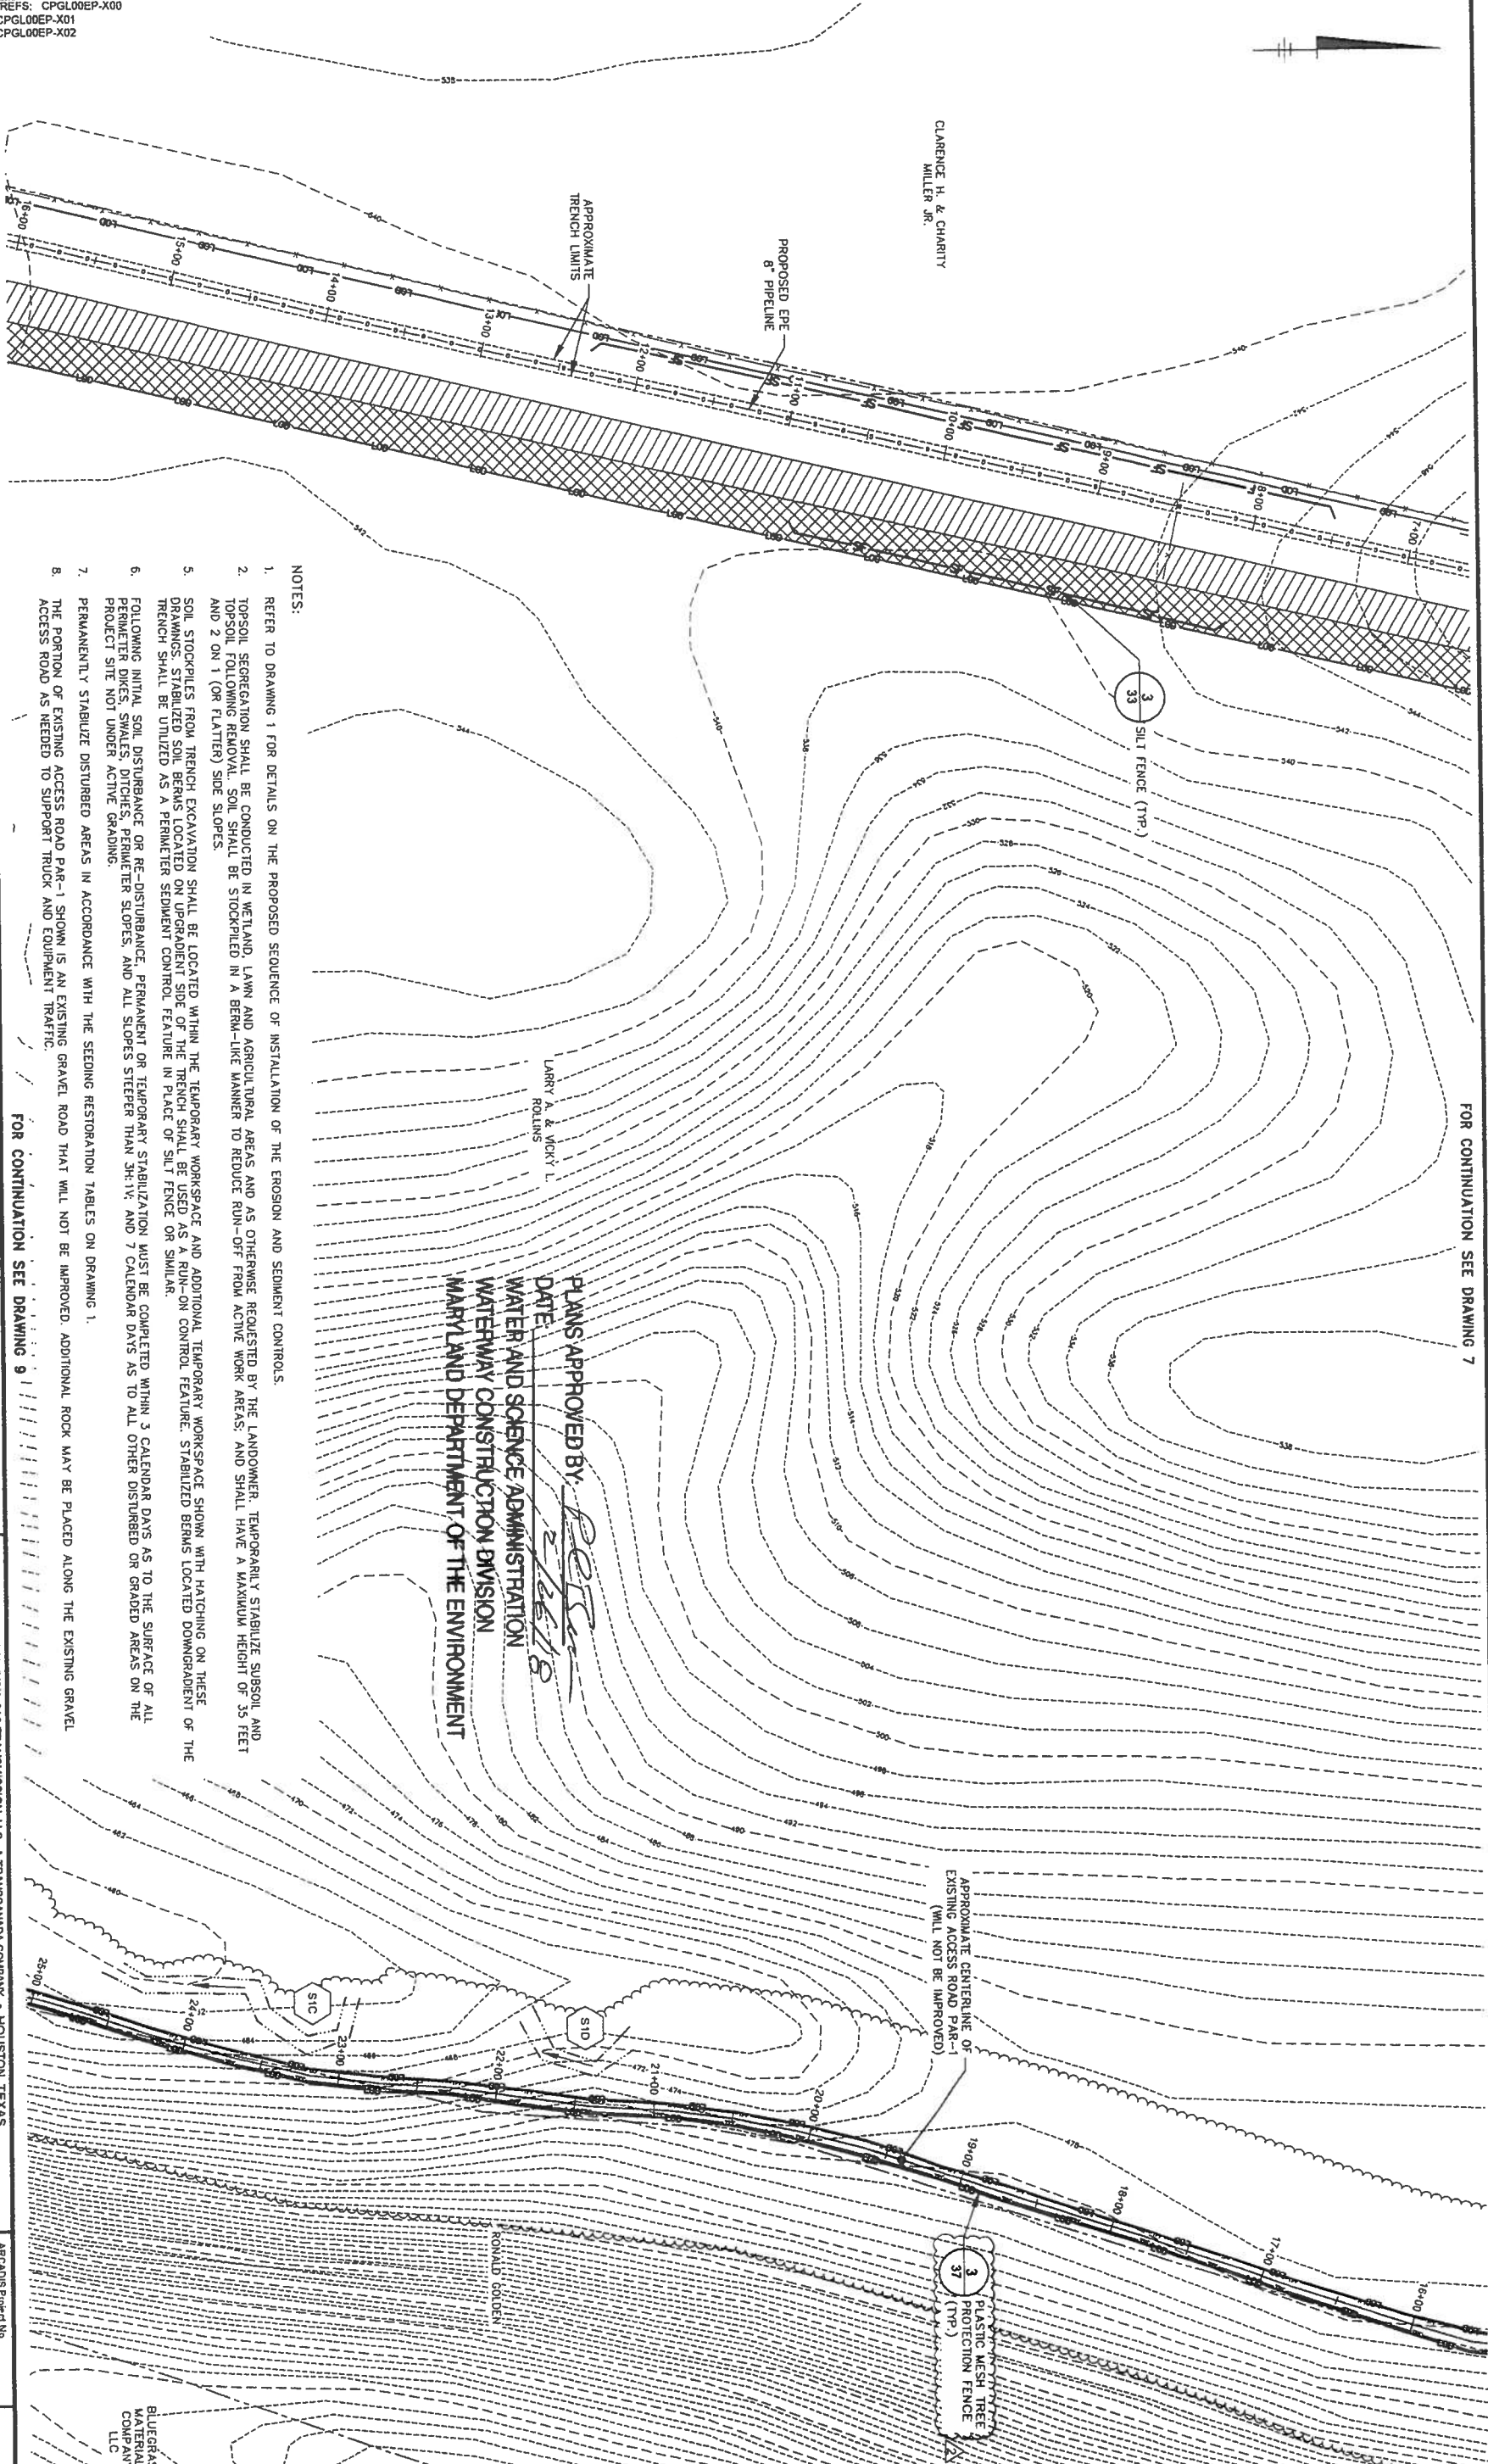

FOR CONTINUATION SEE DRAWING 7

- NOTES:
1. REFER TO DRAWING 1 FOR DETAILS ON THE PROPOSED SEQUENCE OF INSTALLATION OF THE EROSION AND SEDIMENT CONTROLS.
 2. TOPSOIL SEGREGATION SHALL BE CONDUCTED IN WETLAND, LAWN AND AGRICULTURAL AREAS AND AS OTHERWISE REQUESTED BY THE LANDOWNER. TEMPORARILY STABILIZE SUBSOIL AND TOPSOIL FOLLOWING REMOVAL. SOIL SHALL BE STOCKPILED IN A BERM-LIKE MANNER TO REDUCE RUN-OFF FROM ACTIVE WORK AREAS; AND SHALL HAVE A MAXIMUM HEIGHT OF 35 FEET AND 2 ON 1 (OR FLATTER) SIDE SLOPES.
 3. SOIL STOCKPILES FROM TRENCH EXCAVATION SHALL BE LOCATED WITHIN THE TEMPORARY WORKSPACE AND ADDITIONAL TEMPORARY WORKSPACE SHOWN WITH HATCHING ON THESE DRAWINGS. STABILIZED SOIL BERMS LOCATED ON UPGRADEMENT SIDE OF THE TRENCH SHALL BE USED AS A RUN-ON CONTROL FEATURE. STABILIZED BERMS LOCATED DOWNGRADIENT OF THE TRENCH SHALL BE UTILIZED AS A PERIMETER SEDIMENT CONTROL FEATURE IN PLACE OF SILT FENCE OR SIMILAR.
 4. FOLLOWING INITIAL SOIL DISTURBANCE OR RE-DISTURBANCE PERMANENT OR TEMPORARY STABILIZATION MUST BE COMPLETED WITHIN 3 CALENDAR DAYS AS TO THE SURFACE OF ALL PERIMETER DIKES, SWALES, DITCHES, PERIMETER SLOPES, AND ALL SLOPES STEEPER THAN 3H:1V; AND 7 CALENDAR DAYS AS TO ALL OTHER DISTURBED OR GRADED AREAS ON THE PROJECT SITE NOT UNDER ACTIVE GRADING.
 5. PERMANENTLY STABILIZE DISTURBED AREAS IN ACCORDANCE WITH THE SEEDING RESTORATION TABLES ON DRAWING 1.
 6. THE PORTION OF EXISTING ACCESS ROAD PAR-1 SHOWN IS AN EXISTING GRAVEL ROAD THAT WILL NOT BE IMPROVED. ADDITIONAL ROCK MAY BE PLACED ALONG THE EXISTING GRAVEL.

PLANS APPROVED BY: *[Signature]*
DATE: 2/26/18
WATER AND SCIENCE ADMINISTRATION
WATERWAY CONSTRUCTION DIVISION
MARYLAND DEPARTMENT OF THE ENVIRONMENT

THIS DRAWING IS THE PROPERTY OF THE ARCHADIS COMPANY. IT IS TO BE USED ONLY FOR THE PROJECT AND SITE SPECIFICALLY IDENTIFIED IN THE TITLE BLOCK AND SHALL NOT BE REPRODUCED OR TRANSMITTED IN ANY FORM OR BY ANY MEANS, ELECTRONIC OR MECHANICAL, INCLUDING PHOTOCOPYING, RECORDING, OR BY ANY INFORMATION STORAGE AND RETRIEVAL SYSTEM, WITHOUT THE WRITTEN PERMISSION OF ARCHADIS U.S., INC.

No.	Date	Revisions	By	Checked
1	7/11/17	FOREST CONSERVATION ACT RE: UREMENT	ALS	ARL

Professional Engineer's Name
ALLEN LONG
Professional Engineer's No.
MD 34862




ARCADIS U.S., INC.
Design & Consultancy
for technical and
built assets

COLUMBIA GAS TRANSMISSION, LLC, A TRANSCANA COMPANY • HOUSTON, TEXAS
EASTERN PANHANDLE EXPANSION PROJECT
SITE PLAN (STA. 6+50 TO 16+00)

ARCADIS Project No.
CPGL00EP-0001-0009A
Date
MARCH 2017
ARCADIS
6041 Wallace Road Extension
Suite 500
Wexford, PA 15090
TEL: 724.742.9100

8

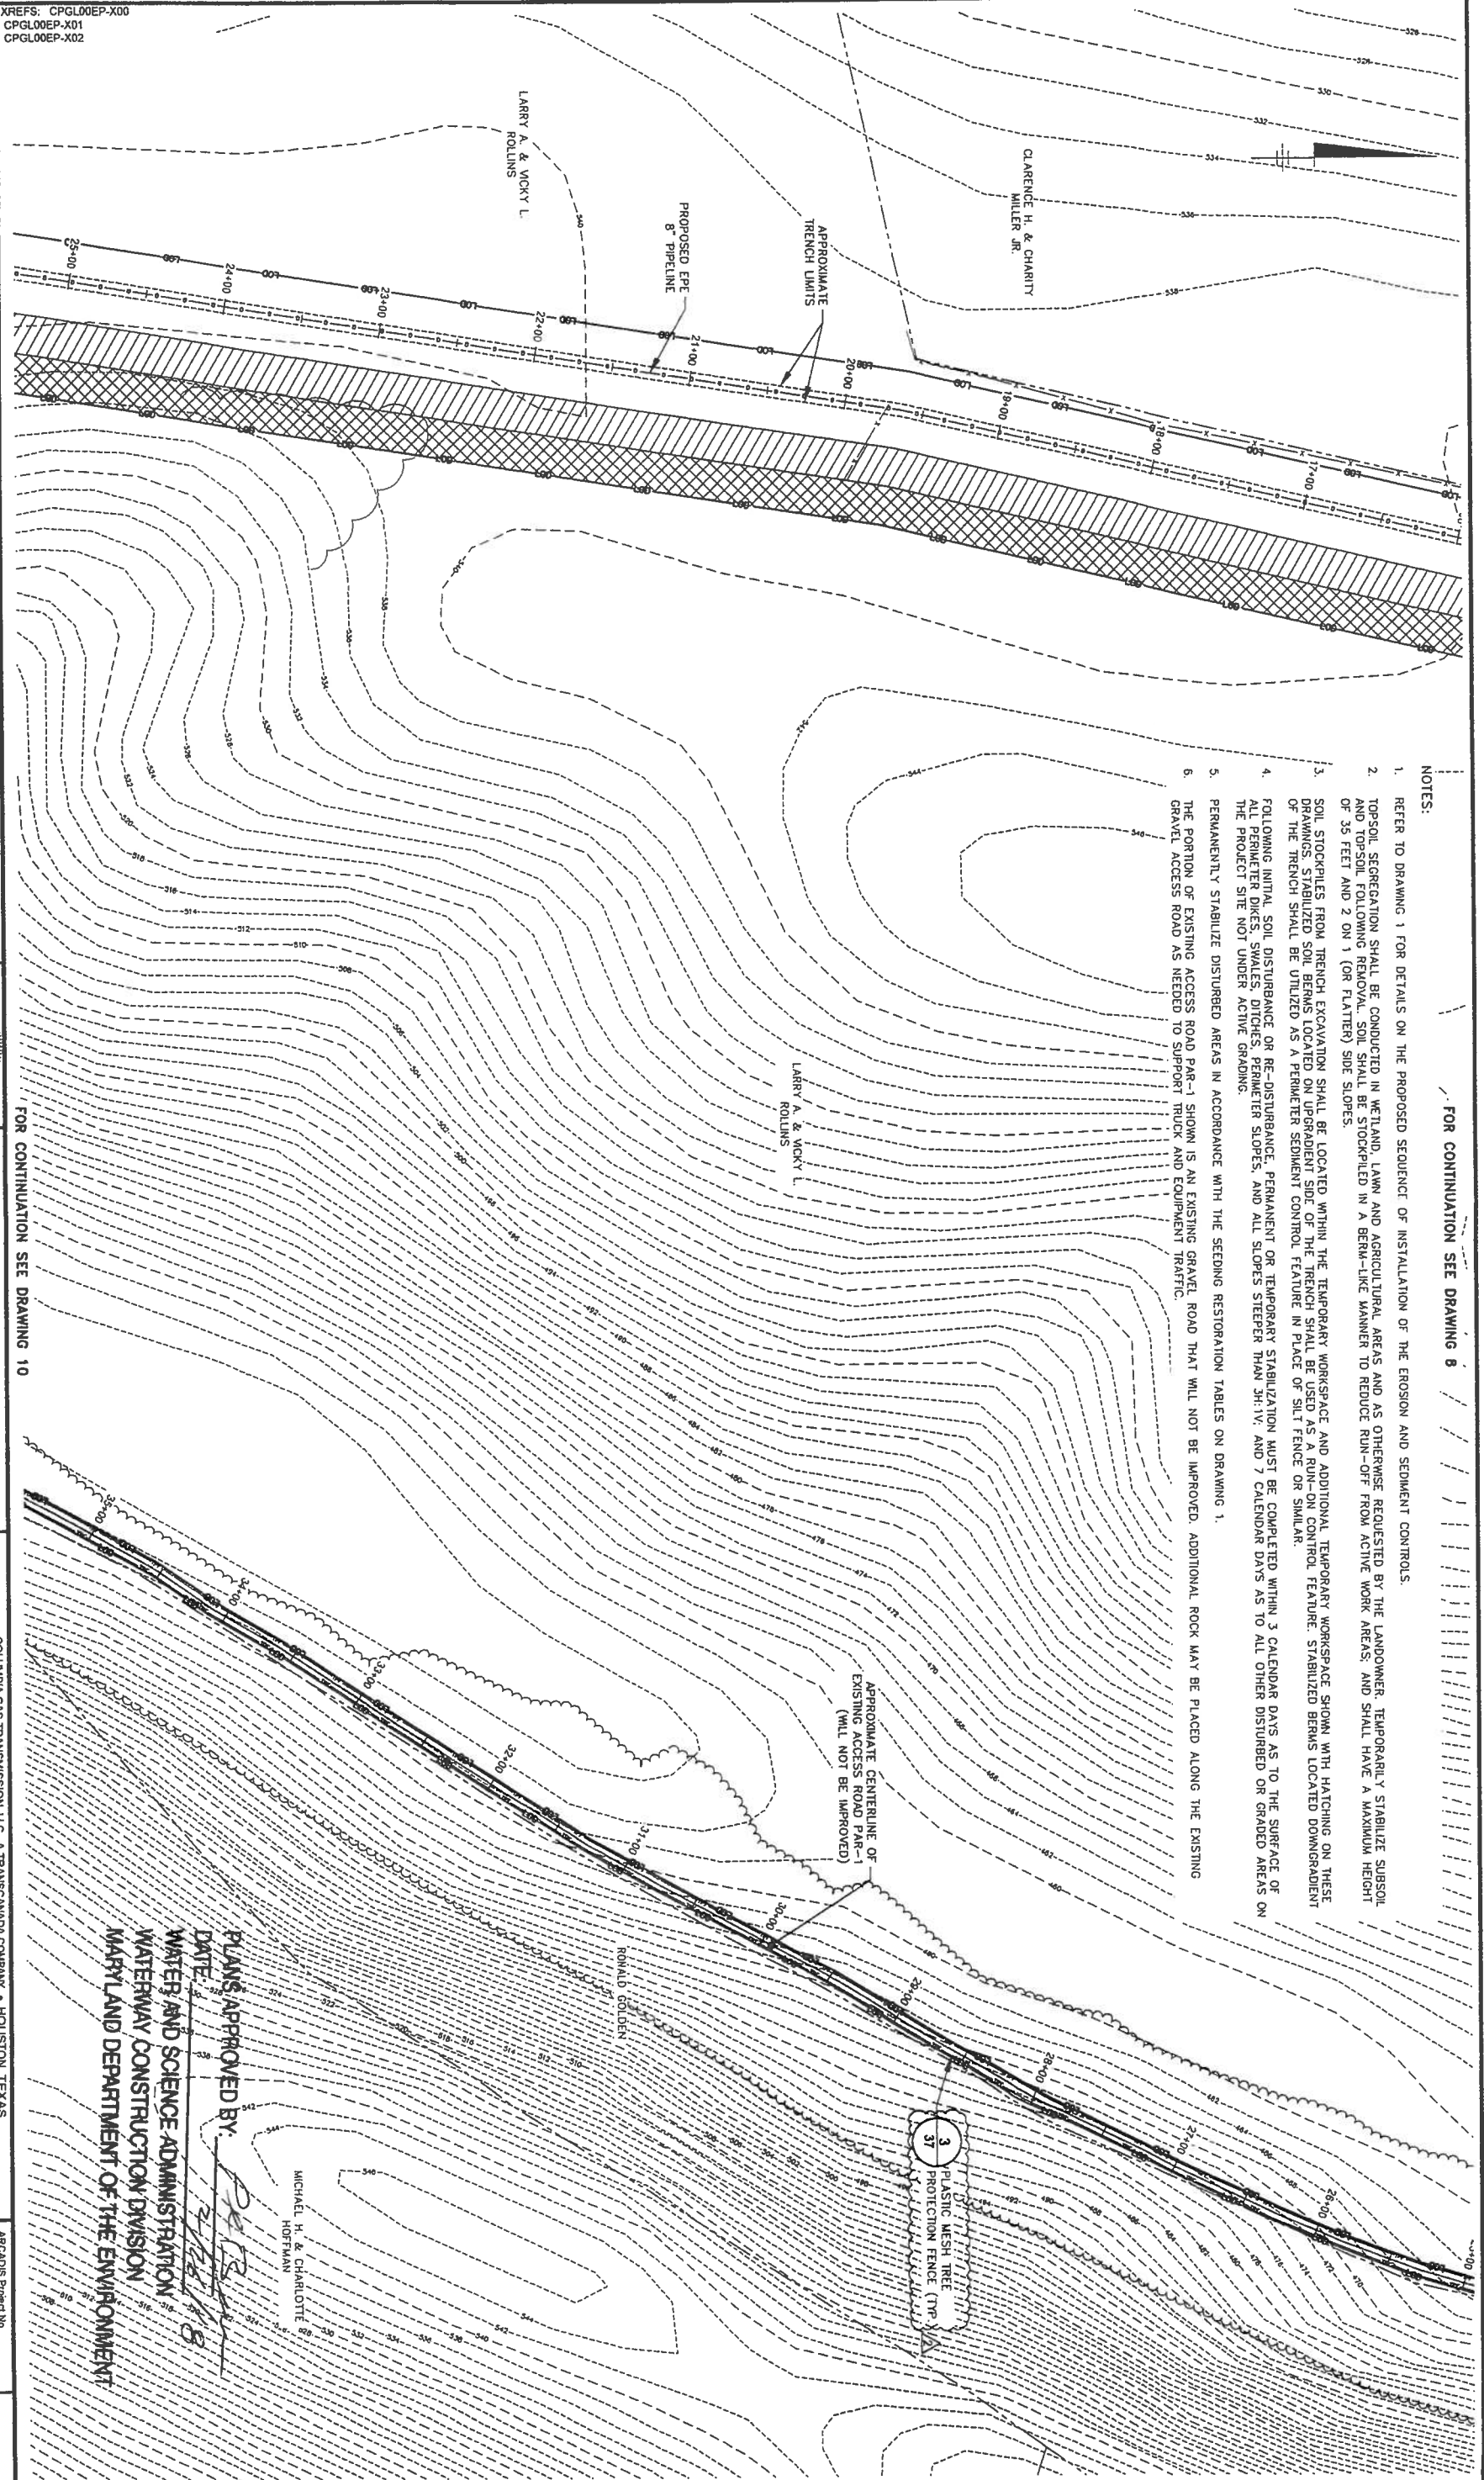

NOTES:

1. REFER TO DRAWING 1 FOR DETAILS ON THE PROPOSED SEQUENCE OF INSTALLATION OF THE EROSION AND SEDIMENT CONTROLS.
2. TOPSOIL SEGREGATION SHALL BE CONDUCTED IN WETLAND, LAWN AND AGRICULTURAL AREAS AND AS OTHERWISE REQUESTED BY THE LANDOWNER. TEMPORARILY STABILIZE SUBSOIL AND TOPSOIL FOLLOWING REMOVAL. SOIL SHALL BE STOCKPILED IN A BERM-LIKE MANNER TO REDUCE RUN-OFF FROM ACTIVE WORK AREAS, AND SHALL HAVE A MAXIMUM HEIGHT OF 35 FEET AND 2 ON 1 (OR FLATTER) SIDE SLOPES.
3. SOIL STOCKPILES FROM TRENCH EXCAVATION SHALL BE LOCATED WITHIN THE TEMPORARY WORKSPACE AND ADDITIONAL TEMPORARY WORKSPACE SHOWN WITH HATCHING ON THESE DRAWINGS. STABILIZED SOIL BERMS LOCATED ON UPGRADIENT SIDE OF THE TRENCH SHALL BE USED AS A RUN-ON CONTROL FEATURE. STABILIZED BERMS LOCATED DOWNGRADIENT OF THE TRENCH SHALL BE UTILIZED AS A PERIMETER SEDIMENT CONTROL.
4. FOLLOWING INITIAL SOIL DISTURBANCE OR RE-DISTURBANCE, PERMANENT OR TEMPORARY STABILIZATION MUST BE COMPLETED WITHIN 3 CALENDAR DAYS AS TO THE SURFACE OF ALL PERIMETER DIKES, SWALES, DITCHES, PERIMETER SLOPES, AND ALL SLOPES STEEPER THAN 3H:1V, AND 7 CALENDAR DAYS AS TO ALL OTHER DISTURBED OR GRADED AREAS ON THE PROJECT SITE NOT UNDER ACTIVE GRADING.
5. PERMANENTLY STABILIZE DISTURBED AREAS IN ACCORDANCE WITH THE SEEDING RESTORATION TABLES ON DRAWING 1.
6. THE PORTION OF EXISTING ACCESS ROAD PAR-1 SHOWN IS AN EXISTING GRAVEL ROAD THAT WILL NOT BE IMPROVED. ADDITIONAL ROCK MAY BE PLACED ALONG THE EXISTING GRAVEL ACCESS ROAD AS NEEDED TO SUPPORT TRUCK AND EQUIPMENT TRAFFIC.

FOR CONTINUATION SEE DRAWING 8

FOR CONTINUATION SEE DRAWING 10

PLANS APPROVED BY: *[Signature]*
 DATE: 2/28/18
 WATER AND SCIENCE ADMINISTRATION
 WATERWAY CONSTRUCTION DIVISION
 MARYLAND DEPARTMENT OF THE ENVIRONMENT

MICHAEL H. & CHARLOTTE
 HOFFMAN

THIS DRAWING IS THE PROPERTY OF THE ARCHADIS U.S., INC. AND MAY NOT BE REPRODUCED OR TRANSMITTED IN ANY FORM OR BY ANY MEANS, ELECTRONIC OR MECHANICAL, WITHOUT THE WRITTEN PERMISSION OF ARCHADIS U.S., INC.		
NO.	DATE	REVISIONS
1	7/7/17	FOREST CONSERVATION ACT REG. URMEMENT

Professional Engineer's Name	ALLEN LONG
Professional Engineer's No.	MD 34862
State	MD
Designed by	ALS
Drawn by	ALS
Checked by	ALS

ARCADIS
 Design & Consultancy
 for
 built assets

ARCADIS U.S., INC.

COLUMBIA GAS TRANSMISSION, L.L.C., A TRANSCANADA COMPANY • HOUSTON, TEXAS
 EASTERN PANHANDLE EXPANSION PROJECT

SITE PLAN (STA. 16+00 TO 25+50)


ARCADIS Project No.
 CPGL00EP-0001-0009A

Date
 MARCH 2017

ARCADIS
 501 N. 300
 Wexford, PA 15090
 Tel. 724.762.9180

NOTES:

1. REFER TO DRAWING 1 FOR DETAILS ON THE PROPOSED SEQUENCE OF INSTALLATION OF THE EROSION AND SEDIMENT CONTROL.
2. TOPSOIL SEPARATION SHALL BE CONDUCTED IN WETLAND, LAWN AND AGRICULTURAL AREAS AND AS OTHERWISE REQUESTED BY THE LANDOWNER. SOIL SHALL BE STOCKPILED IN A BERM-LIKE MANNER TO REDUCE RUN-OFF FROM ACTIVE WORK AREAS, AND SHALL HAVE A MAXIMUM HEIGHT OF 35 FEET AND 2 ON 1 (OR FLATTER) SIDE SLOPES.
3. SOIL STOCKPILES FROM TRENCH EXCAVATION SHALL BE LOCATED WITHIN THE TEMPORARY WORKSPACE AND ADDITIONAL TEMPORARY WORKSPACE SHOWN WITH HATCHING ON THESE DRAWINGS. STABILIZED SOIL BERMS LOCATED ON UPGRADIENT SIDE OF THE TRENCH SHALL BE USED AS A RUN-ON CONTROL FEATURE. STABILIZED BERMS LOCATED DOWNGRADENT OF THE TRENCH SHALL BE UTILIZED AS A PERIMETER SEDIMENT CONTROL FEATURE IN PLACE OF SILT FENCE OR SIMILAR.
4. FOLLOWING INITIAL SOIL DISTURBANCE OR RE-DISTURBANCE, PERMANENT OR TEMPORARY STABILIZATION MUST BE COMPLETED WITHIN 3 CALENDAR DAYS AS TO THE SHOULDER OF ALL PERIMETER DICES, SWALES, DITCHES, PERIMETER SLOPES, AND ALL SLOPES STEEPER THAN 3H:1V, AND 7 CALENDAR DAYS AS TO ALL OTHER DISTURBED OR GRADED AREAS ON THE PROJECT SITE NOT UNDER ACTIVE GRADING.
5. PERMANENTLY STABILIZE DISTURBED AREAS IN ACCORDANCE WITH THE SEEDING RESTORATION TABLES ON DRAWING 1.
6. THE PORTION OF EXISTING ACCESS ROAD PAR-1 SHOWN IS AN EXISTING GRAVEL ROAD THAT WILL NOT BE IMPROVED. ADDITIONAL ROCK MAY BE PLACED ALONG THE EXISTING GRAVEL ACCESS ROAD AS NEEDED TO SUPPORT TRUCK AND EQUIPMENT TRAFFIC.

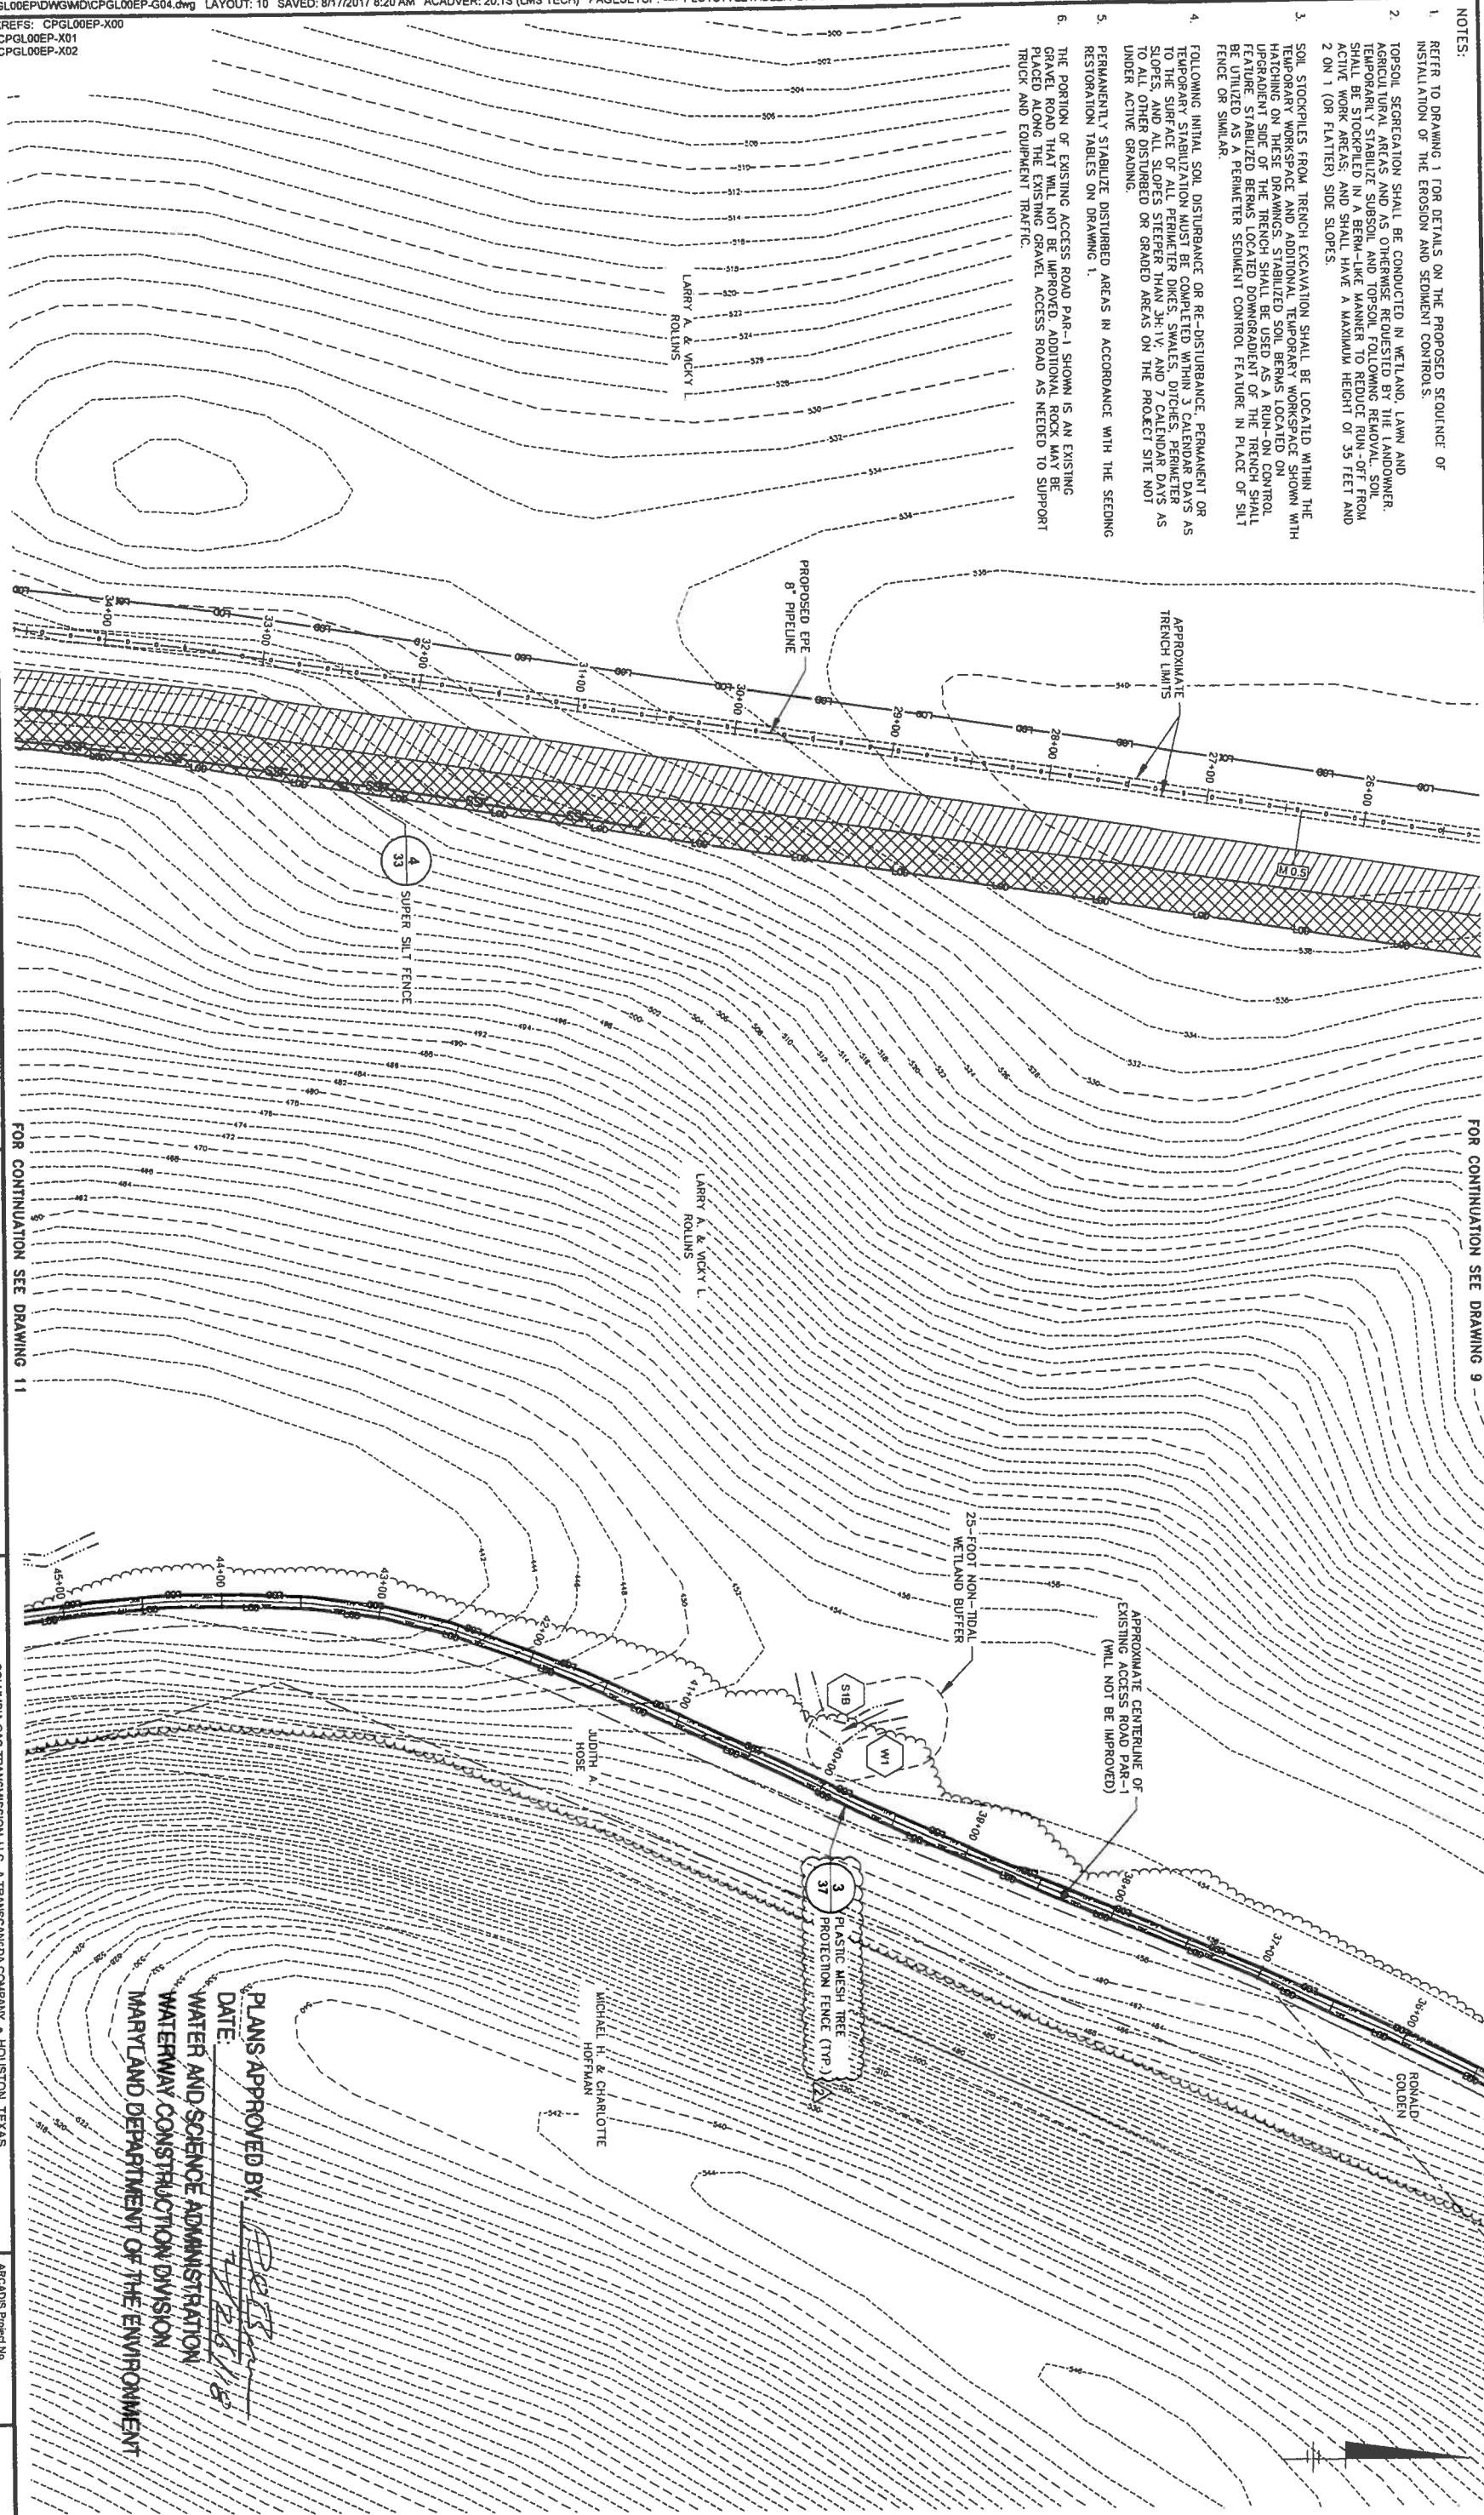

FOR CONTINUATION SEE DRAWING 9

FOR CONTINUATION SEE DRAWING 11

XREFS: CPGL00EP-X00 CPGL00EP-X01 CPGL00EP-X02	
1" = 50' 50' 0' 50' 100'	USE TO VERIFY REPRODUCTION SCALE
THIS DRAWING IS THE PROPERTY OF THE ARCHADIS U.S., INC. AND SHALL NOT BE REPRODUCED OR TRANSMITTED IN ANY FORM OR BY ANY MEANS, ELECTRONIC OR MECHANICAL, INCLUDING PHOTOCOPYING, RECORDING, OR BY ANY INFORMATION STORAGE AND RETRIEVAL SYSTEM, WITHOUT THE WRITTEN PERMISSION OF ARCHADIS U.S., INC.	THIS DRAWING IS THE PROPERTY OF THE ARCHADIS U.S., INC. AND SHALL NOT BE REPRODUCED OR TRANSMITTED IN ANY FORM OR BY ANY MEANS, ELECTRONIC OR MECHANICAL, INCLUDING PHOTOCOPYING, RECORDING, OR BY ANY INFORMATION STORAGE AND RETRIEVAL SYSTEM, WITHOUT THE WRITTEN PERMISSION OF ARCHADIS U.S., INC.
No. 77717 Date 7/7/17 FOREST CONSERVATION ACT REG. UMBREMENT	No. 77717 Date 7/7/17 FOREST CONSERVATION ACT REG. UMBREMENT
Professional Engineer's Name ALLEN LONG Professional Engineer's No. MD 34652	State MD
Date Signed Project Mgr. Checked By ARL	Date Signed Project Mgr. Checked By ARL



ARCADIS
 Design & Consultancy
 for natural and built assets


ARCADIS U.S., INC.

COLUMBIA GAS TRANSMISSION, LLC, A TRANSCANADA COMPANY • HOUSTON, TEXAS
 EASTERN PANHANDLE EXPANSION PROJECT
SITE PLAN (STA. 25+50 TO 34+50)

PLANS APPROVED BY: *[Signature]*
 DATE: 7/7/17
 WATER AND SCIENCE ADMINISTRATION
 WATERWAY CONSTRUCTION DIVISION
 MARYLAND DEPARTMENT OF THE ENVIRONMENT

ARCADIS Project No. CPGL00EP-0001-0009A
 DATE: MARCH 2017
 ARCADIS
 6041 Wallace Road Extension
 Suite 300
 Wexford, PA 15080
 Tel: 724.742.8180

- NOTES:**
1. REFER TO DRAWING 1 FOR DETAILS ON THE PROPOSED SEQUENCE OF INSTALLATION OF THE EROSION AND SEDIMENT CONTROLS.
 2. TOPSOIL SEGREGATION SHALL BE CONDUCTED IN WETLAND, LAWN AND AGRICULTURAL AREAS AND AS OTHERWISE REQUESTED BY THE LANDOWNER. TEMPORARILY STABILIZE SUBSOIL AND TOPSOIL FOLLOWING REMOVAL. SOIL SHALL BE STOCKPILED IN A BERM-LIKE MANNER TO REDUCE RUN-OFF FROM ACTIVE WORK AREAS; AND SHALL HAVE A MAXIMUM HEIGHT OF 35 FEET AND 2 ON 1 (OR FLATTER) SIDE SLOPES.
 3. SOIL STOCKPILES FROM TRENCH EXCAVATION SHALL BE LOCATED WITHIN THE TEMPORARY WORKSPACE AND ADDITIONAL TEMPORARY WORKSPACE SHOWN WITH HATCHING ON THESE DRAWINGS. STABILIZED SOIL BERMS LOCATED ON UPGRADIENT SIDE OF THE TRENCH SHALL BE USED AS A RUN-ON CONTROL FEATURE. STABILIZED BERMS LOCATED DOWNGRADIENT OF THE TRENCH SHALL BE UTILIZED AS A PERIMETER SEDIMENT CONTROL FEATURE IN PLACE OF SILT FENCE OR SIMILAR.
 4. FOLLOWING INITIAL SOIL DISTURBANCE OR RE-DISTURBANCE, PERMANENT OR TEMPORARY STABILIZATION MUST BE COMPLETED WITHIN 3 CALENDAR DAYS AS TO THE SURFACE OF ALL PERIMETER DICES, SWALES, DITCHES, PERIMETER SLOPES, AND ALL SLOPES STEEPER THAN 3H:1V, AND 7 CALENDAR DAYS AS TO ALL OTHER DISTURBED OR GRADED AREAS ON THE PROJECT SITE NOT UNDER ACTIVE GRADING.
 5. PERMANENTLY STABILIZE DISTURBED AREAS IN ACCORDANCE WITH THE SEEDING RESTORATION TABLES ON DRAWING 1.
 6. THE PORTION OF EXISTING ACCESS ROAD PAR-1 SHOWN IS AN EXISTING GRAVEL ROAD THAT WILL NOT BE IMPROVED. ADDITIONAL ROCK MAY BE PLACED ALONG THE EXISTING GRAVEL ACCESS ROAD AS NEEDED TO SUPPORT TRUCK AND EQUIPMENT TRAFFIC.
 7. DISTURBANCE ACTIVITIES WITHIN PORTIONS OF THE LIMIT OF DISTURBANCE BETWEEN HORIZONTAL DIRECTIONAL DRILLING ENTRY/EXIT LOCATIONS WILL CONSIST OF TREE CLEARING ONLY. EQUIPMENT ACCESS TO THESE AREAS WILL BE REQUIRED.
 8. ACTUAL LOCATIONS OF STABILIZED CONSTRUCTION ENTRANCES MAY BE ADJUSTED BASED ON FIELD CONDITIONS AT THE TIME OF CONSTRUCTION.

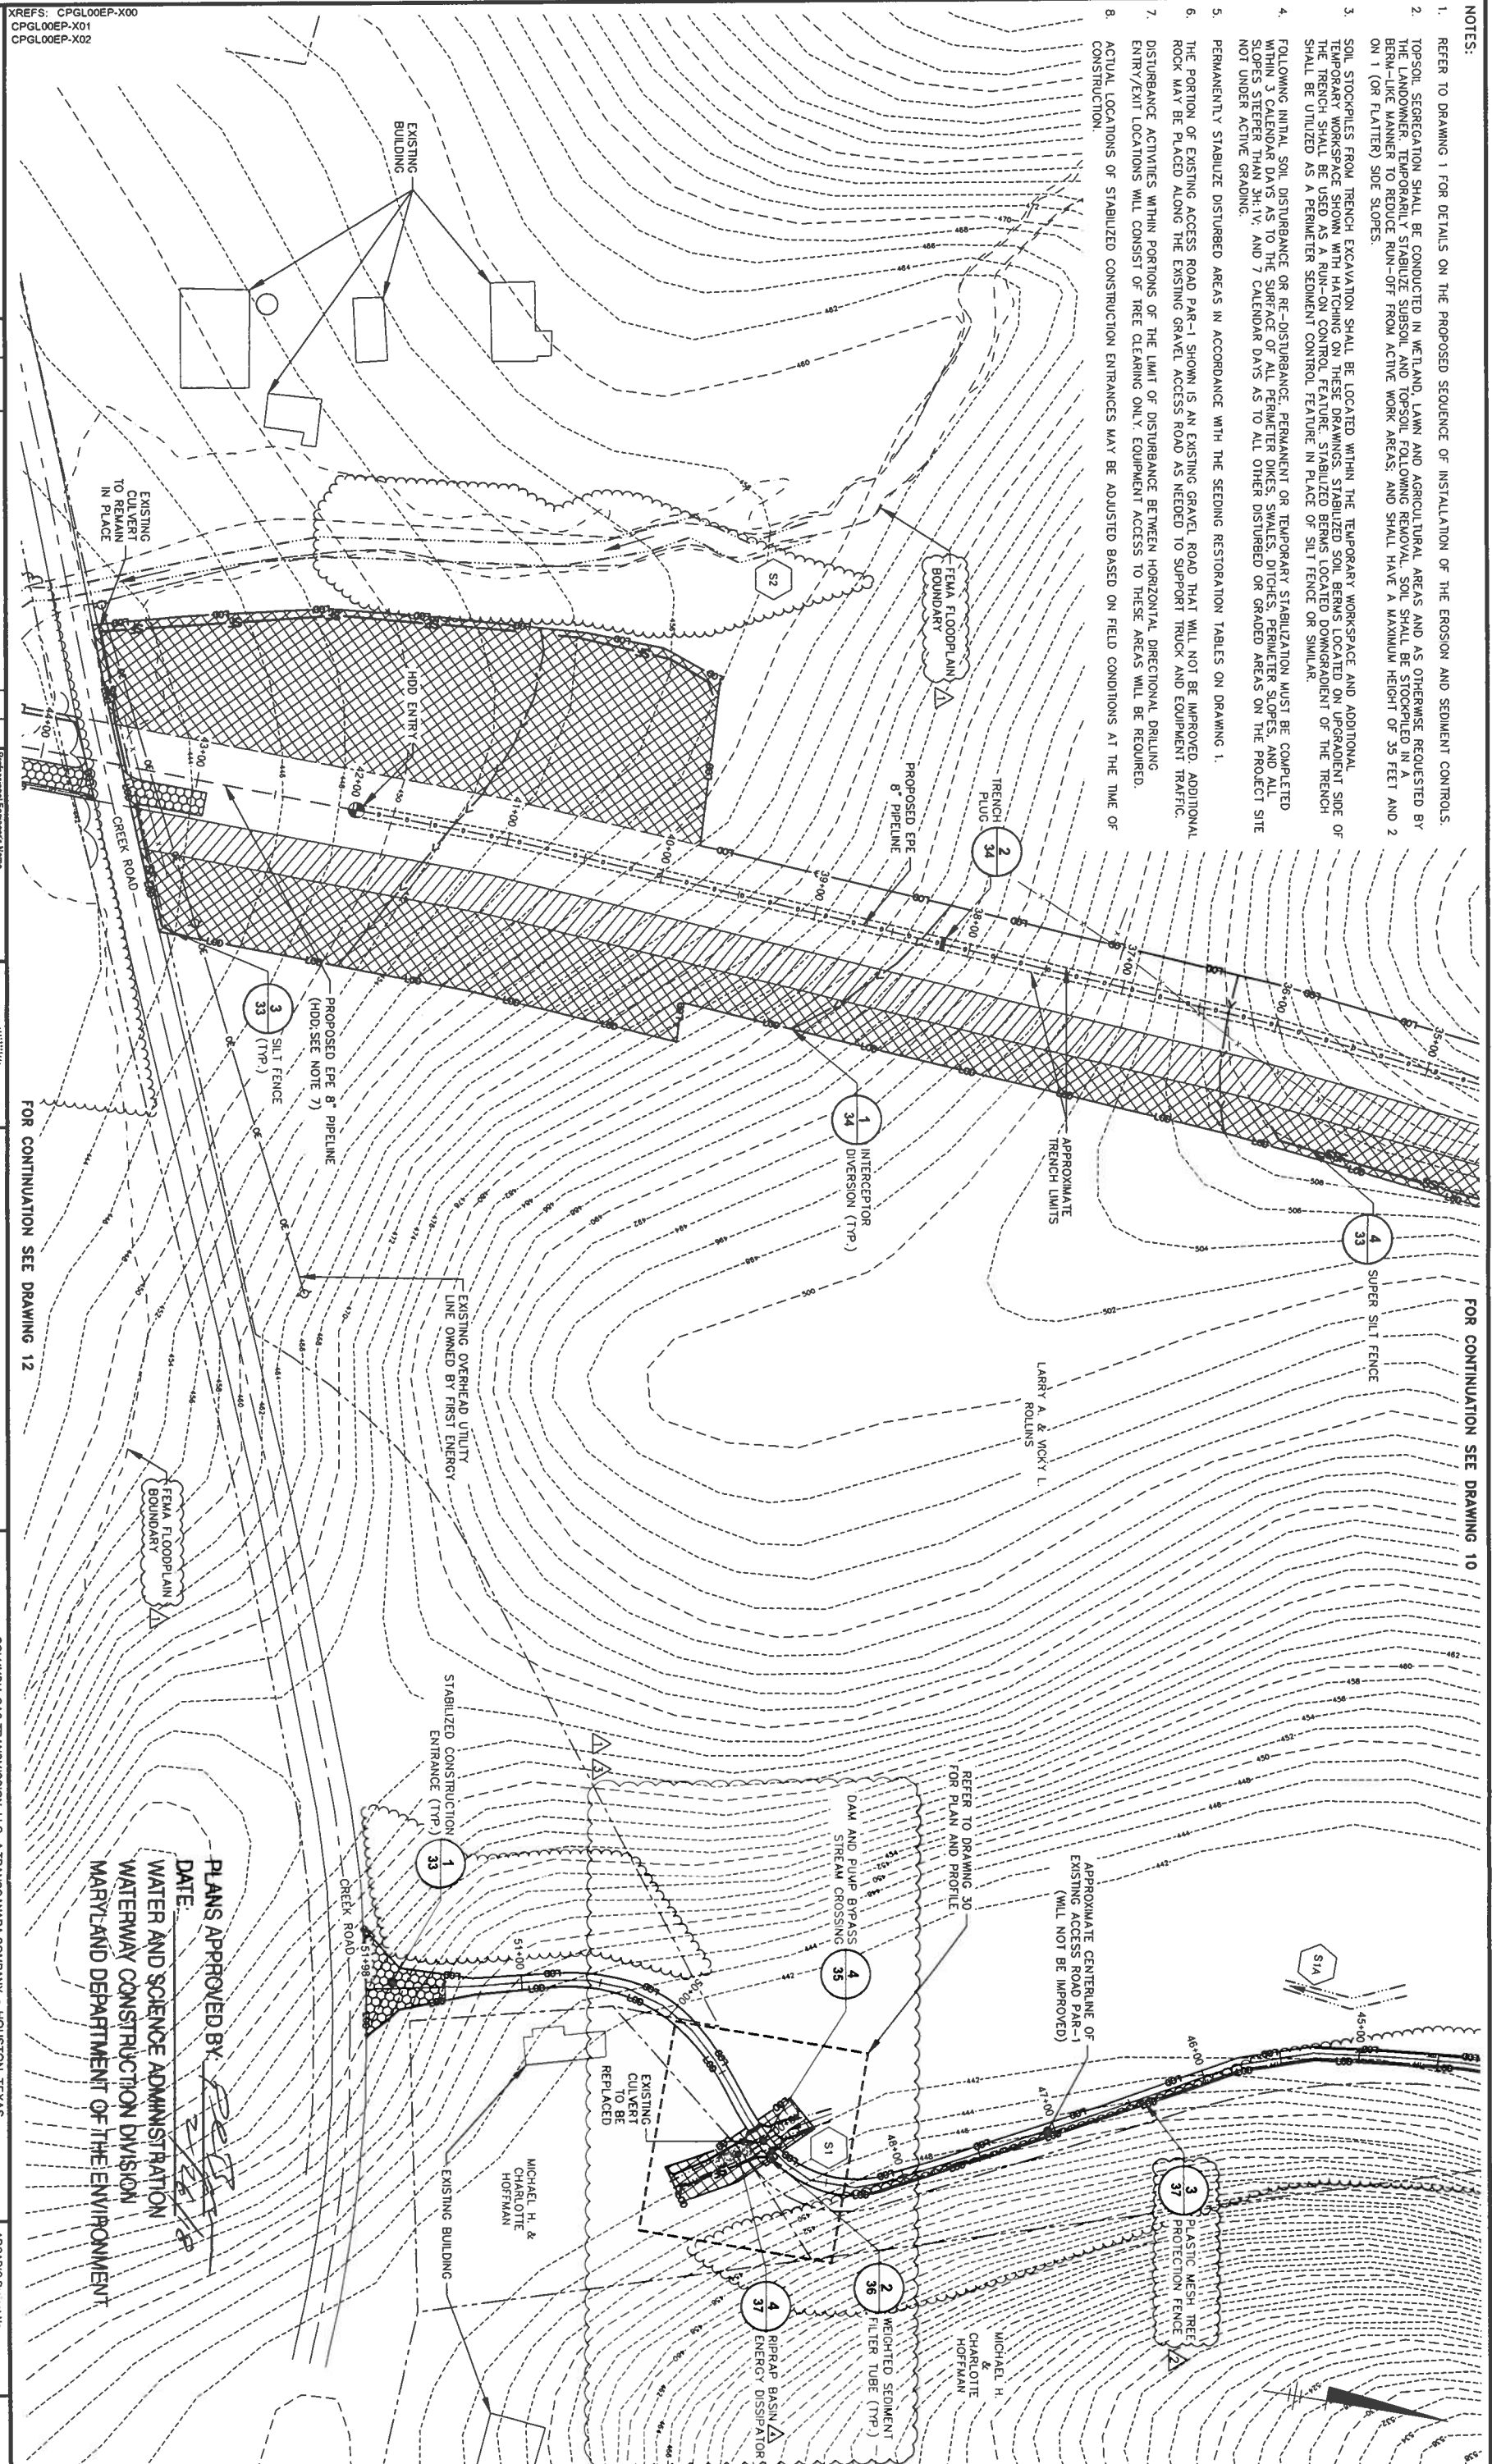

KREFS: CPGL00EP-X00
 CPGL00EP-X01
 CPGL00EP-X02

THIS BAR REPRESENTS ONE INCH ON THE ORIGINAL DRAWING

USE TO VERIFY REPRODUCTION SCALE

No.	Date	Revisions

THIS DRAWING IS THE PROPERTY OF THE ARCHADES ENGINEERING AND DESIGN, INC. AND SHALL NOT BE REPRODUCED OR TRANSMITTED IN ANY FORM OR BY ANY MEANS, ELECTRONIC OR MECHANICAL, WITHOUT PERMISSION OF ARCHADES ENGINEERING AND DESIGN, INC.

Professional Engineer's Name	Allen Long
Professional Engineer's No.	MD 34802
State	MD
Designed by	ARL
Drawn by	ARL
Checked by	
Project No.	
Date	

ARCADIS
 Design & Consultancy
 for natural and built assets

ARCADIS U.S., INC.
 COLUMBIA GAS TRANSMISSION, LLC, A TRANSCANADA COMPANY • HOUSTON, TEXAS
 EASTERN PANHANDLE EXPANSION PROJECT


SITE PLAN (STA. 34+50 TO 44+00)

PLANS APPROVED BY: [Signature]
 DATE: [Date]
 WATER AND SCIENCE ADMINISTRATION
 WATERWAY CONSTRUCTION DIVISION
 MARYLAND DEPARTMENT OF THE ENVIRONMENT

ARCADIS Project No. CPGL00EP 0001 0008A
 Date: MARCH 2017
 ARCADIS
 6041 Wallace Road Extension
 Suite 300
 Wexford, PA 15090
 Tel: 724 742 9180

XREFS: CPGL00EP-X00
 CPGL00EP-X01
 CPGL00EP-X02

- NOTES:
1. REFER TO DRAWING 1 FOR DETAILS ON THE PROPOSED SEQUENCE OF INSTALLATION OF THE EROSION AND SEDIMENT CONTROLS.
 2. TOPSOIL SEGREGATION SHALL BE CONDUCTED IN WETLAND, LAWN AND AGRICULTURAL AREAS AND AS OTHERWISE REQUESTED BY THE LANDOWNER. TEMPORARILY STABILIZE SUBSOIL AND TOPSOIL FOLLOWING REMOVAL. SOIL SHALL BE STOCKPILED IN A BERTERRE MANNER TO REDUCE RUN-OFF FROM ACTIVE WORK AREAS, AND SHALL HAVE A MAXIMUM HEIGHT OF 35 FEET AND 2 ON 1 (OR FLATTER) SIDE SLOPES.
 3. SOIL STOCKPILES FROM TRENCH EXCAVATION SHALL BE LOCATED WITHIN THE TEMPORARY WORKSPACE AND ADDITIONAL TEMPORARY WORKSPACE SHOWN WITH HATCHING ON THESE DRAWINGS. STOCKPILED SOIL BEARS LOCATED ON UPRADIANT SIDE OF THE TRENCH SHALL BE USED AS A RUN-ON CONTROL FEATURE. STOCKPILED DOWNGRADIENT OF THE TRENCH SHALL BE UTILIZED AS A PERIMETER SEDIMENT CONTROL FEATURE IN PLACE OF SILT FENCE OR SIMILAR.
 4. FOLLOWING INITIAL SOIL DISTURBANCE OR RE-DISTURBANCE, PERMANENT OR TEMPORARY STABILIZATION MUST BE COMPLETED WITHIN 3 CALENDAR DAYS AS TO THE SURFACE OF ALL PERIMETER DIKES, SWALES, DITCHES, PERIMETER SLOPES, AND ALL SLOPES STEEPER THAN 3H:1V, AND 7 CALENDAR DAYS AS TO ALL OTHER DISTURBED OR GRADED AREAS ON THE PROJECT SITE NOT UNDER ACTIVE GRADING.
 5. PERMANENTLY STABILIZE DISTURBED AREAS IN ACCORDANCE WITH THE SEEDING RESTORATION TABLES ON DRAWING 1.
 6. DISTURBANCE ACTIVITIES WITHIN PORTIONS OF THE LIMIT OF DISTURBANCE BETWEEN HORIZONTAL DIRECTIONAL DRILLING ENTRY/EXIT LOCATIONS WILL CONSIST OF TREE CLEARING ONLY. EQUIPMENT ACCESS TO THESE AREAS WILL BE REQUIRED.
 7. SOIL STABILIZATION MATTING HAS BEEN PROPOSED ON SLOPES STEEPER THAN 3H:1V.

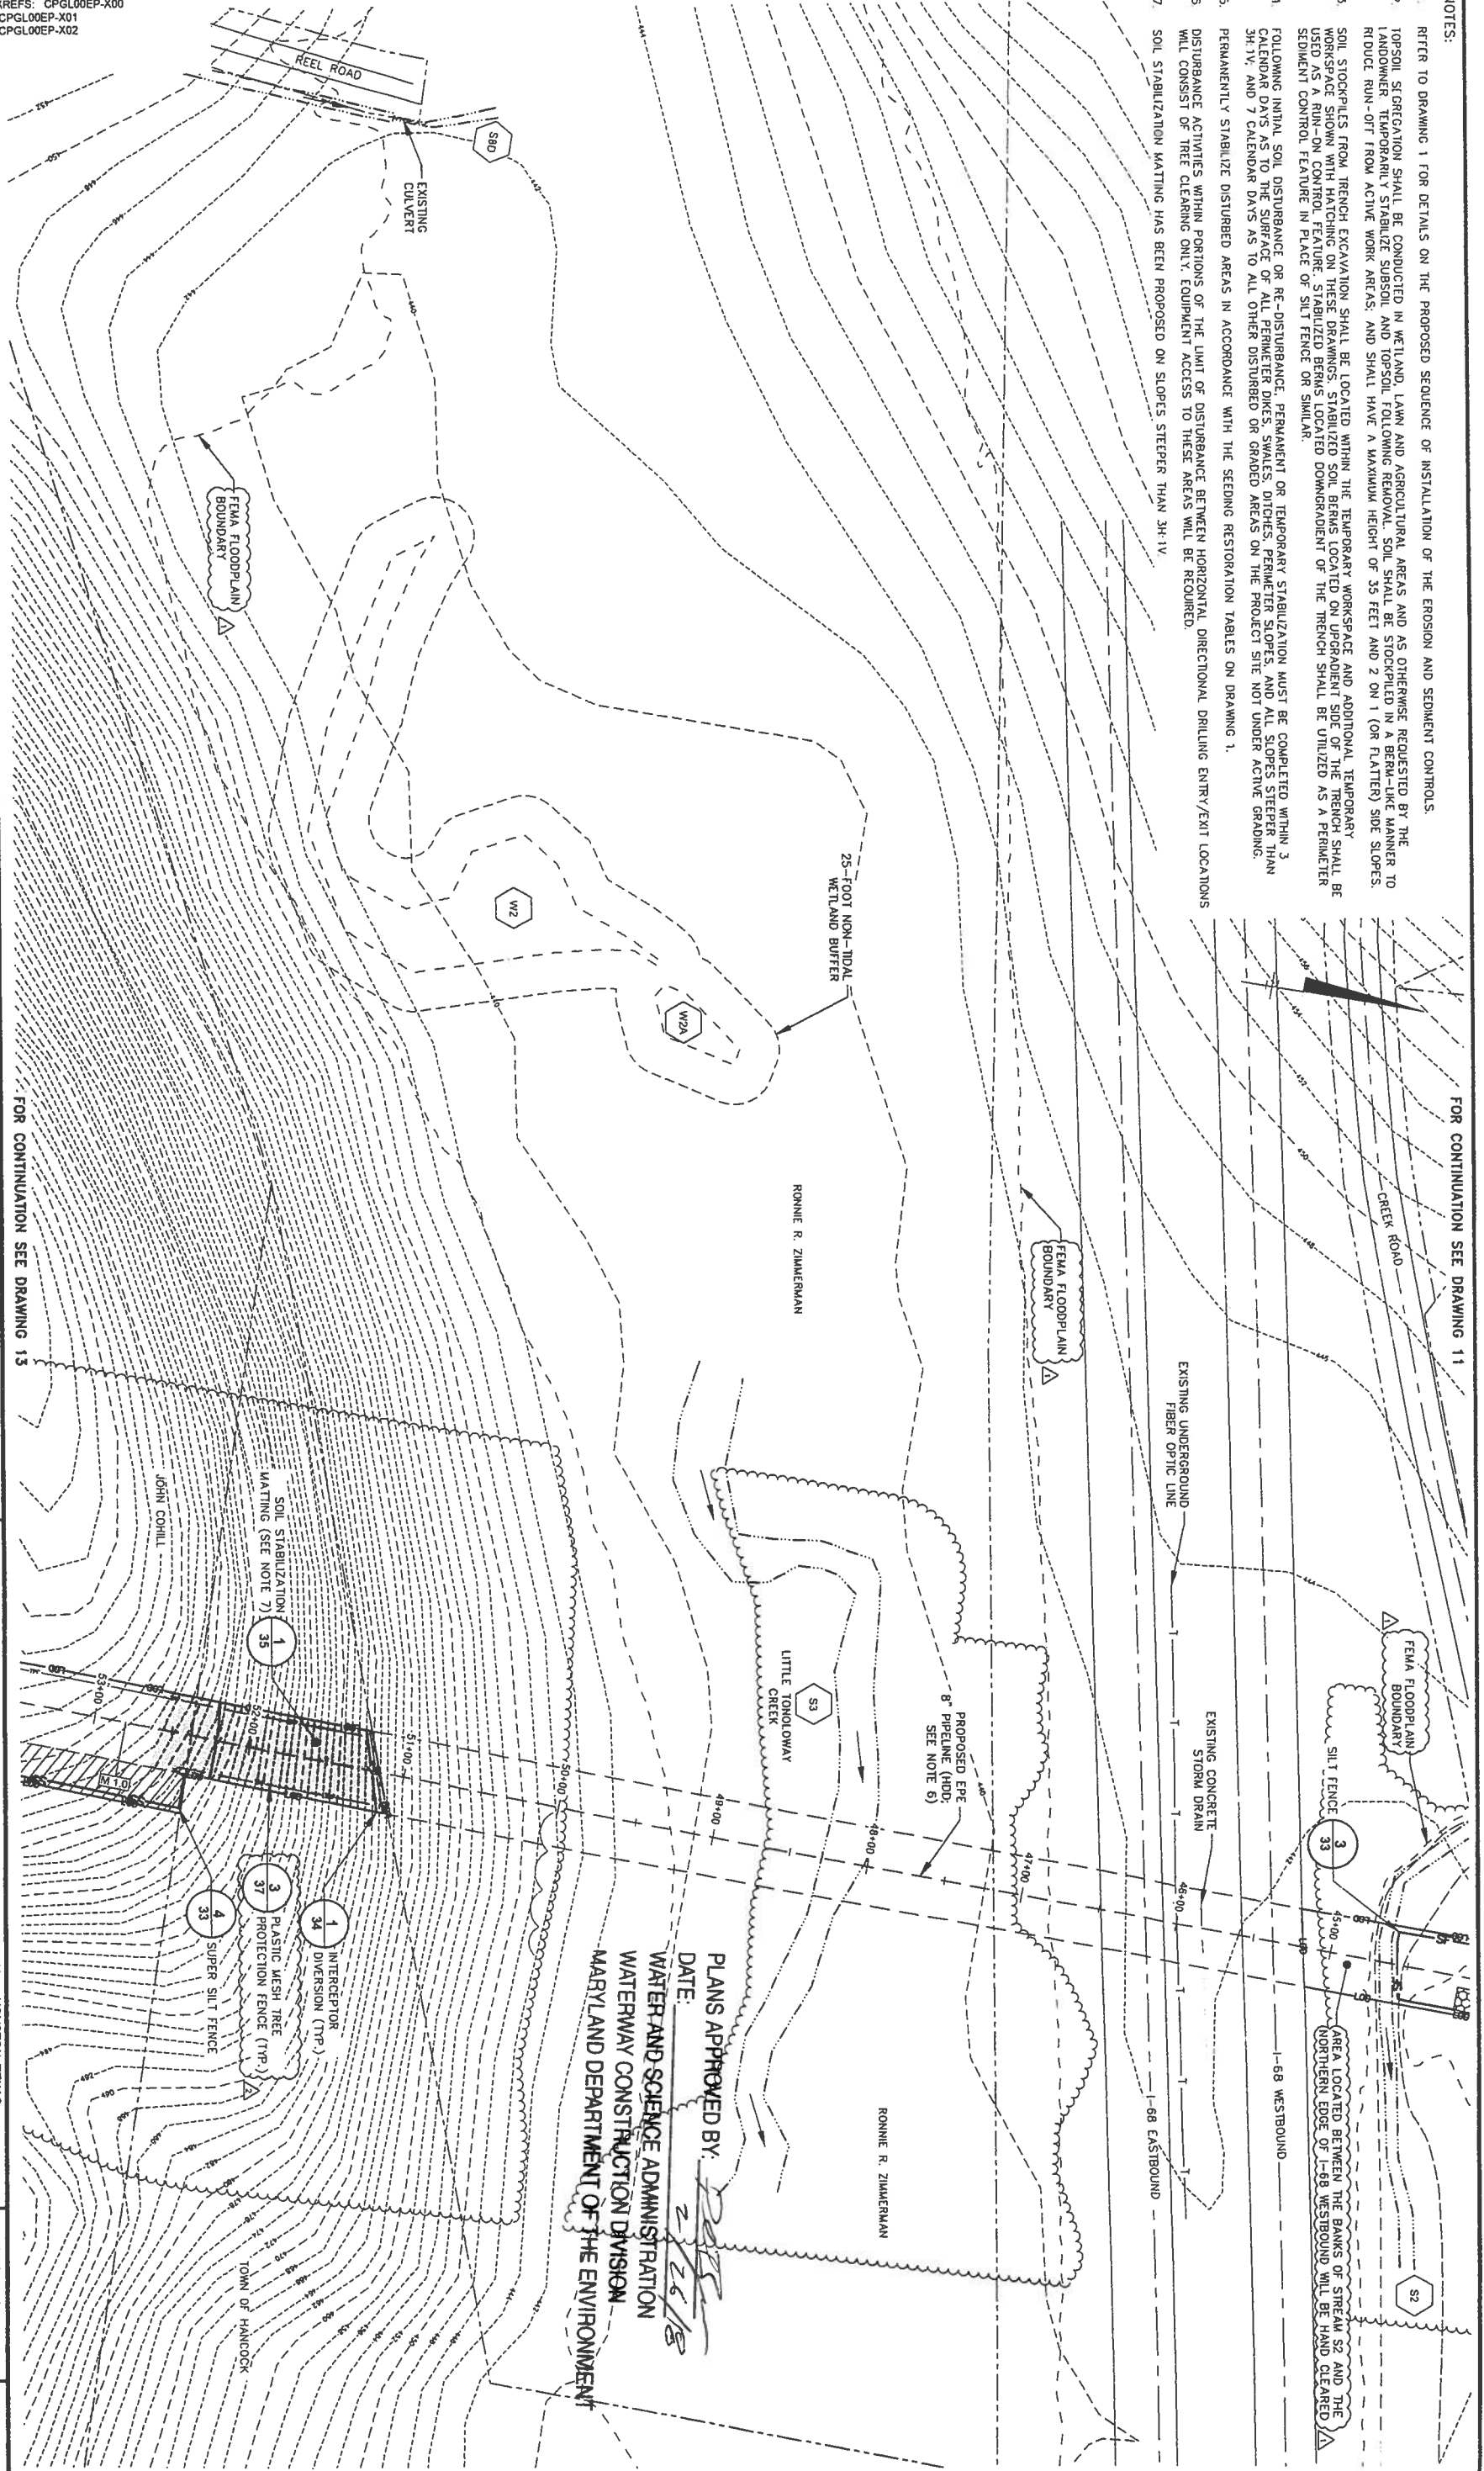

FOR CONTINUATION SEE DRAWING 11

FOR CONTINUATION SEE DRAWING 13

THIS DRAWING REPRESENTS ONE ORIGINAL DRAWING

USE TO VERIFY REFERENCE SCALE

NO.	DATE	DESCRIPTION	BY	CHKD
1	7/27/17	FOREST CONSERVATION ACT REQUIREMENT	ALS	JARL
2	7/27/17	FOREST COMMENT RESPONSE	ALS	JARL

Professional Engineer's Name: **ALLEN LONG**
 Professional Engineer's No.: MD 34862

Project No.: 16-2482-01
 Project Name: EASTERN PANHANDLE EXPANSION PROJECT

Drawn by: ALS
 Checked by: JARL



ARCADIS
 Design & Consultancy
 for natural and built assets

ARCADIS U.S., INC.

COLUMBIA GAS TRANSMISSION, LLC, A TRANSCANADA COMPANY • HOUSTON, TEXAS
 EASTERN PANHANDLE EXPANSION PROJECT

SITE PLAN (STA. 44+00 TO 53+50)

ARCADIS Project No.: CPGL00EP-0001-0008A
 Date: MARCH 2017


ARCADIS
 6041 Wabash Road Extension
 Wexford, PA 15090
 Tel: 724.742.9180

XREFS: CPGL00EP-X00
CPGL00EP-X01
CPGL00EP-X02


FOR CONTINUATION SEE DRAWING 12

- NOTES:
1. REFER TO DRAWING 1 FOR DETAILS ON THE PROPOSED SEQUENCE OF INSTALLATION OF THE EROSION AND SEDIMENT CONTROLS.
 2. TOPSOIL SEGREGATION SHALL BE CONDUCTED IN WETLAND, LAWN AND AGRICULTURAL AREAS AND AS OTHERWISE REQUESTED BY THE LANDOWNER. TEMPORARILY STABILIZE SUBSOIL AND TOPSOIL FOLLOWING REMOVAL. SOIL SHALL BE STOCKPILED IN A BERM-LIKE MANNER TO REDUCE RUN-OFF FROM ACTIVE WORK AREAS, AND SHALL HAVE A MAXIMUM HEIGHT OF 35 FEET AND 2 ON 1 (OR FLATTER) SIDE SLOPES.
 3. SOIL STOCKPILES FROM TRENCH EXCAVATION SHALL BE LOCATED WITHIN THE TEMPORARY WORKSPACE AND ADDITIONAL TEMPORARY WORKSPACE SHOWN WITH HATCHING ON THESE DRAWINGS. STABILIZED SOIL BERMS LOCATED ON UPGRADIENT SIDE OF THE TRENCH SHALL BE USED AS A RUN-ON CONTROL FEATURE. STABILIZED BERMS LOCATED DOWNGRADIENT OF THE TRENCH SHALL BE UTILIZED AS A PERIMETER SEDIMENT CONTROL FEATURE IN PLACE OF SILT FENCE OR SIMILAR.
 4. FOLLOWING INITIAL SOIL DISTURBANCE OR RE-DISTURBANCE, PERMANENT OR TEMPORARY STABILIZATION MUST BE COMPLETED WITHIN 3 CALENDAR DAYS AS TO THE SURFACE OF ALL PERIMETER DIKES, SWALES, DITCHES, PERIMETER SLOPES, AND ALL SLOPES STEEPER THAN 3H:1V, AND 7 CALENDAR DAYS AS TO ALL OTHER DISTURBED OR GRADED AREAS ON THE PROJECT SITE NOT UNDER ACTIVE GRADING.
 5. PERMANENTLY STABILIZE DISTURBED AREAS IN ACCORDANCE WITH THE SEEDING RESTORATION TABLES ON DRAWING 1.
 6. DISTURBANCE ACTIVITIES WITHIN PORTIONS OF THE LIMIT OF DISTURBANCE BETWEEN HORIZONTAL DIRECTIONAL DRILLING ENTRY/EXIT LOCATIONS WILL CONSIST OF TREE CLEARING ONLY. EQUIPMENT ACCESS TO THESE AREAS WILL BE REQUIRED.
 7. SOIL STABILIZATION MATING HAS BEEN PROPOSED ON SLOPES STEEPER THAN 3H:1V.
 8. PROPOSED PERMANENT ACCESS ROAD PAR-2 IS AN EXISTING FARM ROAD THAT WILL BE STABILIZED WITH STONE TO FACILITATE TRUCK AND EQUIPMENT TRAFFIC.

PLANS APPROVED BY: *[Signature]*
DATE: 8/16/17
WATER AND SCIENCE ADMINISTRATION
WATERWAY CONSTRUCTION DIVISION
MARYLAND DEPARTMENT OF THE ENVIRONMENT

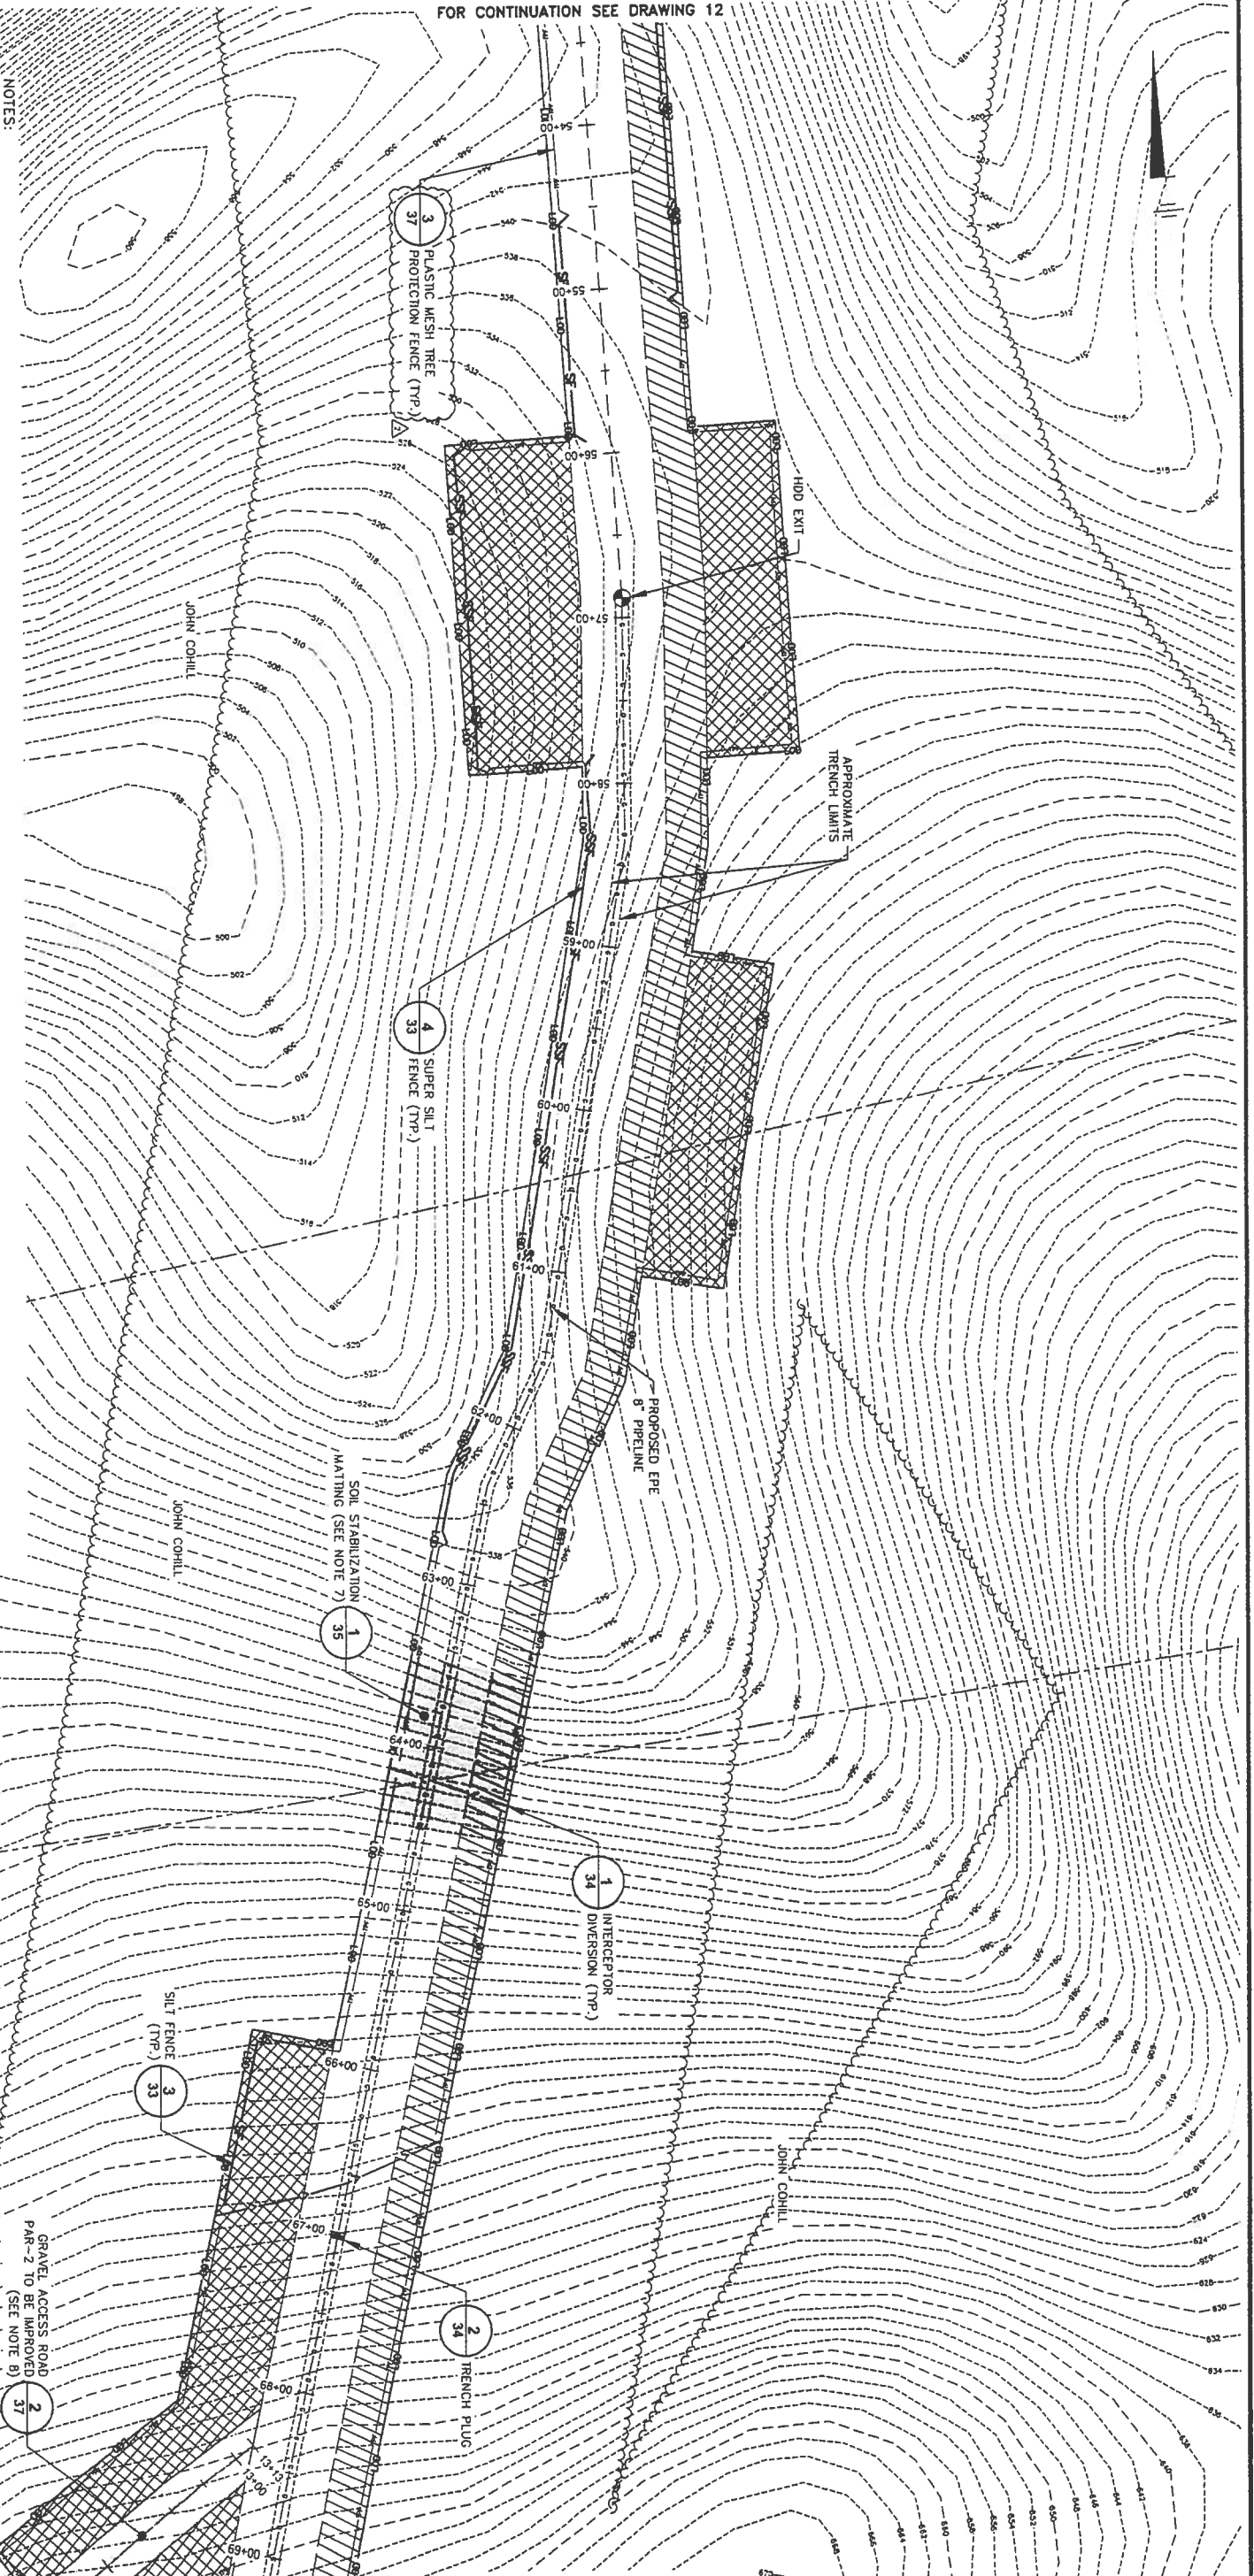

FOR CONTINUATION SEE DRAWING 14

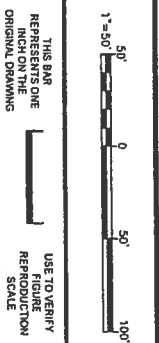

NO.	DATE	REVISIONS	BY	CHKD
1	7/17/17	FOREST CONSERVATION ACT RE-ALIGNMENT	ALS	ARL

Professional Engineer's Name
ALLEN LONG
Professional Engineer No.
MD 34862



ARCADIS U.S., INC.
Design & Consultancy
for Federal and
State Agencies
BID # 15353

COLUMBIA GAS TRANSMISSION, LLC, A TRANSCANADA COMPANY • HOUSTON, TEXAS
EASTERN PANHANDLE EXPANSION PROJECT
SITE PLAN (STA. 53+50 TO 69+00)


ARCADIS Project No.
CPGL00EP-0001-0008A
Date
MARCH 2017
ARCADIS
6041 Wallace Road Extension
Suite 200
Wexford, PA 15090
Tel: 724.762.8180

XREFS: CPGL00EP-X00
 CPGL00EP-X01
 CPGL00EP-X02

- NOTES:**
1. REFER TO DRAWING 1 FOR DETAILS ON THE PROPOSED SEQUENCE OF INSTALLATION OF THE EROSION AND SEDIMENT CONTROLS.
 2. TOPSOIL SEGREGATION SHALL BE CONDUCTED IN WETLAND, LAWN AND AGRICULTURAL AREAS AND AS OTHERWISE REQUESTED BY THE LANDOWNER. TEMPORARILY STABILIZE SUBSOIL AND TOPSOIL FOLLOWING REMOVAL. SOIL SHALL BE STOCKPILED IN A BERM-LIKE MANNER TO REDUCE RUN-OFF FROM ACTIVE WORK AREAS. AND SHALL HAVE A MAXIMUM HEIGHT OF 35 FEET AND 2 ON 1 (OR FLATTER) SIDE SLOPES.
 3. INTERCEPTOR DIVERSIONS LOCATED IN RESIDENTIAL AREAS AND AGRICULTURAL FIELDS SHALL BE REMOVED DURING FINAL GRADING. INTERCEPTOR DIVERSIONS THAT CAN BE LEFT IN PLACE, AT THE LANDOWNER'S DISCRETION, SHALL BE VEGETATED.
 4. SOIL STOCKPILES FROM TRENCH EXCAVATION SHALL BE LOCATED WITHIN THE TEMPORARY WORKSPACE AND ADDITIONAL TEMPORARY WORKSPACE SHOWN WITH HATCHING ON THESE DRAWINGS. STABILIZED SOIL BERMS LOCATED ON UPGRADIENT SIDE OF THE TRENCH SHALL BE USED AS A RUN-ON CONTROL FEATURE. STABILIZED BERMS LOCATED DOWNGRADIENT OF THE TRENCH SHALL BE UTILIZED AS A PERIMETER SEDIMENT CONTROL FEATURE IN PLACE OF SILT FENCE OR SIMILAR.
 5. FOLLOWING INITIAL SOIL DISTURBANCE OR RE-DISTURBANCE, PERMANENT OR TEMPORARY STABILIZATION MUST BE COMPLETED WITHIN 3 CALENDAR DAYS AS TO THE SURFACE OF ALL PERMETER DIKES, SWALES, DITCHES, PERMETER SLOPES, AND ALL SLOPES STEEPER THAN 3H:1V, AND 7 CALENDAR DAYS AS TO ALL OTHER DISTURBED OR GRADED AREAS ON THE PROJECT SITE NOT UNDER ACTIVE GRADING.
 6. PERMANENTLY STABILIZE DISTURBED AREAS IN ACCORDANCE WITH THE SEDIMENT RESTORATION TABLES ON DRAWING 1.
 7. PROPOSED PERMANENT ACCESS ROAD PAR-2 WILL BE IMPROVED BY GRADING AND STABILIZED WITH STONE TO FACILITATE TRUCK AND EQUIPMENT TRAFFIC.



FOR CONTINUATION SEE DRAWING 15

FOR CONTINUATION SEE DRAWING 13

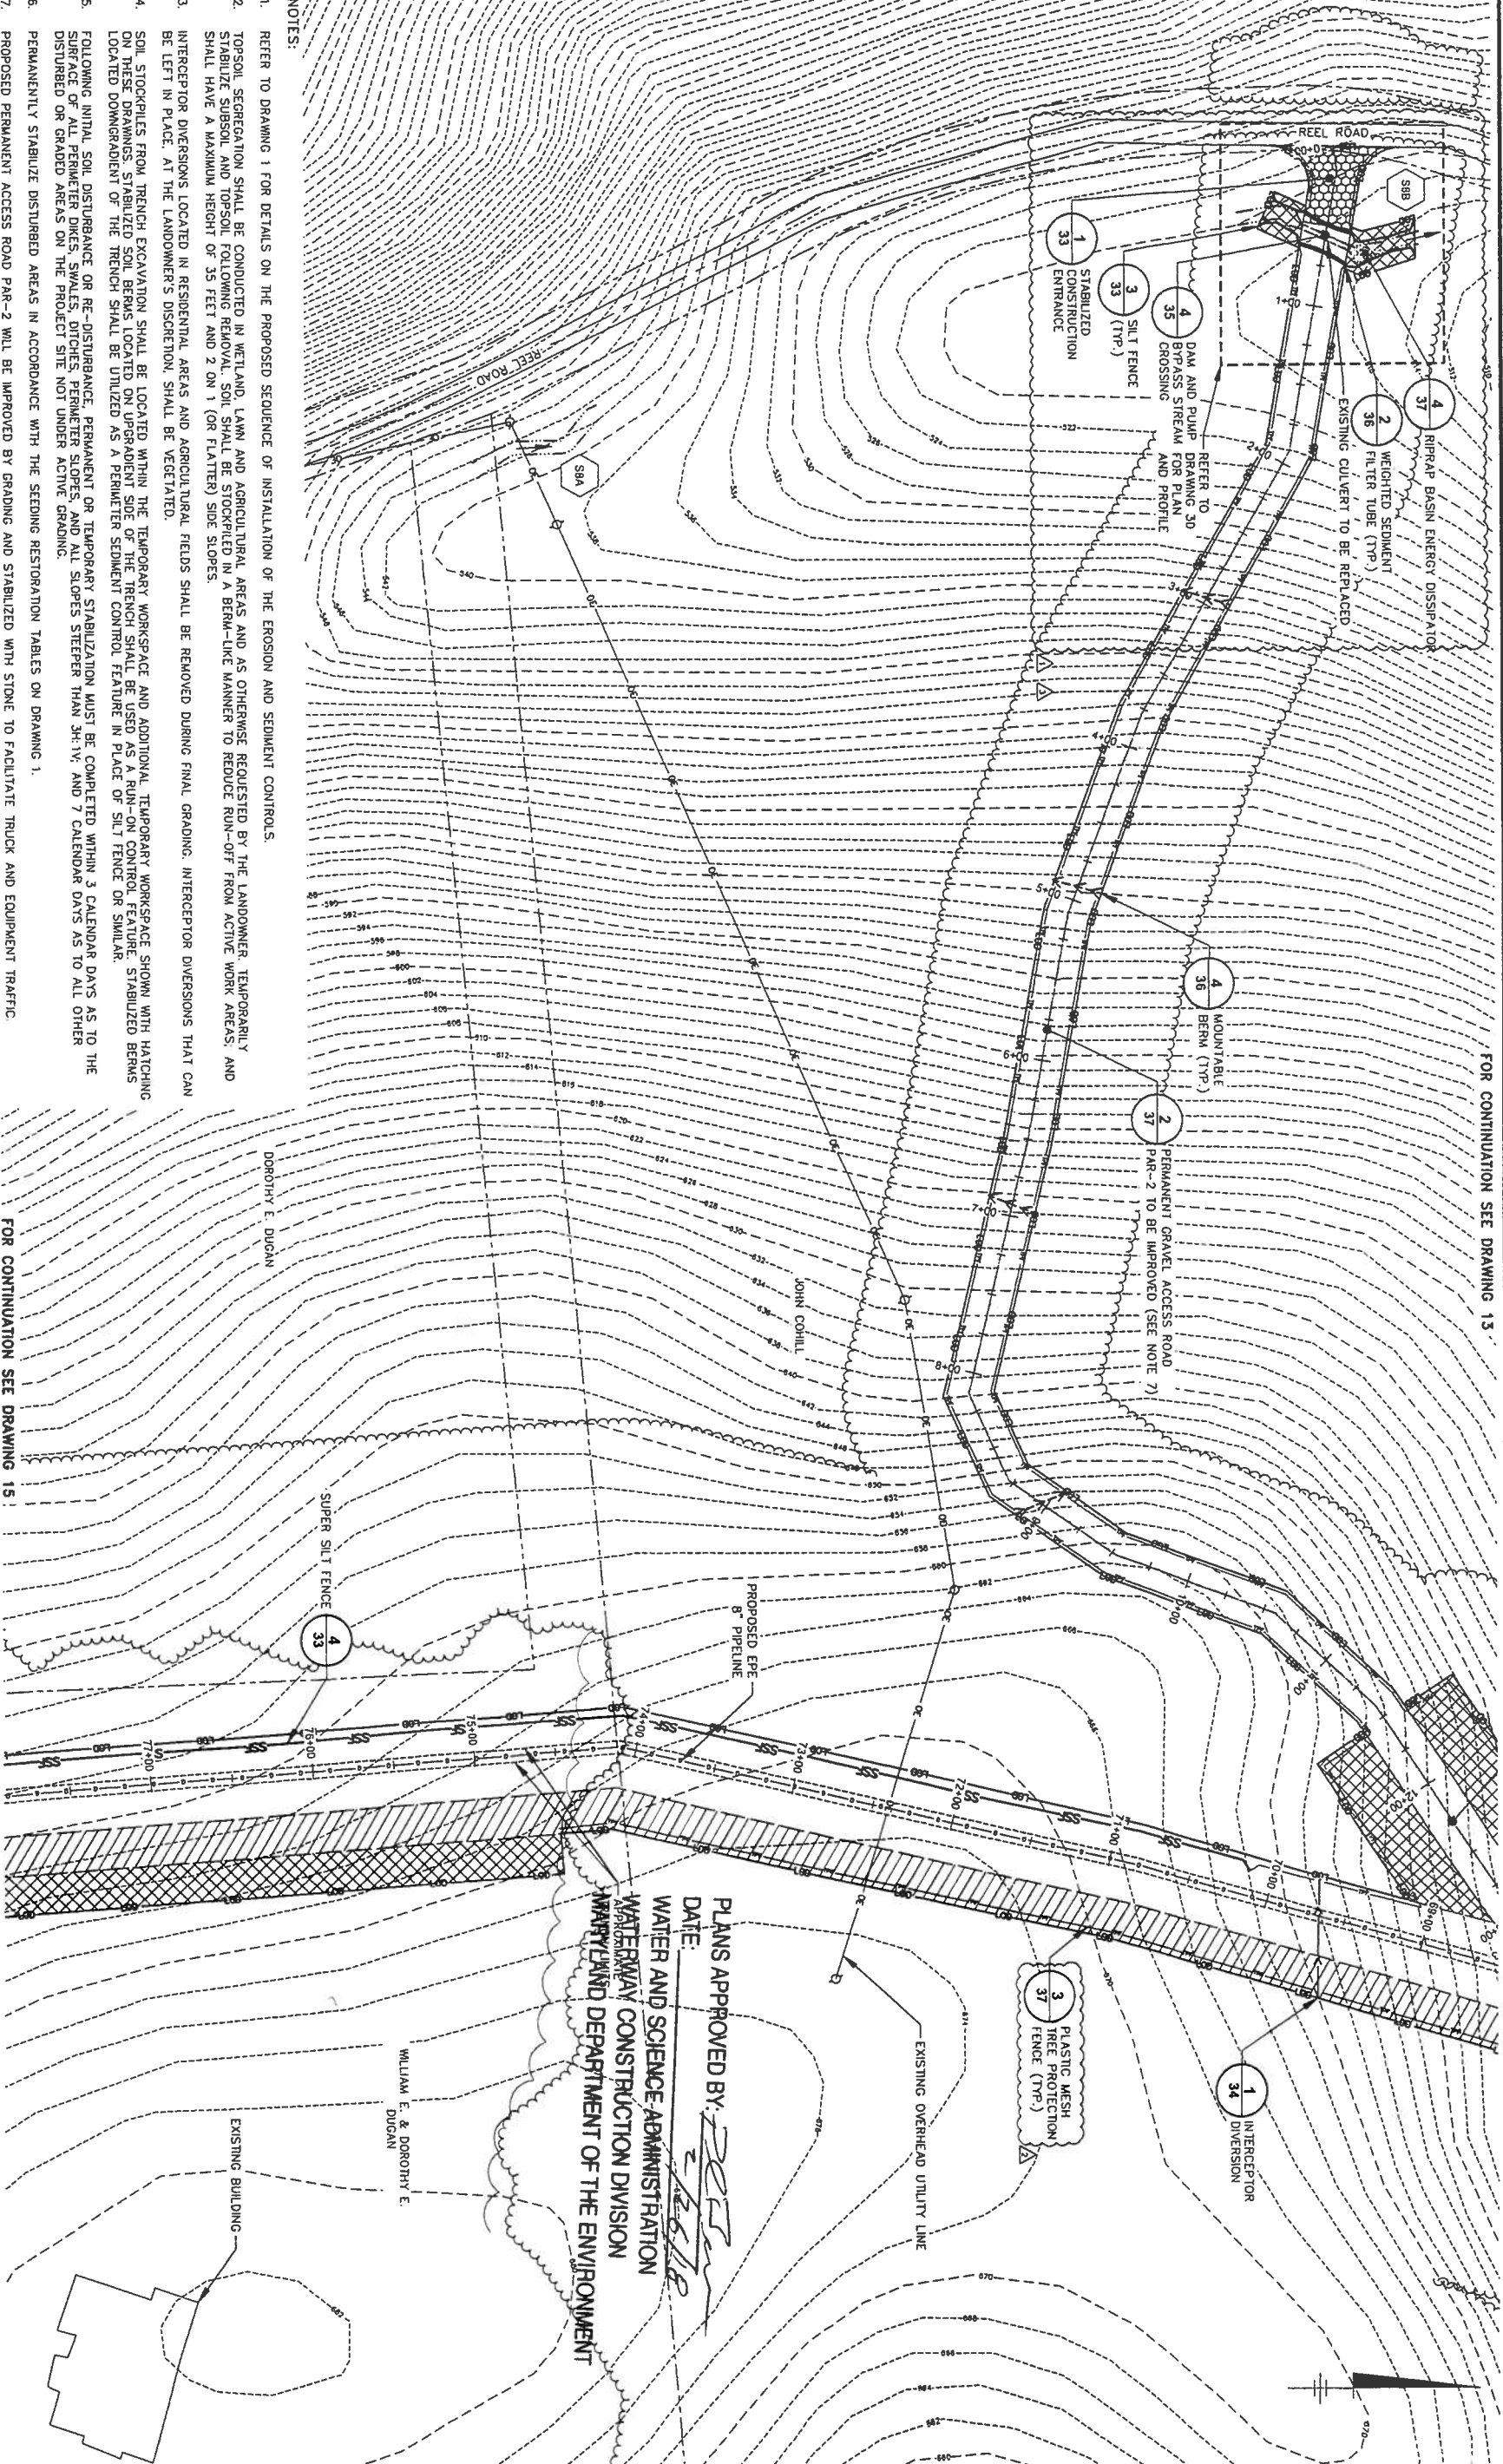

PLANS APPROVED BY: *[Signature]*
 DATE: *[Date]*
 WATER AND SCIENCE ADMINISTRATION
 WATERWAY CONSTRUCTION DIVISION
 MARYLAND DEPARTMENT OF THE ENVIRONMENT

WILLIAM E. & DOROTHY E. DUGAN

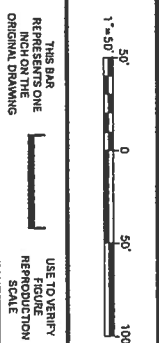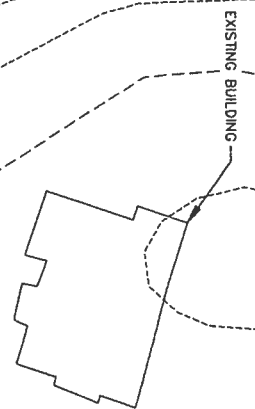

NO.	DATE	REVISIONS	DESIGNED BY	CHECKED BY	DATE
1	7/17/17	MOE COMMENT RESPONSE	ALS	ALS	
2	7/17/17	FOREST CONSERVATION ACT THE UREMENT	ALS	ALS	
3	7/17/17	MOE COMMENT RESPONSE	ALS	ALS	




ARCADIS
 Design & Consultancy
 for the natural and built worlds

COLUMBIA GAS TRANSMISSION, L.L.C. A TRANSCANADA COMPANY • HOUSTON, TEXAS
 EASTERN PANHANDLE EXPANSION PROJECT
SITE PLAN (STA. 69+00 TO 78+00)

ARCADIS Project No. CPGL00EP.0001.0008A
Date MARCH 2017
ARCADIS 6041 Wallace Road Extension Suite 300 Wexford, PA 15080 Tel: 724.742.8100

XREFS: CPGL00EP-X00
CPGL00EP-X01
CPGL00EP-X02

- NOTES:**
1. REFER TO DRAWING 1 FOR DETAILS ON THE PROPOSED SEQUENCE OF INSTALLATION OF THE EROSION AND SEDIMENT CONTROLS.
 2. TOPSOIL SEGRIGATION SHALL BE CONDUCTED IN WETLAND, LAWN AND AGRICULTURAL AREAS AND AS OTHERWISE REQUESTED BY THE LANDOWNER. TEMPORARILY STABILIZE SUBSOIL AND TOPSOIL FOLLOWING TRENCH. SOIL SHALL BE STOCKPILED IN A BERM-LIKE MANNER TO REDUCE RUN-OFF FROM ACTIVE WORK AREAS, AND SHALL HAVE A MAXIMUM HEIGHT OF 35 FEET 1 AND 2 ON 1 (OR FLATTER) SIDE SLOPES.
 3. INTERCEPTOR DIVERSIONS LOCATED IN RESIDENTIAL AREAS AND AGRICULTURAL FIELDS SHALL BE REMOVED DURING FINAL GRADING. INTERCEPTOR DIVERSIONS THAT CAN BE LEFT IN PLACE, AT THE LANDOWNER'S DISCRETION, SHALL BE VEGETATED.
 4. SOIL STOCKPILES FROM TRENCH EXCAVATION SHALL BE LOCATED WITHIN THE TEMPORARY WORKSPACE AND ADDITIONAL TEMPORARY WORKSPACE SHOWN WITH HATCHING ON THESE DRAWINGS. STABILIZED SOIL BERMS LOCATED ON UPGRADIENT SIDE OF THE TRENCH SHALL BE USED AS A PERIMETER SEDIMENT CONTROL FEATURE. STABILIZED BERMS LOCATED DOWNGRADIENT OF THE TRENCH SHALL BE UTILIZED AS A PERIMETER SEDIMENT CONTROL FEATURE IN PLACE OF SILT FENCE OR SIMILAR.
 5. FOLLOWING INITIAL SOIL DISTURBANCE OR RE-DISTURBANCE, PERMANENT OR TEMPORARY STABILIZATION MUST BE COMPLETED WITHIN 3 CALENDAR DAYS AS TO THE SURFACE OF ALL PERIMETER DIKES, SWALES, DITCHES, PERIMETER SLOPES, AND ALL SLOPES STEEPER THAN 3H:1V, AND 7 CALENDAR DAYS AS TO ALL OTHER DISTURBED OR GRADED AREAS ON THE PROJECT SITE NOT UNDER ACTIVE GRADING.
 6. PERMANENTLY STABILIZE DISTURBED AREAS IN ACCORDANCE WITH THE SEEDING RESTORATION TABLES ON DRAWING 1.
 7. PROPOSED PERMANENT ACCESS ROAD PAR-2 IS AN EXISTING GRAVEL ROAD THAT WILL BE STABILIZED WITH ADDITIONAL STONE TO FACILITATE TRUCK AND EQUIPMENT TRAFFIC.

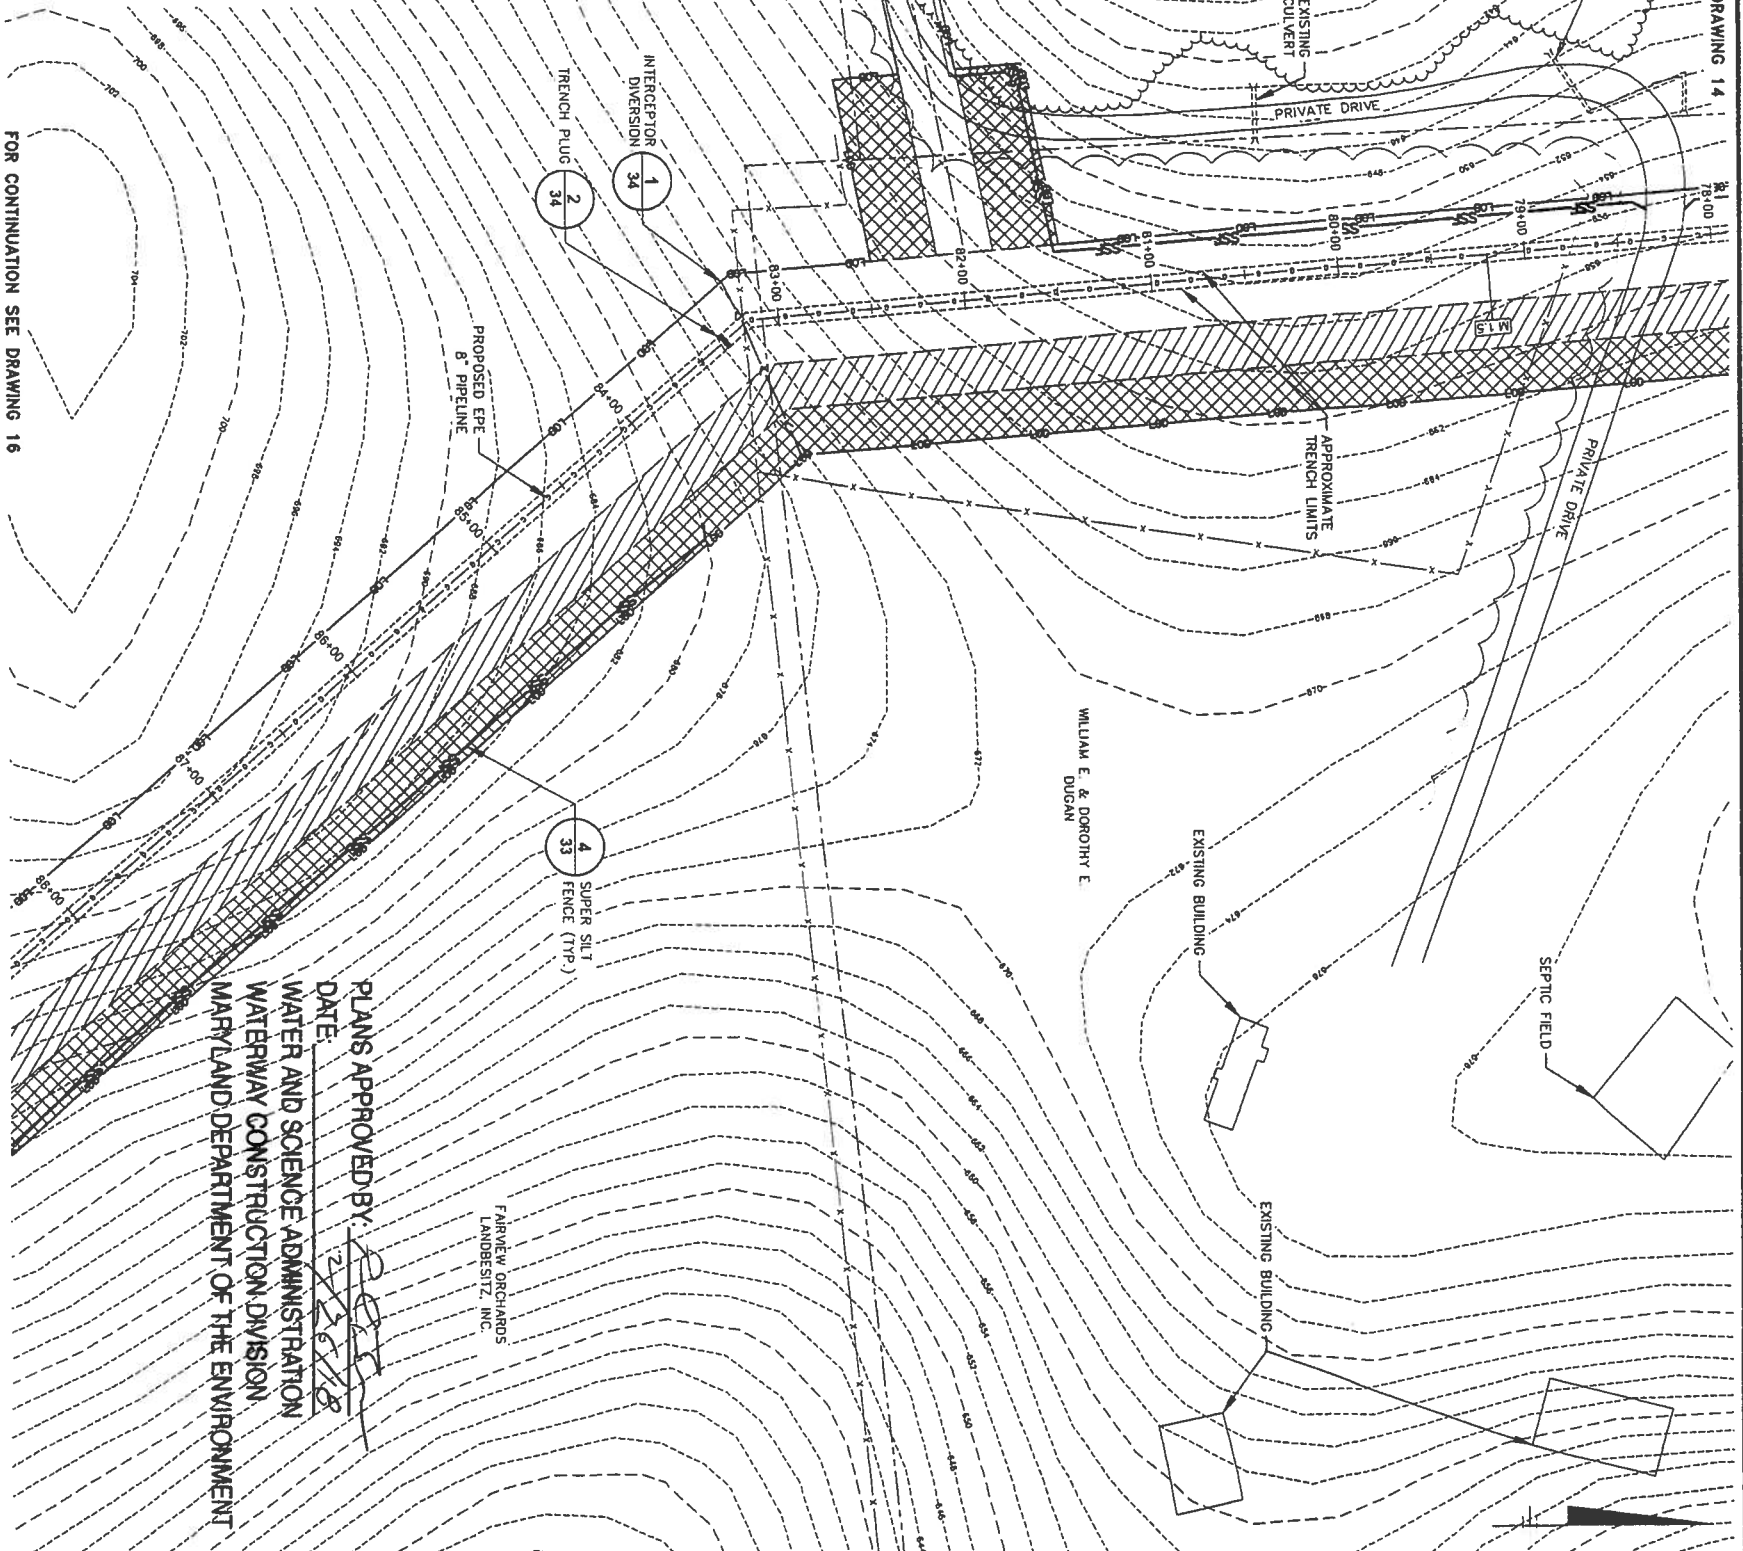

FOR CONTINUATION SEE DRAWING 14

FOR CONTINUATION SEE DRAWING 16

PLANS APPROVED BY: *[Signature]*
DATE: 2/26/18
WATER AND SCIENCE ADMINISTRATION
WATERWAY CONSTRUCTION DIVISION
MARYLAND DEPARTMENT OF THE ENVIRONMENT

THIS DRAWING IS THE PROPERTY OF THE ARCHADIS GROUP AND SHALL NOT BE REPRODUCED OR TRANSMITTED IN ANY FORM OR BY ANY MEANS, ELECTRONIC OR MECHANICAL, INCLUDING PHOTOCOPYING, RECORDING, OR BY ANY INFORMATION STORAGE AND RETRIEVAL SYSTEM, WITHOUT THE WRITTEN PERMISSION OF ARCHADIS U.S., INC.

USE TO REPRODUCE FIGURE REPRODUCTION SCALE

1" = 50'

0 50' 100'

No.	Date	Revisions	By	Checked by
1	7/11/17	FOREST CONSERVATION ACT RE-LIQUORMENT	ALS (ARL)	ALS (ARL)

Professional Engineer's Name	ALLEN LONG
Professional Engineer's No.	MD 34662
State	MD
Date Signed	
Project No.	
Project Name	
Project Location	




COLUMBIA GAS TRANSMISSION, LLC, A TRANSCANADA COMPANY • HOUSTON, TEXAS
EASTERN PANHANDLE EXPANSION PROJECT
SITE PLAN (STA. 78+00 TO 88+00)

ARCADIS Project No. CPGL00EP-001.0000A
Date: MARCH 2017
ARCADIS
501 State Road Extension
Wakarusa, PA 15090
Tel: 724.762.9180

- NOTES:
1. REFER TO DRAWING 1 FOR DETAILS ON THE PROPOSED SEQUENCE OF INSTALLATION OF THE EROSION AND SEDIMENT CONTROLS.
 2. TOPSOIL SEGRIGATION SHALL BE CONDUCTED IN WETLANDS, LAWN AND AGRICULTURAL AREAS AND AS OTHERWISE REQUESTED BY THE LANDOWNER. TEMPORARILY STABILIZE SUBSOIL AND TOPSOIL FOLLOWING REMOVAL. SOIL SHALL BE STOCKPILED IN A BERM-LIKE MANNER TO REDUCE RUN-OFF FROM ACTIVE WORK AREAS, AND SHALL HAVE A MAXIMUM HEIGHT OF 35 FEET AND 2 ON 1 (OR FLATTER) SIDE SLOPES.
 3. SOIL STOCKPILES FROM TRENCH EXCAVATION SHALL BE LOCATED WITHIN THE TEMPORARY WORKSPACE AND ADDITIONAL TEMPORARY WORKSPACE SHOWN WITH HATCHING ON THESE DRAWINGS. STABILIZED SOIL BERMS LOCATED ON UPGRADE SIDE OF THE TRENCH SHALL BE USED AS A RUN-ON CONTROL FEATURE. STABILIZED BERMS LOCATED DOWNGRADIENT OF THE TRENCH SHALL BE UTILIZED AS A PERIMETER SEDIMENT CONTROL FEATURE IN PLACE OF SILT FENCE OR SMALL AR.
 4. INTERCEPTOR DIVERSIONS LOCATED IN RESIDENTIAL AREAS AND AGRICULTURAL FIELDS SHALL BE REMOVED DURING FINAL GRADING. INTERCEPTOR DIVERSIONS THAT CAN BE LEFT IN PLACE AT THE LANDOWNER'S DISCRETION, SHALL BE VEGETATED.
 5. FOLLOWING INITIAL SOIL DISTURBANCE OR RE-DISTURBANCE, PERMANENT OR TEMPORARY STABILIZATION MUST BE COMPLETED WITHIN 3 CALENDAR DAYS AS TO THE SURFACE OF ALL PERIMETER DIKES, SWALES, DITCHES, PERIMETER SLOPES, AND ALL SLOPES STEEPER THAN 3H:1V, AND 7 CALENDAR DAYS AS TO ALL OTHER DISTURBED OR GRADED AREAS ON THE PROJECT SITE NOT UNDER ACTIVE GRADING.
 6. PERMANENTLY STABILIZE DISTURBED AREAS IN ACCORDANCE WITH THE SEEDING RESTORATION TABLES ON DRAWING 1.
 7. ACTUAL LOCATIONS OF STABILIZED CONSTRUCTION ENTRANCES MAY BE ADJUSTED BASED ON FIELD CONDITIONS AT THE TIME OF CONSTRUCTION.

FOR CONTINUATION SEE DRAWING 16

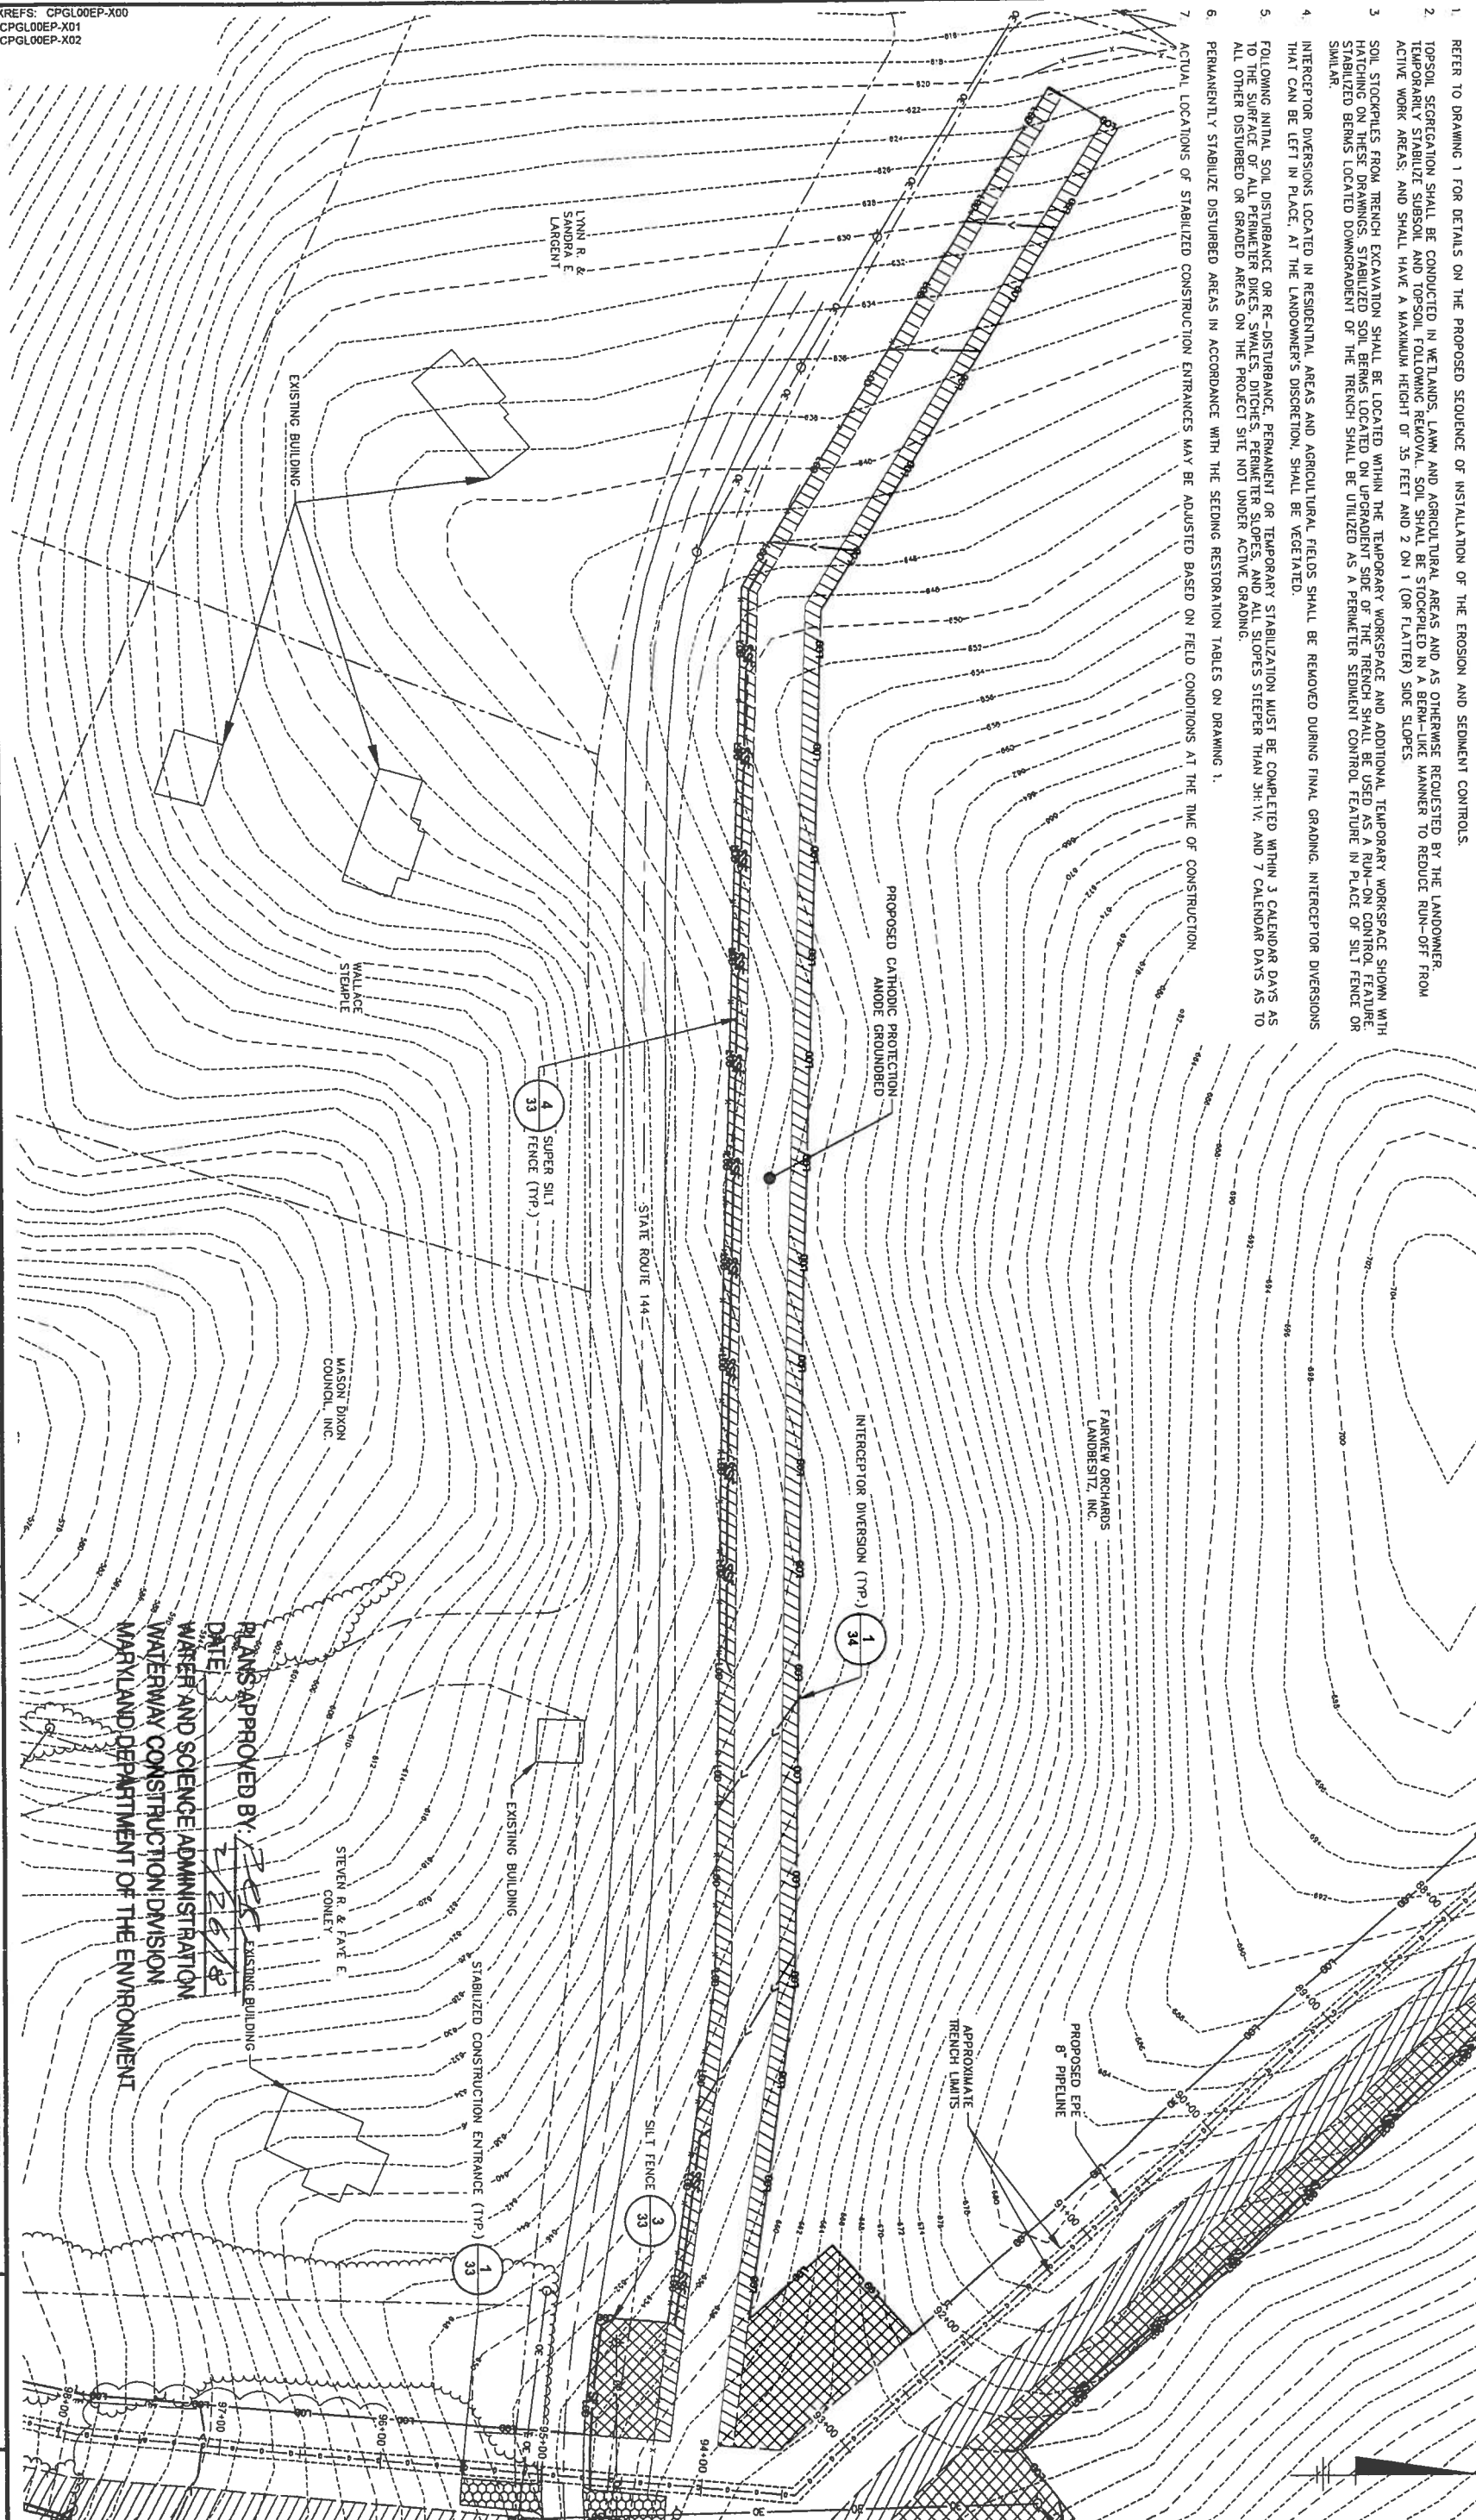

1"=50'
 0 50' 100'

THIS DRAWING IS THE PROPERTY OF THE ARCHITECT. ANY REPRODUCTION OF THIS DRAWING WITHOUT THE WRITTEN PERMISSION OF THE ARCHITECT IS PROHIBITED.

USE TO VERIFY REPRODUCTION SCALE

No.	Date	MODE COMMENT RESPONSE	BY	DATE	DESIGNED BY	CHECKED BY
1	7/17/17		ALS		ALS	ALS


Professional Engineer's Name
ALLEN LONG
 Professional Engineer No.
 MD 34862

ARCADIS
 Design & Consultancy
 for natural and built assets
 ARCADIS U.S., INC.


COLUMBIA GAS TRANSMISSION, L.L.C. A TRANSCANADA COMPANY • HOUSTON, TEXAS
 EASTERN PANHANDLE EXPANSION PROJECT
SITE PLAN (CATHODIC PROTECTION ANODE GROUNDBED AT STA. 94+00)

ARCADIS Project No.
 CPGL00EP-0001-0008A
 Date
 MARCH 2017
 ARCADIS
 6001 Walnut Road Extension
 Suite 300
 Wexford, PA 15090
 Tel: 724.742.9190

FOR CONTINUATION SEE DRAWING 18

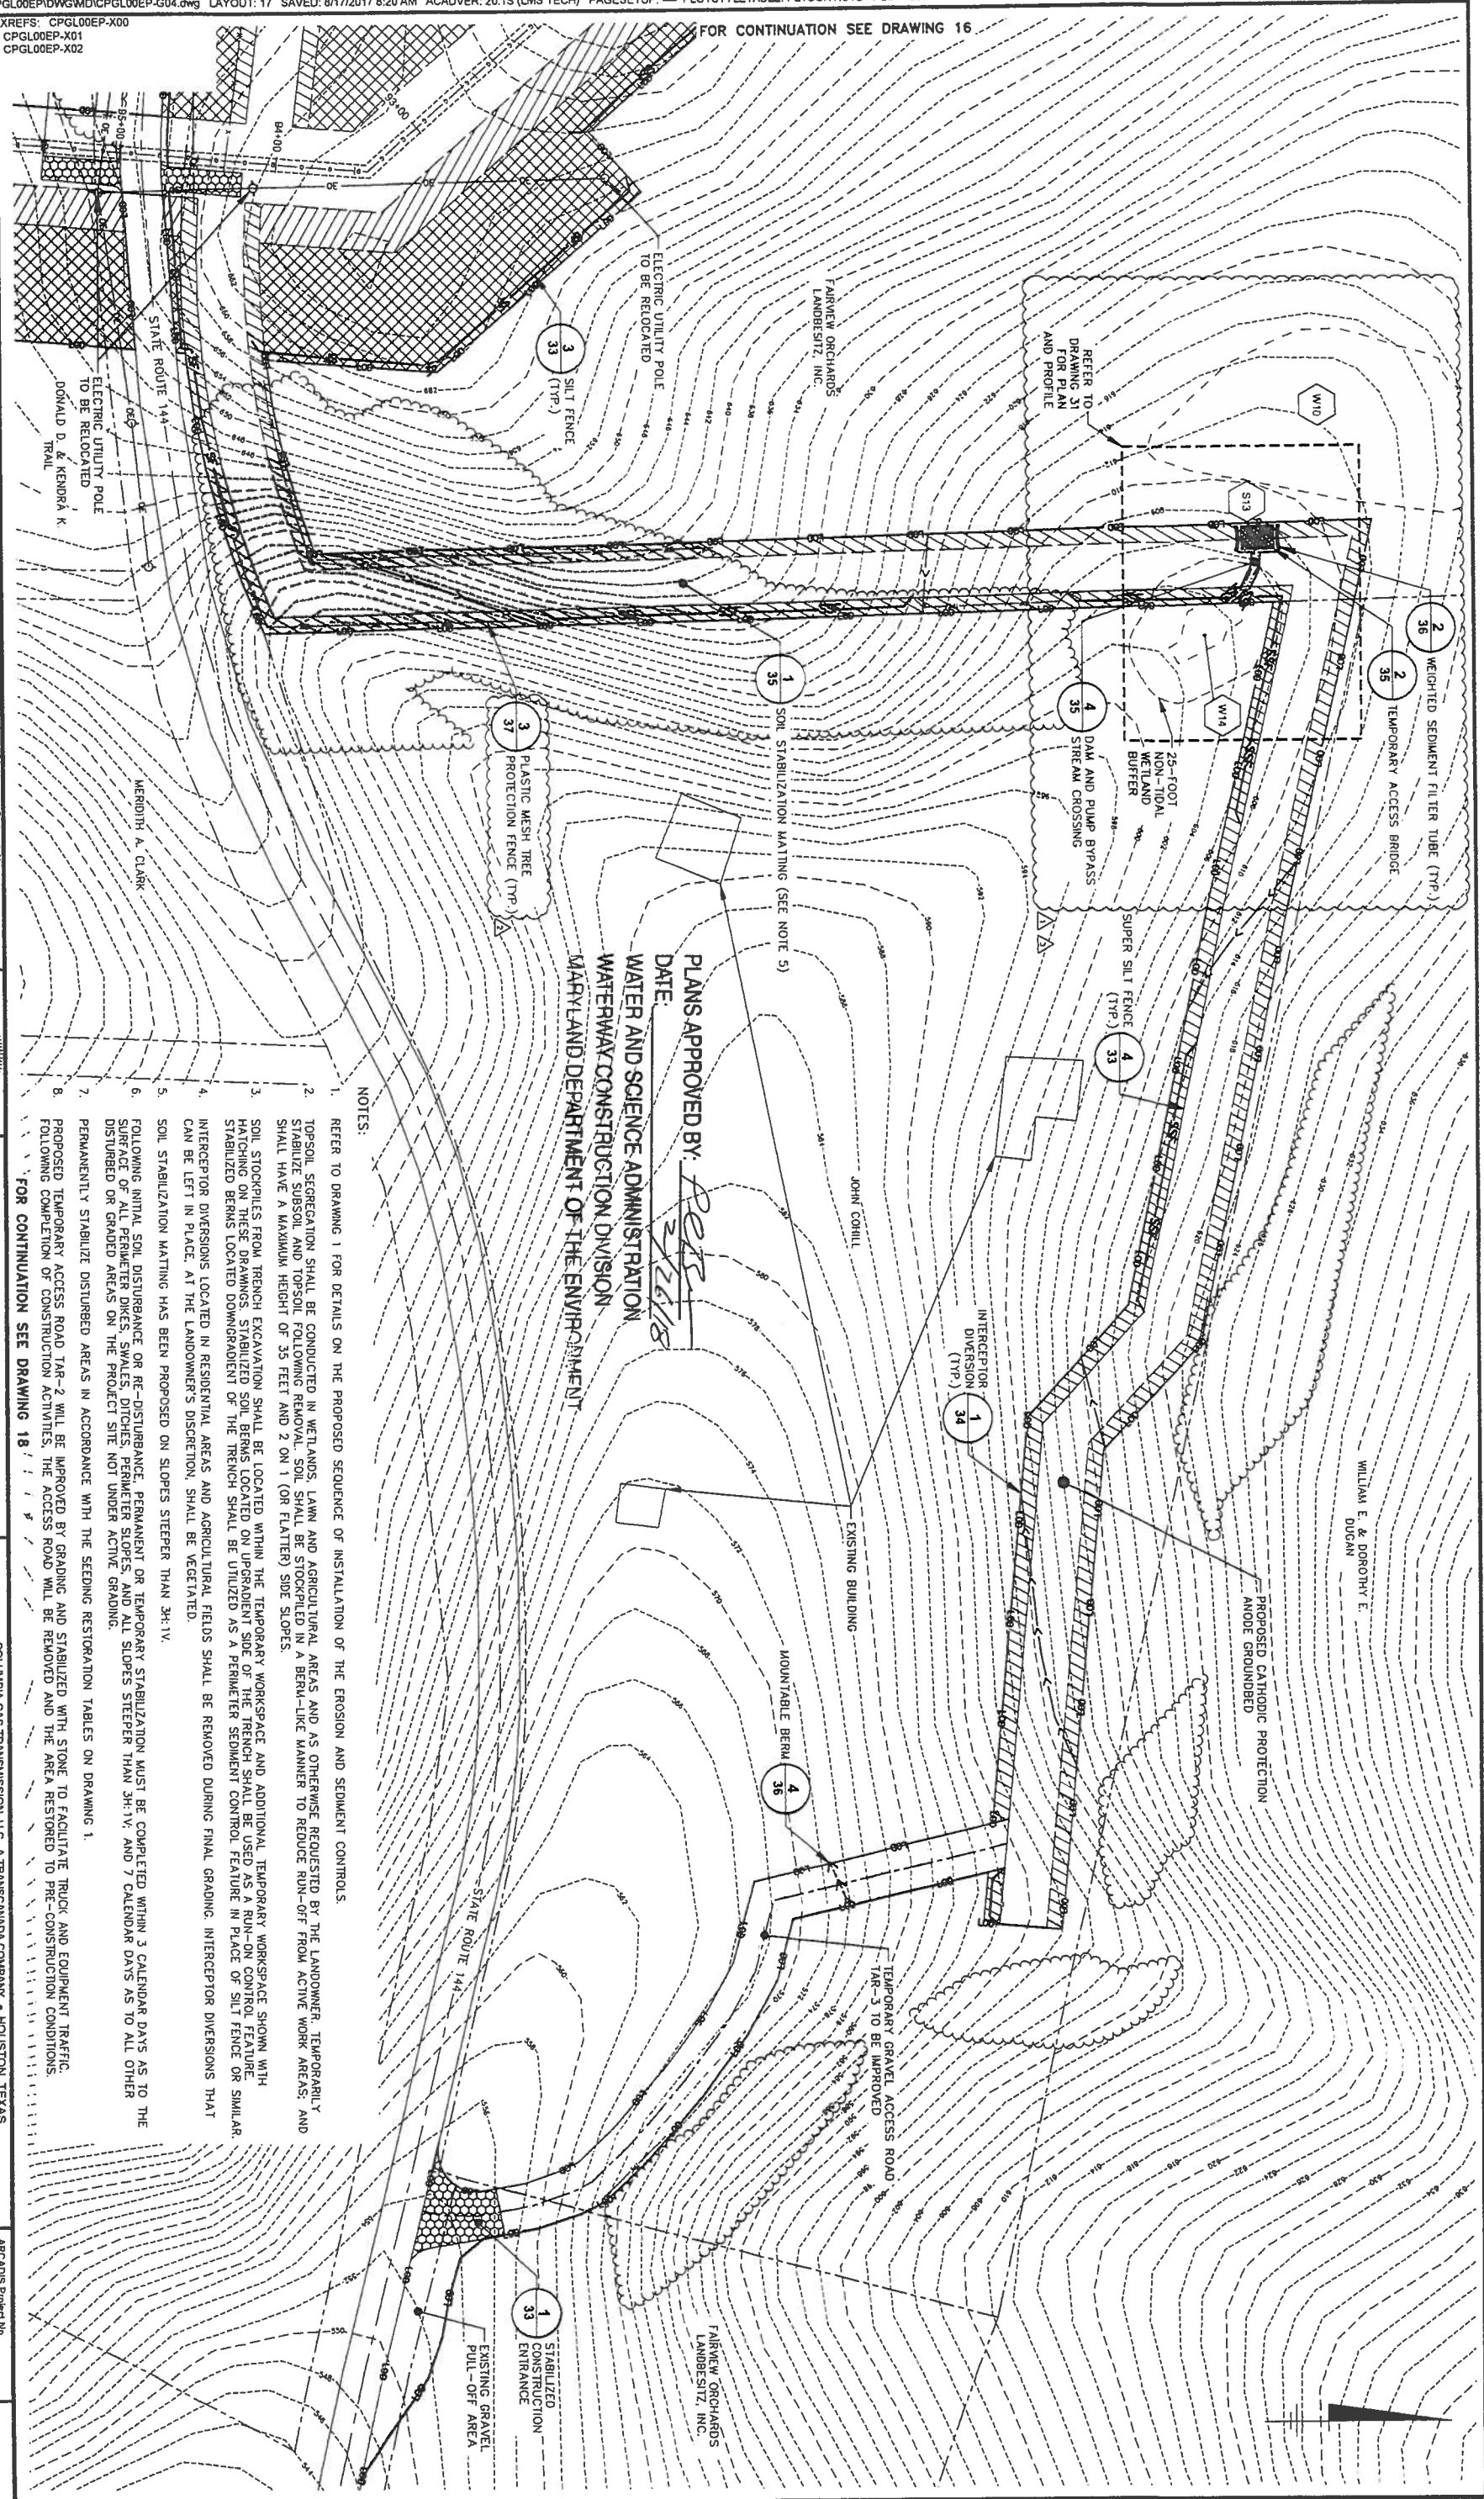

FOR CONTINUATION SEE DRAWING 16

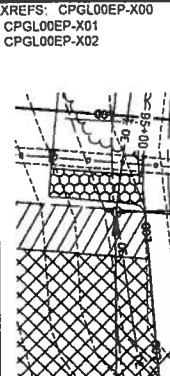

XREFS: CPGLO0EP-X00
CPGL00EP-X01
CPGL00EP-X02

THIS DRAWING IS THE PROPERTY OF THE ARCHADIS ENTITY IDENTIFIED IN THE TITLE BLOCK AND MUST NOT BE REPRODUCED OR TRANSMITTED IN ANY FORM OR BY ANY MEANS, ELECTRONIC OR MECHANICAL, INCLUDING PHOTOCOPYING, RECORDING, OR BY ANY INFORMATION STORAGE AND RETRIEVAL SYSTEM, WITHOUT THE WRITTEN PERMISSION OF ARCHADIS U.S., INC.	NO.	DATE	BY	FOR
REVISIONS				
7/7/17	7/7/17	AL/S	AL/S	FOREST CONSERVATION ACT RE JUREMENT
8/11/17	8/11/17	AL/S	AL/S	MADE COMMENT RESPONSE

Professional Engineer's Name
ALLEN LONG
Professional Engineer's No.
MD 34682

Professional Engineer's Name
MERDITH A. CLARK
Professional Engineer's No.
MD 34682

Professional Engineer's Name
ALLEN LONG
Professional Engineer's No.
MD 34682

Professional Engineer's Name
ALLEN LONG
Professional Engineer's No.
MD 34682

PLANS APPROVED BY: *[Signature]*
DATE: 2/26/18
WATER AND SCIENCE ADMINISTRATION
WATERWAY CONSTRUCTION DIVISION
MARYLAND DEPARTMENT OF THE ENVIRONMENT

- NOTES:
- REFER TO DRAWING 1 FOR DETAILS ON THE PROPOSED SEQUENCE OF INSTALLATION OF THE EROSION AND SEDIMENT CONTROLS.
 - TOPSOIL SEGREGATION SHALL BE CONDUCTED IN WETLANDS, LAWN AND AGRICULTURAL AREAS AND AS OTHERWISE REQUESTED BY THE LANDOWNER. TEMPORARILY STABILIZE SUBSOIL AND TOPSOIL FOLLOWING REMOVAL. SOIL SHALL BE STOCKPILED IN A BERM-LIKE MANNER TO REDUCE RUN-OFF FROM ACTIVE WORK AREAS; AND SHALL HAVE A MAXIMUM HEIGHT OF 35 FEET AND 2 ON 1 (OR FLATTER) SIDE SLOPES.
 - SOIL STOCKPILES FROM TRENCH EXCAVATION SHALL BE LOCATED WITHIN THE TEMPORARY WORKSPACE AND ADDITIONAL TEMPORARY WORKSPACE SHOWN WITH HATCHING ON THESE DRAWINGS. STABILIZED SOIL BERMS LOCATED ON UPGRADE SIDE OF THE TRENCH SHALL BE SEED AS RUN-ON CONTROL FEATURE. STABILIZED BERMS LOCATED DOWNGRADIENT OF THE TRENCH SHALL BE UTILIZED AS A PERIMETER SEDIMENT CONTROL FEATURE IN PLACE OF SILT FENCE OR SIMILAR INTERCEPTOR DIVERSIONS LOCATED IN RESIDENTIAL AREAS AND AGRICULTURAL FIELDS SHALL BE REMOVED DURING FINAL GRADING. INTERCEPTOR DIVERSIONS THAT CAN BE LEFT IN PLACE, AT THE LANDOWNER'S DISCRETION, SHALL BE VEGETATED.
 - SOIL STABILIZATION MATTING HAS BEEN PROPOSED ON SLOPES STEEPER THAN 3H:1V.
 - FOLLOWING INITIAL SOIL DISTURBANCE OR RE-DISTURBANCE, PERMANENT OR TEMPORARY STABILIZATION MUST BE COMPLETED WITHIN 3 CALENDAR DAYS AS TO THE SURFACE OF ALL PERIMETER DIKES, SWALES, DITCHES, PERIMETER SLOPES, AND ALL SLOPES STEEPER THAN 3H:1V, AND 7 CALENDAR DAYS AS TO ALL OTHER DISTURBED OR GRADED AREAS ON THE PROJECT SITE NOT UNDER ACTIVE GRADING.
 - PERMANENTLY STABILIZE DISTURBED AREAS IN ACCORDANCE WITH THE SEEDING RESTORATION TABLES ON DRAWING 1.
 - PROPOSED TEMPORARY ACCESS ROAD TAR-2 WILL BE IMPROVED BY GRADING AND STABILIZED WITH STONE TO FACILITATE TRUCK AND EQUIPMENT TRAFFIC FOLLOWING COMPLETION OF CONSTRUCTION ACTIVITIES. THE ACCESS ROAD WILL BE REMOVED AND THE AREA RESTORED TO PRE-CONSTRUCTION CONDITIONS.
 - FOR CONTINUATION SEE DRAWING 18

COLUMBIA GAS TRANSMISSION, L.L.C. A TRANSCANADA COMPANY • HOUSTON, TEXAS
EASTERN PAHANHALE EXPANSION PROJECT

ARCADIS Project No.
CPGL00EP-001-0009A
Date
MARCH 2017
ARCADIS
501 Westgate Road Extension
Wexford, PA 15090
Tel: 724.762.2180

XREFS: CPGL00EP-X00
CPGL00EP-X01
CPGL00EP-X02

THIS DRAWING IS THE PROPERTY OF THE ARCHADIS ENGINEERING AND CONSULTANCY. IT IS TO BE USED ONLY FOR THE PROJECT AND SITE SPECIFICALLY IDENTIFIED ON THE TITLE BLOCK. ANY REPRODUCTION OR TRANSMISSION OF THIS DRAWING WITHOUT THE WRITTEN PERMISSION OF ARCHADIS ENGINEERING AND CONSULTANCY IS STRICTLY PROHIBITED.

1"=50'
0 50' 100'

USE TO VERIFY REPRODUCTION SCALE

No.	Date	Revisions	Designed By	Checked By	Drawn By	Scale
1	7/17/17	FOREST CONSERVATION ACT REQUIREMENT	ALS	ARL	ALS	AS SHOWN
2	7/17/17	MODE COMMENT RESPONSE	ALS	ARL	ALS	AS SHOWN

Professional Engineer's Name
ALLEN LONG
Professional Engineer's No.
MD 34882

Professional Engineer's Name
ALLEN LONG
Professional Engineer's No.
MD 34882

ARCADIS
Design & Consultancy
Soil Remediation
Soil Assessors

ARCADIS U.S., INC.


COLUMBIA GAS TRANSMISSION, LLC, A TRANSCANADA COMPANY • HOUSTON, TEXAS
EASTERN PANHANDLE EXPANSION PROJECT
SITE PLAN (STA. 95+00 TO 105+00)

ARCADIS Project No.
CPGL00EP-0001-0009A

Date
MARCH 2017

ARCADIS
6041 Wallace Road Extension
Suite 300
Wexford, PA 15090
Tel: 724.762.8180

18

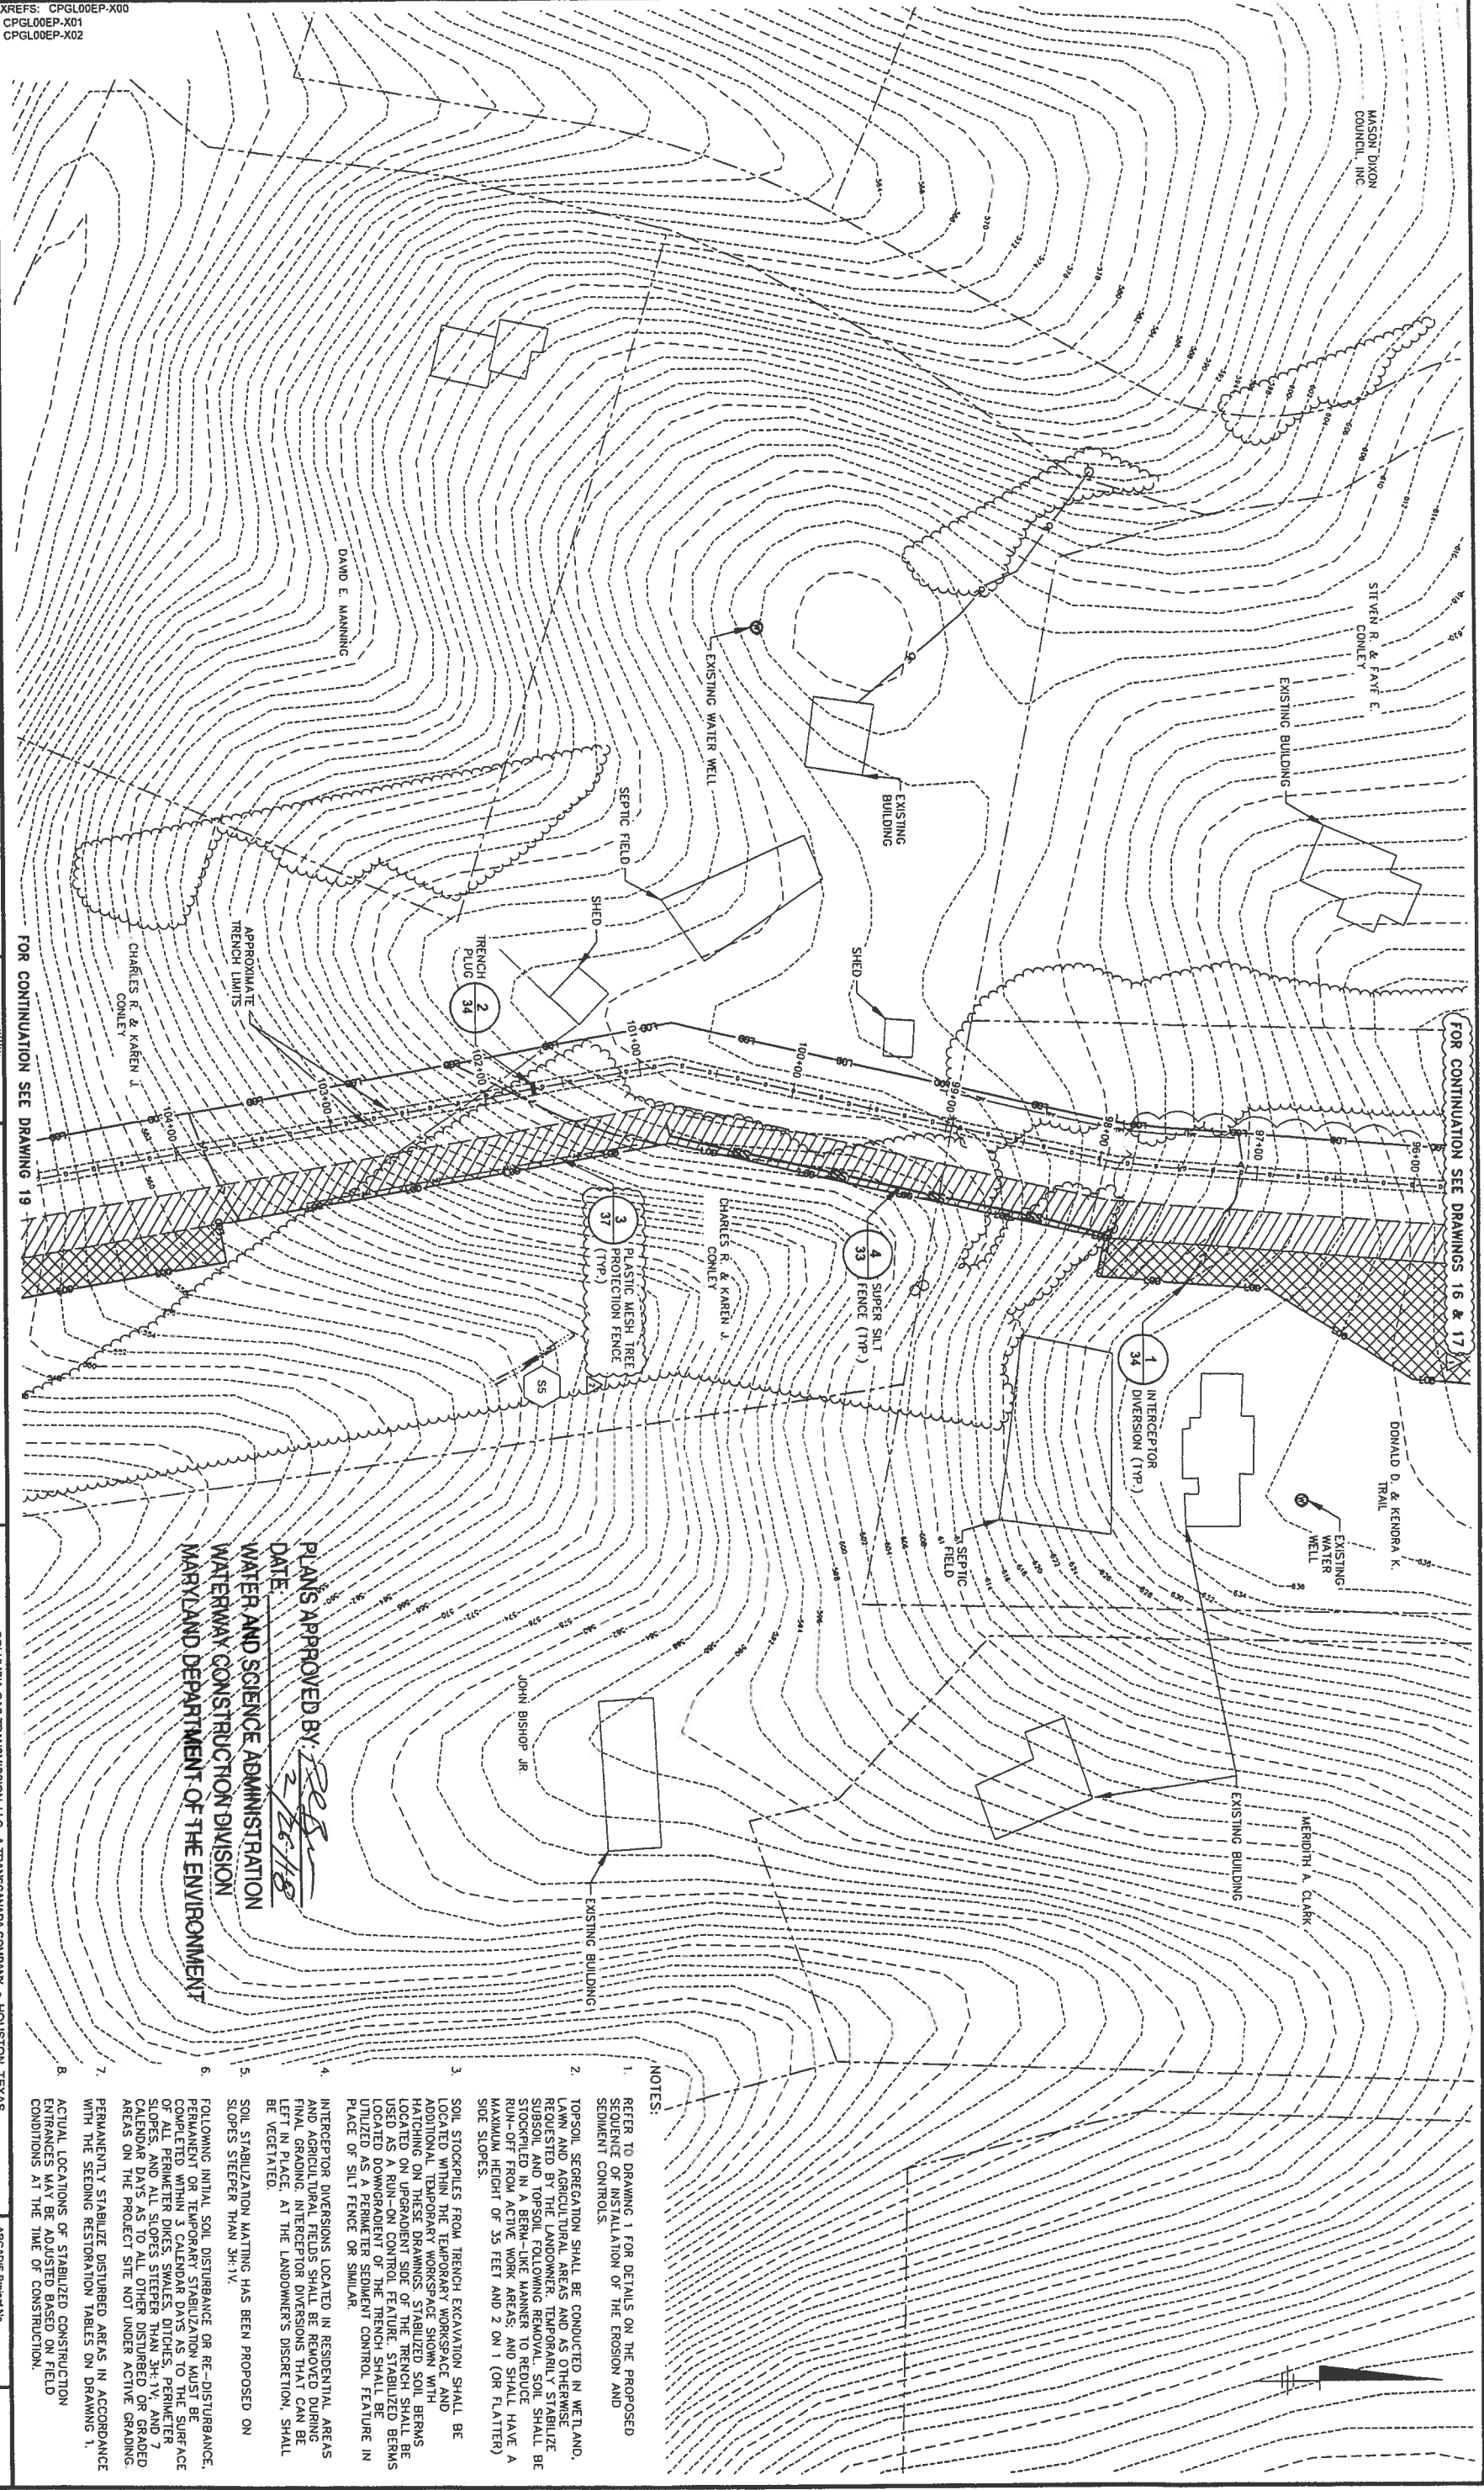

FOR CONTINUATION SEE DRAWING 19

FOR CONTINUATION SEE DRAWINGS 16 & 17


PLANS APPROVED BY: *[Signature]*
DATE: *[Signature]*
WATER AND SCIENCE ADMINISTRATION
WATERWAY CONSTRUCTION DIVISION
MARYLAND DEPARTMENT OF THE ENVIRONMENT

NOTES:

- REFER TO DRAWING 1 FOR DETAILS ON THE PROPOSED SEQUENCE OF INSTALLATION OF THE EROSION AND SEDIMENT CONTROLS.
- TOPSOIL SEGREGATION SHALL BE CONDUCTED IN WETLAND, LAWN AND AGRICULTURAL AREAS AND AS OTHERWISE REQUESTED BY THE LANDOWNER. TEMPORARILY STABILIZE SUBSOIL AND TOPSOIL FOLLOWING REMOVAL. SOIL SHALL BE STOCKPILED IN A BERM-LIKE MANNER TO REDUCE RUN-OFF FROM ACTIVE WORK AREAS; AND SHALL HAVE A MAXIMUM HEIGHT OF 35 FEET AND 2 ON 1 (OR FLATTER) SIDE SLOPES.
- SOIL STOCKPILES FROM TRENCH EXCAVATION SHALL BE LOCATED WITHIN THE TEMPORARY WORKSPACE AND ADDITIONAL TEMPORARILY STABILIZED SOIL BERMS LOCATED ON UPGRADIENT SIDE OF THE TRENCH SHALL BE USED AS A RUN-ON CONTROL FEATURE. STABILIZED BERMS LOCATED DOWNGRADIENT OF THE TRENCH SHALL BE UTILIZED AS A PERMEABLE SEDIMENT CONTROL FEATURE IN PLACE OF SILT FENCE OR SIMILAR.
- INTERCEPTOR DIVERSIONS LOCATED IN RESIDENTIAL AREAS AND AGRICULTURAL FIELDS SHALL BE REMOVED DURING FINAL GRADING. INTERCEPTOR DIVERSIONS THAT CAN BE LEFT IN PLACE AT THE LANDOWNER'S DISCRETION, SHALL BE VEGETATED.
- SOIL STABILIZATION MATTING HAS BEEN PROPOSED ON SLOPES STEEPER THAN 3H:1V.
- FOLLOWING INITIAL SOIL DISTURBANCE OR RE-DISTURBANCE, PERMANENT OR TEMPORARY STABILIZATION MUST BE COMPLETED WITHIN 3 CALENDAR DAYS AS TO THE SURFACE OF ALL PERIMETER DICES, SWALES, DITCHES, PERIMETER SLOPES, AND ALL SLOPES STEEPER THAN 3H:1V. AND 7 CALENDAR DAYS AS TO ALL OTHER DISTURBED OR GRADED AREAS ON THE PROJECT SITE NOT UNDER ACTIVE GRADING.
- PERMANENTLY STABILIZE DISTURBED AREAS IN ACCORDANCE WITH THE SEEDING RESTORATION TABLES ON DRAWING 1.
- ACTUAL LOCATIONS OF STABILIZED CONSTRUCTION ENTRANCES MAY BE ADJUSTED BASED ON FIELD CONDITIONS AT THE TIME OF CONSTRUCTION.

CPGL00EP-X00
 CPGL00EP-X01
 CPGL00EP-X02

FOR CONTINUATION SEE DRAWING 16

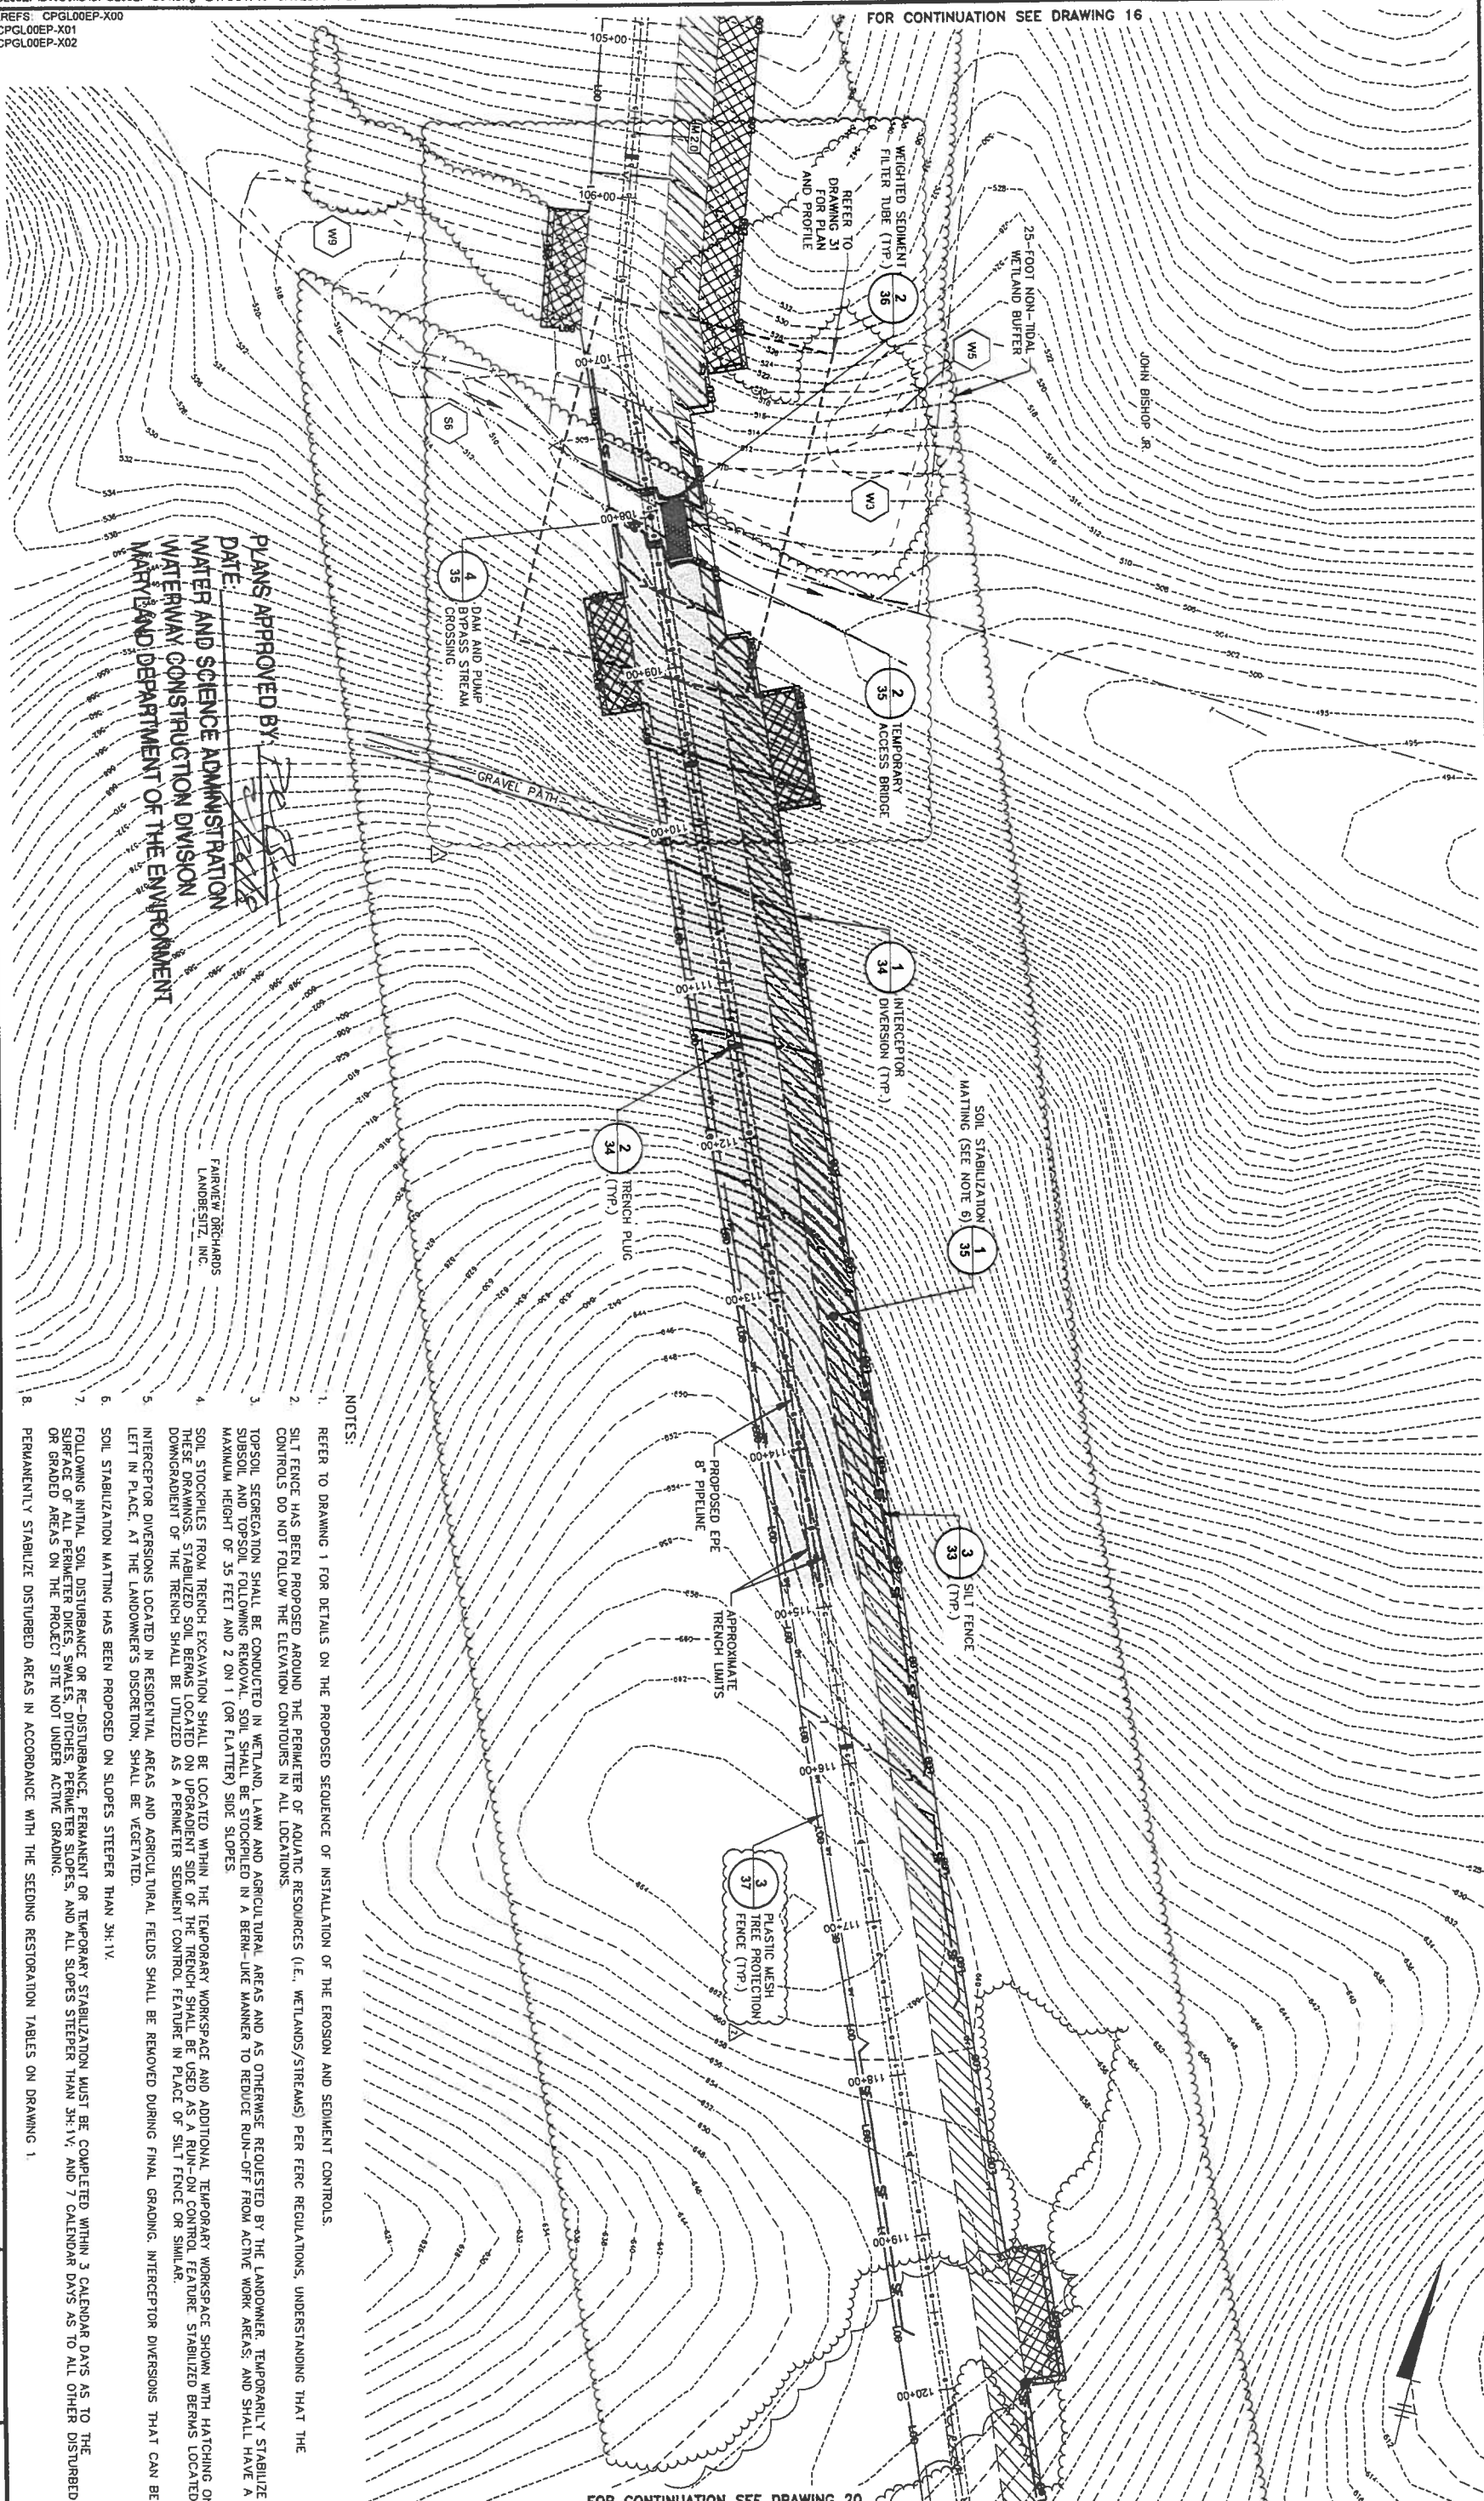

PLANS APPROVED BY: *[Signature]*
 DATE: *[Date]*
 WATER AND SCIENCE ADMINISTRATION
 WATERWAY CONSTRUCTION DIVISION
 MARYLAND DEPARTMENT OF THE ENVIRONMENT

FARMVIEW ORCHARDS
 LANDBESITZ, INC.

NOTES:

1. REFER TO DRAWING 1 FOR DETAILS ON THE PROPOSED SEQUENCE OF INSTALLATION OF THE EROSION AND SEDIMENT CONTROLS.
2. SILT FENCE HAS BEEN PROPOSED AROUND THE PERIMETER OF AQUATIC RESOURCES (I.E., WETLANDS/STREAMS) PER FERD REGULATIONS, UNDERSTANDING THAT THE CONTROLS DO NOT FOLLOW THE ELEVATION CONTOURS IN ALL LOCATIONS.
3. TOPSOIL SEGREGATION SHALL BE CONDUCTED IN WETLAND, LAWN AND AGRICULTURAL AREAS AND AS OTHERWISE REQUESTED BY THE LANDOWNER. TEMPORARILY STABILIZE SUBSOIL AND TOPSOIL FOLLOWING REMOVAL. SOIL SHALL BE STOCKPILED IN A BERM-LIKE MANNER TO REDUCE RUN-OFF FROM ACTIVE WORK AREAS, AND SHALL HAVE A MAXIMUM HEIGHT OF 35 FEET AND 2 ON 1 (OR FLATTER) SIDE SLOPES.
4. SOIL STOCKPILES FROM TRENCH EXCAVATION SHALL BE LOCATED WITHIN THE TEMPORARY WORKSPACE AND ADDITIONAL TEMPORARY WORKSPACE SHOWN WITH HATCHING ON THESE DRAWINGS. STABILIZED SOIL BERMS LOCATED ON UPGRADIENT SIDE OF THE TRENCH SHALL BE USED AS A PERIMETER SEDIMENT CONTROL FEATURE IN PLACE OF SILT FENCE OR SIMILAR DOWNGRADIENT OF THE TRENCH SHALL BE UTILIZED AS A PERIMETER SEDIMENT CONTROL FEATURE IN PLACE OF SILT FENCE OR SIMILAR.
5. INTERCEPTOR DIVERSIONS LOCATED IN RESIDENTIAL AREAS AND AGRICULTURAL FIELDS SHALL BE REMOVED DURING FINAL GRADING. INTERCEPTOR DIVERSIONS THAT CAN BE LEFT IN PLACE, AT THE LANDOWNER'S DISCRETION, SHALL BE VEGETATED.
6. SOIL STABILIZATION MATTING HAS BEEN PROPOSED ON SLOPES STEEPER THAN 3H:1V.
7. FOLLOWING INITIAL SOIL DISTURBANCE OR RE-DISTURBANCE, PERMANENT OR TEMPORARY STABILIZATION MUST BE COMPLETED WITHIN 3 CALENDAR DAYS AS TO THE SURFACE OF ALL PERIMETER DICES, SWALES, DITCHES, PERIMETER SLOPES, AND ALL SLOPES STEEPER THAN 3H:1V, AND 7 CALENDAR DAYS AS TO ALL OTHER DISTURBED OR GRADED AREAS ON THE PROJECT SITE NOT UNDER ACTIVE GRADING.
8. PERMANENTLY STABILIZE DISTURBED AREAS IN ACCORDANCE WITH THE SEEDING RESTORATION TABLES ON DRAWING 1.

THIS DRAWING IS THE PROPERTY OF THE ARCHDISE ENGINEERING AND CONSULTING FIRM. IT IS TO BE USED ONLY FOR THE PROJECT AND SITE SPECIFICALLY IDENTIFIED IN THE TITLE BLOCK AND MAY NOT BE REPRODUCED OR TRANSMITTED IN ANY FORM OR BY ANY MEANS, ELECTRONIC OR MECHANICAL, WITHOUT THE WRITTEN PERMISSION OF SAID FIRM.

Professional Engineer's Name	ALLEN LONG
Professional Engineer's No.	MD 34862
State	MD
Designed by	ALS
Drawn by	ALS
Checked by	AVL
Project No.	19
Project Name	SITE PLAN (STA. 105+00 TO 120+50)
Revision No.	1
Revision Description	FOREST CONSERVATION ACT RE-UMBREMENT
Revision Date	7/17/17
Revision By	ALS
Revision Checked	ALS




COLUMBIA GAS TRANSMISSION, L.P., A TRANSCANADA COMPANY • HOUSTON, TEXAS
 EASTERN PANHANDLE EXPANSION PROJECT
 SITE PLAN (STA. 105+00 TO 120+50)
 ARCADIS Project No. CPGL00EP-0001-0006A
 Date: MARCH 2017
 ARCADIS
 501 N. Market Road Extension
 Wexford, PA 15090
 Tel: 724.742.9180


FOR CONTINUATION SEE DRAWING 20

FOR CONTINUATION SEE DRAWING 19

REFS: CPGL00EP-X00
CPGL00EP-X01
CPGL00EP-X02

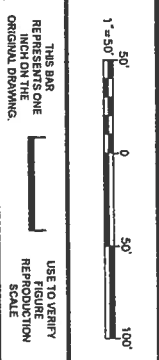

No.	Date	Revisions	Designed By	Checked By	Drawn By	Project Mgr
1	7/17/17	FOREST CONSERVATION ACT REQUIREMENT	ALS	JARL	ALS	JARL
2	7/17/17	WDE COMMENT RESPONSE	ALS	JARL	MD	MD

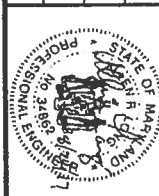


ARCADIS Design & Consultancy
for planning and built assets
ARCADIS U.S., INC.


COLUMBIA GAS TRANSMISSION, L.L.C., A TRANSCANADA COMPANY • HOUSTON, TEXAS
SITE PLAN (STA. 120+50 TO 136+00)
ARCADIS Project No. CPGL00EP-0001-0009A
Date: MARCH 2017
6841 Wallace Road
Wexford, PA 15090
Tel. 724.742.9180

- NOTES:**
1. REFER TO DRAWING 1 FOR DETAILS ON THE PROPOSED SEQUENCE OF INSTALLATION OF THE EROSION AND SEDIMENT CONTROLS.
 2. SILT FENCE HAS BEEN PROPOSED AROUND THE PERIMETER OF AQUATIC RESOURCES (I.E., WETLANDS/STREAMS) PER FERC REGULATIONS, UNDERSTANDING THAT THE CONTROLS DO NOT FOLLOW THE ELEVATION CONTOURS IN ALL LOCATIONS.
 3. TOPSOIL SEGREGATION SHALL BE CONDUCTED IN WETLAND, LAWN AND AGRICULTURAL AREAS AND AS OTHERWISE REQUESTED BY THE LANDOWNER. TEMPORARILY STABILIZE SUBSOIL AND TOPSOIL FOLLOWING REMOVAL. SOIL SHALL BE STOCKPILED IN A BERM-LIKE MANNER TO REDUCE RUN-OFF FROM ACTIVE WORK AREAS; AND SHALL HAVE A MAXIMUM HEIGHT OF 35 FEET AND 2 ON 1 (OR FLATTER) SIDE SLOPES.
 4. SOIL STOCKPILES FROM TRENCH EXCAVATION SHALL BE LOCATED WITHIN THE TEMPORARY WORKSPACE SHOWN WITH HATCHING ON THESE DRAWINGS. STABILIZED SOIL BERMS LOCATED ON UPGRADIENT SIDE OF THE TRENCH SHALL BE USED AS A RUN-ON CONTROL FEATURE. STABILIZED BERMS LOCATED DOWNGRADEMENT OF THE TRENCH SHALL BE UTILIZED AS A PERIMETER SEDIMENT CONTROL FEATURE IN PLACE OF SILT FENCE OR SIMILAR VEGETATED.
 5. INTERCEPTOR DIVERSIONS LOCATED IN RESIDENTIAL AREAS AND AGRICULTURAL FIELDS SHALL BE REMOVED DURING FINAL GRADING. INTERCEPTOR DIVERSIONS THAT CAN BE LEFT IN PLACE, AT THE LANDOWNER'S DISCRETION, SHALL BE VEGETATED.
 6. FOLLOWING INITIAL SOIL DISTURBANCE OR RE-DISTURBANCE, PERMANENT OR TEMPORARY STABILIZATION MUST BE COMPLETED WITHIN 3 CALENDAR DAYS AS TO THE SURFACE OF ALL PERIMETER DIKES, SWALES, DITCHES, PERIMETER SLOPES, AND ALL SLOPES STEEPER THAN 3H:1V; AND 7 CALENDAR DAYS AS TO ALL OTHER DISTURBED OR GRADED AREAS ON THE PROJECT SITE NOT UNDER ACTIVE GRADING.
 7. PERMANENTLY STABILIZE DISTURBED AREAS IN ACCORDANCE WITH THE SEEDING RESTORATION TABLES ON DRAWING 1.
 8. PROPOSED PERMANENT ACCESS ROAD PAR-5 WILL BE IMPROVED BY GRADING AND STABILIZED WITH STONE TO FACILITATE TRUCK AND EQUIPMENT TRAFFIC.

PLANS APPROVED BY: *[Signature]*
DATE: 3/26/18
WATER AND SCIENCE ADMINISTRATION
WATERWAY CONSTRUCTION DIVISION
MARYLAND DEPARTMENT OF THE ENVIRONMENT

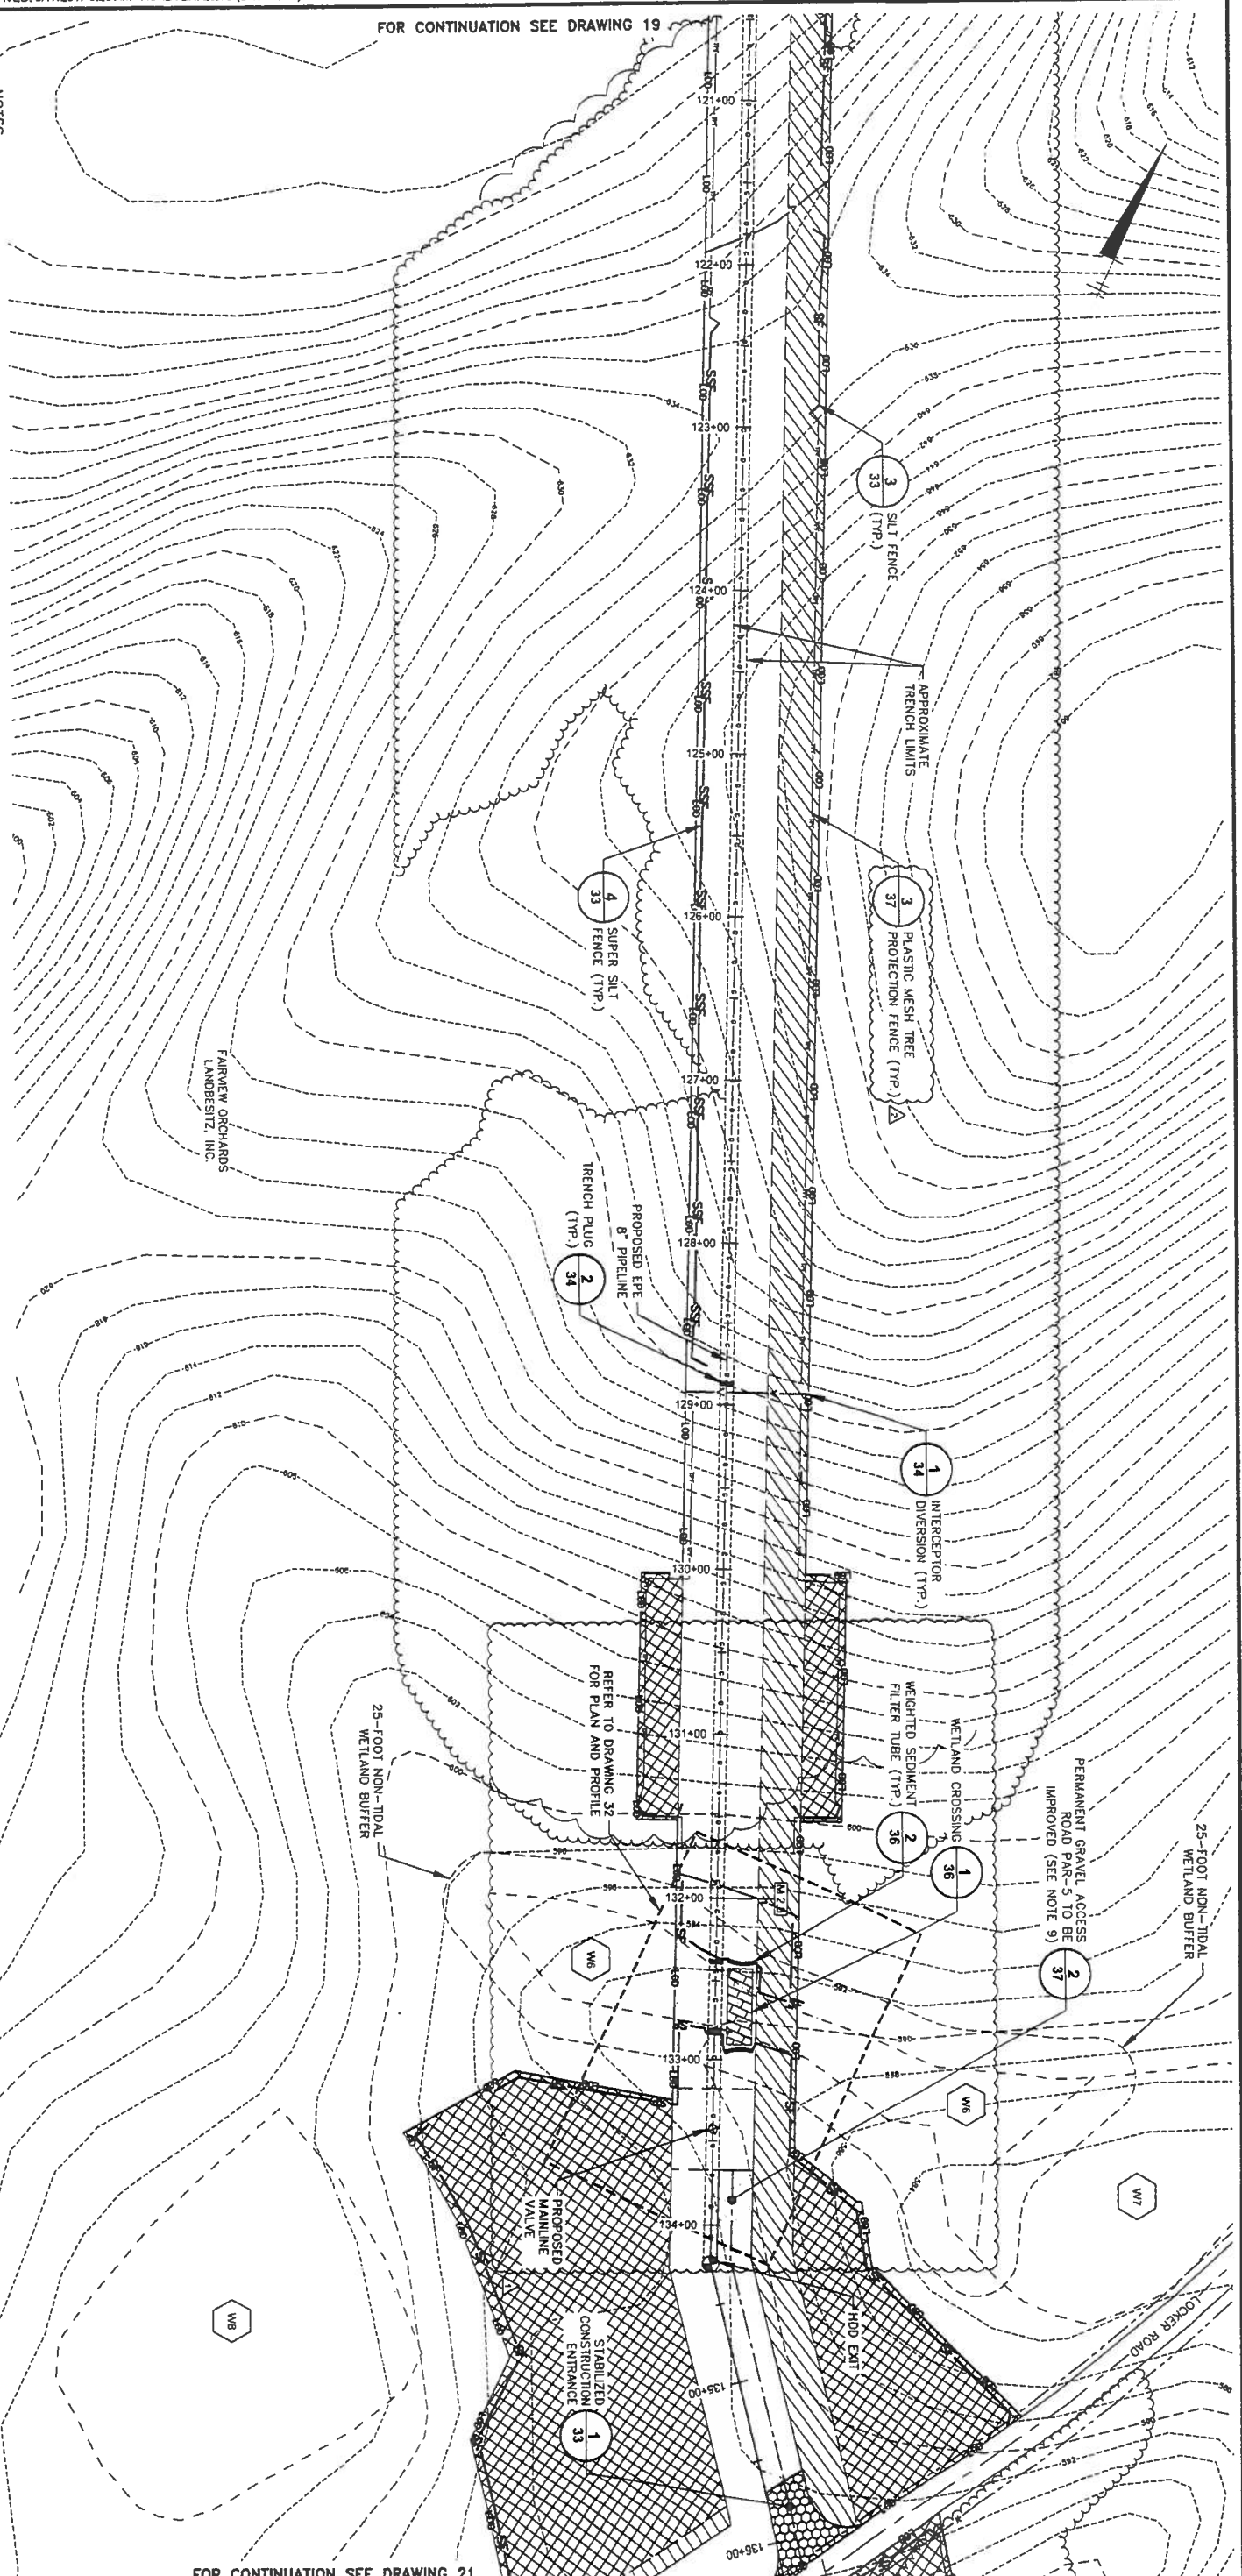

FOR CONTINUATION SEE DRAWING 21

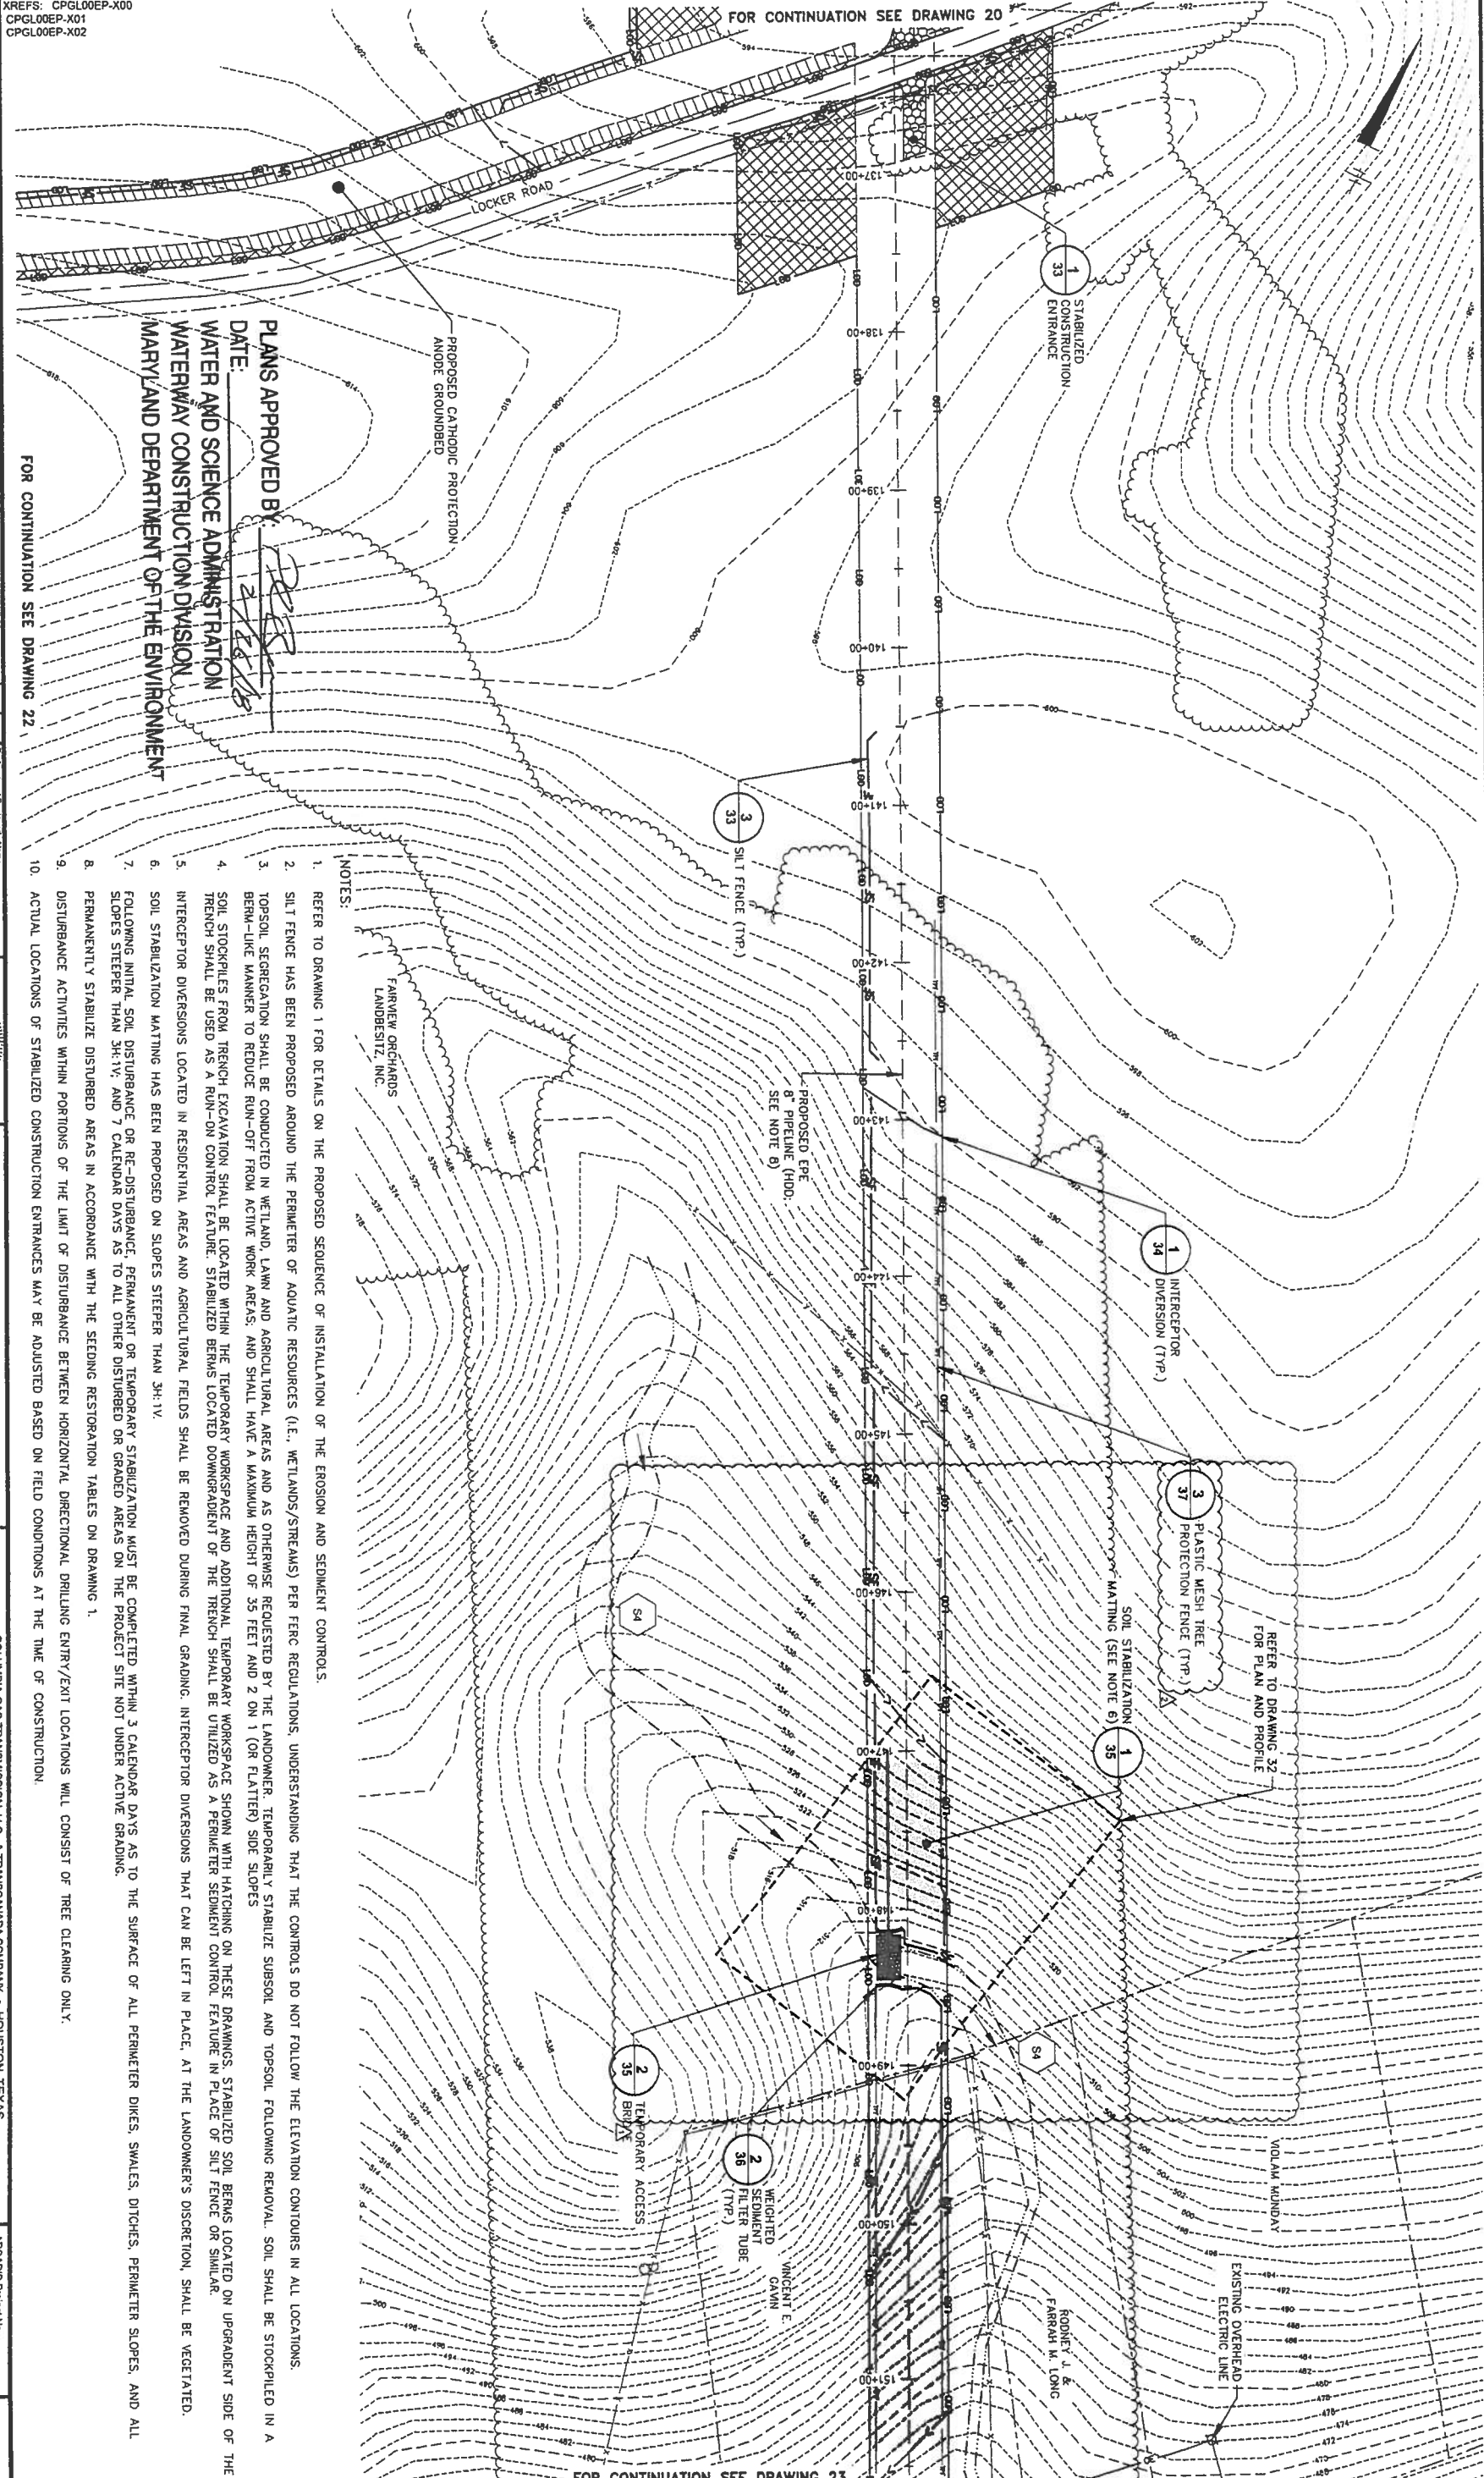


PLANS APPROVED BY: *[Signature]*
 DATE: 7/11/17
 WATER AND SCIENCE ADMINISTRATION
 WATERWAY CONSTRUCTION DIVISION
 MARYLAND DEPARTMENT OF THE ENVIRONMENT

- NOTES:
1. REFER TO DRAWING 1 FOR DETAILS ON THE PROPOSED SEQUENCE OF INSTALLATION OF THE EROSION AND SEDIMENT CONTROLS.
 2. SILT FENCE HAS BEEN PROPOSED AROUND THE PERMETER OF AQUATIC RESOURCES (I.E., WETLANDS/STREAMS) PER FERC REGULATIONS. UNDERSTANDING THAT THE CONTROLS DO NOT FOLLOW THE ELEVATION CONTOURS IN ALL LOCATIONS.
 3. TOPSOIL SEGREGATION SHALL BE CONDUCTED IN WETLAND, LAWN AND AGRICULTURAL AREAS AND AS OTHERWISE REQUESTED BY THE LANDOWNER. TEMPORARILY STABILIZE SUBSOIL AND TOPSOIL FOLLOWING REMOVAL. SOIL SHALL BE STOCKPILED IN A BERM-LIKE MANNER TO REDUCE RUN-OFF FROM ACTIVE WORK AREAS. AND SHALL HAVE A MAXIMUM HEIGHT OF 35 FEET AND 2 ON 1 (OR FLATTER) SIDE SLOPES
 4. SOIL STOCKPILES FROM TRENCH EXCAVATION SHALL BE LOCATED WITHIN THE TEMPORARY WORKSPACE SHOWN WITH HATCHING ON THESE DRAWINGS. STABILIZED SOIL BERMS LOCATED ON UPGRADIENT SIDE OF THE TRENCH SHALL BE USED AS A RUN-ON CONTROL FEATURE. STABILIZED BERMS LOCATED DOWNGRADIENT OF THE TRENCH SHALL BE UTILIZED AS A PERMETER SEDIMENT CONTROL FEATURE IN PLACE OF SILT FENCE OR SIMILAR.
 5. INTERCEPTOR DIVERSIONS LOCATED IN RESIDENTIAL AREAS AND AGRICULTURAL FIELDS SHALL BE REMOVED DURING FINAL GRADING. INTERCEPTOR DIVERSIONS THAT CAN BE LEFT IN PLACE AT THE LANDOWNER'S DISCRETION, SHALL BE VEGETATED.
 6. SOIL STABILIZATION MATTING HAS BEEN PROPOSED ON SLOPES STEEPER THAN 3H:1V.
 7. FOLLOWING INITIAL SOIL DISTURBANCE OR RE-DISTURBANCE, PERMANENT OR TEMPORARY STABILIZATION MUST BE COMPLETED WITHIN 3 CALENDAR DAYS AS TO THE SURFACE OF ALL PERMETER DIKES, SWALES, DITCHES, PERMETER SLOPES, AND ALL SLOPES STEEPER THAN 3H:1V, AND 7 CALENDAR DAYS AS TO ALL OTHER DISTURBED OR GRADED AREAS ON THE PROJECT SITE NOT UNDER ACTIVE GRADING.
 8. PERMANENTLY STABILIZE DISTURBED AREAS IN ACCORDANCE WITH THE SEEDING RESTORATION TABLES ON DRAWING 1.
 9. DISTURBANCE ACTIVITIES WITHIN PORTIONS OF THE LIMIT OF DISTURBANCE BETWEEN HORIZONTAL DIRECTIONAL DRILLING ENTRY/EXIT LOCATIONS WILL CONSIST OF TREE CLEARING ONLY.
 10. ACTUAL LOCATIONS OF STABILIZED CONSTRUCTION ENTRANCES MAY BE ADJUSTED BASED ON FIELD CONDITIONS AT THE TIME OF CONSTRUCTION.


FOR CONTINUATION SEE DRAWING 22

FOR CONTINUATION SEE DRAWING 23

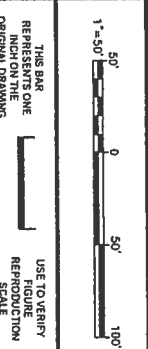

No.	Date	Revisions	By	Checked by
1	7/11/17	FOREST CONSERVATION ACT RE: URGEMENT	ALS	ARL
2	7/11/17	FOREST COMMENT RESPONSE	ALS	ARL

Professional Engineer's Name
ALLEN LONG
 Professional Engineer's No.
 MD 34862
 State
 MD
 Date Signed
 7/11/17
 Project No.
 J.D.
 Checked by
 ARL

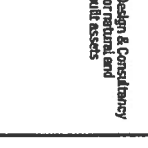

COLUMBIA GAS TRANSMISSION, L.L.C. A TRANSCANADA COMPANY • HOUSTON, TEXAS
 EASTERN PANHANDLE EXPANSION PROJECT
SITE PLAN (STA. 136+00 TO 151+50)


ARCADIS Project No.
 CPGL00EP-0001-0008A
 Date
 MARCH 2017
 ARCADIS
 6041 Vantage Road Extension
 Suite 300 PA 15090
 Wexford, PA 15090
 TEL: 724.742.8100

XREFS: CPGL00EP-X00
 CPGL00EP-X01
 CPGL00EP-X02

THIS SHEET REPRESENTS ONE INCH ON THE ORIGINAL DRAWING. USE TO VERIFY REPRODUCTION SCALE.	
No. <u>1</u> / <u>1</u>	Date <u>7/17/17</u>
FOREST CONSERVATION ACT THE JURISDICTION	
Designed by <u>ALS</u>	State <u>MD</u>
Drawn by <u>ALS</u>	Date Signed <u>MD</u>
Project Mgr. <u>ALS</u>	Created by <u>ALS</u>
Professional Engineer's Name ALLEN LONG Professional Engineer's No. <u>MD 34882</u>	




COLUMBIA GAS TRANSMISSION, LLC, A TRANSCANADA COMPANY • HOUSTON, TEXAS
 EASTERN PANHANDLE EXPANSION PROJECT
SITE PLAN (ANODE GROUNDBED CATHODIC PROTECTION AT STA. 136+00)
 ARCADIS Project No. CPGL00EP-0001-0009A
 Date: MARCH 2017
 ARCADIS
 6041 Wallace Road Extension
 Suite 300
 Westford, MA 01580
 TEL: 781.742.9180

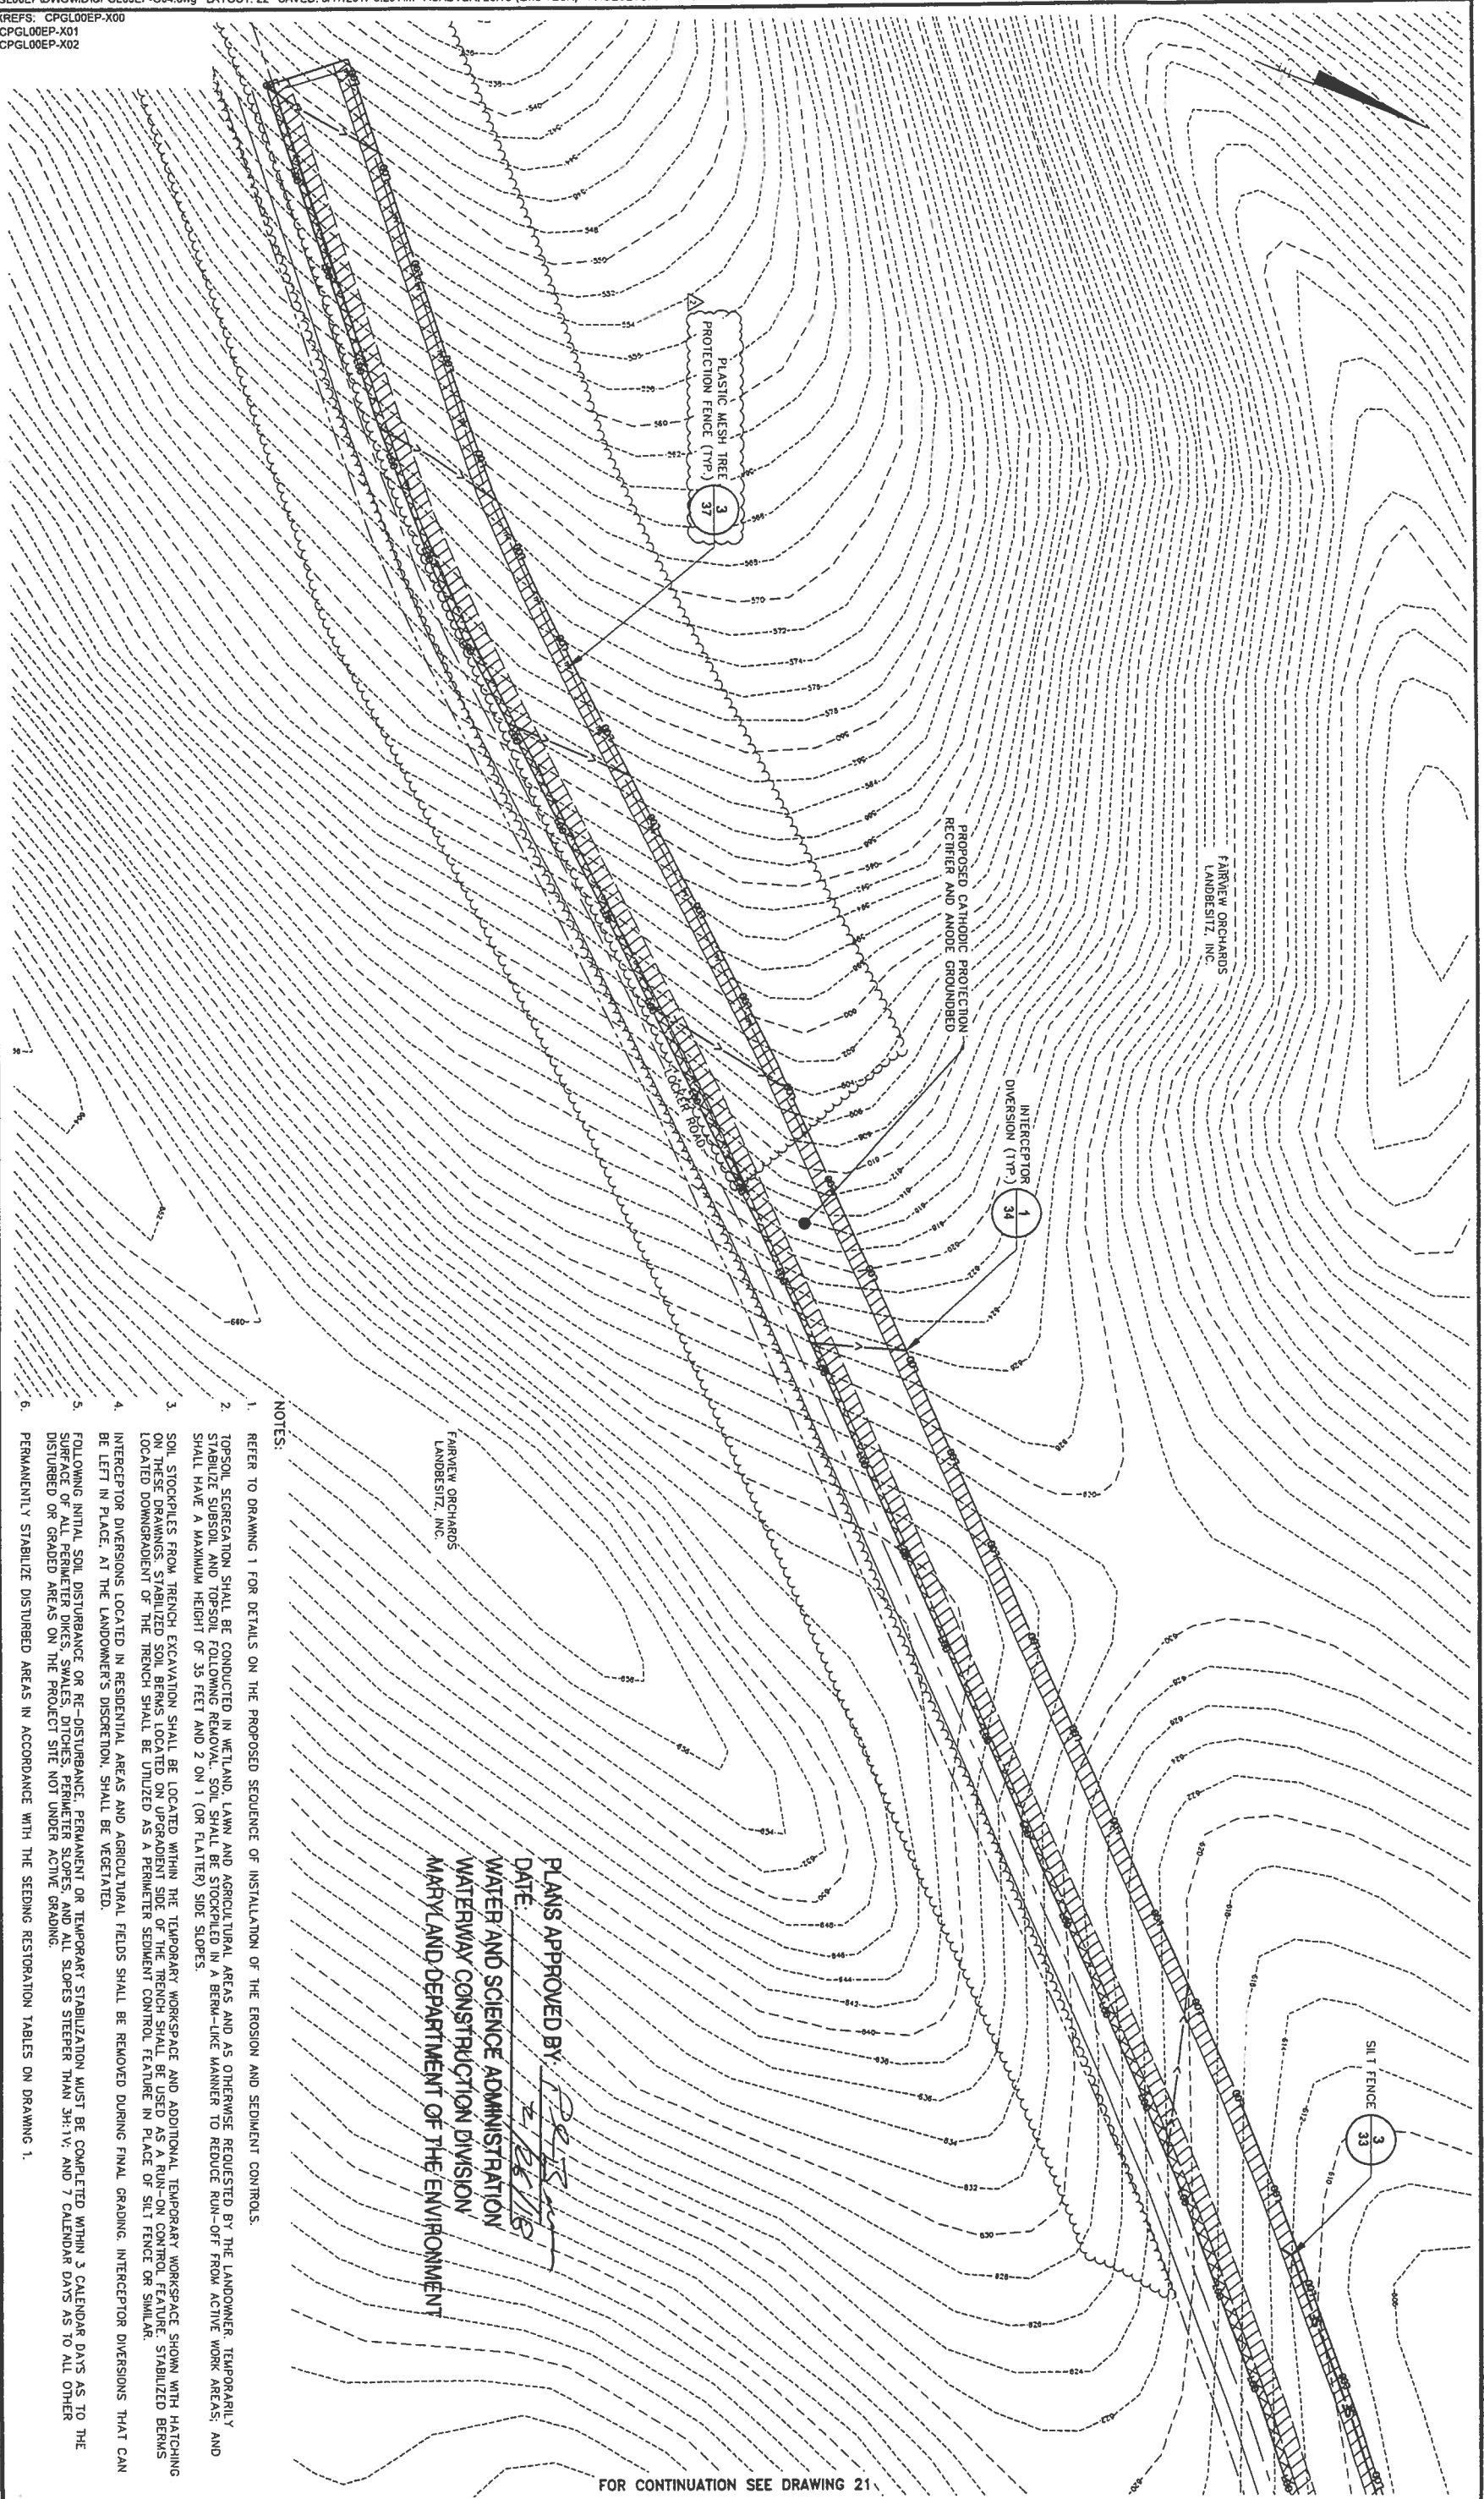

- NOTES:**
- REFER TO DRAWING 1 FOR DETAILS ON THE PROPOSED SEQUENCE OF INSTALLATION OF THE EROSION AND SEDIMENT CONTROLS.
 - TOPSOIL SEGREGATION SHALL BE CONDUCTED IN WETLAND, LAWN AND AGRICULTURAL AREAS AND AS OTHERWISE REQUESTED BY THE LANDOWNER. TEMPORARILY STABILIZE SUBSOIL/TOPSOIL FOLLOWING REMOVAL. SOIL SHALL BE STOCKPILED IN A BERM-LIKE MANNER TO REDUCE RUN-OFF FROM ACTIVE WORK AREAS. AND SHALL HAVE A MAXIMUM HEIGHT OF 35 FEET AND 2 ON 1 (OR FLATTER) SIDE SLOPES.
 - SOIL STOCKPILES FROM TRENCH EXCAVATION SHALL BE LOCATED WITHIN THE TEMPORARY WORKSPACE AND ADDITIONAL TEMPORARY WORKSPACE SHOWN WITH HATCHING ON THESE DRAWINGS. STABILIZED SOIL BERMS LOCATED ON UPWARD SLOPE OF THE TRENCH SHALL BE USED AS A RUN-ON CONTROL FEATURE. STABILIZED BERMS LOCATED DOWNWARD SLOPE OF THE TRENCH SHALL BE UTILIZED AS A PERIMETER SEDIMENT CONTROL FEATURE IN PLACE OF SILT FENCE OR SIMILAR.
 - INTERCEPTOR DIVERSIONS LOCATED IN RESIDENTIAL AREAS AND AGRICULTURAL FIELDS SHALL BE REMOVED DURING FINAL GRADING. INTERCEPTOR DIVERSIONS THAT CAN BE LEFT IN PLACE, AT THE LANDOWNER'S DISCRETION, SHALL BE VEGETATED.
 - FOLLOWING INITIAL SOIL DISTURBANCE OR RE-DISTURBANCE, PERMANENT OR TEMPORARY STABILIZATION MUST BE COMPLETED WITHIN 3 CALENDAR DAYS AS TO THE SURFACE OF ALL PERIMETER DIKES, SWALES, DITCHES, PERIMETER SLOPES, AND ALL SLOPES STEEPER THAN 3H:1V, AND 7 CALENDAR DAYS AS TO ALL OTHER DISTURBED OR GRADED AREAS ON THE PROJECT SITE NOT UNDER ACTIVE GRADING.
 - PERMANENTLY STABILIZE DISTURBED AREAS IN ACCORDANCE WITH THE SEEDING RESTORATION TABLES ON DRAWING 1.

PLANS APPROVED BY: *[Signature]*
 DATE: 2/28/18
 WATER AND SCIENCE ADMINISTRATION
 WATERWAY CONSTRUCTION DIVISION
 MARYLAND DEPARTMENT OF THE ENVIRONMENT

FOR CONTINUATION SEE DRAWING 21.

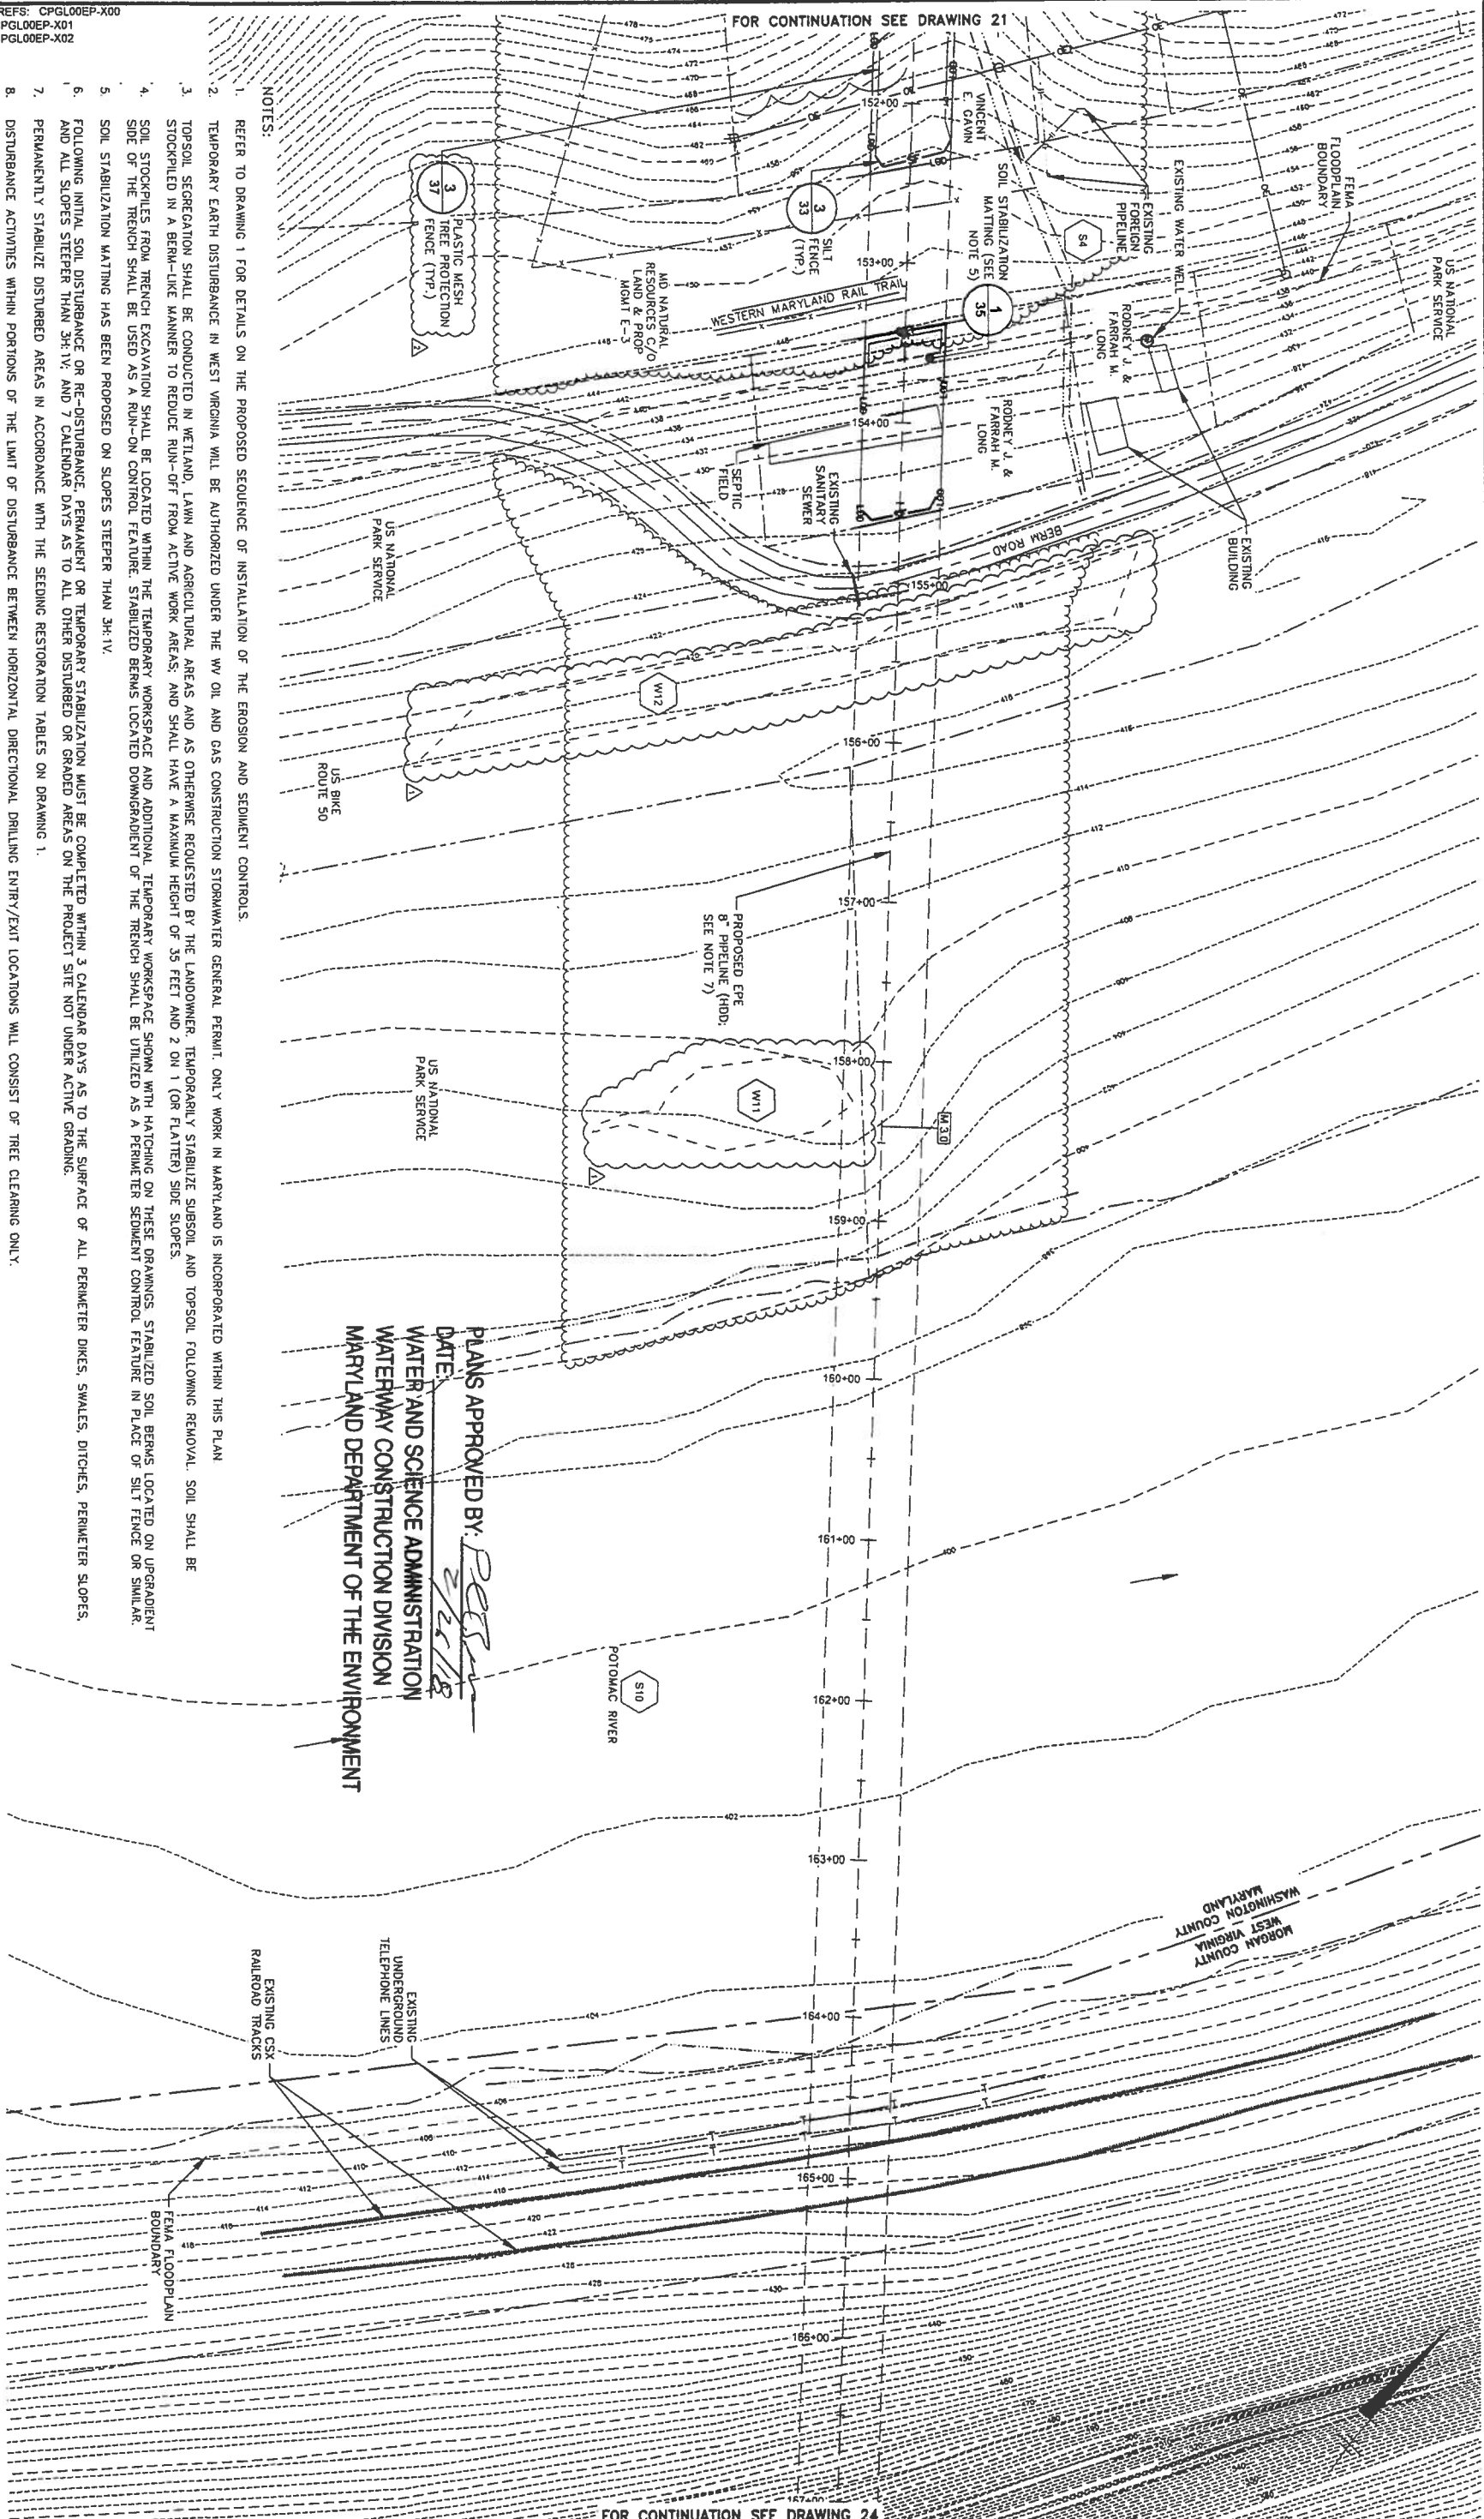

FOR CONTINUATION SEE DRAWING 21

FOR CONTINUATION SEE DRAWING 24

NOTES:

1. REFER TO DRAWING 1 FOR DETAILS ON THE PROPOSED SEQUENCE OF INSTALLATION OF THE EROSION AND SEDIMENT CONTROLS.
2. TEMPORARY EARTH DISTURBANCE IN WEST VIRGINIA WILL BE AUTHORIZED UNDER THE WV OIL AND GAS CONSTRUCTION STORMWATER GENERAL PERMIT. ONLY WORK IN MARYLAND IS INCORPORATED WITHIN THIS PLAN.
3. TOPSOIL SEGREGATION SHALL BE CONDUCTED IN WETLAND, LAWN AND AGRICULTURAL AREAS AND AS OTHERWISE REQUESTED BY THE LANDOWNER. TEMPORARILY STABILIZE SUBSOIL AND TOPSOIL FOLLOWING REMOVAL. SOIL SHALL BE STOCKPILED IN A BERM-LIKE MANNER TO REDUCE RUN-OFF FROM ACTIVE WORK AREAS. AND SHALL HAVE A MAXIMUM HEIGHT OF 35 FEET AND 2 ON 1 (OR FLATTER) SIDE SLOPES.
4. SOIL STOCKPILES FROM TRENCH EXCAVATION SHALL BE LOCATED WITHIN THE TEMPORARY WORKSPACE SHOWN WITH HATCHING ON THESE DRAWINGS. STABILIZED SOIL BERMS LOCATED ON UPGRADIENT SIDE OF THE TRENCH SHALL BE USED AS A RUN-ON CONTROL FEATURE. STABILIZED BERMS LOCATED DOWNGRADIENT OF THE TRENCH SHALL BE UTILIZED AS A PERIMETER SEDIMENT CONTROL FEATURE IN PLACE OF SILT FENCE OR SIMILAR.
5. SOIL STABILIZATION MATING HAS BEEN PROPOSED ON SLOPES STEEPER THAN 3H:1V.
6. FOLLOWING INITIAL SOIL DISTURBANCE OR RE-DISTURBANCE, PERMANENT OR TEMPORARY STABILIZATION MUST BE COMPLETED WITHIN 3 CALENDAR DAYS AS TO THE SURFACE OF ALL PERIMETER DIKES, SWALES, DITCHES, PERIMETER SLOPES, AND ALL SLOPES STEEPER THAN 3H:1V, AND 7 CALENDAR DAYS AS TO ALL OTHER DISTURBED OR GRADED AREAS ON THE PROJECT SITE NOT UNDER ACTIVE GRADING.
7. PERMANENTLY STABILIZE DISTURBED AREAS IN ACCORDANCE WITH THE SEEDING RESTORATION TABLES ON DRAWING 1.
8. DISTURBANCE ACTIVITIES WITHIN PORTIONS OF THE LIMIT OF DISTURBANCE BETWEEN HORIZONTAL DIRECTIONAL DRILLING ENTRY/EXIT LOCATIONS WILL CONSIST OF TREE CLEARING ONLY.

PLANS APPROVED BY: *[Signature]*
 DATE: *[Signature]*
 WATER AND SCIENCE ADMINISTRATION
 WATERWAY CONSTRUCTION DIVISION
 MARYLAND DEPARTMENT OF THE ENVIRONMENT


XREFS: CPGLO0EP-X00 CPGLO0EP-X01 CPGLO0EP-X02	
THIS BAR REPRESENTS ONE INCH ON THE ORIGINAL DRAWING	USE TO VERIFY FIGURE REPRODUCTION SCALE
THIS DRAWING IS NOT BE REFERRED TO OR FIELD ADJUSTED OR PART WHEN THE EXPRESS WRITTEN PERMISSION OF SAVER	REVISIONS:
NO. DATE BY	REVISIONS
1 7/17/17 MDC COLMANT RESPONSE	1. SLOPE CORRECTION
2 7/17/17 MDC COLMANT RESPONSE	2. SLOPE CORRECTION
3 7/17/17 MDC COLMANT RESPONSE	3. SLOPE CORRECTION
100 7/17/17 MDC COLMANT RESPONSE	100. SLOPE CORRECTION

COLUMBIA GAS TRANSMISSION, L.L.C., A TRANSCANADA COMPANY • HOUSTON, TEXAS
 EASTERN PANHANDLE EXPANSION PROJECT
SITE PLAN (STA. 151+50 TO 167+00)

ARCADIS Project No. CPGLO0EP-0001-000084
 DATE: MARCH 2017
 ARCADIS
 6041 Wallace Road Extension
 Suite 300 PA 15390
 Tel: 724.742.8100

FOR CONTINUATION SEE DRAWING 23

XREFS: CPGL00EP-X00
CPGL00EP-X01
CPGL00EP-X02

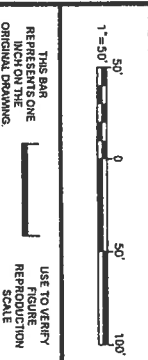


No.	DATE	BY	REVISIONS
1	7/13/17	WV DEP COMMENT RESPONSE	

Professional Engineer's Name	ALLEN LONG
Professional Engineer's No.	MD 34652
State	MD
Drawn by	ALS
Checked by	ALS
Date Signed	
Project Mgr	JD
Created by	ARL



COLUMBIA GAS TRANSMISSION, L.L.C., A TRANSCANADA COMPANY • HOUSTON, TEXAS
EASTERN PANHANDLE EXPANSION PROJECT
SITE PLAN (STA. 167+00 TO 177+74)
ARCADIS Project No. CPGL00EP-001-0000A
Date: MARCH 2017
ARCADIS Eastern Panhandle Road Extension
Station 167+00 to 177+74
Wexford, PA 15090
Tel: 724.742.9180
24

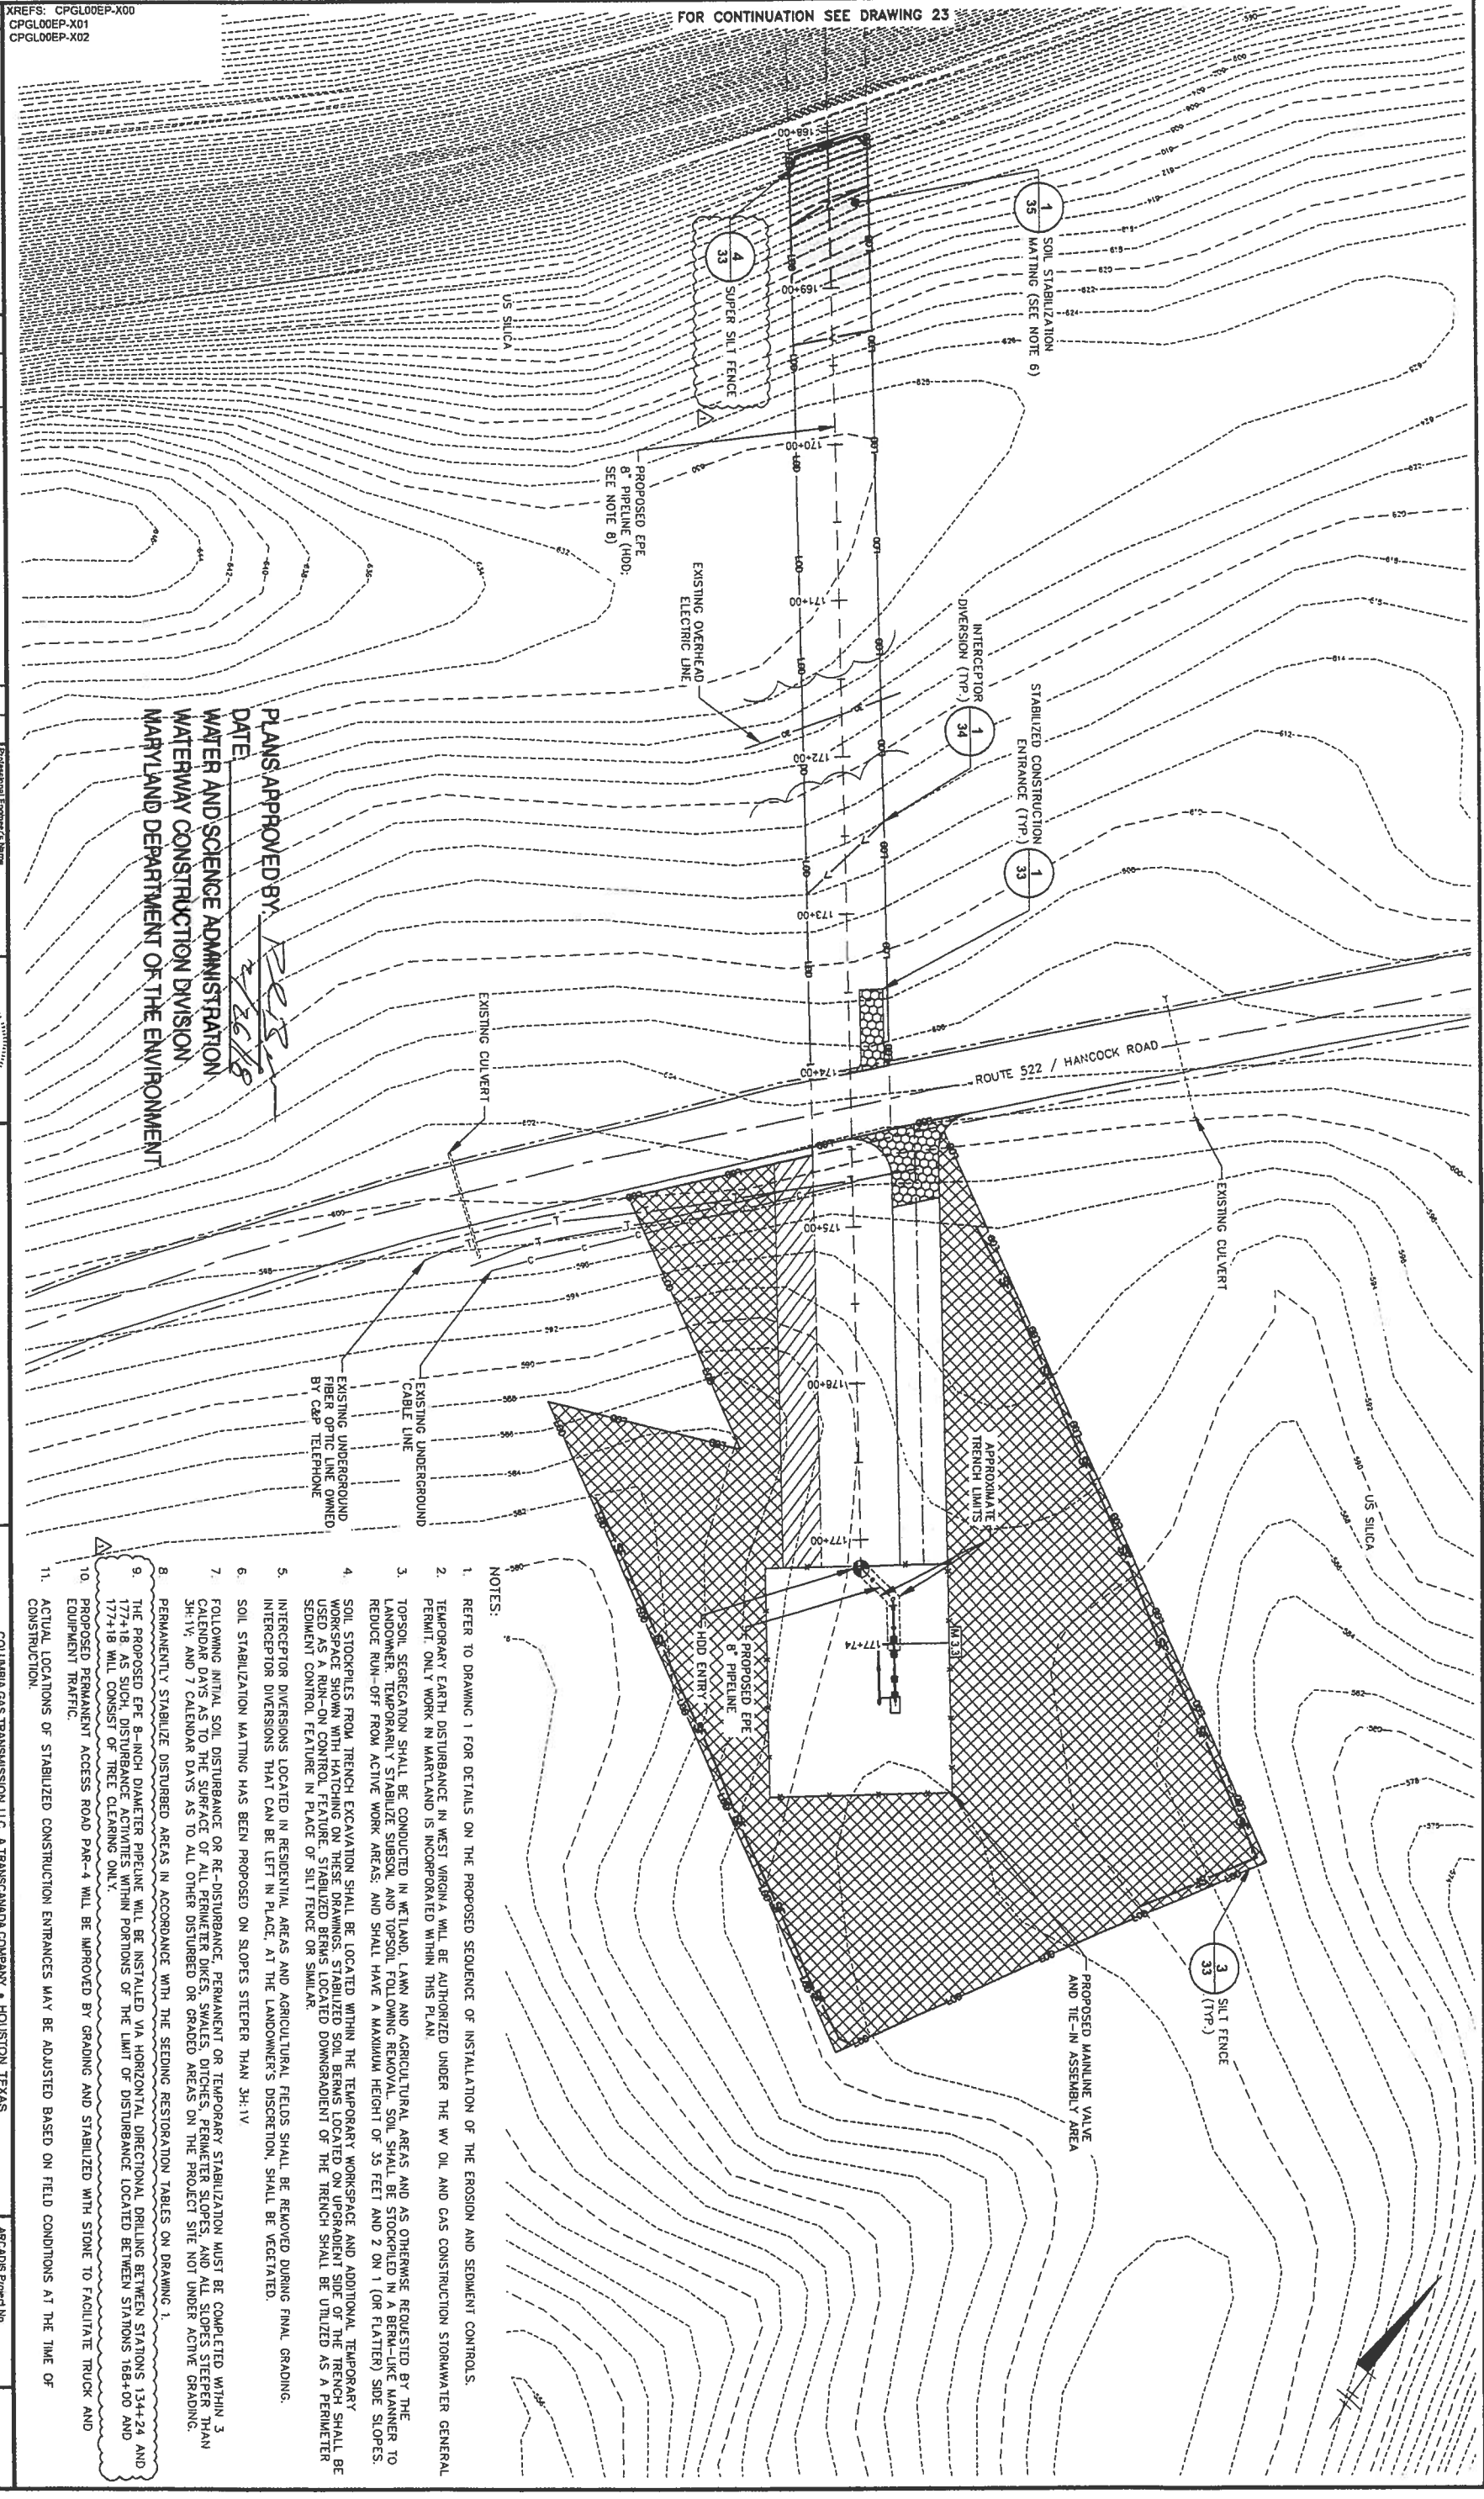

PLANS APPROVED BY: *[Signature]*
DATE: 7/26/18
WATER AND SCIENCE ADMINISTRATION
WATERWAY CONSTRUCTION DIVISION
MARYLAND DEPARTMENT OF THE ENVIRONMENT

- NOTES:
- REFER TO DRAWING 1 FOR DETAILS ON THE PROPOSED SEQUENCE OF INSTALLATION OF THE EROSION AND SEDIMENT CONTROLS.
 - TEMPORARY EARTH DISTURBANCE IN WEST VIRGINIA WILL BE AUTHORIZED UNDER THE WV OIL AND GAS CONSTRUCTION STORMWATER GENERAL PERMIT. ONLY WORK IN MARYLAND IS INCORPORATED WITHIN THIS PLAN.
 - TOPSOIL SEPARATION SHALL BE CONDUCTED IN WETLAND, LAWN, AND AGRICULTURAL AREAS AND AS OTHERWISE REQUESTED BY THE LANDOWNER. TEMPORARILY STABILIZE SUBSOIL AND TOPSOIL FOLLOWING REMOVAL. SOIL SHALL BE STOCKPILED IN A BERM-LIKE MANNER TO REDUCE RUN-OFF FROM ACTIVE WORK AREAS. AND SHALL HAVE A MAXIMUM HEIGHT OF 35 FEET AND 2 ON 1 (OR FLATTER) SIDE SLOPES. SOIL STOCKPILES FROM TRENCH EXCAVATION SHALL BE LOCATED WITHIN THE TEMPORARY WORKSPACE AND ADDITIONAL TEMPORARY WORKSPACE SHOWN WITH HATCHING ON THESE DRAWINGS. STABILIZED SOIL BERMS LOCATED ON UPGRADEMENT SIDE OF THE TRENCH SHALL BE USED AS A RUN-ON CONTROL FEATURE. STABILIZED BERMS LOCATED DOWNGRADIENT OF THE TRENCH SHALL BE UTILIZED AS A PERIMETER SEDIMENT CONTROL FEATURE IN PLACE OF SILT FENCE OR SIMILAR.
 - INTERCEPTOR DIVERSIONS LOCATED IN RESIDENTIAL AREAS AND AGRICULTURAL FIELDS SHALL BE REMOVED DURING FINAL GRADING. INTERCEPTOR DIVERSIONS THAT CAN BE LEFT IN PLACE, AT THE LANDOWNER'S DISCRETION, SHALL BE VEGETATED.
 - SOIL STABILIZATION MATTING HAS BEEN PROPOSED ON SLOPES STEEPER THAN 3H:1V.
 - FOLLOWING INITIAL SOIL DISTURBANCE OR RE-DISTURBANCE, PERMANENT OR TEMPORARY STABILIZATION MUST BE COMPLETED WITHIN 3 CALENDAR DAYS AS TO THE SURFACE OF ALL PERIMETER DICES, SPALES, DIGGES, PERIMETER SLOPES, AND ALL SLOPES STEEPER THAN 3H:1V; AND 7 CALENDAR DAYS AS TO ALL OTHER DISTURBED OR GRADED AREAS ON THE PROJECT SITE NOT UNDER ACTIVE GRADING.
 - PERMANENTLY STABILIZE DISTURBED AREAS IN ACCORDANCE WITH THE SEEDING RESTORATION TABLES ON DRAWING 1.
 - THE PROPOSED EPE 8-INCH DIAMETER PIPELINE WILL BE INSTALLED VIA HORIZONTAL DIRECTIONAL DRILLING BETWEEN STATIONS 134+24 AND 177+18. AS SUCH, DISTURBANCE ACTIVITIES WITHIN PORTIONS OF THE LIMIT OF DISTURBANCE LOCATED BETWEEN STATIONS 168+00 AND 177+18 WILL CONSIST OF TREE CLEARING ONLY.
 - PROPOSED PERMANENT ACCESS ROAD PAR-4 WILL BE IMPROVED BY GRADING AND STABILIZED WITH STONE TO FACILITATE TRUCK AND EQUIPMENT TRAFFIC.
 - ACTUAL LOCATIONS OF STABILIZED CONSTRUCTION ENTRANCES MAY BE ADJUSTED BASED ON FIELD CONDITIONS AT THE TIME OF CONSTRUCTION.

XREFS: CPGL00EP-X00
CPGL00EP-X01
CPGL00EP-X02

THIS DRAWING IS THE PROPERTY OF THE ARCHADIS GROUP. IT IS NOT ANTICIPATED THAT USE OF THE STAGING AREA WILL RESULT IN SOIL DISTURBANCE IF EXCESSIVE ROUTING OCCURS. THE AREA WILL BE STABILIZED WITH GEOTEXTILE AND GRAVEL FOR THE REMAINDER OF WORK. THIS AREA WILL REMAIN A GRAVEL SURFACE FOLLOWING COMPLETION OF CONSTRUCTION ACTIVITIES.

PROPOSED TEMPORARY ACCESS ROAD TAR-1 IS AN EXISTING GRAVEL ROAD THAT WILL NOT BE IMPROVED. ADDITIONAL ROCK MAY BE PLACED ALONG THE EXISTING GRAVEL ACCESS ROAD AS NEEDED TO SUPPORT TRUCK AND EQUIPMENT TRAFFIC.

DATE	7/7/17	REVISIONS	NO.	DESCRIPTION
DATE		NO.		

DESIGNED BY	ALLEN LONG	CHECKED BY	ALLEN LONG
DRAWN BY	ALLEN LONG	DATE	7/7/17



ARCADIS | Design & Consultancy
for natural and built assets

ARCADIS U.S., INC


SITE PLAN (CONTRACTOR STAGING AREA AND TEMPORARY ACCESS ROAD TAR-1)

PLANS APPROVED BY: *[Signature]*
DATE: 7/26/18

WATER AND SCIENCE ADMINISTRATION
WATERWAY CONSTRUCTION DIVISION
MARYLAND DEPARTMENT OF THE ENVIRONMENT

ARCADIS Project No. CPGL00EP-00010000A
Date: MARCH 2017
ARCADIS 5001 W. State Road Extension Suite 300 Wexford, PA 15090 Tel. 724.742.9180

25

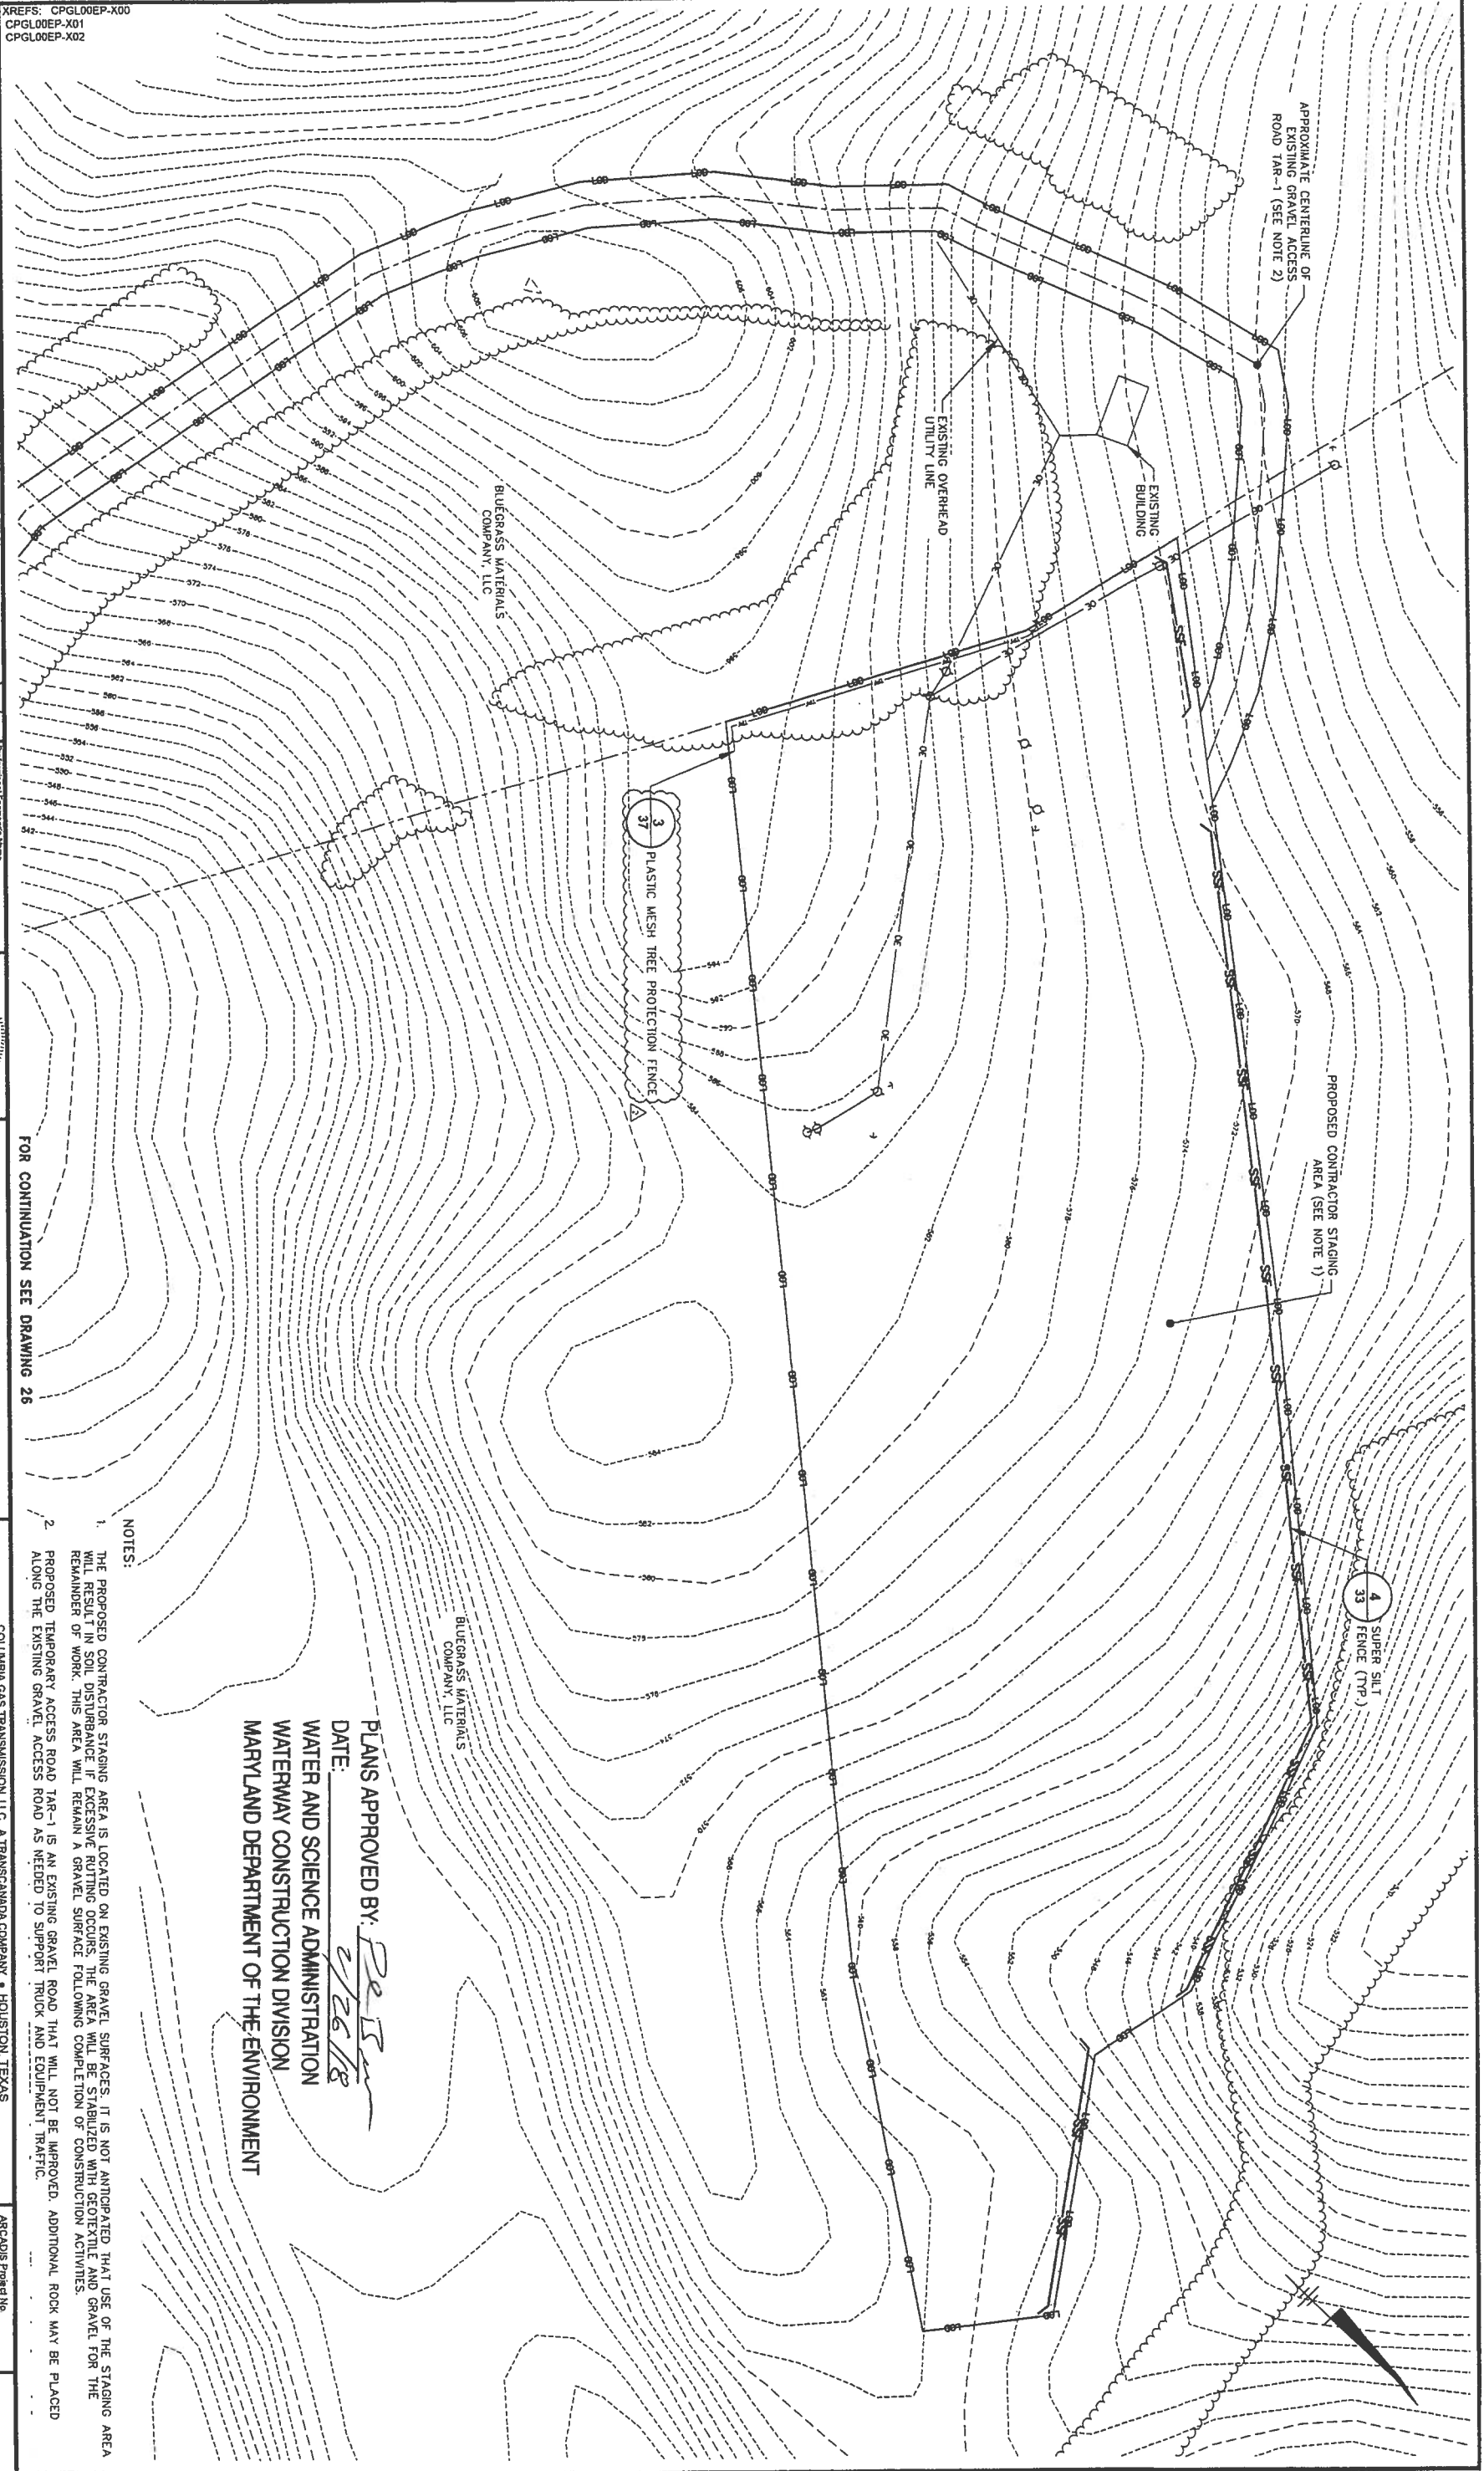

FOR CONTINUATION SEE DRAWING 26

NOTES:

1. THE PROPOSED CONTRACTOR STAGING AREA IS LOCATED ON EXISTING GRAVEL SURFACES. IT IS NOT ANTICIPATED THAT USE OF THE STAGING AREA WILL RESULT IN SOIL DISTURBANCE IF EXCESSIVE ROUTING OCCURS. THE AREA WILL BE STABILIZED WITH GEOTEXTILE AND GRAVEL FOR THE REMAINDER OF WORK. THIS AREA WILL REMAIN A GRAVEL SURFACE FOLLOWING COMPLETION OF CONSTRUCTION ACTIVITIES.
2. PROPOSED TEMPORARY ACCESS ROAD TAR-1 IS AN EXISTING GRAVEL ROAD THAT WILL NOT BE IMPROVED. ADDITIONAL ROCK MAY BE PLACED ALONG THE EXISTING GRAVEL ACCESS ROAD AS NEEDED TO SUPPORT TRUCK AND EQUIPMENT TRAFFIC.

PLANS APPROVED BY: *[Signature]*
DATE: 7/26/18

WATER AND SCIENCE ADMINISTRATION
WATERWAY CONSTRUCTION DIVISION
MARYLAND DEPARTMENT OF THE ENVIRONMENT

BLUEGRASS MATERIALS COMPANY, LLC

BLUEGRASS MATERIALS COMPANY, LLC

3 PLASTIC MESH TREE PROTECTION FENCE

4 SUPER SILT FENCE (TYP)

APPROXIMATE CENTERLINE OF EXISTING GRAVEL ACCESS ROAD TAR-1 (SEE NOTE 2)

PROPOSED CONTRACTOR STAGING AREA (SEE NOTE 1)


EXISTING BUILDING

EXISTING OVERHEAD UTILITY LINE



CPGL00EP-X00
 CPGL00EP-X01
 CPGL00EP-X02

- NOTES:
1. PROPOSED TEMPORARY ACCESS ROAD TAR-1 IS AN EXISTING GRAVEL ROAD THAT WILL NOT BE IMPROVED. ADDITIONAL ROCK MAY BE PLACED ALONG THE EXISTING GRAVEL ACCESS ROAD AS NEEDED TO SUPPORT TRUCK AND EQUIPMENT TRAFFIC.

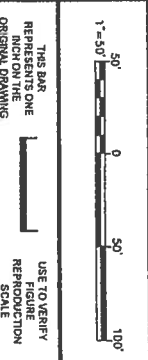


No.	Date	Revisions	By	Checked
1	7/17/17	FOREST CONSERVATION ACT REQUIREMENT	ALS	JRL

Professional Engineer's Name
ALLEN LONG
 Professional Engineer's No.
 MD 34862
 State
 MD
 Date Signed
 Project Mgr.
 JD
 Checked by
 JRL

ARCADIS Design & Consultancy for natural and built assets
 ARCADIS U.S., INC.

COLUMBIA GAS TRANSMISSION, LLC, A TRANSCANADA COMPANY • HOUSTON, TEXAS
 EASTERN PANHANDLE EXPANSION PROJECT
SITE PLAN (TEMPORARY ACCESS ROAD TAR-1)
 ARCADIS Project No. CPGL00EP-0001-0009A
 Date: MARCH-2017
 ARCADIS
 5041 Wallace Road Extension
 Wexford, PA 15090
 Tel: 724.752.2180

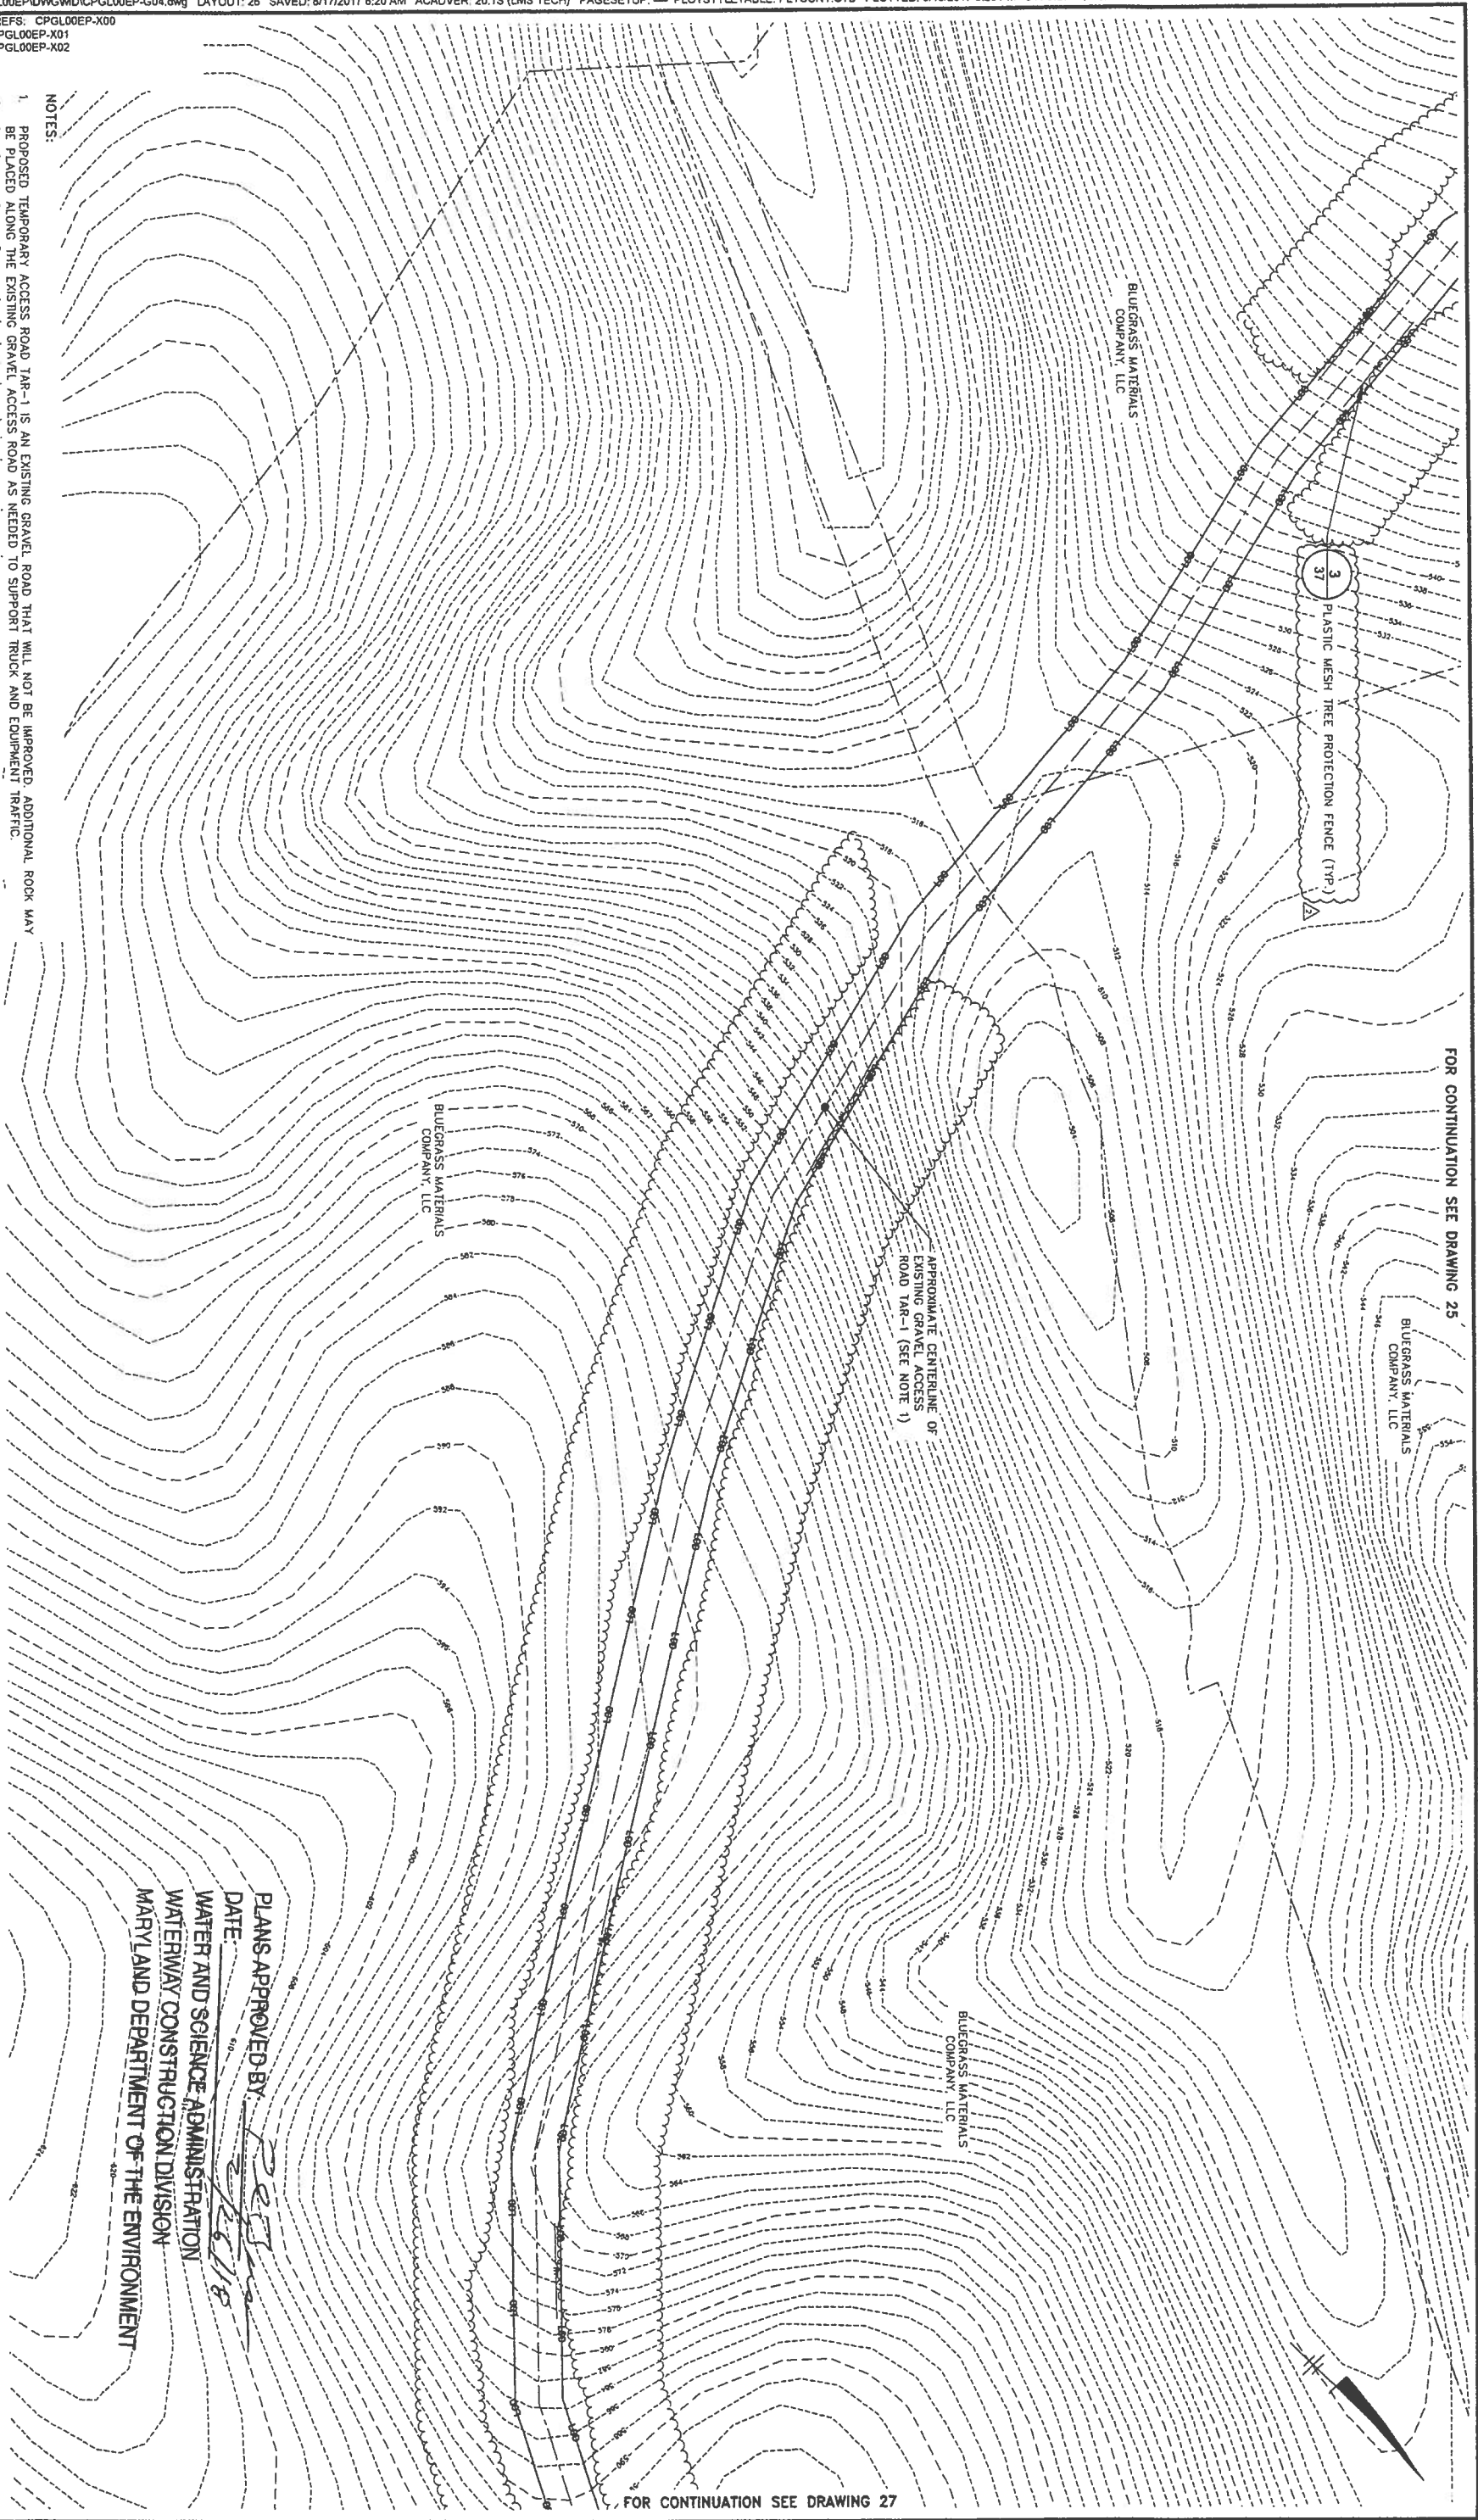

FOR CONTINUATION SEE DRAWING 25

FOR CONTINUATION SEE DRAWING 27

PLANS APPROVED BY: *[Signature]*
 DATE: 5/10/18
 WATER AND SCIENCE ADMINISTRATION
 WATERWAY CONSTRUCTION DIVISION
 MARYLAND DEPARTMENT OF THE ENVIRONMENT

XREFS: CPGL00EP-X00
 CPGL00EP-X01
 CPGL00EP-X02

FOR CONTINUATION SEE DRAWING 27

THIS BAR REPRESENTS ONE INCH ON THE ORIGINAL DRAWING

USE TO VERIFY REPRODUCTION SCALE

No.	Date	By	Checked by

Revisions
 THIS DRAWING IS THE PROPERTY OF THE ARCHITECT. ANY REVISIONS TO THIS DRAWING MUST BE MADE IN THE ORIGINAL DRAWING AND MUST BE APPROVED BY THE ARCHITECT.



ARCADIS Design & Consultancy
 for natural and built assets


ARCADIS U.S., INC.

SITE PLAN (TEMPORARY ACCESS ROAD TAR-1)

COLUMBIA GAS TRANSMISSION, L.L.C., A TRANSCANADA COMPANY • HOUSTON, TEXAS
 EASTERN PANHANDLE EXPANSION PROJECT


ARCADIS Project No: CPGL00EP-001.0009A
 Date: MARCH 2017
 ARCADIS
 6041 Wallace Road Extension
 Suite 300
 Warfield, PA 15090
 Tel: 724.742.8180

28

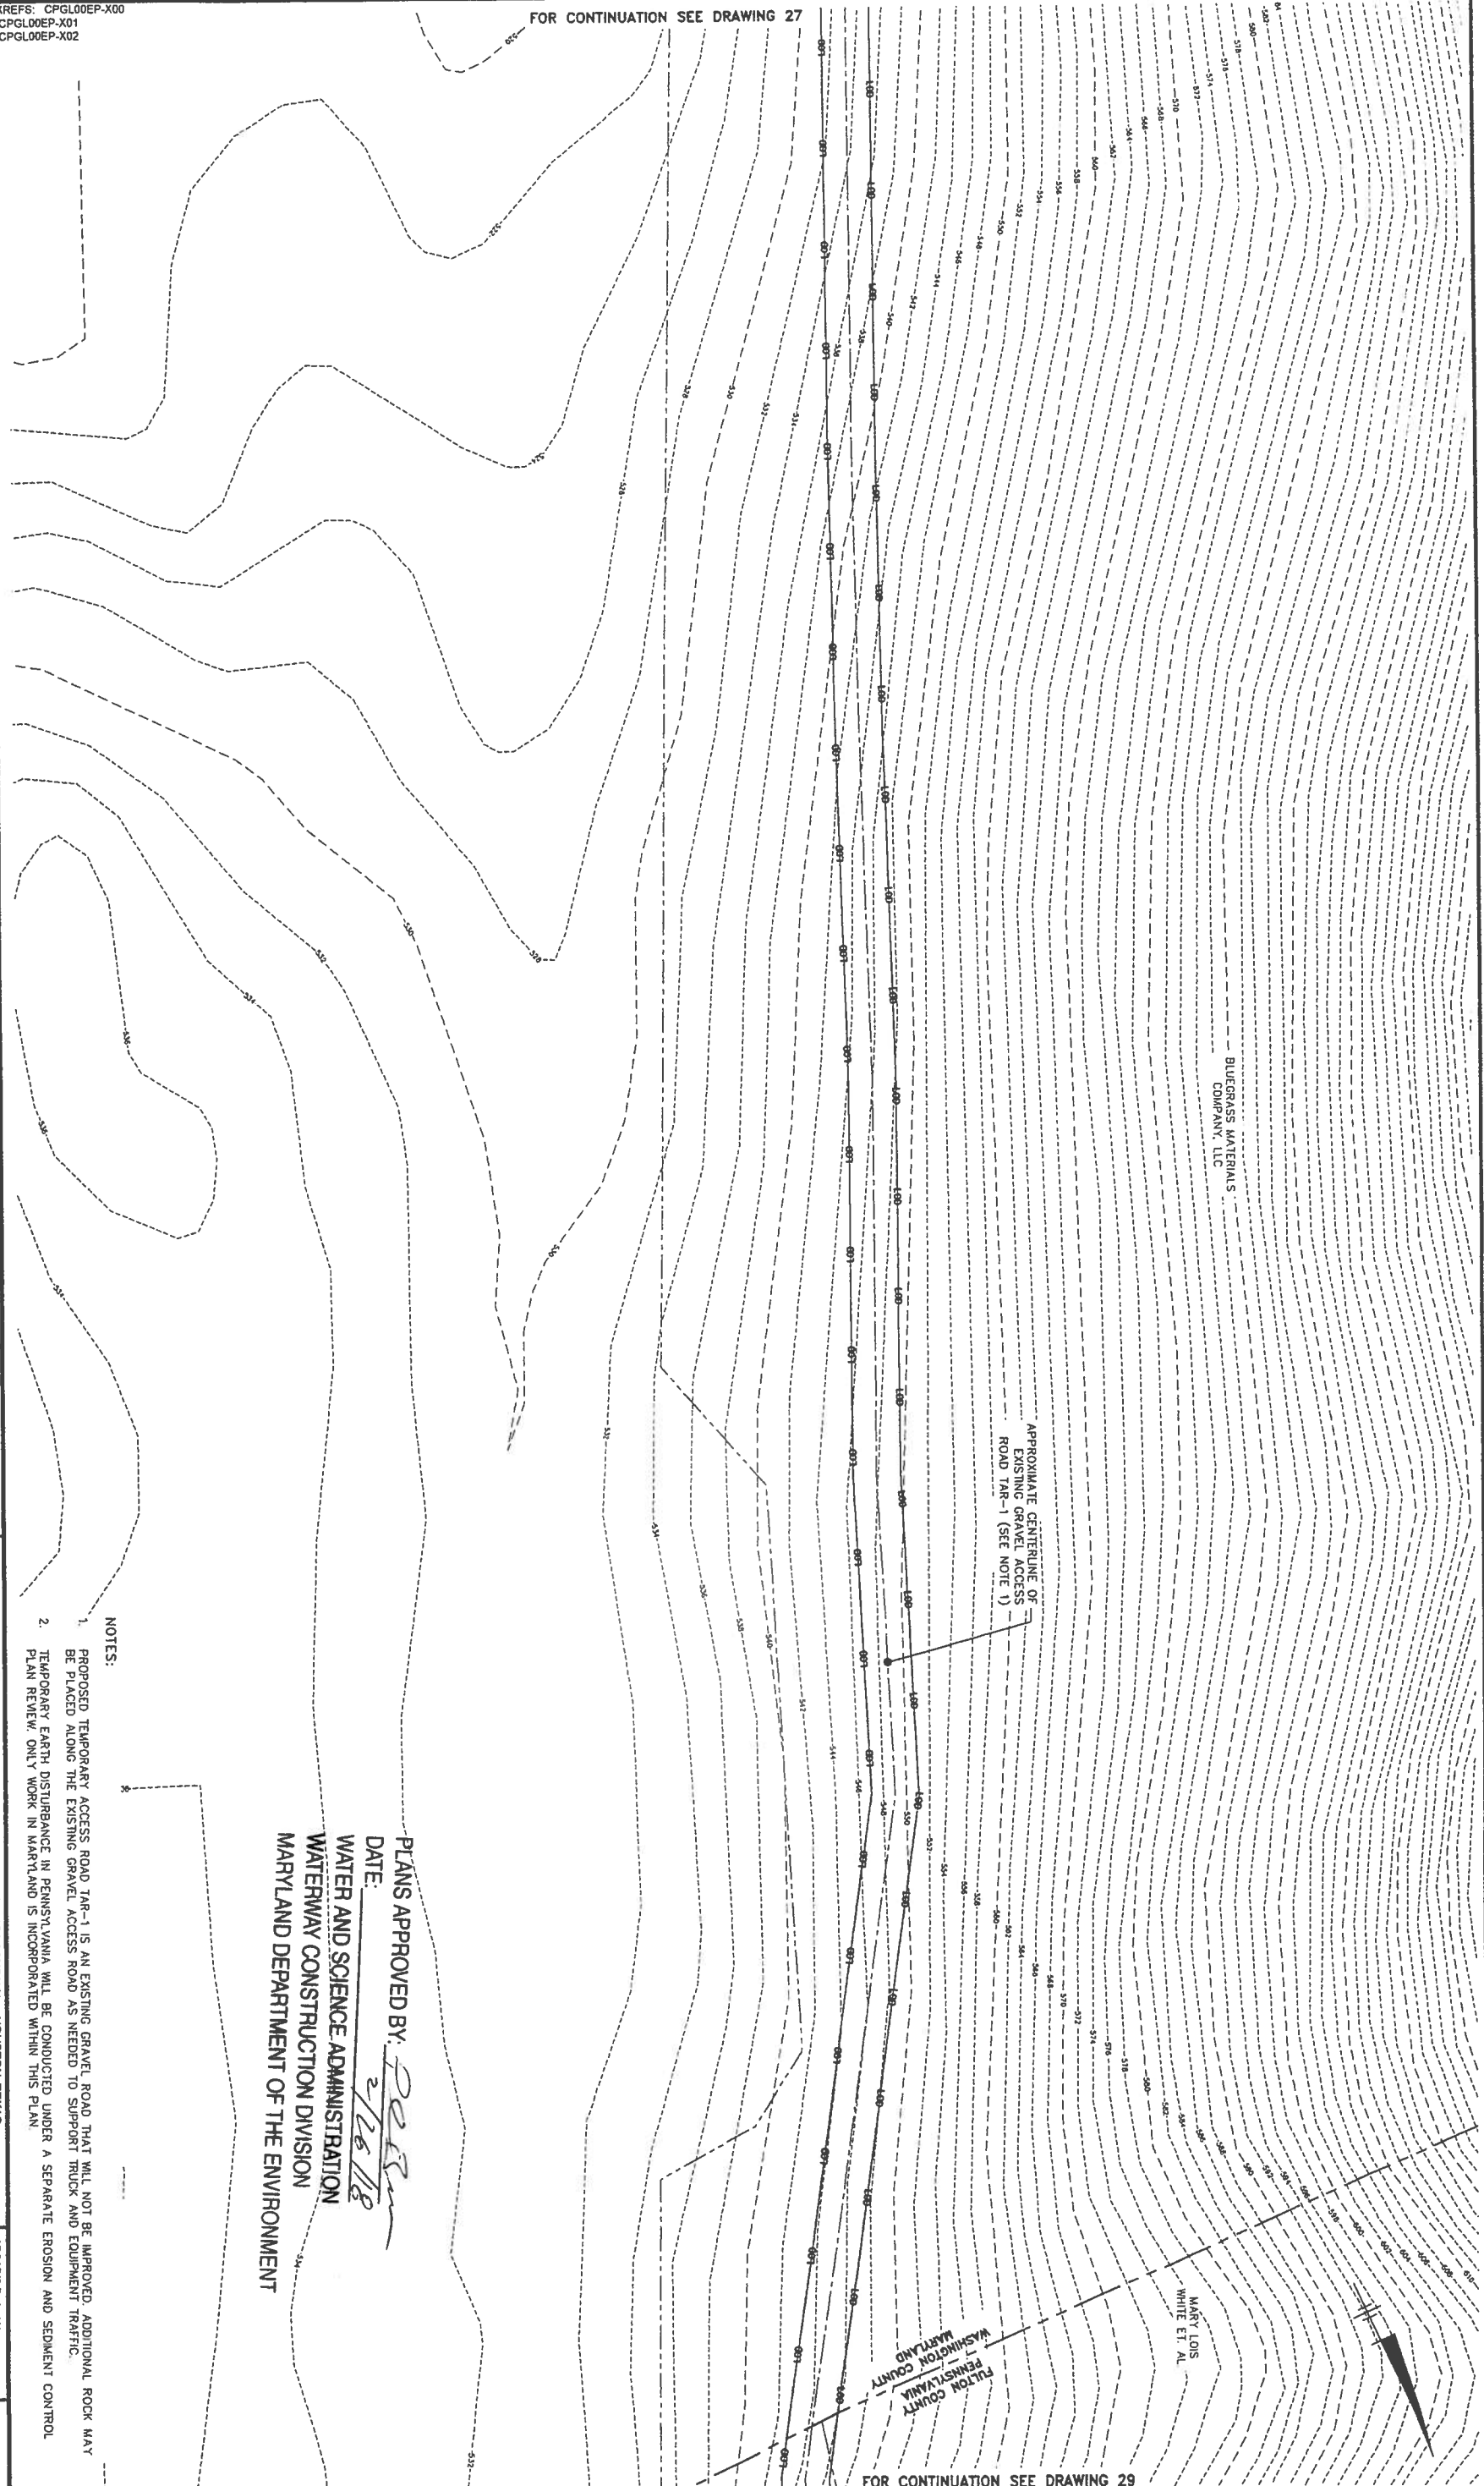


FOR CONTINUATION SEE DRAWING 29

FOR CONTINUATION SEE DRAWING 28

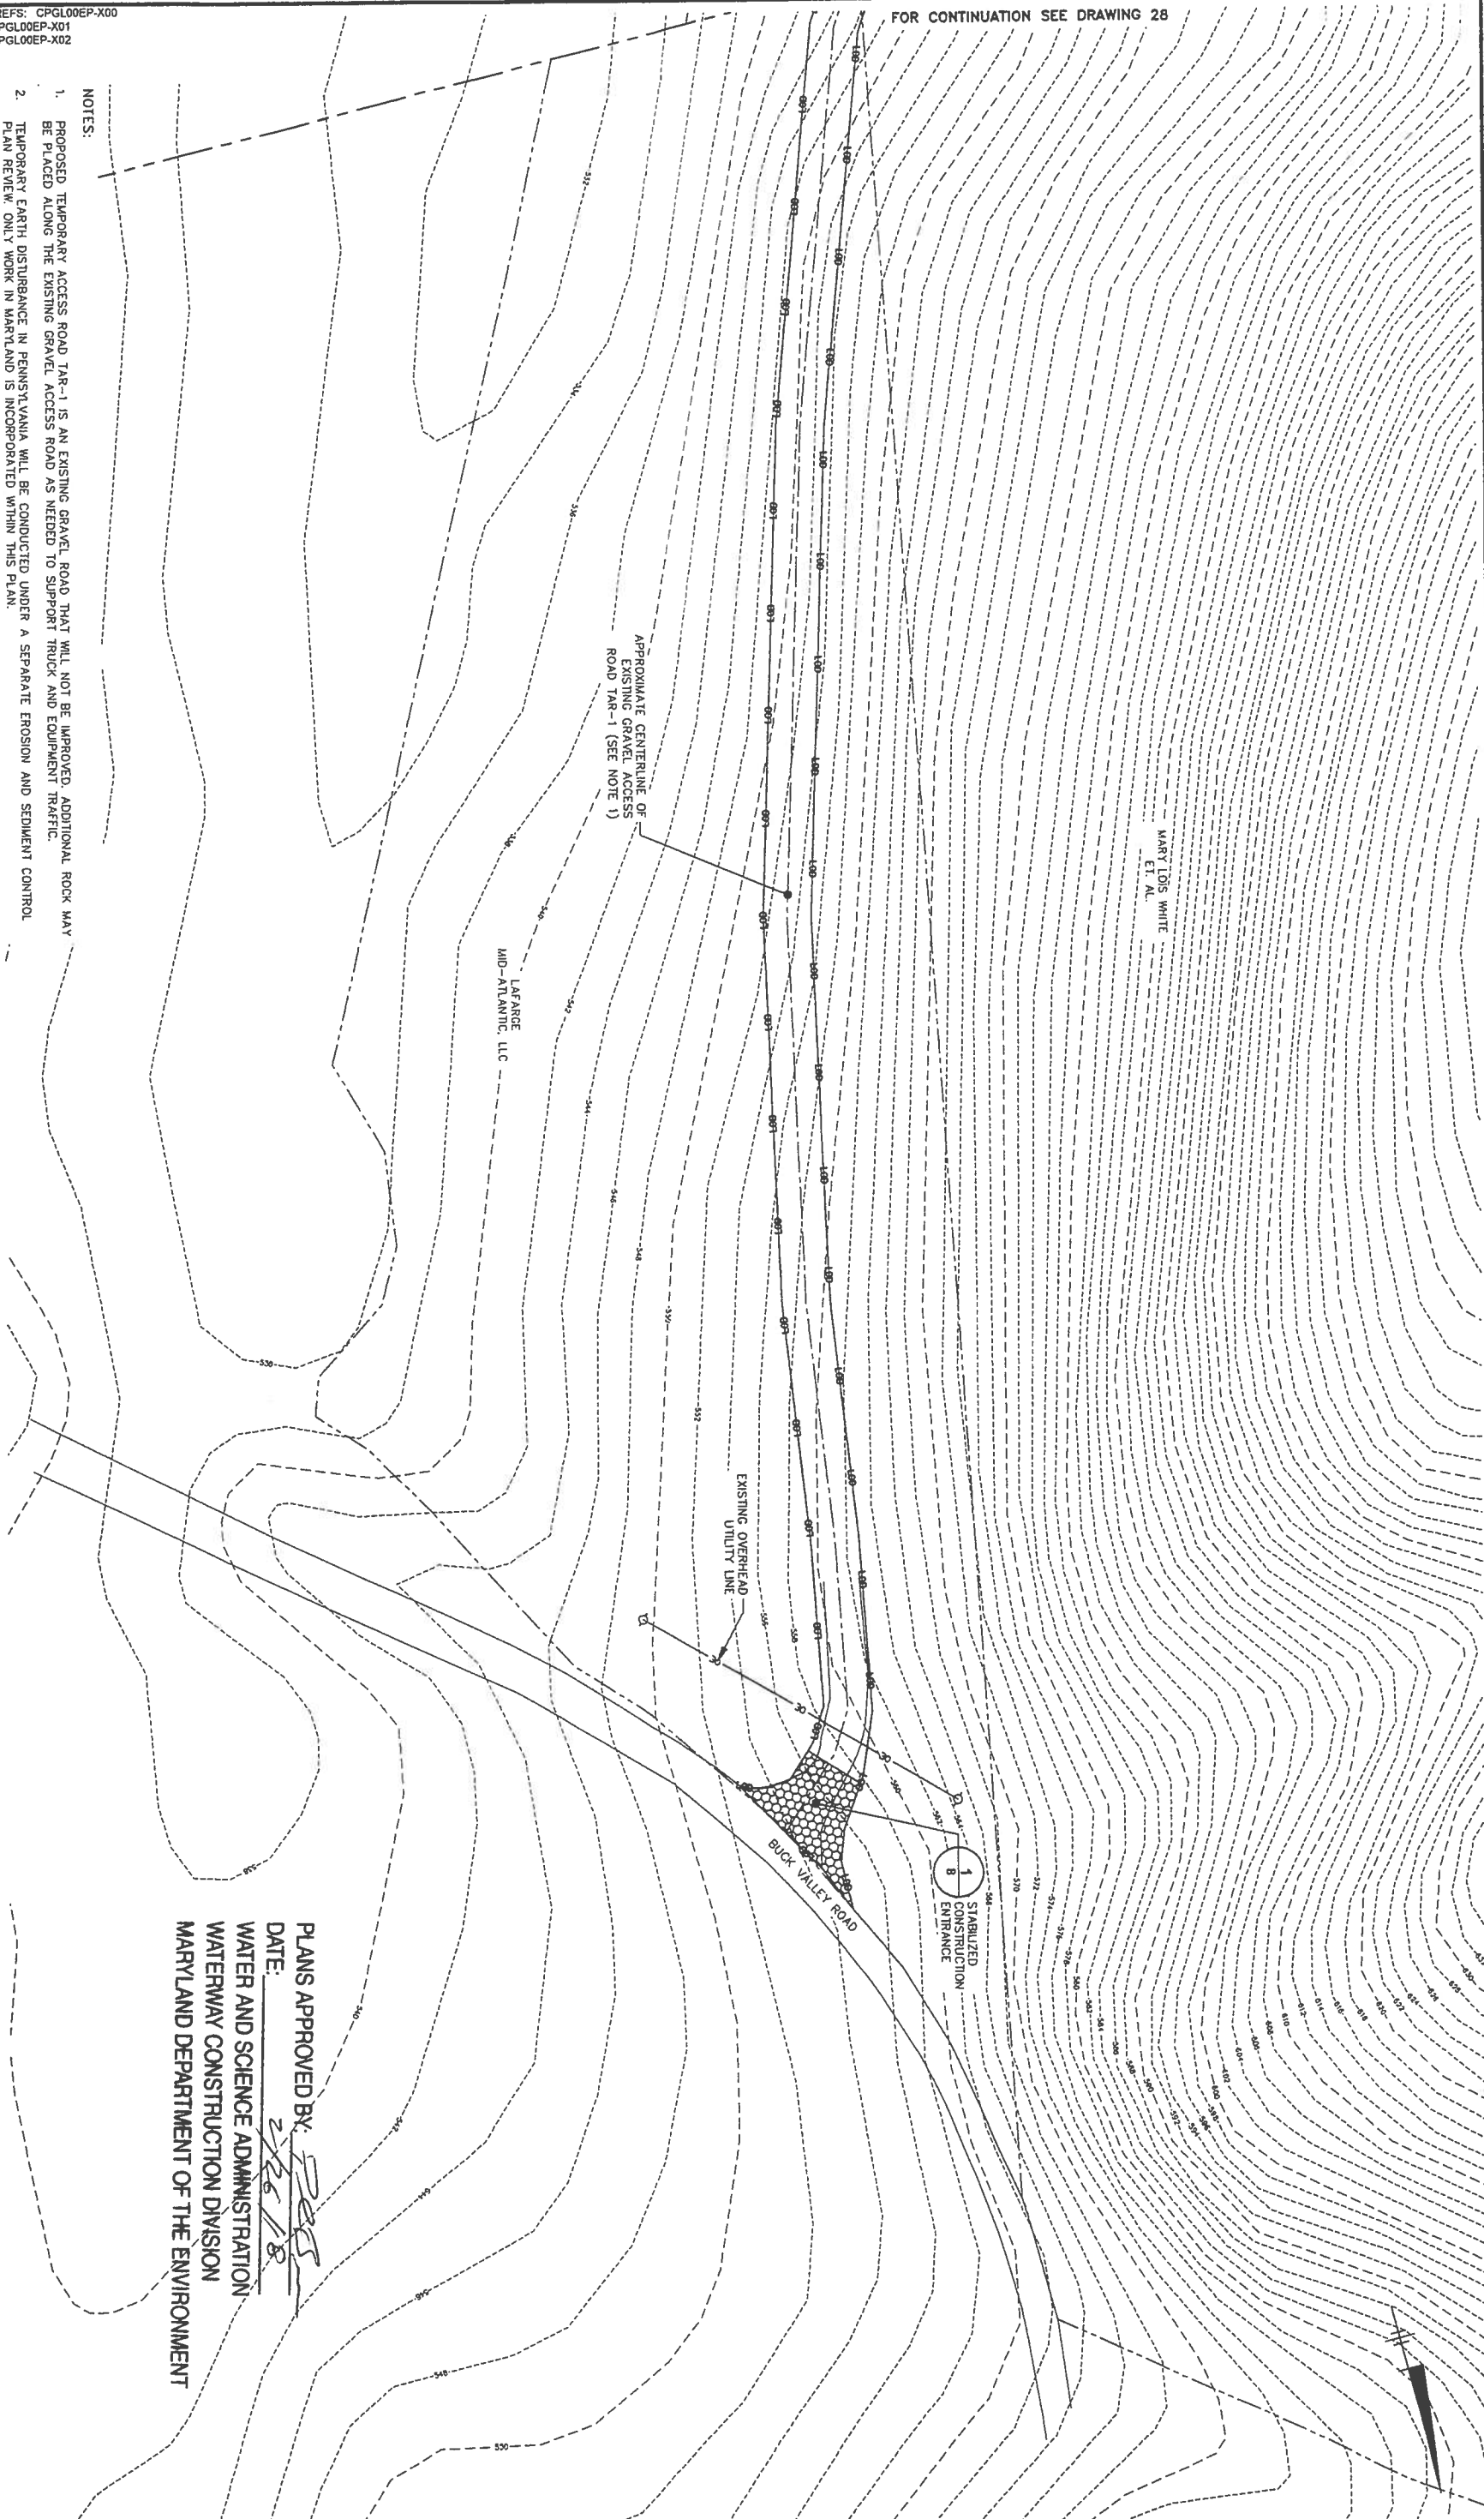

- NOTES:
1. PROPOSED TEMPORARY ACCESS ROAD TAR-1 IS AN EXISTING GRAVEL ROAD THAT WILL NOT BE IMPROVED. ADDITIONAL ROCK MAY BE PLACED ALONG THE EXISTING GRAVEL ACCESS ROAD AS NEEDED TO SUPPORT TRUCK AND EQUIPMENT TRAFFIC.
 2. TEMPORARY EARTH DISTURBANCE IN PENNSYLVANIA WILL BE CONDUCTED UNDER A SEPARATE EROSION AND SEDIMENT CONTROL PLAN REVIEW. ONLY WORK IN MARYLAND IS INCORPORATED WITHIN THIS PLAN.

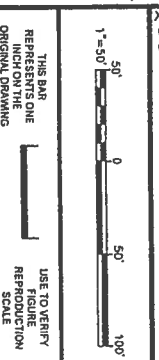

No.	Date	Revisions	By	Checked by




COLUMBIA GAS TRANSMISSION, L.L.C. A TRANSCANADA COMPANY • HOUSTON, TEXAS
 EASTERN PANHANDLE EXPANSION PROJECT
SITE PLAN (TEMPORARY ACCESS ROAD TAR-1)

PLANS APPROVED BY: *[Signature]*
 DATE: 2/26/18
 WATER AND SCIENCE ADMINISTRATION
 WATERWAY CONSTRUCTION DIVISION
 MARYLAND DEPARTMENT OF THE ENVIRONMENT

ARCADIS Project No. CPGL000EP-00071-0008A
Date MARCH 2017
ARCADIS 3000 Wendover, PA 15086 Tel: 724.742.9190

CPGL00EP-X00
 CPGL00EP-X01
 CPGL00EP-X05

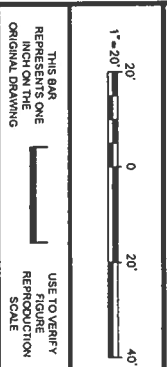

NO.	DATE	BY	CHK	DESCRIPTION
1	8/20/17	ALS	ARL	MODE COMMENT RESPONSE
2	8/14/17	ALS	ARL	MODE COMMENT RESPONSE
3	7/17/17	ALS	ARL	FOREST CONSERVATION ACT REQUIREMENT
4	7/17/17	ALS	ARL	MODE COMMENT RESPONSE



ARCADIS | Design & Consultancy
 for regional and built assets

ARCADIS U.S., INC.










PROPOSED STREAMS S1, S1E, AND S8B CULVERT REPLACEMENT PLANS AND PROFILES

COLUMBIA GAS TRANSMISSION, L.P., A TRANSCANADA COMPANY • HOUSTON, TEXAS
 EASTERN PANHANDLE EXPANSION PROJECT
 MARYLAND DEPARTMENT OF THE ENVIRONMENT

RESOURCE ID	SIZE OF AQUATIC RESOURCE ON SITE (SF)	TEMPORARY STREAM IMPACT STREAM WIDTH - TOP OF BANK TO TOP OF BANK (FT)	TEMPORARY STREAM IMPACT CENTER LINE OF STREAM (LF)	TEMPORARY STREAM IMPACT AREA (SF)	PERMANENT STREAM IMPACT CENTER LINE OF STREAM (LF)	PERMANENT STREAM IMPACT AREA (SF)	TEMPORARY 100-YEAR FLOODPLAIN IMPACT (SF)	PERMANENT 100-YEAR FLOODPLAIN IMPACT (SF)
S1	506	21	20	420	15	40	468	6,717
S1E	678	7	140	34	34	183	1,542	N/A
S8B	553	8	20	180	11	53	272	1,700


PLANS APPROVED BY: *[Signature]*
 DATE: 2/26/18
 WATER AND SCIENCE ADMINISTRATION
 WATERWAY CONSTRUCTION DIVISION

- REFER TO DRAWING 1 FOR DETAILS ON THE PROPOSED SEQUENCE OF INSTALLATION OF THE EROSION AND SEDIMENT CONTROLS.
- TEMPORARY EARTH DISTURBANCE IN PENNSYLVANIA WILL BE CONDUCTED UNDER A SEPARATE EROSION AND SEDIMENT CONTROL PLAN REVIEW. ONLY WORK IN MARYLAND IS INCORPORATED WITHIN THIS PLAN.
- SILT FENCE HAS BEEN PROPOSED AROUND THE PERIMETER OF AQUATIC RESOURCES (I.E. WETLANDS/STREAMS) PER FERC REGULATIONS, UNDERSTANDING THAT THE CONTROLS DO NOT FOLLOW THE ELEVATION CONTOURS IN ALL LOCATIONS.
- TOPSOIL SEGRIGATION SHALL BE CONDUCTED IN WETLAND, LAWN AND AGRICULTURAL AREAS AND AS OTHERWISE REDUCED BY THE LANDOWNER. TEMPORARILY STABILIZE SUBSOIL AND TOPSOIL FOLLOWING REMOVAL. SOIL SHALL BE STOCKPILED IN A BERM-LIKE MANNER TO REDUCE RUN-OFF FROM ACTIVE WORK AREAS. AND SHALL HAVE A MAXIMUM HEIGHT OF 35 FEET AND 2 ON 1 (OR FLATTER) SIDE SLOPES.
- SOIL STOCKPILES FROM TRENCH EXCAVATION SHALL BE LOCATED WITHIN THE ADDITIONAL BUFFER ZONE AND SHALL BE STABILIZED WITH SOIL BERMS LOCATED ON UPGRADE SIDE OF THE TRENCH SHALL BE USED AS A RUN-ON CONTROL FEATURE. STABILIZED BERMS LOCATED DOWNGRADIENT OF THE TRENCH SHALL BE UTILIZED AS A PERIMETER SEDIMENT CONTROL FEATURE IN PLACE OF SILT FENCE OR SIMILAR.
- FOLLOWING INITIAL SOIL DISTURBANCE OR RE-DISTURBANCE, PERMANENT OR TEMPORARY STABILIZATION MUST BE COMPLETED WITHIN 3 CALENDAR DAYS AS TO THE SURFACE OF ALL PERIMETER DIKES, SWALES, DITCHES, PERIMETER SLOPES, AND ALL SLOPES STEEPER THAN 3H:1V, AND 7 CALENDAR DAYS AS TO ALL OTHER DISTURBED OR GRADED AREAS ON THE PROJECT SITE NOT UNDER ACTIVE GRADING.
- PERMANENTLY STABILIZE DISTURBED AREAS IN ACCORDANCE WITH THE SEEDING RESTORATION TABLES ON DRAWING 1.
- THE PORTION OF EXISTING ACCESS ROAD PAR-1 FROM APPROXIMATELY STATION 0+00 TO 12+00 IS AN EXISTING FARM ROAD THAT WILL BE IMPROVED WITH THE PLACEMENT OF STONE. THE REMAINING PORTION OF EXISTING ACCESS ROAD PAR-1 (BETWEEN STATION 12+00 AND 51+98) IS AN EXISTING GRAVEL ROAD THAT WILL NOT BE IMPROVED. ADDITIONAL GRAVEL ACCESS ROAD AS NEEDED TO SUPPORT TRUCK TRAFFIC. ADDITIONALLY, THE CULVERT REPLACEMENTS ALONG EXISTING ACCESS ROAD PAR-1 MAY REQUIRE ADDITIONAL ROADWAY FILL OVER THE NEW CULVERTS TO MEET THE MINIMUM COVER REQUIREMENTS.
- PROPOSED PERMANENT ACCESS ROAD PAR-2 WILL BE IMPROVED BY GRADING AND STABILIZED WITH STONE TO FACILITATE TRUCK AND EQUIPMENT TRAFFIC.
- EXISTING 2-FOOT CONTOUR ELEVATIONS SHOWN ON THE PLAN VIEWS ARE BASED ON TOPOGRAPHIC CONTOURS PROVIDED BY ENSTE USA, INC. ON 1/25/2017.
- EXISTING ROADWAY SURFACE, STREAMBED, AND CULVERT ELEVATIONS DEPICTED ON THIS DRAWING ARE BASED ON SURVEY POINT ELEVATIONS PROVIDED BY ENSTE USA, INC. ON 8/10/2017.

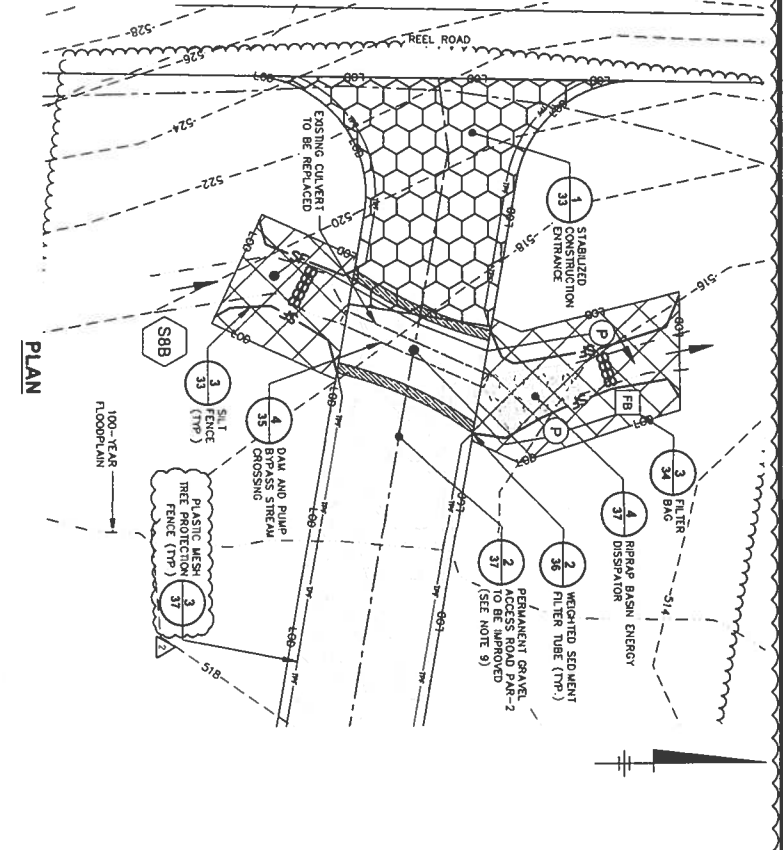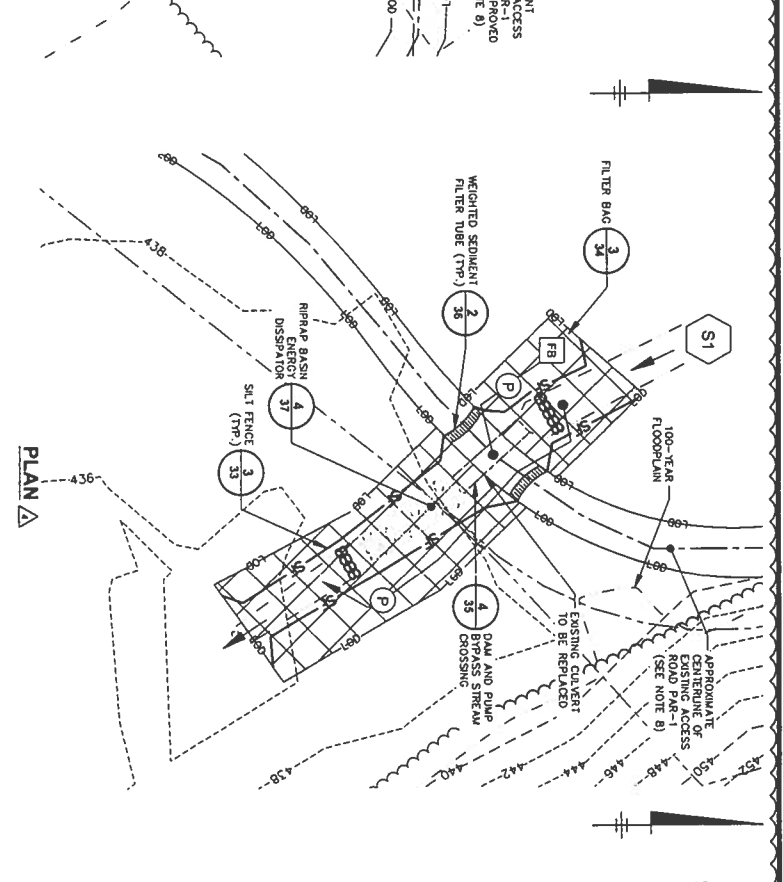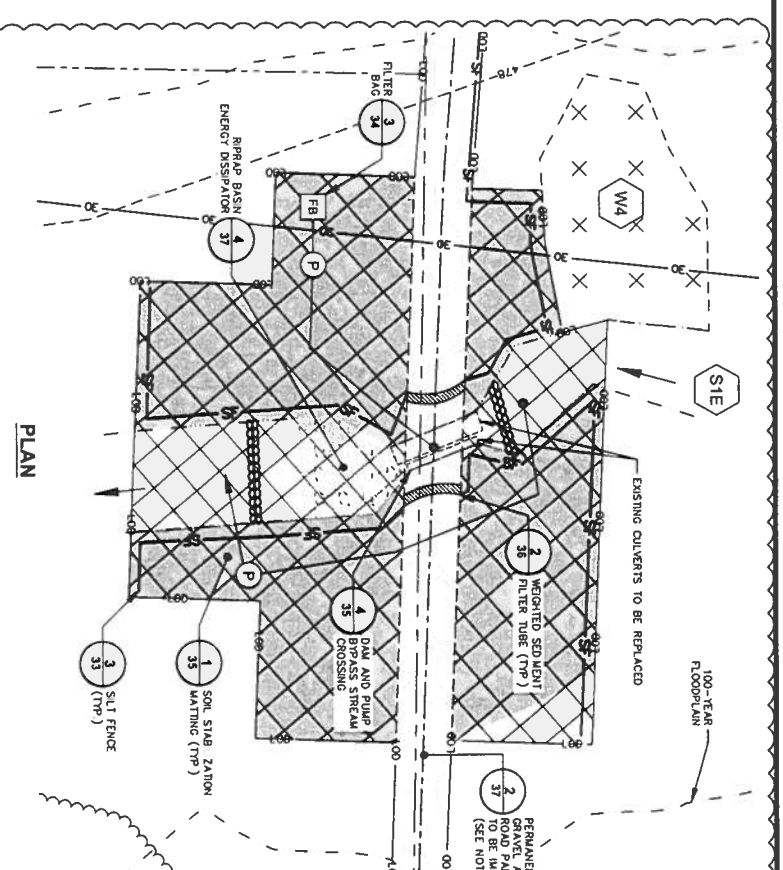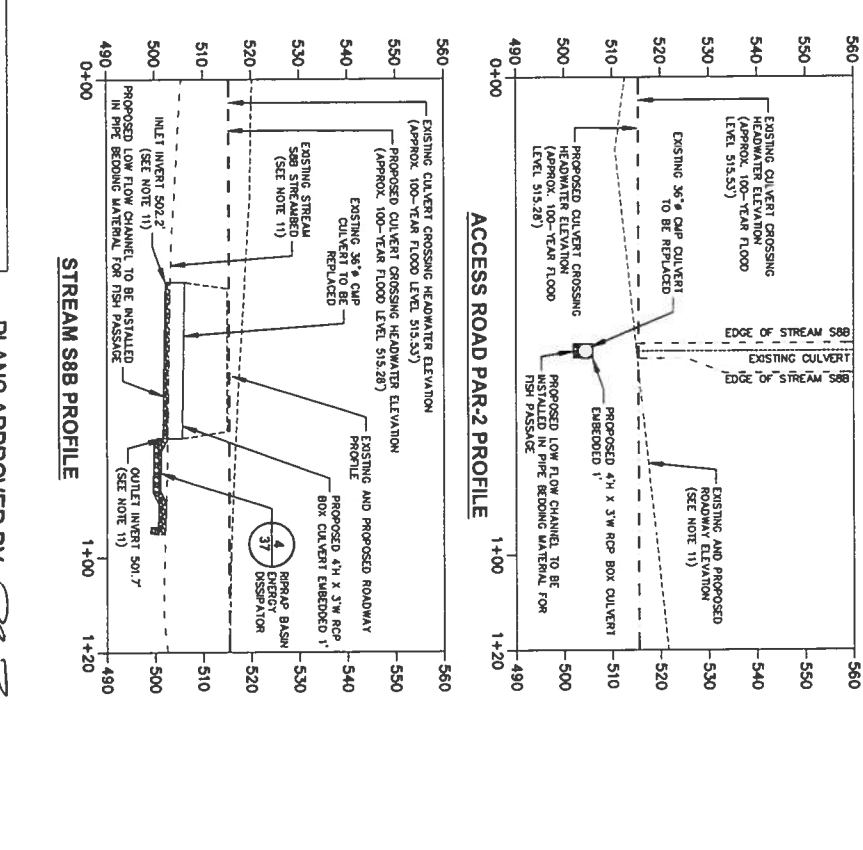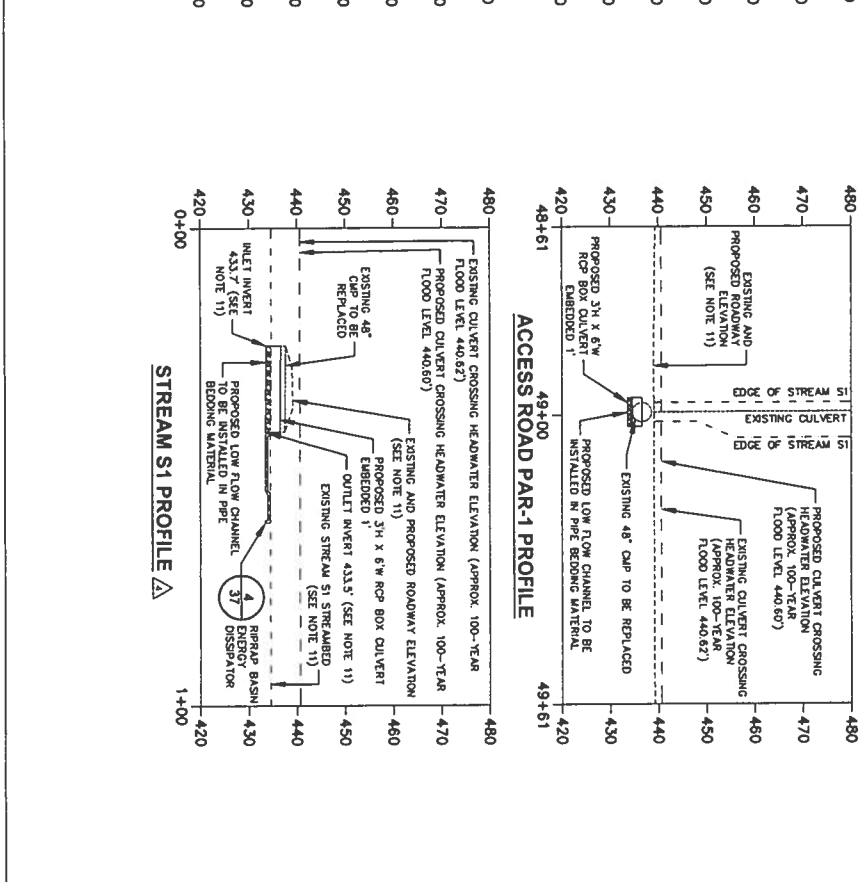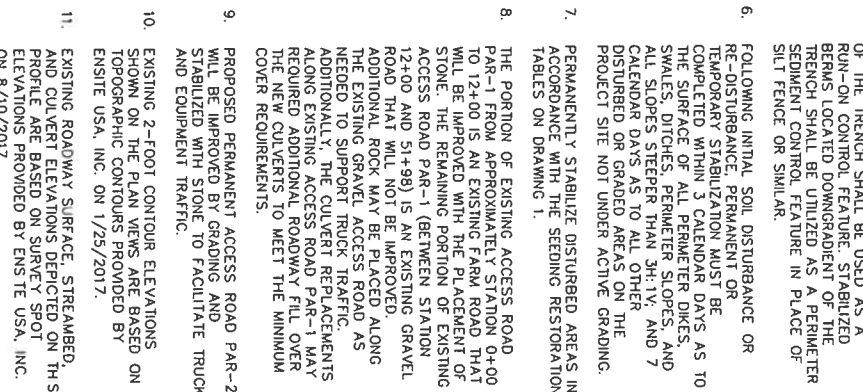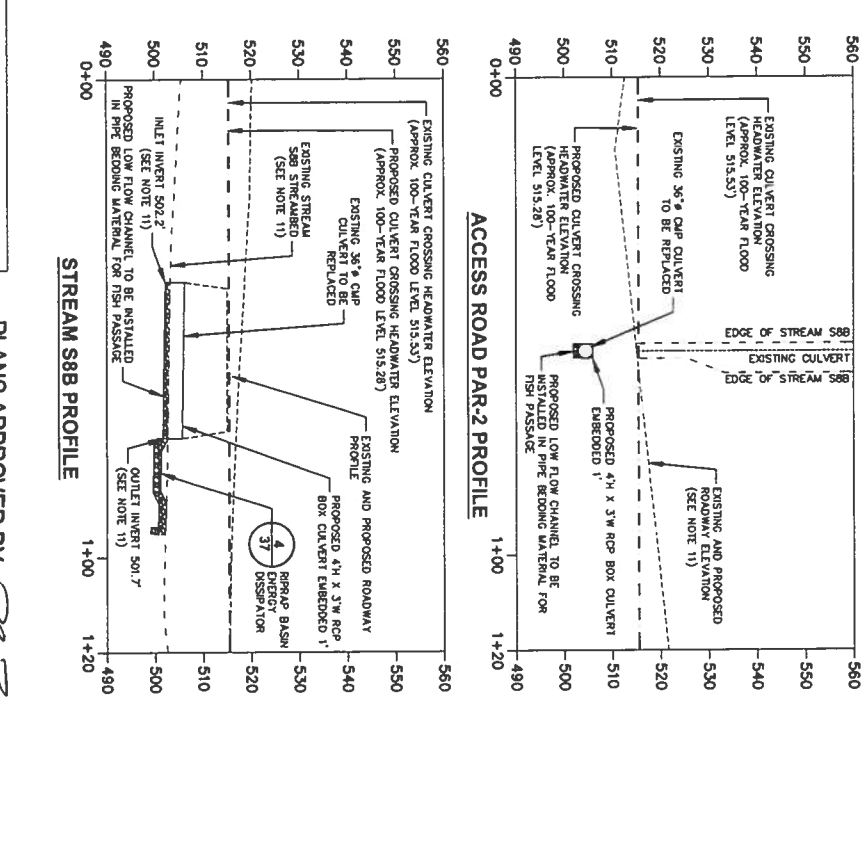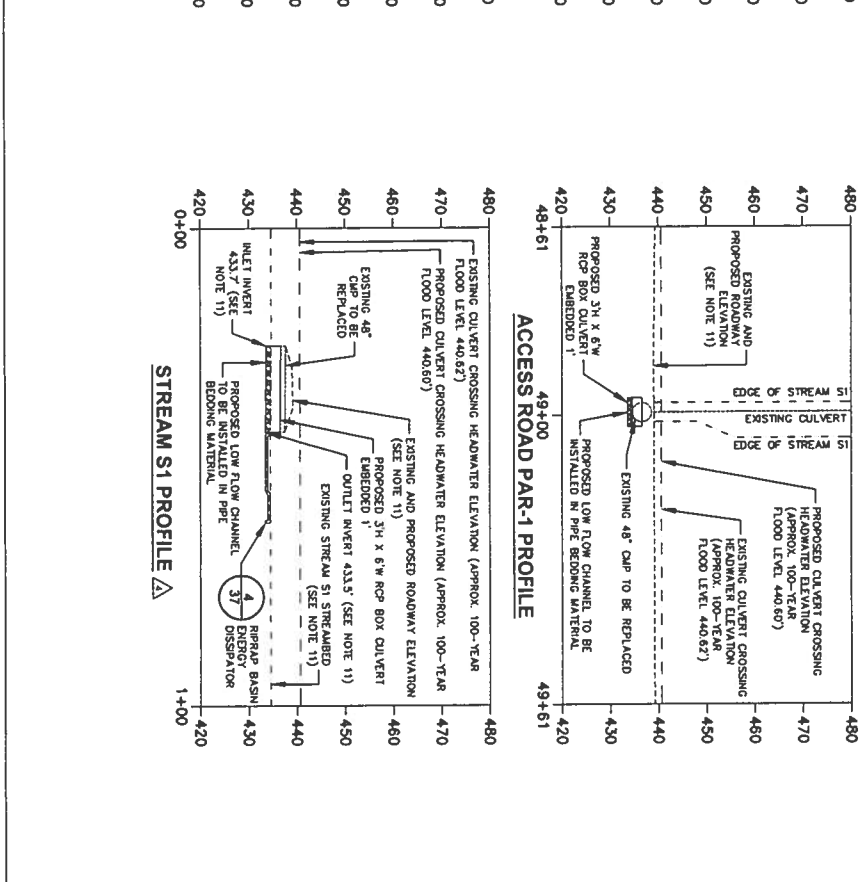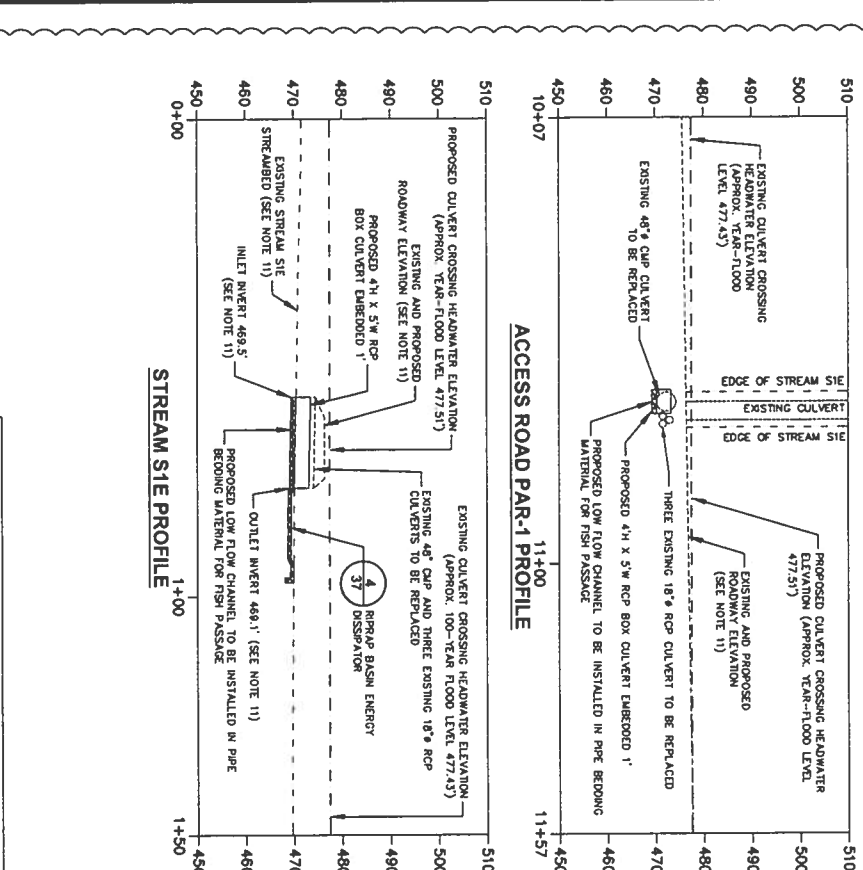

- REFER TO DRAWING 1 FOR DETAILS ON THE PROPOSED SEQUENCE OF INSTALLATION OF THE EROSION AND SEDIMENT CONTROLS.
- TEMPORARY EARTH DISTURBANCE IN PENNSYLVANIA WILL BE CONDUCTED UNDER A SEPARATE EROSION AND SEDIMENT CONTROL PLAN REVIEW. ONLY WORK IN MARYLAND IS INCORPORATED WITHIN THIS PLAN.
- SILT FENCE HAS BEEN PROPOSED AROUND THE PERIMETER OF AQUATIC RESOURCES (I.E. WETLANDS/STREAMS) PER FERC REGULATIONS, UNDERSTANDING THAT THE CONTROLS DO NOT FOLLOW THE ELEVATION CONTOURS IN ALL LOCATIONS.
- TOPSOIL SEGRIGATION SHALL BE CONDUCTED IN WETLAND, LAWN AND AGRICULTURAL AREAS AND AS OTHERWISE REDUCED BY THE LANDOWNER. TEMPORARILY STABILIZE SUBSOIL AND TOPSOIL FOLLOWING REMOVAL. SOIL SHALL BE STOCKPILED IN A BERM-LIKE MANNER TO REDUCE RUN-OFF FROM ACTIVE WORK AREAS. AND SHALL HAVE A MAXIMUM HEIGHT OF 35 FEET AND 2 ON 1 (OR FLATTER) SIDE SLOPES.
- SOIL STOCKPILES FROM TRENCH EXCAVATION SHALL BE LOCATED WITHIN THE ADDITIONAL BUFFER ZONE AND SHALL BE STABILIZED WITH SOIL BERMS LOCATED ON UPGRADE SIDE OF THE TRENCH SHALL BE USED AS A RUN-ON CONTROL FEATURE. STABILIZED BERMS LOCATED DOWNGRADIENT OF THE TRENCH SHALL BE UTILIZED AS A PERIMETER SEDIMENT CONTROL FEATURE IN PLACE OF SILT FENCE OR SIMILAR.
- FOLLOWING INITIAL SOIL DISTURBANCE OR RE-DISTURBANCE, PERMANENT OR TEMPORARY STABILIZATION MUST BE COMPLETED WITHIN 3 CALENDAR DAYS AS TO THE SURFACE OF ALL PERIMETER DIKES, SWALES, DITCHES, PERIMETER SLOPES, AND ALL SLOPES STEEPER THAN 3H:1V, AND 7 CALENDAR DAYS AS TO ALL OTHER DISTURBED OR GRADED AREAS ON THE PROJECT SITE NOT UNDER ACTIVE GRADING.
- PERMANENTLY STABILIZE DISTURBED AREAS IN ACCORDANCE WITH THE SEEDING RESTORATION TABLES ON DRAWING 1.
- THE PORTION OF EXISTING ACCESS ROAD PAR-1 FROM APPROXIMATELY STATION 0+00 TO 12+00 IS AN EXISTING FARM ROAD THAT WILL BE IMPROVED WITH THE PLACEMENT OF STONE. THE REMAINING PORTION OF EXISTING ACCESS ROAD PAR-1 (BETWEEN STATION 12+00 AND 51+98) IS AN EXISTING GRAVEL ROAD THAT WILL NOT BE IMPROVED. ADDITIONAL GRAVEL ACCESS ROAD AS NEEDED TO SUPPORT TRUCK TRAFFIC. ADDITIONALLY, THE CULVERT REPLACEMENTS ALONG EXISTING ACCESS ROAD PAR-1 MAY REQUIRE ADDITIONAL ROADWAY FILL OVER THE NEW CULVERTS TO MEET THE MINIMUM COVER REQUIREMENTS.
- PROPOSED PERMANENT ACCESS ROAD PAR-2 WILL BE IMPROVED BY GRADING AND STABILIZED WITH STONE TO FACILITATE TRUCK AND EQUIPMENT TRAFFIC.
- EXISTING 2-FOOT CONTOUR ELEVATIONS SHOWN ON THE PLAN VIEWS ARE BASED ON TOPOGRAPHIC CONTOURS PROVIDED BY ENSTE USA, INC. ON 1/25/2017.
- EXISTING ROADWAY SURFACE, STREAMBED, AND CULVERT ELEVATIONS DEPICTED ON THIS DRAWING ARE BASED ON SURVEY POINT ELEVATIONS PROVIDED BY ENSTE USA, INC. ON 8/10/2017.

XREFS: CPGL00EP-X00
CPGL00EP-X01
CPGL00EP-X05


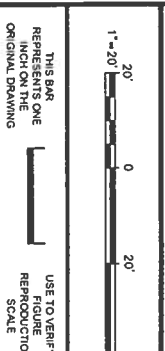


No.	Date	Revisions	By	Checked by
1	8/20/17	MOE COMMENT RESPONSE	ALS	ARL
2	8/21/17	MOE COMMENT RESPONSE	ALS	ARL
3	8/21/17	FOREST CONSERVATION ACT REQUIREMENT	ALS	ARL
4	8/21/17	MOE COMMENT RESPONSE	ALS	ARL





PROPOSED STREAM CROSSINGS S6 AND S13 PLANS AND PROFILES

COLUMBIA GAS TRANSMISSION, LLC, A TRANSCANADA COMPANY • HOUSTON, TEXAS
EASTERN PANHANDLE EXPANSION PROJECT

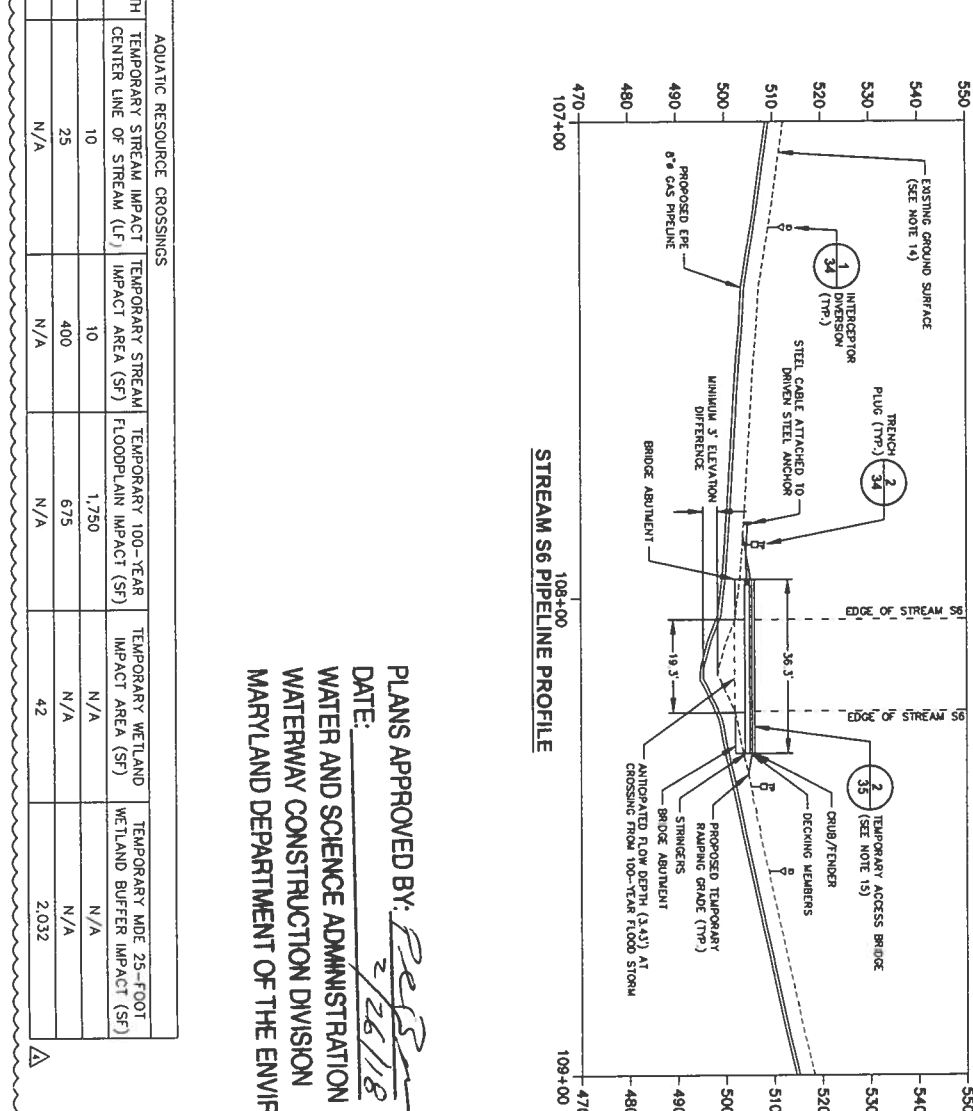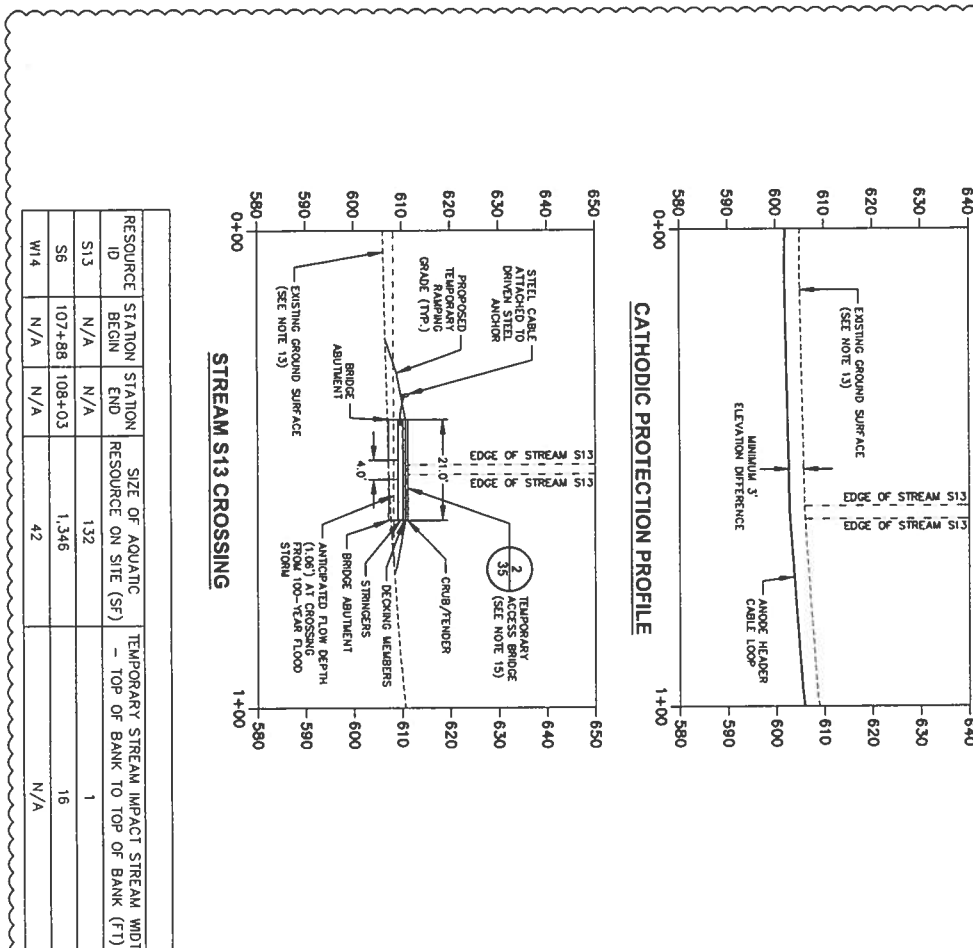



RESOURCE ID	STATION BEGIN	STATION END	SIZE OF AQUATIC RESOURCE ON SITE (SF)	TEMPORARY STREAM IMPACT WIDTH - TOP OF BANK TO TOP OF BANK (FT)	TEMPORARY STREAM IMPACT CENTER LINE OF STREAM (LF)	TEMPORARY STREAM IMPACT AREA (SF)	TEMPORARY 100-YEAR FLOODPLAIN IMPACT (SF)	TEMPORARY WETLAND IMPACT AREA (SF)	TEMPORARY WETLAND BUFFER IMPACT (SF)
S13	N/A	N/A	132	1	10	1,750	N/A	N/A	N/A
S6	107+88	108+03	1,346	16	25	400	675	N/A	N/A
W14	N/A	N/A	42	N/A	N/A	N/A	N/A	2,032	N/A

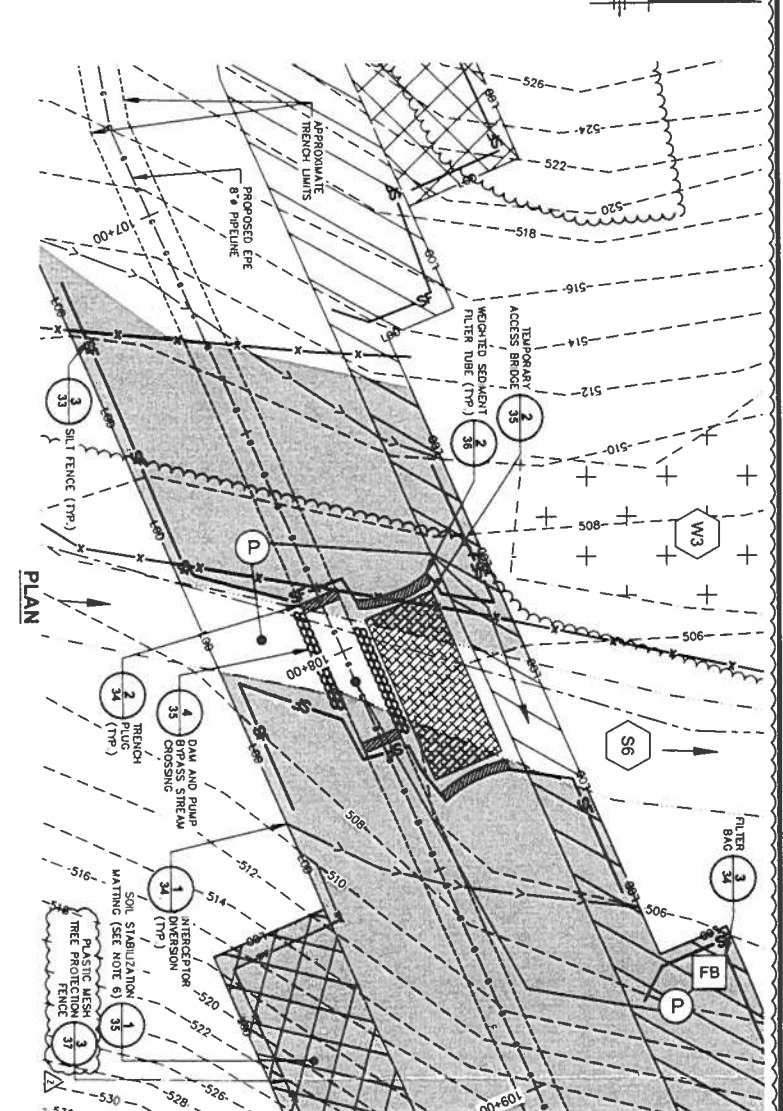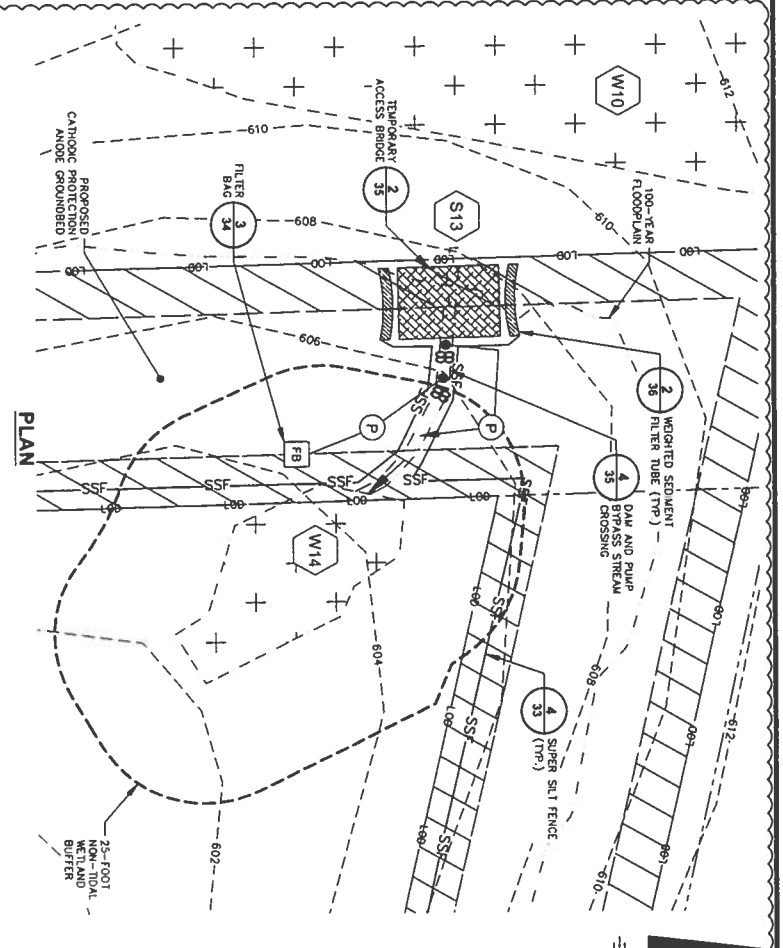



- NOTES:**
- REFER TO DRAWING 1 FOR DETAILS ON THE PROPOSED SEQUENCE OF INSTALLATION OF THE EROSION AND SEDIMENT CONTROL.
 - SILT FENCE HAS BEEN PROPOSED AROUND THE PERIMETER OF AQUATIC RESOURCES (I.E., WETLANDS/STREAMS) PER FERC REGULATIONS, UNDERSTANDING THAT THE CONTROLS DO NOT FOLLOW THE ELEVATION CONTOURS IN ALL LOCATIONS.
 - TOPSOIL SEGRIGATION SHALL BE CONDUCTED IN WETLAND, LAWN AND AGRICULTURAL AREAS AND AS OTHERWISE REQUESTED BY THE LANDOWNER. TEMPORARILY STABILIZE SOIL AND TOPSOIL FOLLOWING REMOVAL. SOIL SHALL BE STOCKPILED FROM-LINE MARK AREAS. SEDIMENT SHALL HAVE A MAXIMUM HEIGHT OF 35 FEET AND 2 ON 1 (OR FLATTER) SIDE SLOPES.
 - SOIL STOCKPILES FROM TRENCH EXCAVATION SHALL BE LOCATED WITHIN THE ADDITIONAL TRENCH WORKSPACE SHOWN WITH HITCHING ON THESE DRAWINGS. STABILIZED SOIL BERM LOCATED ON UPGRADE SIDE OF THE TRENCH SHALL BE USED AS A RUN-ON CONTROL FEATURE. STABILIZED BERMS LOCATED DOWNGRADIENT OF THE TRENCH SHALL BE UTILIZED AS A PERIMETER SEDIMENT CONTROL FEATURE IN PLACE OF SILT FENCE OR SIMILAR.
 - INTERCEPTOR DIVERSIONS LOCATED IN RESIDENTIAL AREAS AND AGRICULTURAL FIELDS SHALL BE REMOVED DURING FINAL GRADING. INTERCEPTOR DIVERSIONS THAT CAN BE LEFT IN PLACE, AT THE LANDOWNER'S DISCRETION, SHALL BE VEGETATED.
 - SOIL STABILIZATION MATTING HAS BEEN PROPOSED ON SLOPES STEEPER THAN 3H:1V.
 - FOLLOWING INITIAL SOIL DISTURBANCE OR RE-DISTURBANCE, PERMANENT OR TEMPORARY STABILIZATION MUST BE COMPLETED WITHIN 3 CALENDAR DAYS AS TO THE SURFACE OF ALL PERMITS, SLOPES, AND SHALLOWS. PERMANENT STABILIZATION SHALL BE STEEPER THAN 3H:1V AND 7 CALENDAR DAYS AS TO ALL OTHER DISTURBED OR GRADED AREAS ON THE PROJECT SITE NOT UNDER ACTIVE GRADING.
 - PERMANENTLY STABILIZE DISTURBED AREAS IN ACCORDANCE WITH THE SEEDING RESTORATION TABLES ON DRAWING 1.
 - PROPOSED PERMANENT ACCESS ROAD PAR-5 WILL BE IMPROVED BY GRADING AND STABILIZED WITH STONE TO FACILITATE TRUCK AND EQUIPMENT TRAFFIC.
 - EXISTING 2-FOOT CONTOUR ELEVATIONS SHOWN ON THE PLAN VIEWS ARE BASED ON TOPOGRAPHIC CONTOURS PROVIDED BY ENSITE USA, INC. ON 1/25/2017.
 - EXISTING GRADES DEPICTED ON THIS PROFILE ARE BASED ON TOPOGRAPHIC CONTOURS PROVIDED BY ENSITE USA, INC. ON 1/25/2017.
 - EXISTING GRADES DEPICTED ON THIS PROFILE ARE BASED ON SURVEY SPOT ELEVATIONS PROVIDED BY ENSITE USA, INC. ON 8/10/2017.
 - TEMPORARY ACCESS BRIDGE WILL BE PLACED FROM ONE SIDE OF THE STREAM TO THE AVOID IMPACTS TO THE STREAM BED AND BANKS.

PLANS APPROVED BY: *[Signature]*
DATE: 9/26/18
WATER AND SCIENCE ADMINISTRATION
WATERWAY CONSTRUCTION DIVISION
MARYLAND DEPARTMENT OF THE ENVIRONMENT

XREFS: CPGL00EP-X00
CPGL00EP-X01

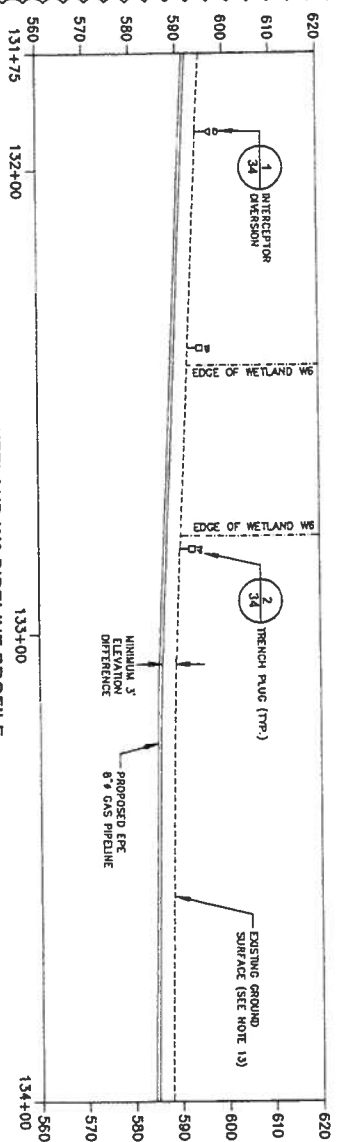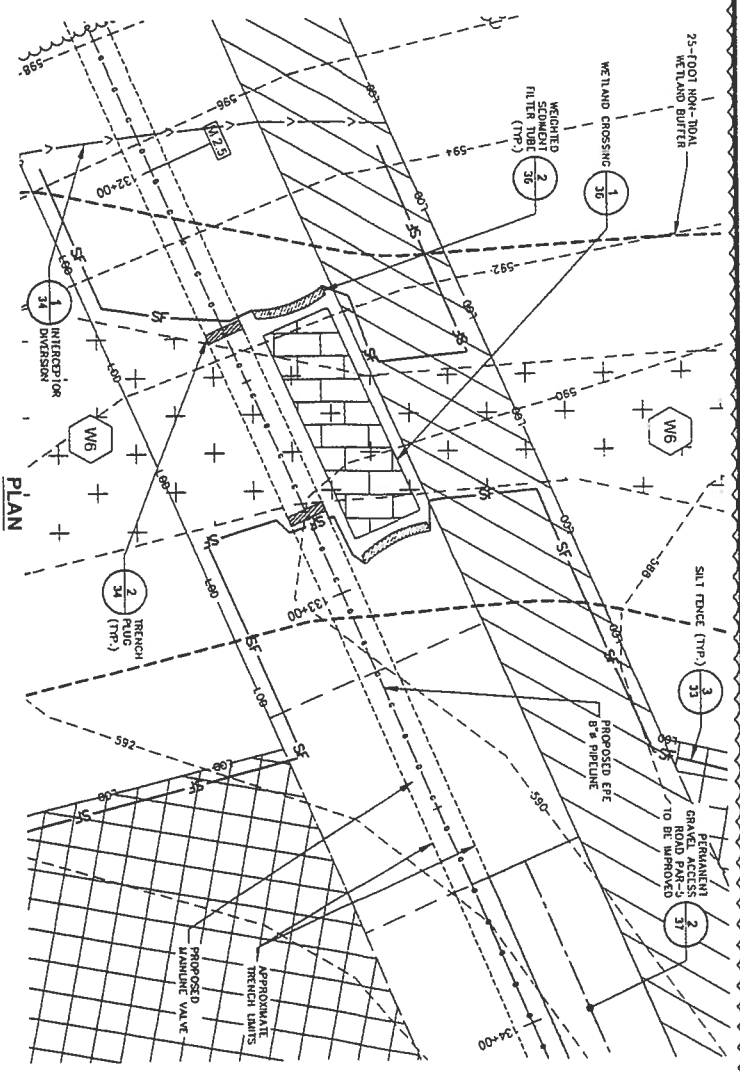

RESOURCE ID	STATION BEG	STATION END	SIZE OF AQUATIC RESOURCE ON SITE (SF)	TEMPORARY STREAM IMPACT WIDTH (FT)	TEMPORARY STREAM IMPACT CENTER LINE OF STREAM (LF)	TEMPORARY STREAM IMPACT AREA (SF)	TEMPORARY WETLAND IMPACT AREA (SF)	MODE 25-FOOT WETLAND BUFFER IMPACT (SF)
W6	132+42	132+79	2,600	N/A	N/A	N/A	2,600	5,797
S4	147+94	148+06	599	N/A	N/A	N/A	N/A	N/A

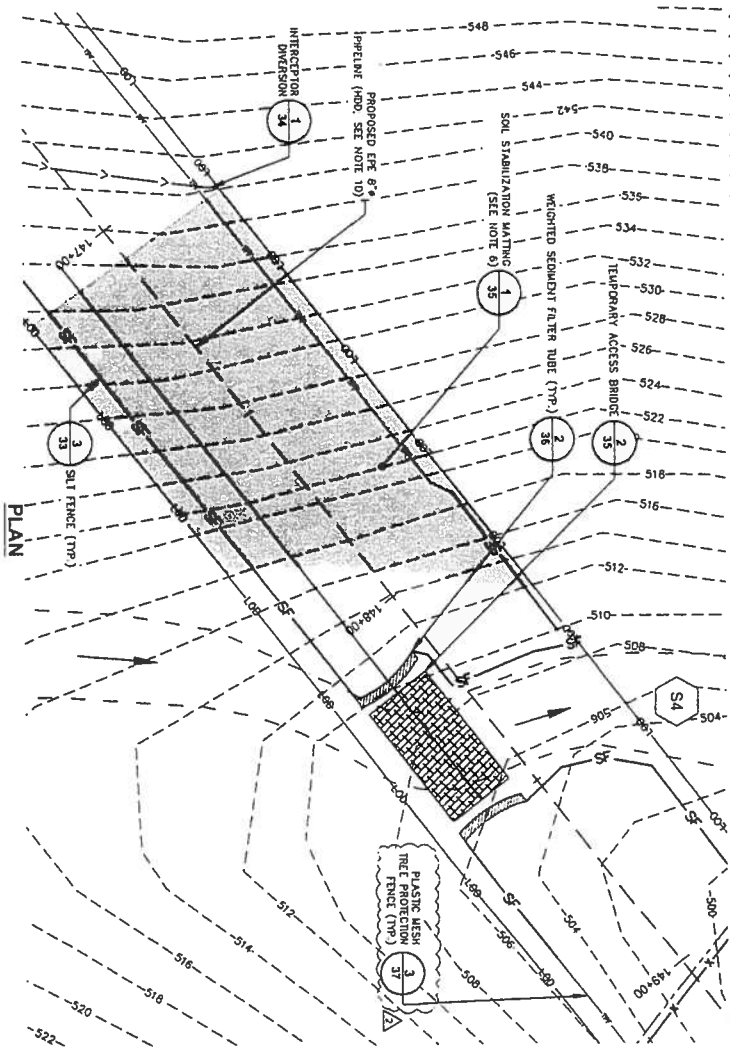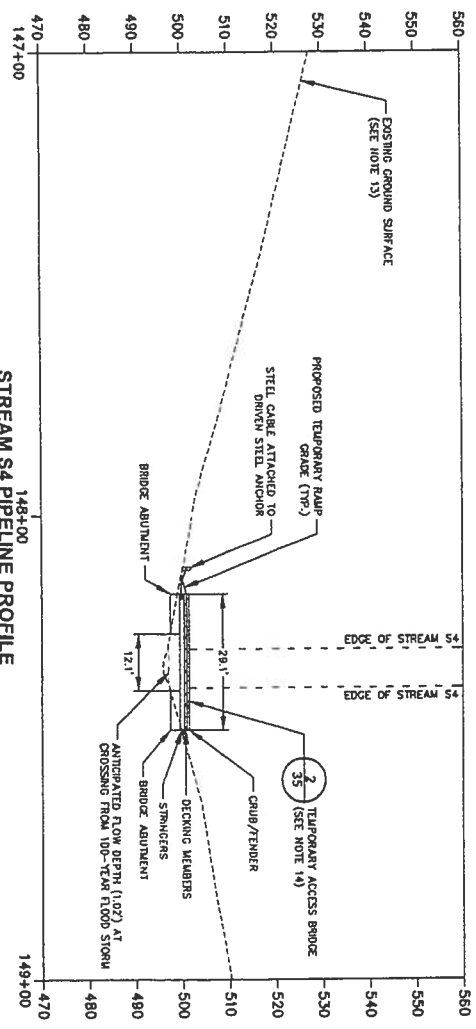

PLANS APPROVED BY: *[Signature]*
DATE: 2/26/18

WATER AND SCIENCE ADMINISTRATION
WATERWAY CONSTRUCTION DIVISION
PENNSYLVANIA DEPARTMENT OF THE ENVIRONMENT

- NOTES:
- REFER TO DRAWING 1 FOR DETAILS ON THE PROPOSED SEQUENCE OF WORKS CONTROL OF THE EROSION AND SEDIMENT CONTROLS.
 - SILT FENCE HAS BEEN PROPOSED AROUND WETLANDS/STREAMS PER FERC REGULATIONS, UNDERSTANDING THAT THE CONTROLS DO NOT FOLLOW THE ELEVATION CONTOURS IN ALL LOCATIONS.
 - TOPSOIL SEGREGATION SHALL BE CONDUCTED IN WETLAND, LAWN AND AGRICULTURAL AREAS AND AS OTHERWISE REQUESTED BY THE LANDOWNER. TEMPORARILY STABILIZED SUBSOIL AND TOPSOIL FOLLOWING REMOVAL SHALL BE STOCKPILED IN A BERM-LIKE MANNER TO REDUCE RUN-OFF FROM ACTIVE WORK AREAS. BERMS SHALL HAVE A MAXIMUM HEIGHT OF 25 FEET AND 2 ON 1 (OR FLATTER) SIDE SLOPES.
 - SOIL STOCKPILES FROM TRENCH EXCAVATION SHALL BE LOCATED WITHIN THE ADDITIONAL TEMPORARY WORKSPACE SHOWN WITH HATCHING ON THESE DRAWINGS. STABILIZED SOIL BERMS LOCATED ON UPGRADE SIDE OF THE TRENCH SHALL BE USED AS A RUN-ON CONTROL FEATURE. STABILIZED BERMS LOCATED DOWNGRADIENT OF THE TRENCH SHALL BE UTILIZED AS A PERIMETER SEDIMENT CONTROL FEATURE IN PLACE OF SILT FENCE OR SIMILAR.
 - INTERCEPTOR DIVERSIONS LOCATED IN RESIDENTIAL AREAS BEHIND DURING FINAL GRADING. INTERCEPTOR DIVERSIONS THAT CAN BE LEFT IN PLACE AT THE LANDOWNER'S DISCRETION, SHALL BE VEGETATED.
 - SOIL STABILIZATION MATTING HAS BEEN PROPOSED ON SLOPES STEEPER THAN 3H:1V.
 - FOLLOWING INITIAL SOIL DISTURBANCE OR RE-DISTURBANCE, PERMANENT OR TEMPORARY STABILIZATION MUST BE COMPLETED WITHIN 3 CALENDAR DAYS AS TO THE SURFACE OF ALL PERIMETER DIKES, SWALES, DITCHES, PERIMETER SLOPES, AND ALL SLOPES STEEPER THAN 3H:1V, AND 7 CALIBER OR GREATER AREAS ON THE PROJECT SITE NOT UNDER ACTIVE GRADING.
 - PERMANENTLY STABILIZE DISTURBED AREAS IN ACCORDANCE WITH THE SEEDING RESTORATION TABLES ON DRAWING 1.
 - PROPOSED PERMANENT ACCESS ROAD PAR-5 WILL BE IMPROVED BY GRADING AND STABILIZED WITH STONE TO FACILITATE TRUCK AND EQUIPMENT TRAFFIC.
 - DISTURBANCE ACTIVITIES WITHIN PORTIONS OF THE LIMIT OF DISTURBANCE BETWEEN ENTRY/EXIT LOCATIONS WILL CONSIST OF TREE CLEARING ONLY.
 - PROPOSED 8-INCH DIAMETER PIPELINE IS NOT SHOWN ON THE PROFILE FOR STREAM S4 CROSSING, AS THE PIPELINE WILL BE INSTALLED VIA HORIZONTAL DIRECTIONAL DRILLING TO BE LOCATED APPROXIMATELY 200 FEET BELOW GROUND SURFACE AT THIS STREAM CROSSING.
 - EXISTING GRADES DEPICTED ON THIS PROFILE ARE BASED ON SURVEY SPOT ELEVATIONS PROVIDED BY ENSITE USA, INC. ON 8/10/2017.
 - TEMPORARY ACCESS BRIDGE WILL BE PLACED FROM ONE SIDE OF THE STREAM TO THE AVOID IMPACTS TO THE STREAM BED AND BANKS.

THIS DRAWING IS THE PROPERTY OF THE ARCHADIS COMPANY. IT IS TO BE USED ONLY FOR THE PROJECT AND SITE SPECIFICALLY IDENTIFIED HEREIN. ANY REPRODUCTION OR USE FOR OTHER PROJECTS WITHOUT THE WRITTEN PERMISSION OF ARCHADIS U.S., INC. IS STRICTLY PROHIBITED.

USE TO USER: REPRODUCTION SCALE

THIS DRAWING IS THE PROPERTY OF THE ARCHADIS COMPANY. IT IS TO BE USED ONLY FOR THE PROJECT AND SITE SPECIFICALLY IDENTIFIED HEREIN. ANY REPRODUCTION OR USE FOR OTHER PROJECTS WITHOUT THE WRITTEN PERMISSION OF ARCHADIS U.S., INC. IS STRICTLY PROHIBITED.



ARCADIS Design & Consultancy for natural and built assets

ARCADIS U.S., INC.

COLUMBIA GAS TRANSMISSION, L.L.C. A TRANSCANADA COMPANY • HOUSTON, TEXAS

EASTERN PANHANDLE EXPANSION PROJECT

PROPOSED STREAM CROSSING S4 AND WETLAND CROSSING W6 PLANS AND PROFILES


ARCADIS Project No: CPGL00EP-001-10008A

Date: MARCH 2017

ARCHADIS 6941 Wallace Road Estimation Suite 300 Wexford, PA 15090 Tel: 724.762.9180

32


XREFS: CPGL00EP-X00

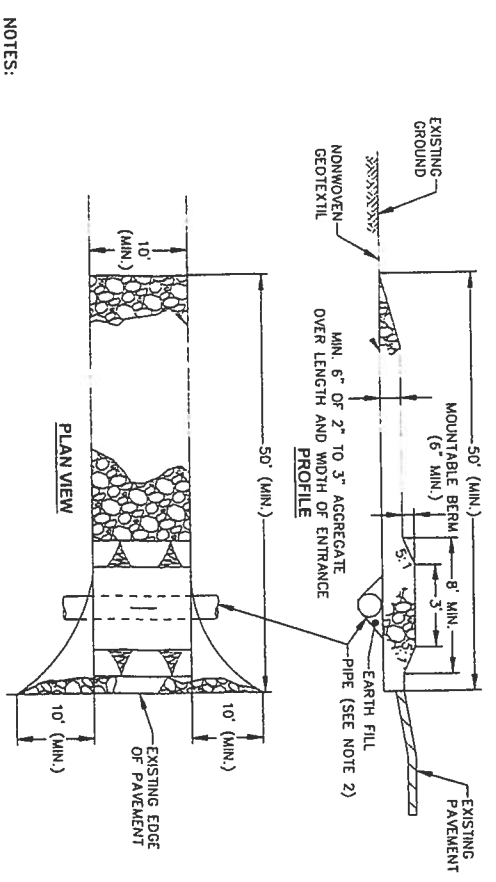

- NOTES:
1. PLACE STABILIZED CONSTRUCTION ENTRANCE IN ACCORDANCE WITH THE APPROVED PLAN. VEHICLES MUST TRAVEL OVER THE ENTIRE LENGTH OF THE SCE. USE MINIMUM LENGTH OF 50 FEET. USE MINIMUM WIDTH OF 10 FEET. FLARE STABILIZED CONSTRUCTION ENTRANCE TO 10 FEET MINIMUM AT THE EXISTING ROAD TO PROVIDE A TURNING RADIUS.
 2. PIPE ALL SURFACE WATER FLOWING TO OR DIVERTED TOWARD THE ENTRANCE. MAINTAINING POSITIVE DRAINAGE OVER THE PIPE. PROVIDE PIPE AS SPECIFIED ON APPROVED PLAN. WHEN THE STABILIZED CONSTRUCTION ENTRANCE IS LOCATED AT A HIGH SPOT AND HAS NO DRAINAGE TO CONVEY, A PIPE IS NOT NECESSARY. A MOUNTABLE BERM IS REQUIRED WHEN STABILIZED CONSTRUCTION ENTRANCE IS NOT LOCATED AT A HIGH SPOT.
 3. PLACE CRUSHED AGGREGATE (2 TO 3 INCHES IN SIZE) OR EQUIVALENT RECYCLED CONCRETE (WITHOUT REBAR) AT LEAST 6 INCHES DEEP OVER THE LENGTH AND WIDTH OF THE STABILIZED CONSTRUCTION ENTRANCE.
 4. MAINTAIN ENTRANCE IN A CONDITION THAT MINIMIZES TRACKING OF SEDIMENT. ADD STONE OR MAKE OTHER REPAIRS AS CONDITIONS DEMAND TO MAINTAIN CLEAN SURFACE. MOUNTABLE BERM, IMMEDIATELY REMOVE STONE AND/OR REBAR TO MAINTAIN PROPER OR TRACKED ONTO PAVEMENT IS NOT ACCEPTABLE UNLESS WASH WATER IS DIRECTED TO AN APPROVED SEDIMENT CONTROL PRACTICE.

STABILIZED CONSTRUCTION ENTRANCE 1


NOT TO SCALE

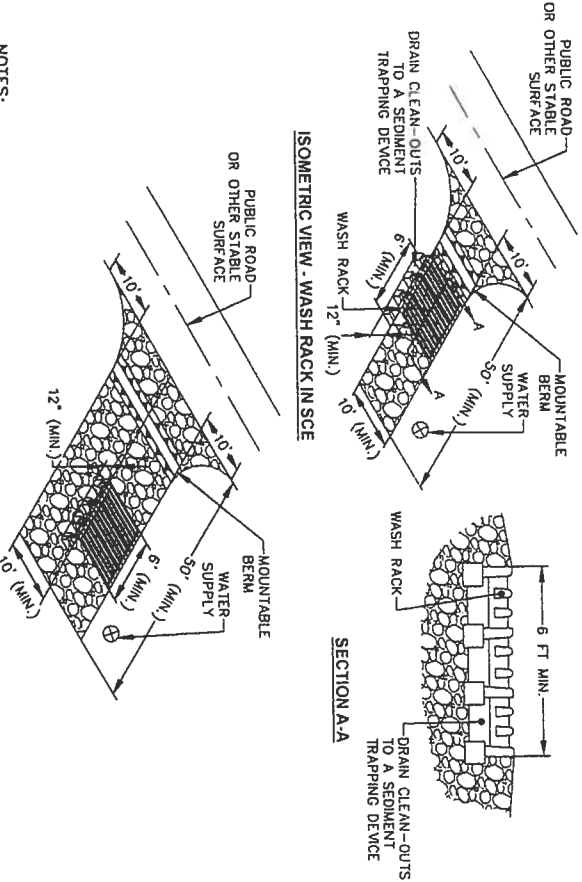

- NOTES:
1. USE A WASH RACK DESIGNED AND CONSTRUCTED/MANUFACTURED FOR THE ANTICIPATED TRAFFIC LOADS. CONCRETE, STEEL, OR OTHER MATERIALS ARE ACCEPTABLE. PRE-FABRICATED UNITS SUCH AS CATTLE GUARDS ARE ACCEPTABLE. USE MINIMUM DIMENSION OF 6 FEET BY 10 FEET. ORIENT DIRECTION OF RISBS AS SHOWN ON THE DETAIL.
 2. INSTALL PRIOR TO, ALONG SIDE OF, OR AS PART OF THE STABILIZED CONSTRUCTION ENTRANCE.
 3. DIRECT WASH WATER TO AN APPROVED SEDIMENT TRAPPING DEVICE.
 4. KEEP AREA UNDER WASH RACK FREE OF ACCUMULATED SEDIMENT. IF DAMAGED, REPAIR OR REPLACE WASH RACK.

WASH RACK OPTION 2


NOT TO SCALE

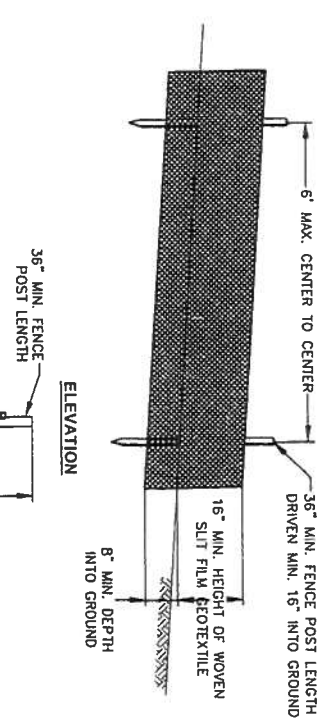

- NOTES:
1. USE WOOD POSTS 1 3/4\"/>
 2. USE 3/8\"/>
 3. FASTEN GEOTEXTILE SECURELY TO UPSLOPE SIDE OF FENCE POSTS WITH WIRE TIES OR STAPLES AT TOP AND MID-SECTION.
 4. PROVIDE MANUFACTURER CERTIFICATION TO THE AUTHORIZED REPRESENTATIVE OF THE INSPECTION/ENFORCEMENT AUTHORITY SHOWING THAT THE GEOTEXTILE USED MEETS THE REQUIREMENTS OF THIS DETAIL.
 5. EMBED GEOTEXTILE A MINIMUM OF 8 INCHES VERTICALLY INTO THE GROUND. BACKFILL AND COMPACT THE SOIL ON BOTH SIDES OF FABRIC.
 6. WHERE TWO SECTIONS OF GEOTEXTILE ADJOIN: OVERLAP, TWIST, AND STAPLE TO POST IN ACCORDANCE WITH THIS DETAIL.
 7. EXTEND BOTH ENDS OF THE SILT FENCE A MINIMUM OF FIVE HORIZONTAL FEET UPSLOPE AT 45 DEGREES TO THE MAIN FENCE ALIGNMENT TO PREVENT RUNOFF FROM GOING AROUND THE ENDS OF THE SILT FENCE.
 8. REMOVE ACCUMULATED SEDIMENT AND DEBRIS WHEN BULGES DEVELOP IN SILT FENCE OR WHEN SEDIMENT REACHES 25% OF FENCE HEIGHT. REPLACE GEOTEXTILE IF TORN. IF UNDERMINING OCCURS, REINSTALL FENCE.

SILT FENCE 3


NOT TO SCALE

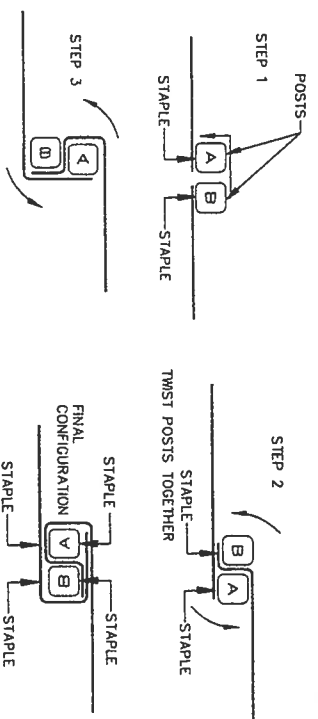

- NOTES:
1. INSTALL 2 3/8\"/>
 2. FASTEN 9 GAUGE OR HEAVIER GALVANIZED CHAIN LINK FENCE (2 3/8\"/>
 3. FASTEN WOVEN SLIT FILM GEOTEXTILE SECURELY TO THE UPSLOPE SIDE OF CHAIN LINK FENCE WITH TIES SPACED EVERY 24 INCHES AT THE TOP AND MID SECTION. EMBED GEOTEXTILE AND CHAIN LINK FENCE A MINIMUM OF 8 INCHES INTO THE GROUND.
 4. WHERE ENDS OF THE GEOTEXTILE COME TOGETHER, THE ENDS SHALL BE OVERLAPPED BY 6 INCHES, FOLDED, AND STARTED TO PREVENT SEDIMENT BY PASS.
 5. EXTEND BOTH ENDS OF THE SUPER SILT FENCE A MINIMUM OF FIVE HORIZONTAL FEET UPSLOPE AT 45 DEGREES TO THE MAIN FENCE ALIGNMENT TO PREVENT RUNOFF FROM GOING AROUND THE ENDS OF THE SUPER SILT FENCE.
 6. PROVIDE MANUFACTURER CERTIFICATION TO THE INSPECTION/ENFORCEMENT AUTHORITY SHOWING THAT GEOTEXTILE USED MEETS THE REQUIREMENTS OF THIS DETAIL.
 7. REMOVE ACCUMULATED SEDIMENT AND DEBRIS WHEN BULGES DEVELOP IN FENCE OR WHEN SEDIMENT REACHES 25% OF FENCE HEIGHT. REPLACE GEOTEXTILE IF TORN. IF UNDERMINING OCCURS, REINSTALL CHAIN LINK FENCING AND GEOTEXTILE.

SUPER SILT FENCE 4

NOT TO SCALE

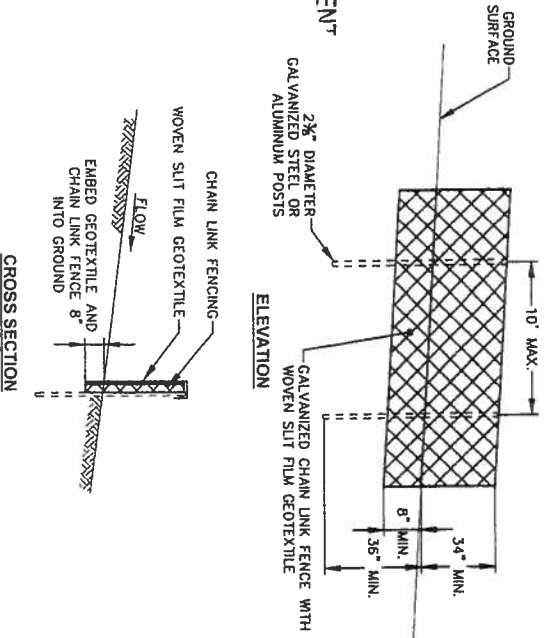

PROPERTY	TEST METHOD	GEOTEXTILE FABRICS			
		WOVEN SLIT FILM GEOTEXTILE		NONWOVEN GEOTEXTILE	
		MD	CD	MD	CD
GRAB TENSILE STRENGTH	ASTM D-4632	200 LBS	370 LBS	290 LBS	200 LBS
GRAB TENSILE ELONGATION	ASTM D-4632	15%	10%	15%	50%
TRAPEZOIDAL TEAR STRENGTH	ASTM D-4533	75 LBS	75 LBS	100 LBS	80 LBS
PUNCTURE STRENGTH	ASTM D-6241	450 LBS	450 LBS	900 LBS	450 LBS
APPERTENT OPENING SIZE	ASTM D-4751	U.S. SIEVE 30 (0.59 MM)	U.S. SIEVE 70 (0.21 MM)	U.S. SIEVE 70 (0.21 MM)	U.S. SIEVE 70 (0.21 MM)
PERMEABILITY	ASTM D-4491	0.05/SEC	0.26/SEC	0.26/SEC	1.1/SEC
ULTRAVIOLET RESISTANCE RETAINED AT 500 HOURS	ASTM D-4355	70% STRENGTH	70% STRENGTH	70% STRENGTH	70% STRENGTH


THIS DRAWING IS THE PROPERTY OF THE ARCHCADIS COMPANY AND IS NOT TO BE REPRODUCED OR TRANSMITTED IN ANY FORM OR BY ANY MEANS, ELECTRONIC OR MECHANICAL, INCLUDING PHOTOCOPYING, RECORDING, OR BY ANY INFORMATION STORAGE AND RETRIEVAL SYSTEM. WITHOUT THE WRITTEN PERMISSION OF ARCHCADIS, ANY REPRODUCTION OF THIS DRAWING IS PROHIBITED.

NOT TO SCALE

Professional Engineer's Name: **ALLEN LONG**
 Professional Engineer's No: MD 34882
 State: MD
 Date Signed: []
 Project No: []
 Project Name: []
 Checked by: []
 Drawn by: []
 Prepared by: []
 ARL

ARCADIS U.S., INC.
 Design & Consultancy for natural and built assets
 COLUMBIA GAS TRANSMISSION, LLC, A TRANSCANADA COMPANY • HOUSTON, TEXAS
 EASTERN PANHANDLE EXPANSION PROJECT
 MISCELLANEOUS DETAILS
 Date: MARCH 2017
 Site: 300 Wexford, PA 15090
 Tel: 724.742.8180


PLANS APPROVED BY: *[Signature]*
 DATE: 2/26/18
 WATER AND SCIENCE ADMINISTRATION
 WATERWAY CONSTRUCTION DIVISION
 MARYLAND DEPARTMENT OF THE ENVIRONMENT

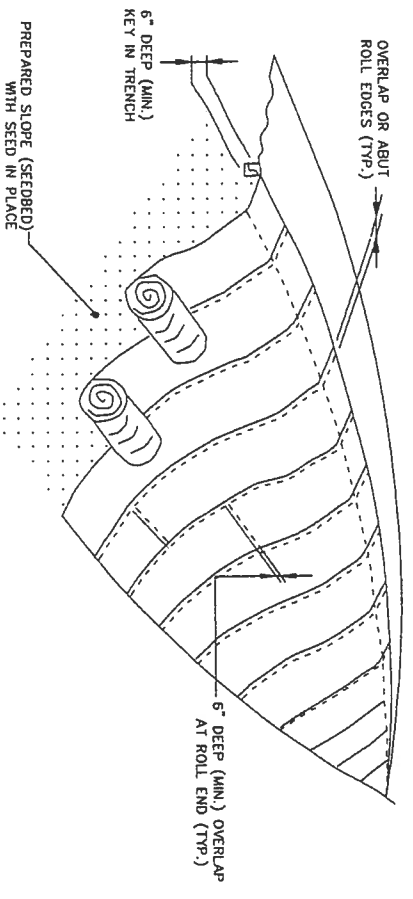

- NOTES:
1. USE TEMPORARY SOIL STABILIZATION MATTING MADE OF DEGRADABLE (LASTS 6 MONTHS MINIMUM) NATURAL OR MAN-MADE FIBERS (MUSKIE ORGANIC). MAT MUST HAVE UNIFORM THICKNESS AND DISTRIBUTION OF FIBERS THROUGHOUT AND BE SMOOTHER RESISTANT TO THE SKIN. IF PRESENT, NETTING MUST BE EXTRUDED PLASTIC WITH A MAXIMUM MESH OPENING OF 2X2 INCHES AND SUFFICIENTLY BONDED OR SEWN ON 2 INCH CENTERS ALONG LONGITUDINAL AXIS OF THE MATERIAL TO PREVENT SEPARATION OF THE NET FROM THE PARENT MATERIAL.
 2. SECURE MATTING USING STEEL STAPLES, WOOD STAKES, OR BIODEGRADABLE EQUIVALENT. STAPLES MUST BE "U" OR "T" SHAPED STEEL WIRE HAVING A MINIMUM GAUGE OF NO. 11 AND NO. 8 RESPECTIVELY. "U" SHAPED STAPLES MUST HAVE A MINIMUM 1 TO 1 1/2 INCHES WIDE AND BE A MINIMUM OF 6 INCHES LONG. "T" SHAPED STAPLES MUST HAVE A MINIMUM 8 INCH MAIN LEG, A MINIMUM 1 INCH SECONDARY LEG, AND A MINIMUM 4 INCH HEAD. WOOD STAKES MUST BE ROUGH-SAWN HARDWOOD, 12 TO 24 INCHES IN LENGTH, 1 BY 3 INCH IN CROSS SECTION, AND WEDGE SHAPED AT THE BOTTOM.
 3. PERFORM FINAL GRADING, TOPSOIL APPLICATION, SEEDBED PREPARATION, AND PERMANENT SEEDING IN ACCORDANCE WITH SPECIFICATIONS. PLACE MATTING WITHIN 48 HOURS OF COMPLETING SEEDING OPERATIONS UNLESS END OF WORKDAY STABILIZATION IS SPECIFIED ON THE APPROVED EROSION & SEDIMENT CONTROL PLAN.
 4. UNROLL MATTING DOWNSLOPE. LAY MAT SMOOTHLY AND FIRMLY UPON THE SEEDBED SURFACE. AVOID STRETCHING THE MATTING.
 5. OVERLAP OR ABUT ROLL EDGES PER MANUFACTURER RECOMMENDATIONS. OVERLAP ROLL ENDS BY 6 INCHES (MINIMUM), WITH THE UPSLOPE MAT OVERLAPPING ON TOP OF THE DOWNSLOPE MAT.
 6. KEY IN THE UPSLOPE END OF MAT 6 INCHES (MINIMUM) BY DIGGING A TRENCH, PLACING THE MATTING ROLL END IN THE TRENCH, STAPLING THE MAT IN PLACE, REPLACING THE EXCAVATED MATERIAL, AND TAMPING TO SECURE THE MAT END IN THE KEY.
 7. STAPLE/STAKE MAT IN A STAGGERED PATTERN ON 4 FOOT (MAXIMUM) CENTERS THROUGHOUT AND 2 FOOT (MAXIMUM) CENTERS ALONG SEAMS, JOINTS, AND ROLL ENDS.
 8. ESTABLISH AND MAINTAIN VEGETATION SO THAT REQUIREMENTS FOR ADEQUATE VEGETATIVE ESTABLISHMENT ARE CONTINUOUSLY MET IN ACCORDANCE WITH SECTION B-4 VEGETATIVE STABILIZATION OF THE 2011 MARYLAND STANDARDS AND SPECIFICATIONS FOR SOIL EROSION AND SEDIMENT CONTROL.

SOIL STABILIZATION MATTING 1


NOT TO SCALE

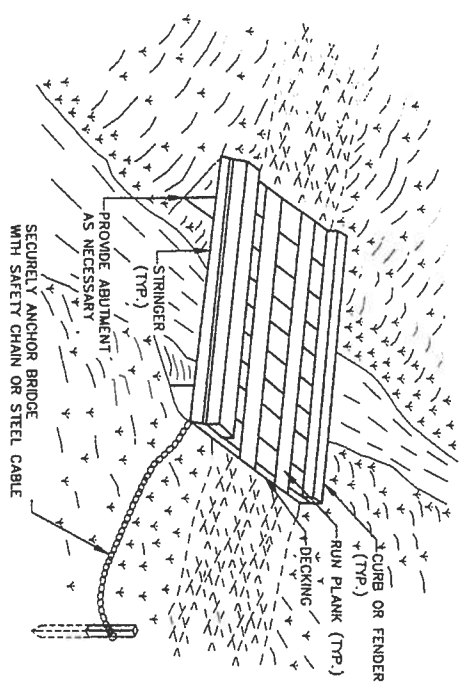

- NOTES:
1. CONSTRUCT TEMPORARY BRIDGE STRUCTURE AT OR ABOVE THE BANK ELEVATION TO PREVENT IMPACTS FROM FLOATING MATERIALS AND DEBRIS.
 2. PLACE ABUTMENTS PARALLEL TO, AND ON, STABLE BANKS.
 3. CONSTRUCT BRIDGE TO SPAN ENTIRE CHANNEL UNLESS OTHERWISE INDICATED ON APPROVED PLAN.
 4. USE STRINGERS CONSISTING OF LOGS, SAWN TIMBER, PRESTRESSED CONCRETE BEAMS, METAL BEAMS, OR OTHER APPROVED MATERIALS.
 5. SELECT DECKING MATERIALS TO PROVIDE SUFFICIENT STRENGTH TO SUPPORT THE ANTICIPATED LOAD. PLACE ALL DECKING MEMBERS PERPENDICULAR TO THE STRINGERS, BUTT TIGHTLY, AND SECURELY FASTEN. DECKING MATERIALS MUST BE BUTTED TIGHTLY TO PREVENT ANY SOIL MATERIAL TRACKED ONTO THE BRIDGE FROM FALLING INTO THE WATERWAY BELOW.
 6. SECURELY FASTEN OPTIONAL RUN PLANKS FOR THE LENGTH OF THE SPAN. PROVIDE A RUN PLANK FOR EACH TRACK OF THE EQUIPMENT WHEELS. ALTHOUGH RUN PLANKS ARE OPTIONAL, THEY MAY BE NECESSARY TO PROPERLY DISTRIBUTE LOADS.
 7. INSTALL CURBS THE ENTIRE LENGTH OF THE OUTER SIDES OF THE DECK TO PREVENT SEDIMENT FROM ENTERING THE STREAM CHANNEL.
 8. ANCHOR BRIDGE SECURELY AT ONLY ONE END USING STEEL CABLE OR CHAIN. ANCHORING AT ONLY ONE END WILL PREVENT CHANNEL OBSTRUCTION IN THE EVENT THAT FLOODWATERS FLOAT THE BRIDGE. ACCEPTABLE ANCHORS ARE LARGE TREES, LARGE BOULDERS, OR DRIVEN STEEL POSTS. ANCHOR MUST BE SUFFICIENT TO PREVENT THE BRIDGE FROM FLOATING DOWNSTREAM.
 9. AREAS DISTURBED DURING BRIDGE INSTALLATION AND/OR REMOVAL MUST NOT BE LEFT UNSTABILIZED OVERNIGHT UNLESS THE RUNOFF IS DIRECTED TO AN APPROVED SEDIMENT CONTROL DEVICE.
 10. STABILIZE APPROACH TO BRIDGE AND KEEP FREE OF EROSION. CLEAN AND VACUUM. ENSURE THAT DECKING AND CURBS REMAIN TIGHTLY BUTTED WITHOUT GAPS. REMOVE DEBRIS TRAPPED BY BRIDGE. MAINTAIN AREAS ADJACENT TO CROSSING TO CONTINUOUSLY MEET REQUIREMENTS FOR ADEQUATE VEGETATIVE ESTABLISHMENT.
 11. AFTER THE TEMPORARY CROSSING IS NO LONGER NEEDED, REMOVE IT WITHIN 14 CALENDAR DAYS. IF SUBJECT TO THE USE DESIGNATION CLOSURE, REMOVE AT THE END OF CLOSURE PERIOD. PROTECT STREAM BANKS DURING BRIDGE REMOVAL AND STABILIZE ALL DISTURBED AREAS WITH EROSION CONTROL MATTING. ACCOMPLISH REMOVAL OF THE BRIDGE AND CLEANUP OF THE AREA WITHOUT CONSTRUCTION EQUIPMENT WORKING IN THE MATTERNA CHANNEL. STORE ALL REMOVED MATERIALS IN AN APPROVED STAGING AREA.
 12. TEMPORARY CROSSINGS SHALL BE MADE FROM SUITABLE MATERIALS (I.E., STEEL PLATE, TIMBER MATTING).


TEMPORARY ACCESS BRIDGE 2

NOT TO SCALE

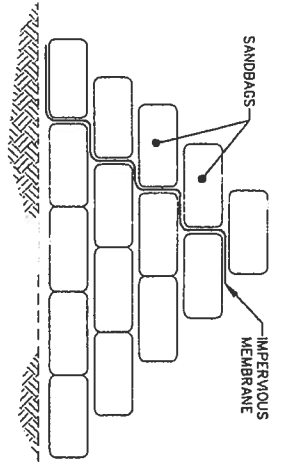

- NOTES:
1. TWO BAG MINIMUM HEIGHT ABOVE NORMAL BASE FLOW.
 2. A TEMPORARY COFFERDAM, AS MANUFACTURED BY AQUA-BARRIER OR SIMILAR, MAY BE USED IN PLACE OF SANDBAG DIVERSION DAM.
- SANDBAG DIVERSION DAM** 3

NOT TO SCALE

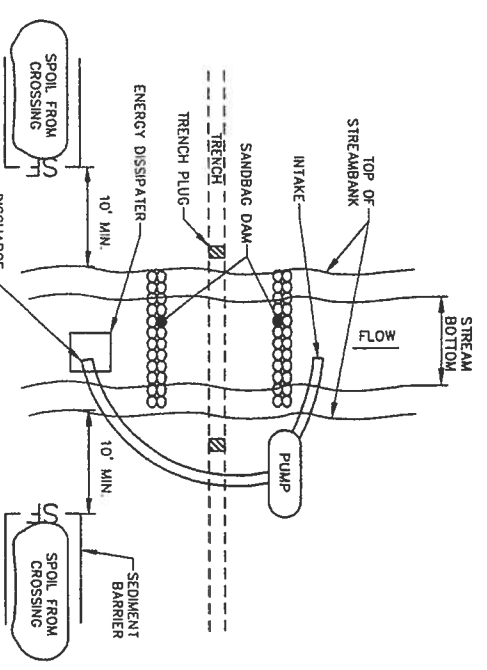

- NOTES:
1. GRABBING SHALL NOT TAKE PLACE WITHIN 50 FEET OF THE TOP-OF-BANK UNTIL ALL MATERIALS REQUIRED TO COMPLETE CROSSING ARE ON SITE AND PIPE IS READY FOR INSTALLATION.
 2. BYPASS PUMP INTAKE SHALL BE MAINTAINED A SUFFICIENT DISTANCE FROM THE BOTTOM TO PREVENT PUMPING OF CHANNEL BOTTOM MATERIALS.
 3. TRENCH PLUGS SHALL BE INSTALLED WITHIN THE TRENCH ON BOTH SIDES OF THE STREAM CHANNEL (SEE TRENCH PLUG DETAIL).
 4. WATER ACCUMULATING WITHIN THE WORK AREA SHALL BE PUMPED TO A FILTER BAG PRIOR TO DISCHARGING INTO ANY RECEIVING SURFACE WATER.
 5. HAZARDOUS OR POLLUTANT MATERIAL STORAGE AREAS SHALL BE LOCATED AT LEAST 100 FEET BACK FROM THE TOP OF STREAM BANK.
 6. ALL EXCESS EXCAVATED MATERIAL SHALL BE IMMEDIATELY REMOVED FROM THE STREAM CROSSING AREA.
 7. APPROPRIATE STREAMBANK PROTECTION SHALL BE PROVIDED WITHIN THE CHANNEL.

DAM AND PUMP BYPASS STREAM CROSSING 4


NOT TO SCALE

THIS BAR REPRESENTS ONE INCH ON THE ORIGINAL DRAWING

USE TO VERIFY FEATURE REPRODUCTION SCALE

No.	Date	By	Check	Scale	Date Speed	Project No.	Checked by


Professional Engineer's Name: **ALLEN LONG**
 Professional Engineer's No: MD 34862
 Design by: ALS
 Drawn by: ALS
 Project No: ARL

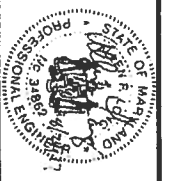

COLUMBIA GAS TRANSMISSION, LLC, A TRANSCANADA COMPANY • HOUSTON, TEXAS
 EASTERN PANHANDLE EXPANSION PROJECT
MISCELLANEOUS DETAILS
 ARCADIS Project No: CPGL00EP-0001-0008A
 Date: MARCH 2017
 ARCADIS 6811 Weber Road Extension
 Westland, PA 15080
 TEL 724.742.8180

XREFS: CPGL00EP-X00


- NOTES:**
1. STAGING AREAS SHALL BE LOCATED AT LEAST 50 FEET FROM THE EDGE OF THE WETLAND.
 2. SILT FENCE SHALL BE INSTALLED AS SHOWN ON THE PLAN DRAWINGS.
 3. DISTURBANCE FOR WETLAND CROSSINGS WILL BE LIMITED TO THE MINIMUM IMPACT NEEDED FOR PIPELINE INSTALLATION.
 4. THE MOVEMENT OF VEHICLES ACROSS THE WETLAND WILL BE MINIMIZED IF SOFT SOILS ARE ENCOUNTERED IN THE WETLAND AREA. THE USE OF TIMBER PADS/MATS WILL BE USED TO SUPPORT THE MOVEMENT OF EQUIPMENT AND/OR VEHICLES.
 5. EXCAVATED UPPER MOST 1 FOOT OF TOPSOIL (WITH THE VEGETATIVE ROOT MASS) WILL BE CAREFULLY REMOVED AND STOCKPILED SEPARATELY FROM THE SUBSOIL. UNLESS THERE IS STANDING WATER ON THE SOIL IS TOO SATURATED TO SEGREGATE.
 6. TRENCH PLUGS WILL BE INSTALLED WHERE SHOWN TO PREVENT THE PIPELINE TRENCH FROM DRAINING THE WETLANDS OR CHANGING ITS HYDROLOGY.
 7. UPSLOPE RUNOFF WILL BE DIVERTED AROUND THE WORK AREA BY THE USE OF INTERCEPTOR DIVERSIONS, WHERE INDICATED.

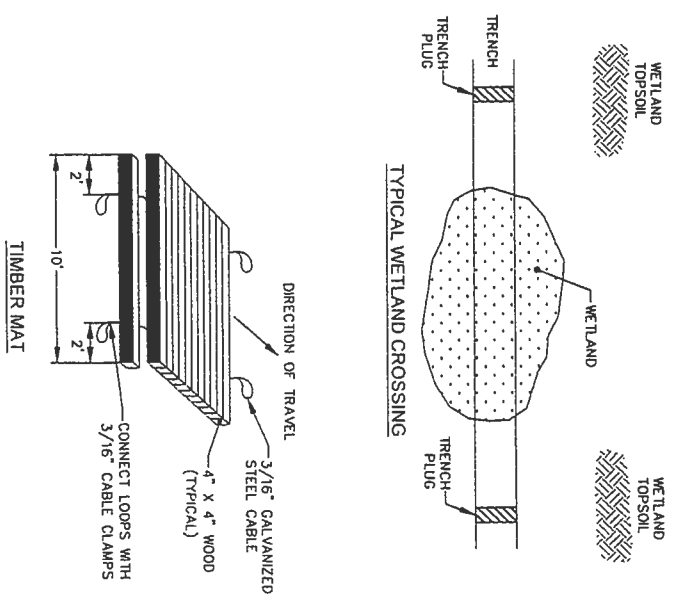

WETLAND CROSSING 1

NOT TO SCALE


- NOTES:**
1. A SEDIMENT TUBE PLACEMENT AREA SHALL BE PREPARED SO THAT IT IS FREE OF ALL DEBRIS, INCLUDING ROCKS, STICKS, ROOTS, ETC. A 2" LAYER OF ASHTO #57 STONE SHALL BE PLACED WHERE THE LOGS TOGETHER. ENDS OF TUBES MAY BE OVERLAPPED ACCORDING TO MANUFACTURER'S SPECIFICATIONS INSTEAD OF THE ASHTO #57 STONE.
 2. SEDIMENT TUBES SHALL BE PLACED AT EXISTING LEVEL GRADE. ENDS SHALL BE EXTENDED UPSLOPE AT 45 DEGREES TO THE MAIN FILTER LOG ALIGNMENT FOR A MINIMUM OF 8 FEET.
 3. SEDIMENT TUBES SHALL BE INSPECTED WEEKLY AND AFTER EACH RUNOFF EVENT.
 4. SEDIMENT DEPOSITS SHALL BE CLEANED FROM THE LOG WHEN IT REACHES HALF THE HEIGHT OF THE TUBE.
 5. DAMAGED TUBES SHALL BE REPLACED WITHIN 24 HOURS OF INSPECTION. A SUPPLY OF TUBES SHALL BE MAINTAINED ON SITE FOR THIS PURPOSE.

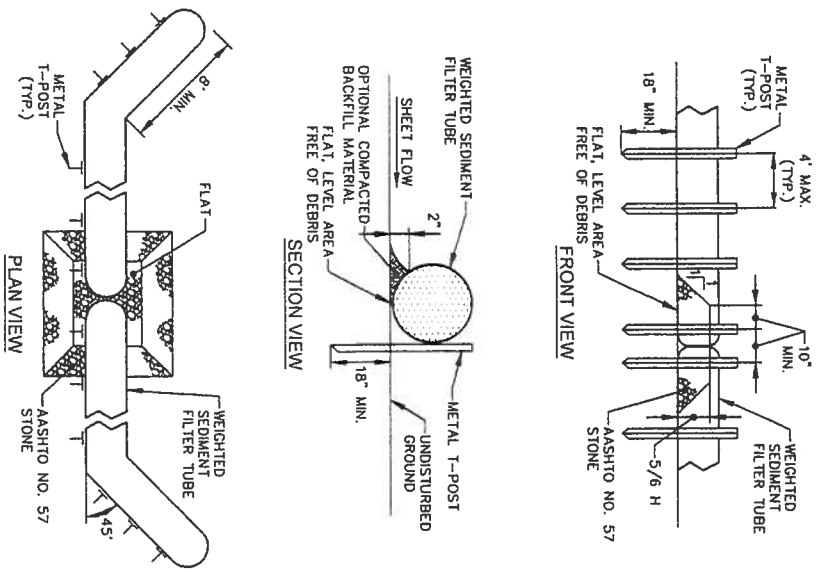

WEIGHTED SEDIMENT FILTER TUBE 2

NOT TO SCALE

- NOTES:**
1. USE MINIMUM WIDTH OF 10 FEET TO ALLOW FOR VEHICULAR PASSAGE.
 2. PLACE NONWOVEN GEOTEXTILE OVER THE EARTH MOUND PRIOR TO PLACING STONE.
 3. PLACE 2 TO 3 INCH STONE OR EQUIVALENT RECYCLED CONCRETE AT LEAST 6 INCHES DEEP OVER THE LENGTH AND WIDTH OF THE MOUNTABLE BERM.
 4. MAINTAIN LINE, GRADE, AND CROSS SECTION. ADD STONE OR MAKE OTHER REPAIRS AS CONDITIONS DEMAND. TO MAINTAIN SPECIFIED DIMENSIONS. REMOVE ACCUMULATED SEDIMENT AND DEBRIS. MAINTAIN POSITIVE DRAINAGE.

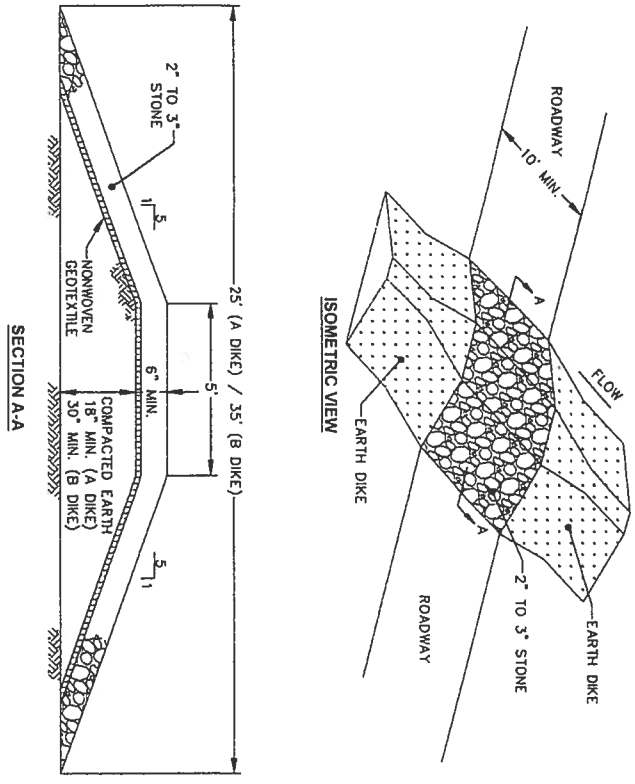

MOUNTABLE BERM 4

NOT TO SCALE


PLANS APPROVED BY: *[Signature]*
 DATE: 2/26/18
 WATER AND SCIENCE ADMINISTRATION
 WATERWAY CONSTRUCTION DIVISION
 MARYLAND DEPARTMENT OF THE ENVIRONMENT

THIS BAR REPRESENTS ONE ORIGINAL DRAWING		USE TO VERIFY REVISION INFORMATION		NO. THIS DRAWING IS THE PROJECT OR THE ARCHIVE ENTRY IDENTIFYING THE TITLE BLOCK AND MAY NOT BE RELATED TO ALTERED IN PLACE OR IN PART WITHOUT THE REVIEWER'S SIGNATURE	
Revisions	Date	By	Checked by	Scale	Project No.



COLUMBIA GAS TRANSMISSION, LLC, A TRANSCANADA COMPANY • HOUSTON, TEXAS
 EASTERN PANHANDLE EXPANSION PROJECT
MISCELLANEOUS DETAILS
 ARCADIS Project No. CPGL00EP-0001-0000A
 Date: MARCH 2017
 ARCADIS
 6001 Wilshire Road Extension
 Suite 300
 Wexford, PA 15090
 Tel: 724.742.9180


XREFS: CPGL00EP-X00

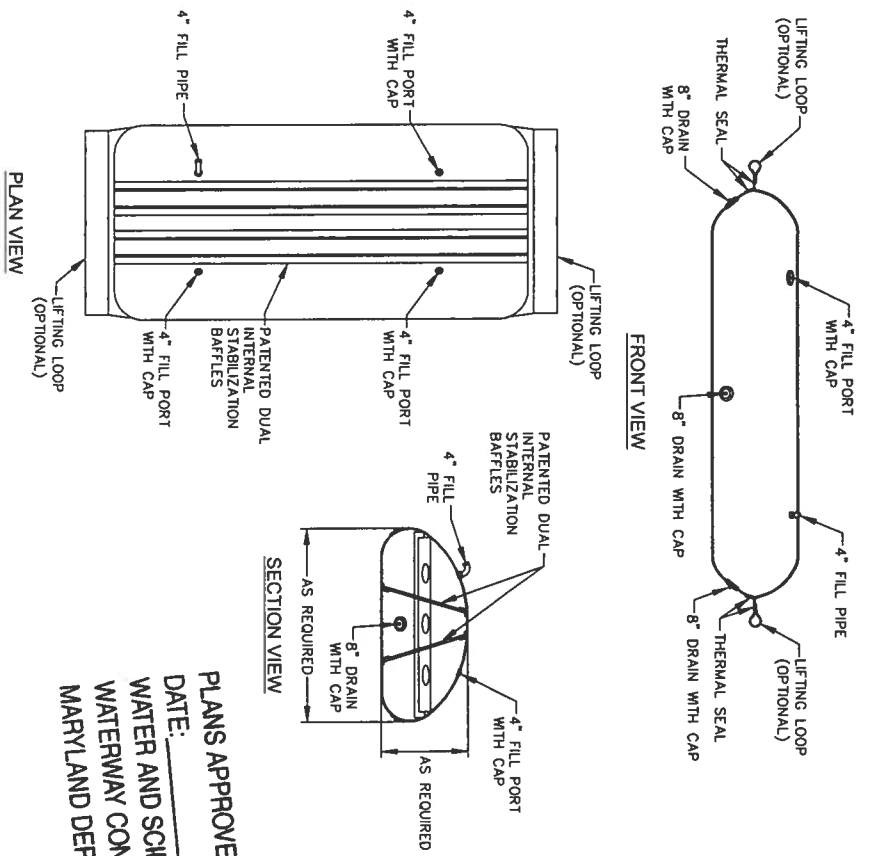

PLANS APPROVED BY: *[Signature]*
 DATE: 9/22/17
 WATER AND SCIENCE ADMINISTRATION
 CONSTRUCTION DIVISION
 MARYLAND DEPARTMENT OF THE ENVIRONMENT

NOTE:
 1. AQUA-BARRIER SHALL BE INSTALLED AND MAINTAINED IN ACCORDANCE WITH THE MANUFACTURER'S INSTALLATION GUIDELINES.

AQUA-BARRIER® 1
 NOT TO SCALE



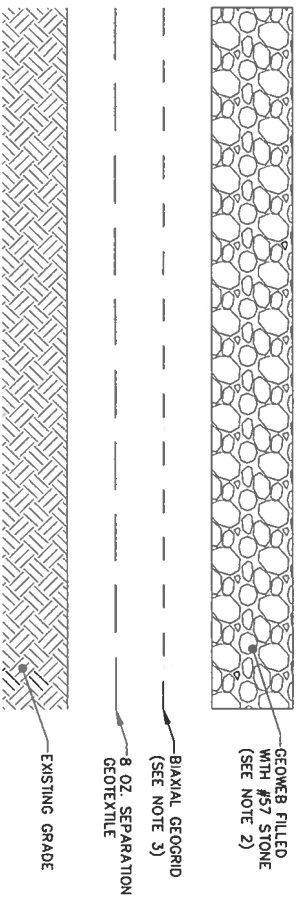


NOTES:

1. NEW PERMANENT ACCESS ROADS SHALL BE CONSTRUCTED IN ACCORDANCE WITH THIS DETAIL TO PROVIDE A PERVIOUS SURFACE FOR STORMWATER INFILTRATION AND STABILITY FOR EQUIPMENT TRAVEL.
2. GEOWEB SHALL BE STRATA 356 (8-INCH PROFILE) OR SIMILAR.
3. GEOGRID SHALL BE STRATA BASE 12 OR SIMILAR.
4. EXISTING GRADE SHALL BE INSPECTED AT THE TIME OF CONSTRUCTION TO DETERMINE SUBGRADE PREPARATION REQUIREMENTS.

TYPICAL PERMANENT ACCESS ROAD DETAIL 2
 NOT TO SCALE


STREAM CROSSING ID	CULVERT SIZE	RIPRAP BASIN											
		D ₅₀ (FT)	D _{MAX} (FT)	TAILWATER DEPTH (TW) (FT)	EQUIVALENT BRINK DEPTH (E _B) (FT)	DISSIPATOR POOL DEPTH (D _P) (FT)	CULVERT WIDTH (W _C) (FT)	FORESLOPE THICKNESS (T ₁) (FT)	RIPPRAP THICKNESS (T ₂) (FT)	Basin Width (W _B) (FT)	Basin Length (L _B) (FT)	Pool Length (L _P) (FT)	Apron Length (L _A) (FT)
SIE	5'H X 4'W CONCRETE BOX CULVERT	0.30	0.45	5.00	3.00	0.60	4.00	0.89	0.67	18.33	20.00	15.00	5.00
S1	3'H X 6'W CONCRETE BOX CULVERT	0.23	0.34	5.94	2.00	0.47	6.00	0.68	0.51	22.00	24.00	18.00	6.00
SBB	4'H X 3'W CONCRETE BOX CULVERT	0.67	1.00	3.38	3.83	1.34	3.00	2.00	1.50	16.37	20.05	13.37	6.68

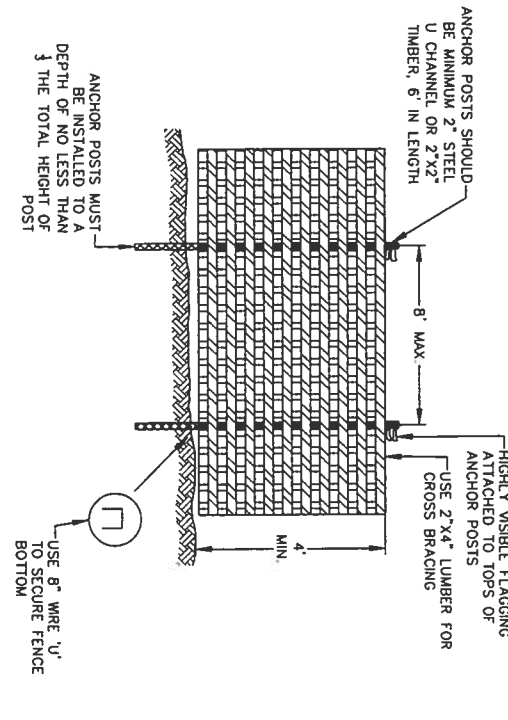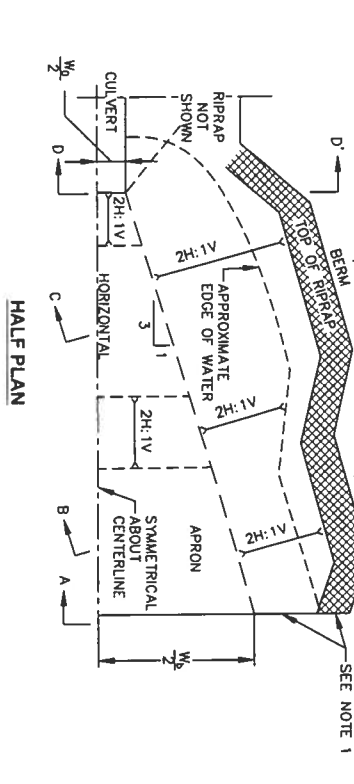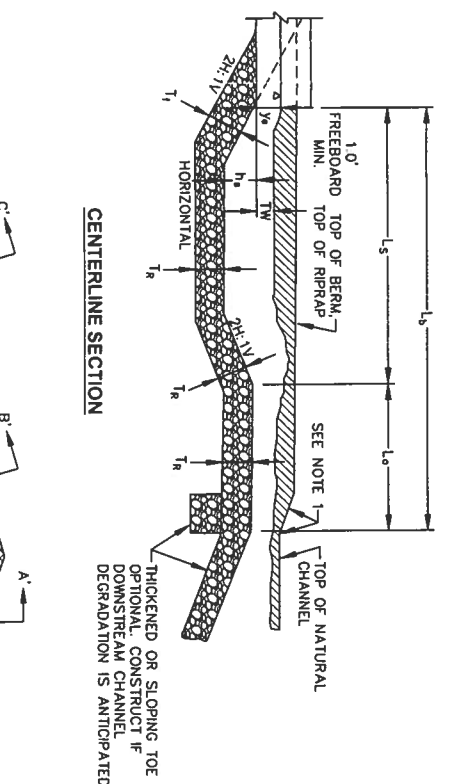

NOTES:

1. BLAZE ORANGE OR BLUE PLASTIC MESH FENCE FOR TREE PROTECTION FENCE.
2. BOUNDARIES OF RETENTION AREA WILL BE ESTABLISHED AS PART OF THE FOREST CONSERVATION PLAN REVIEW PROCESS.
3. BOUNDARIES OF RETENTION AREA SHALL BE STAKED AND FLAGGED PRIOR TO INSTALLING TREE PROTECTION FENCE.
4. AVOID DAMAGES TO CRITICAL ROOT ZONE. DO NOT DAMAGE OR SEVER LARGE ROOTS WHEN INSTALLING POSTS.
5. TREE PROTECTION SIGNS ARE REQUIRED.
6. TREE PROTECTION FENCE SHALL BE MAINTAINED THROUGHOUT CONSTRUCTION.

PLASTIC MESH TREE PROTECTION FENCE 3
 NOT TO SCALE

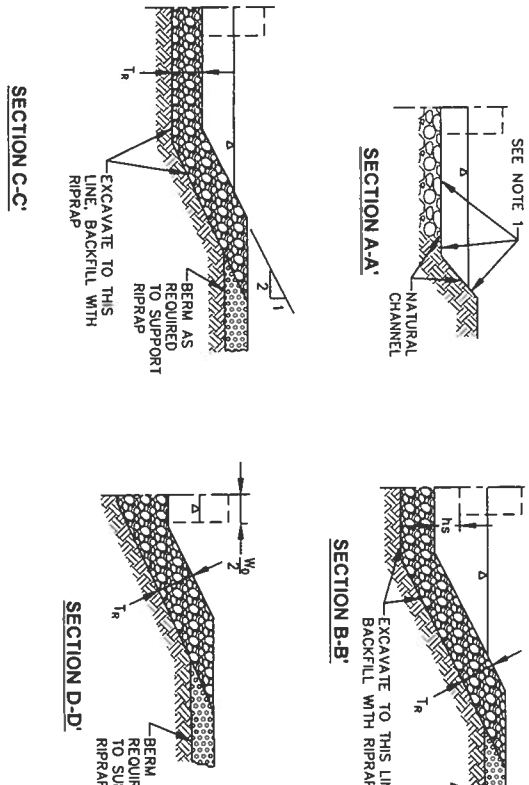

NOTES:

1. WARP BASIN TO CONFORM TO NATURAL STREAM CHANNEL. TOP OF RIPRAP IN FLOOR OF BASIN SHOULD BE AT LEAST THE SAME ELEVATION OR LOWER THAN THE NATURAL CHANNEL BOTTOM AT SECTION A-A.

RIPPRAP BASIN ENERGY DISSIPATOR 4
 NOT TO SCALE

THIS DRAWING IS TO BE USED IN CONJUNCTION WITH THE ORIGINAL DRAWING.


NO.	DATE	REVISIONS	BY	CHKD	DESIGNED BY	DRAWN BY	CHECKED BY
1	9/20/17	MOE COMMENT RESPONSE	ALS	ARL	Professional Engineer's Name	ALS	ARL
2	9/21/17	MOE COMMENT RESPONSE	ALS	ARL	Professional Engineer's No	ALS	ARL
3	9/21/17	FOREST CONSERVATION ACT REQUIREMENT	ALS	ARL	MD 34862	ALS	ARL
4	12/11/17	MOE COMMENT RESPONSE	ALS	ARL	State	ALS	ARL




COLUMBIA GAS TRANSMISSION, LLC, A TRANSCANADA COMPANY • HOUSTON, TEXAS
 EASTERN PANHANDLE EXPANSION PROJECT
MISCELLANEOUS DETAILS
 ARCADIS PROJECT NO: CPGL00EP-0001-00088A
 Date: MARCH 2017
 ARCADIS
 6001 Wilkes Road Extension
 Suite 300
 Wexford, PA 15090
 Tel: 724 742 9190



WASHINGTON COUNTY, MD - MORGAN COUNTY, WV

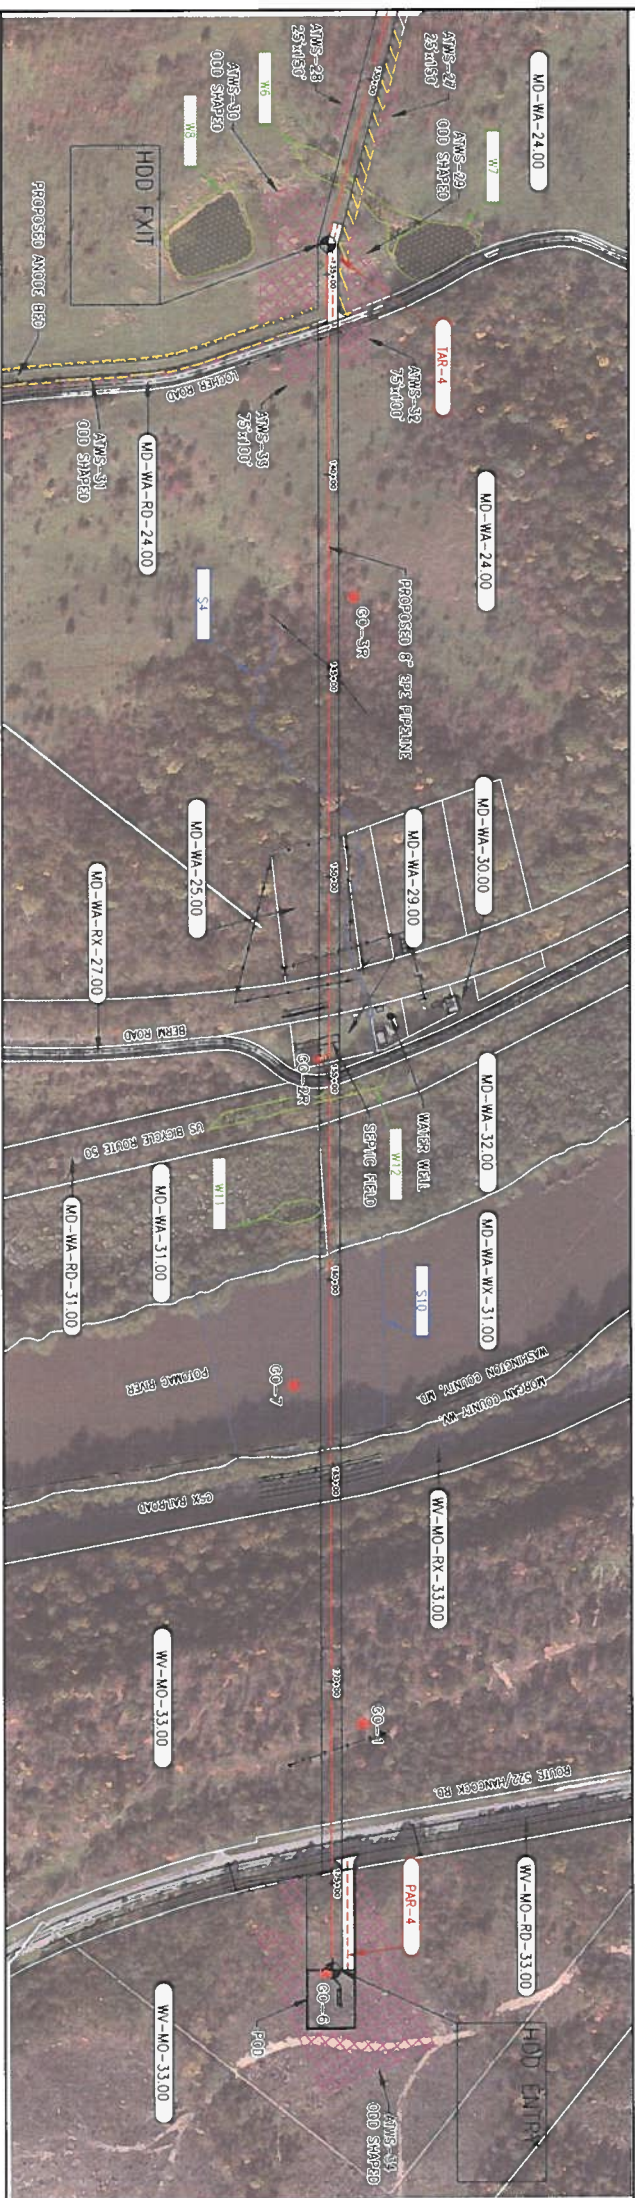

PLAN
SCALE 1"=200'

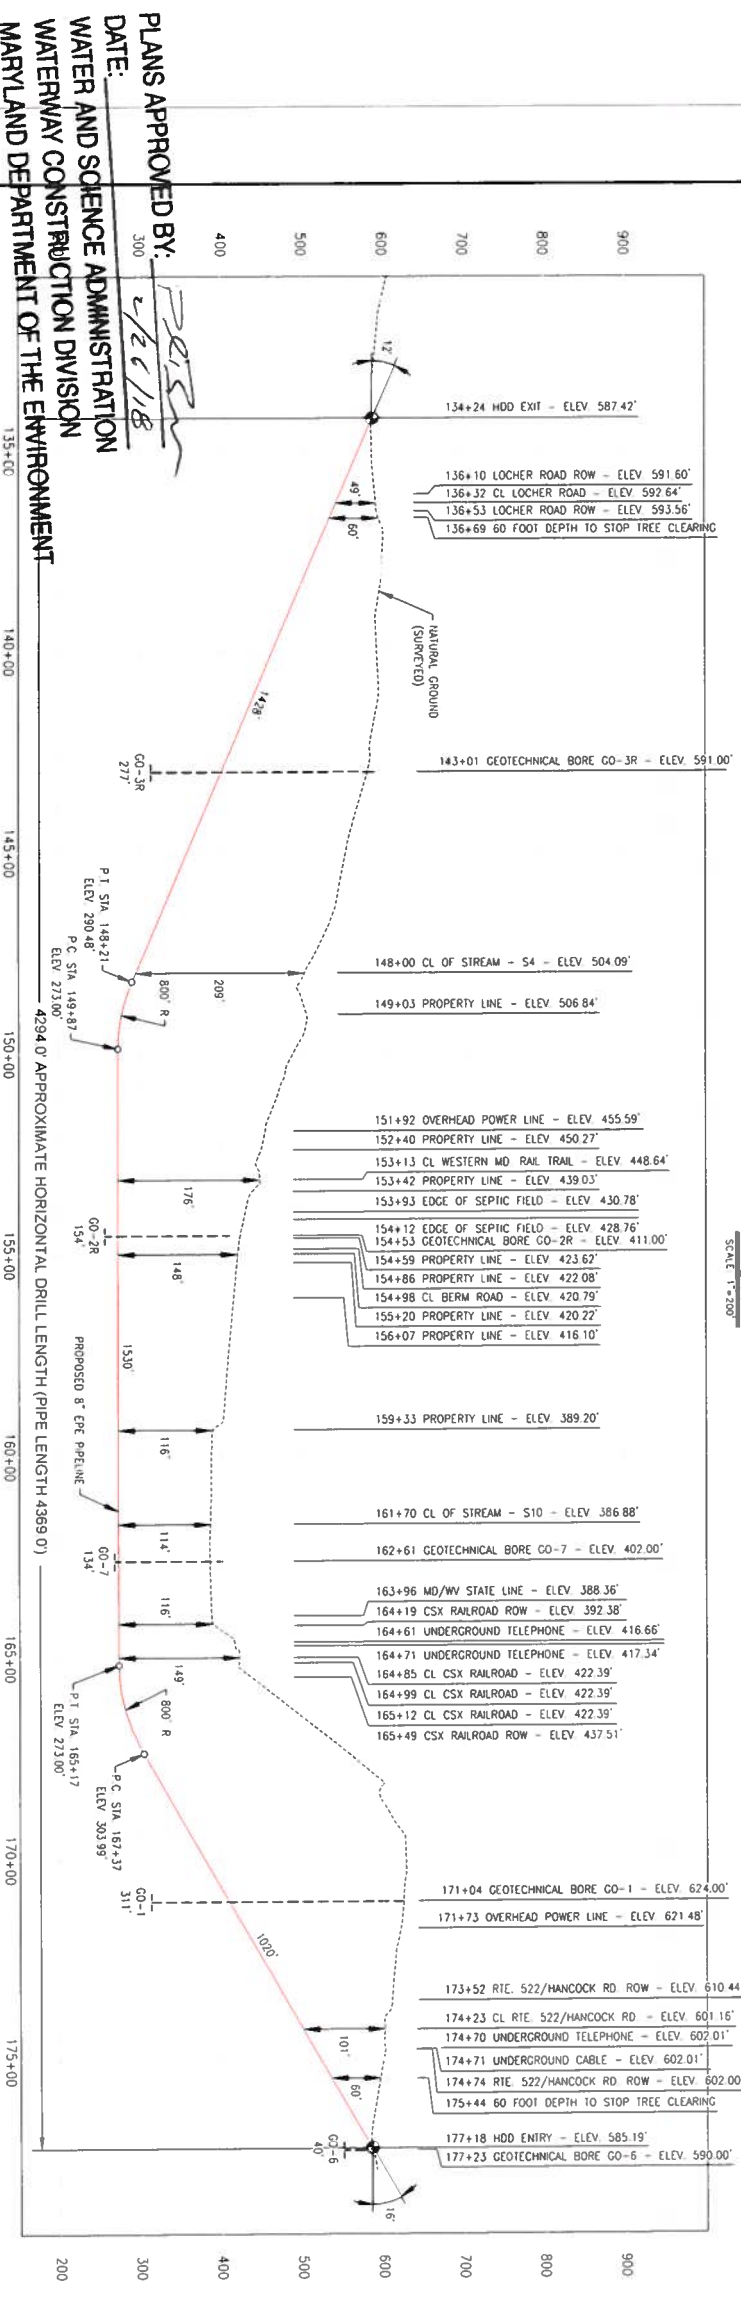

PROFILE
HORIZ SCALE 1"=200'
VERT SCALE 1"=100'

PLANS APPROVED BY: *[Signature]*
DATE: 2/26/18
WATER AND SCIENCE ADMINISTRATION
WATERWAY CONSTRUCTION DIVISION
MARYLAND DEPARTMENT OF THE ENVIRONMENT

LEGEND

	PROPOSED 8" EPE PIPELINE
	PROPOSED 48" EPE PIPELINE
	PROPOSED 36" EPE PIPELINE
	PROPOSED 24" EPE PIPELINE
	PROPOSED 18" EPE PIPELINE
	PROPOSED 12" EPE PIPELINE
	PROPOSED 6" EPE PIPELINE
	PROPOSED 4" EPE PIPELINE
	PROPOSED 3" EPE PIPELINE
	PROPOSED 2" EPE PIPELINE
	PROPOSED 1.5" EPE PIPELINE
	PROPOSED 1" EPE PIPELINE
	PROPOSED 0.75" EPE PIPELINE
	PROPOSED 0.5" EPE PIPELINE
	PROPOSED 0.375" EPE PIPELINE
	PROPOSED 0.25" EPE PIPELINE
	PROPOSED 0.1875" EPE PIPELINE
	PROPOSED 0.125" EPE PIPELINE
	PROPOSED 0.0625" EPE PIPELINE
	PROPOSED 0.03125" EPE PIPELINE
	PROPOSED 0.015625" EPE PIPELINE
	PROPOSED 0.0078125" EPE PIPELINE
	PROPOSED 0.00390625" EPE PIPELINE
	PROPOSED 0.001953125" EPE PIPELINE
	PROPOSED 0.0009765625" EPE PIPELINE
	PROPOSED 0.00048828125" EPE PIPELINE
	PROPOSED 0.000244140625" EPE PIPELINE
	PROPOSED 0.0001220703125" EPE PIPELINE
	PROPOSED 0.00006103515625" EPE PIPELINE
	PROPOSED 0.000030517578125" EPE PIPELINE
	PROPOSED 0.0000152587890625" EPE PIPELINE
	PROPOSED 0.00000762939453125" EPE PIPELINE
	PROPOSED 0.000003814697265625" EPE PIPELINE
	PROPOSED 0.0000019073486328125" EPE PIPELINE
	PROPOSED 0.00000095367431640625" EPE PIPELINE
	PROPOSED 0.000000476837158203125" EPE PIPELINE
	PROPOSED 0.0000002384185791015625" EPE PIPELINE
	PROPOSED 0.00000011920928955078125" EPE PIPELINE
	PROPOSED 0.000000059604644775390625" EPE PIPELINE
	PROPOSED 0.0000000298023223876953125" EPE PIPELINE
	PROPOSED 0.00000001490116119384765625" EPE PIPELINE
	PROPOSED 0.000000007450580596923828125" EPE PIPELINE
	PROPOSED 0.0000000037252902984619140625" EPE PIPELINE
	PROPOSED 0.00000000186264514923095703125" EPE PIPELINE
	PROPOSED 0.000000000931322574615478515625" EPE PIPELINE
	PROPOSED 0.0000000004656612873077392578125" EPE PIPELINE
	PROPOSED 0.00000000023283064365386962890625" EPE PIPELINE
	PROPOSED 0.00000000011641532182693484765625" EPE PIPELINE
	PROPOSED 0.000000000058207660913467424328125" EPE PIPELINE
	PROPOSED 0.0000000000291038304567312121640625" EPE PIPELINE
	PROPOSED 0.00000000001455191522836560608203125" EPE PIPELINE
	PROPOSED 0.000000000007275957614182803041015625" EPE PIPELINE
	PROPOSED 0.0000000000036379788070914015205078125" EPE PIPELINE
	PROPOSED 0.00000000000181898940354570076025390625" EPE PIPELINE
	PROPOSED 0.000000000000909494701772850380126953125" EPE PIPELINE
	PROPOSED 0.0000000000004547473508864251900634765625" EPE PIPELINE
	PROPOSED 0.0000000000002273736754432125950317328125" EPE PIPELINE
	PROPOSED 0.00000000000011368683772160627751562890625" EPE PIPELINE
	PROPOSED 0.0000000000000568434188608033757814454765625" EPE PIPELINE
	PROPOSED 0.0000000000000284217094304016878907227328125" EPE PIPELINE
	PROPOSED 0.000000000000014210854715200843945141365625" EPE PIPELINE
	PROPOSED 0.0000000000000071054273576004219725706828125" EPE PIPELINE
	PROPOSED 0.00000000000000355271367880021098628534140625" EPE PIPELINE
	PROPOSED 0.0000000000000017763568394001054931426707203125" EPE PIPELINE
	PROPOSED 0.0000000000000008881784197000527465713133515625" EPE PIPELINE
	PROPOSED 0.0000000000000004440892098500263732856567890625" EPE PIPELINE
	PROPOSED 0.00000000000000022204460492501318664282834765625" EPE PIPELINE
	PROPOSED 0.00000000000000011102230246250065932141365625" EPE PIPELINE
	PROPOSED 0.000000000000000055511151231250329660706828125" EPE PIPELINE
	PROPOSED 0.0000000000000000277555756156251548303534140625" EPE PIPELINE
	PROPOSED 0.000000000000000013877787807812577415171671703125" EPE PIPELINE
	PROPOSED 0.0000000000000000069388939039062870758888534140625" EPE PIPELINE
	PROPOSED 0.000000000000000003469446951953143794426706828125" EPE PIPELINE
	PROPOSED 0.00000000000000000173472347597657171972133515625" EPE PIPELINE
	PROPOSED 0.0000000000000000008673617379882858598606828125" EPE PIPELINE
	PROPOSED 0.0000000000000000004336808689941429293034140625" EPE PIPELINE
	PROPOSED 0.000000000000000000216840434497071464651706828125" EPE PIPELINE
	PROPOSED 0.0000000000000000001084202172485357323258534140625" EPE PIPELINE
	PROPOSED 0.000000000000000000054210108624267866161671703125" EPE PIPELINE
	PROPOSED 0.000000000000000000027105054312133930808534140625" EPE PIPELINE
	PROPOSED 0.00000000000000000001355252715606696540426706828125" EPE PIPELINE
	PROPOSED 0.00000000000000000000677626357803348271133515625" EPE PIPELINE
	PROPOSED 0.000000000000000000003388131789016741365625" EPE PIPELINE
	PROPOSED 0.0000000000000000000016940658945083706828125" EPE PIPELINE
	PROPOSED 0.000000000000000000000847032947254194140625" EPE PIPELINE
	PROPOSED 0.0000000000000000000004235164736270706828125" EPE PIPELINE
	PROPOSED 0.00000000000000000000021175823681353534140625" EPE PIPELINE
	PROPOSED 0.00000000000000000000010587911840671703125" EPE PIPELINE
	PROPOSED 0.0000000000000000000000529395592033515625" EPE PIPELINE
	PROPOSED 0.00000000000000000000002646977960167828125" EPE PIPELINE
	PROPOSED 0.000000000000000000000013234889800839140625" EPE PIPELINE
	PROPOSED 0.00000000000000000000000661744490041953140625" EPE PIPELINE
	PROPOSED 0.000000000000000000000003308722450209765625" EPE PIPELINE
	PROPOSED 0.0000000000000000000000016543612251048828125" EPE PIPELINE
	PROPOSED 0.00000000000000000000000082718061252444140625" EPE PIPELINE
	PROPOSED 0.00000000000000000000000041359030626222206828125" EPE PIPELINE
	PROPOSED 0.0000000000000000000000002067951531311133515625" EPE PIPELINE
	PROPOSED 0.0000000000000000000000001033975765655567890625" EPE PIPELINE
	PROPOSED 0.00000000000000000000000005169878828277890625" EPE PIPELINE
	PROPOSED 0.000000000000000000000000025849394141365625" EPE PIPELINE
	PROPOSED 0.0000000000000000000000000129246970706828125" EPE PIPELINE
	PROPOSED 0.00000000000000000000000000646234853534140625" EPE PIPELINE
	PROPOSED 0.0000000000000000000000000032311742671703125" EPE PIPELINE
	PROPOSED 0.000000000000000000000000001615587133515625" EPE PIPELINE
	PROPOSED 0.000000000000000000000000000807793567890625" EPE PIPELINE