



Francis Scott Key Bridge Rebuild Project

Vicinity Map

Baltimore City and Baltimore County, Maryland

June 2024


24-WL-0607 and 24-WL-0653

24-WQC-0022

202460906

7/8/2024

1 of 45

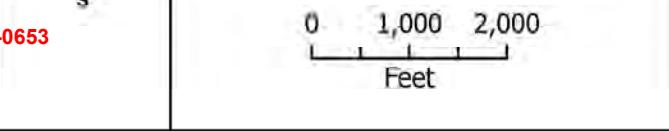

- Study Area
- County Boundaries

REMAINDER OF FSK BRIDGE DEMOLITION

NOTES:

- Erosion controls shall be in place on both approaches prior to removing any deck or dropping any steel.
- Shielding barges will be positioned beneath span being removed to prevent any slurry or debris from entering the waterway.

Deck, Parapet, and Median Removal (Water)

1. The existing median barrier will be removed by hammering it every ten (10) feet to create sections. The barrier will then be hammered where it meets the deck. Cut any rebar and move each section down the bridge.
2. Parapet will be removed by sawcutting techniques.
3. Core holes in the parapet to allow rigging to be inserted.
4. Make plunge cuts every ten (10) feet to create sections.
5. Finally, make a longitudinal cut adjacent to the bottom of the barrier.
6. Lift the sections and place them on the deck.
7. Drag the sections out of the way to the laydown area.
8. Next, the concrete deck will be removed. The concrete deck is non-composite so sawcutting techniques will also be utilized for this removal operation.
9. The size of the deck panels shall be six (6) feet long and nine (9) feet wide (this is the spacing of the girders.)
10. Make the sawcuts in the span to be removed. Sawcut down the center of the existing girders.
11. Once the deck is sawcut, begin to remove the deck sections.
12. Deck sections shall be moved off the span and down to the laydown yard.
13. The concrete deck and parapet sections will be downsized and then shall be loaded into trucks for recycling at an approved recycling facility.

Deck, Parapet, and Median Removal (Land)

1. The existing median barrier will be removed by hammering it every ten (10) feet to create sections. The barrier will then be hammered where it meets the deck. Cut

- any rebar and move each section down the bridge.
2. Parapet will be removed by sawcutting techniques.
 3. Core holes in the parapet to allow rigging to be inserted.
 4. Make plunge cuts every ten (10) feet to create sections.
 5. Finally, make a longitudinal cut adjacent to the bottom of the barrier.
 6. Lift the sections and place them on the deck.
 7. Drag the sections out of the way to the laydown area.

Next, the concrete deck will be removed. The concrete deck is non-composite so sawcutting techniques will also be utilized for this removal operation.

8. The size of the deck panels shall be six (6) feet long and nine (9) feet wide (this is the spacing of the girders.)
9. Make the sawcuts in the span to be removed. Sawcut down the center of the existing girders.
10. Once the deck is sawcut, begin to remove the deck sections.
11. Deck sections shall be moved off the span and down to the laydown yard.
12. The concrete deck and parapet sections will be downsized and then shall be loaded into trucks for recycling at an approved recycling facility.

Girder Removal (Water)

1. The existing continuous span girders shall be removed either in pairs or as a single unit (there are seven (7) beams in each span.)
2. Position the Ringer Crane into position and spud down. A material barge shall be placed alongside the crane barge.
3. Remove the first section of steel by cutting holes in the web to insert the chain through. A spreader bar will be utilized as these spans are 300 feet long.
4. Lift the section of steel with the crane and place it on the material barge.
5. Multiple material barges may be required due to the span length.
6. Continue in each span until all the beams are removed.
7. Move to the adjacent span and repeat the process.
8. The operation will then be moved to the opposite approach to remove those spans.
9. The material barges will be pushed to the laydown yard where they will be offloaded.
10. Once the steel is offloaded, it will be subsequently downsized with a combination of hydraulic shears and oxygen/propane torches.
11. Load steel into trucks to be recycled at facility listed above.

Girder & Pier Removal (Land) – Piers 1 through 13 & 25 through 36

1. The existing land spans and piers shall be removed by felling the piers and allowing the steel girders to drop.
2. The existing column legs, caps, and struts shall be drilled to allow charges to be placed.
3. Once all charges are placed, explosive demolition shall fell the piers which will bring

the steel girders down to the ground.

4. Once the steel girders and piers are on the ground, process the materials. Any remaining portions of the piers shall be hammered with a hydraulic excavator equipped with a hydraulic hammer.
5. Multiple spans will be felled at once since the spans are continuous.
6. Repeat the process for the remaining land spans.
7. Load concrete and steel into trucks to be recycled at facility listed above.

Pier Above Water Removal – Piers 14 through 16 & 22 through 24

1. The portion of the piers above the water for the remaining piers (14, 15, 16, and 22, 23, 24) shall be removed using explosives.
2. The existing pier caps, columns, and struts shall be drilled to allow charges to be placed.
3. Once the charges are placed, the explosives will fail the piers and allow them to fall into the water.
4. They will be cleaned up with the portions of the piers that are below water.

Pier Below Water Removal – Piers 14 through 16 & 19 through 24

1. The portions of the existing piers that are below water (14, 15, 16, 19, 20, 21, 22, 23, and 24) shall be removed utilizing explosives.
2. The piers shall either be drilled from on top of the pier or from a barge.
3. Divers will be sent down to inspect the footing to check for any cofferdams that may have been left in place. If they are found, the sheets will be cut vertically every eight (8) feet.
4. Once the drilling is completed, the explosives will be placed and the piers will be imploded.
5. Once they are imploded, the river bottom will be cleaned up with a combination of hydraulic excavators and duty cycle cranes equipped with clamshell buckets.
6. Place material on barges and push to trestle or offloading yard.
7. Offload all the debris from the barges then move the barge back to each pier until the cleanup is complete.
8. Piers shall be removed to two (2) feet below existing mudline or as directed by the United States Coast Guard (USCG) or the United States Army Corps of Engineers (USACE). Approximate elevations of mudline:
 - a. Pier 14 – EL -16
 - b. Pier 15 – EL -16
 - c. Pier 16 – EL -20
 - d. Pier 19 – EL -25
 - e. Pier 20 – EL -24
 - f. Pier 21 – EL -24
 - g. Pier 22 – EL -19
 - h. Pier 23 – EL -13

- i. Pier 24 – EL -15
9. Load concrete into trucks to be recycled at facility listed above.

Abutment Removal

1. The existing abutments and wingwalls shall be completely removed.
2. Hammer the abutments and wingwalls with a hydraulic excavator equipped with a hydraulic hammer.
3. Load concrete into trucks to be recycled at an approved facility.

Pier 18 Strut & Column Removal (Above Water)

1. The portion of Pier 18 above the water shall be removed using explosives.
2. The existing pier caps, columns, and struts shall be drilled to allow charges to be placed.
3. Once the charges are placed, the explosives will fail the piers and allow them to fall into the water.
4. They will be cleaned up with the portions of the piers that are below water.

Pier 17 & 18 Lower Strut, Column, and Footing Removal (Below Water)

1. The portions of the existing Piers 17 and 18 that are below water shall be removed utilizing explosives.
2. The piers shall either be drilled from on top of the pier or from a barge.
3. Divers will be sent down to inspect the footings/tremies to check for any cofferdams that may have been left in place. If they are found, the sheets will be cut vertically every eight (8) feet.
4. Once the drilling is completed, the explosives will be placed and the piers will be imploded.
5. Once they are imploded, the river bottom will be cleaned up with a combination of hydraulic excavators and duty cycle cranes equipped with clamshell buckets.
6. Place material on barges and push to trestle or offloading yard.
7. Offload all the debris from the barges then move the barge back to each pier until the cleanup is complete.
8. Pier 17 and 18 shall be removed to the top of the (footing) foundation concrete unless otherwise directed by MDTA.
9. Load concrete into trucks to be recycled at facility listed above.

Dolphins A, B, C, & D Removal

1. The top portion of each of the dolphins from EL 4 to EL 0 shall be hammered in place utilizing hydraulic excavators equipped with hydraulic hammers operating on barges.
2. Concrete shall fall into water and will be cleaned up after the remainder of the dolphins are removed.
3. The dolphins shall be drilled from a barge.
4. Divers will be sent down to inspect the sheets. The sheets will be cut vertically

every eight (8) feet.

5. Once the drilling is completed, the explosives will be placed and the dolphins will be imploded.
6. Once they are imploded, the river bottom will be cleaned up with a combination of hydraulic excavators and duty cycle cranes equipped with clamshell buckets.
7. Place material on barges and push to trestle or offloading yard.
8. Offload all the debris from the barges then move the barge back to each dolphin until the cleanup is complete.
9. Dolphins shall be removed to two (2) feet below existing mudline. Approximate elevations of the mudline – A & C EL -40 – B & D EL -26
10. Load concrete into trucks to be recycled at facility listed above.

Salt Shed Removal

1. The existing wood framed salt shed shall be demolished systematically starting at the top and working towards the bottom.
2. Once the upper portion is removed, any existing slabs, foundations, or sonotubes shall be removed to two (2) feet below ground level.
3. Load concrete and construction/demolition debris into trucks to be recycled at an approved facility.


Piers 19-21 Blast Parameters

	<u>P19</u>	<u>P20</u>	<u>P21</u>
Number of holes	180	126	163
Hole depth (ft)	36	34	34
Hole diameter(in)	2.75	2.75	2.75
Spacing(ft)	5	4.5	4.5
Burden(ft)	4.5	4.5	4.5
Number of holes	180	126	163
Max. decks per hole	2	2	2
Max. explosives /delay(lb)	30	24	26
Approx. Total explosive(lb)	5500	3000	4300
Average powder factor	1.75	1.75	1.75
Minimum delay (ms)	9	9	9

Estimated Peak Particle Velocity (in/sec) at Utility Trench

Structure	Distance(ft)	lb/delay	K = 24.2	160	240	300
Pier 19	~230	30	0.061	0.405	0.607	0.795
Pier 20	~230	24	0.051	0.338	0.508	0.635
Pier 21	~230	26	0.058	0.383	0.574	0.718

** K value indicates level of confinement of the blast with 24.2 being unconfined and 300 being extremely confined (as a sinking cut in solid bedrock).

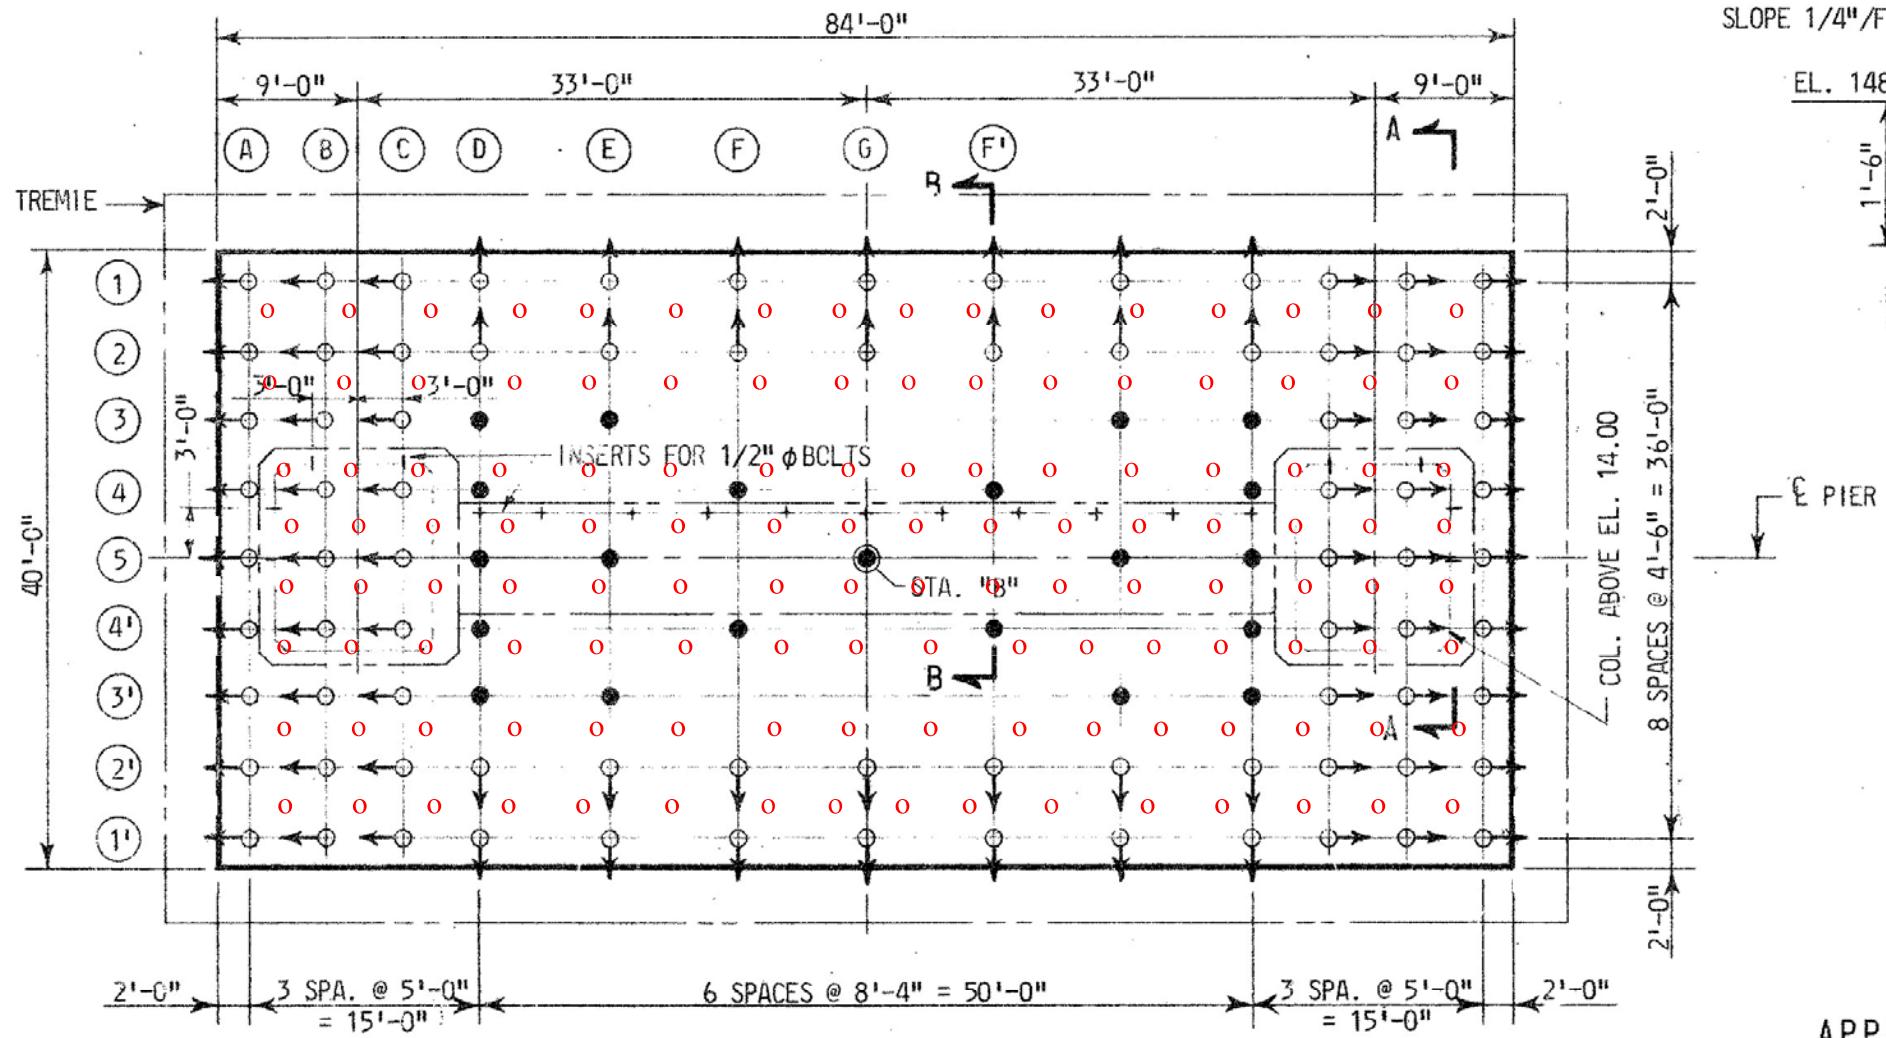


24-WL-0607 and 24-WL-0653

24-WQC-0022

202460906

7/8/2024

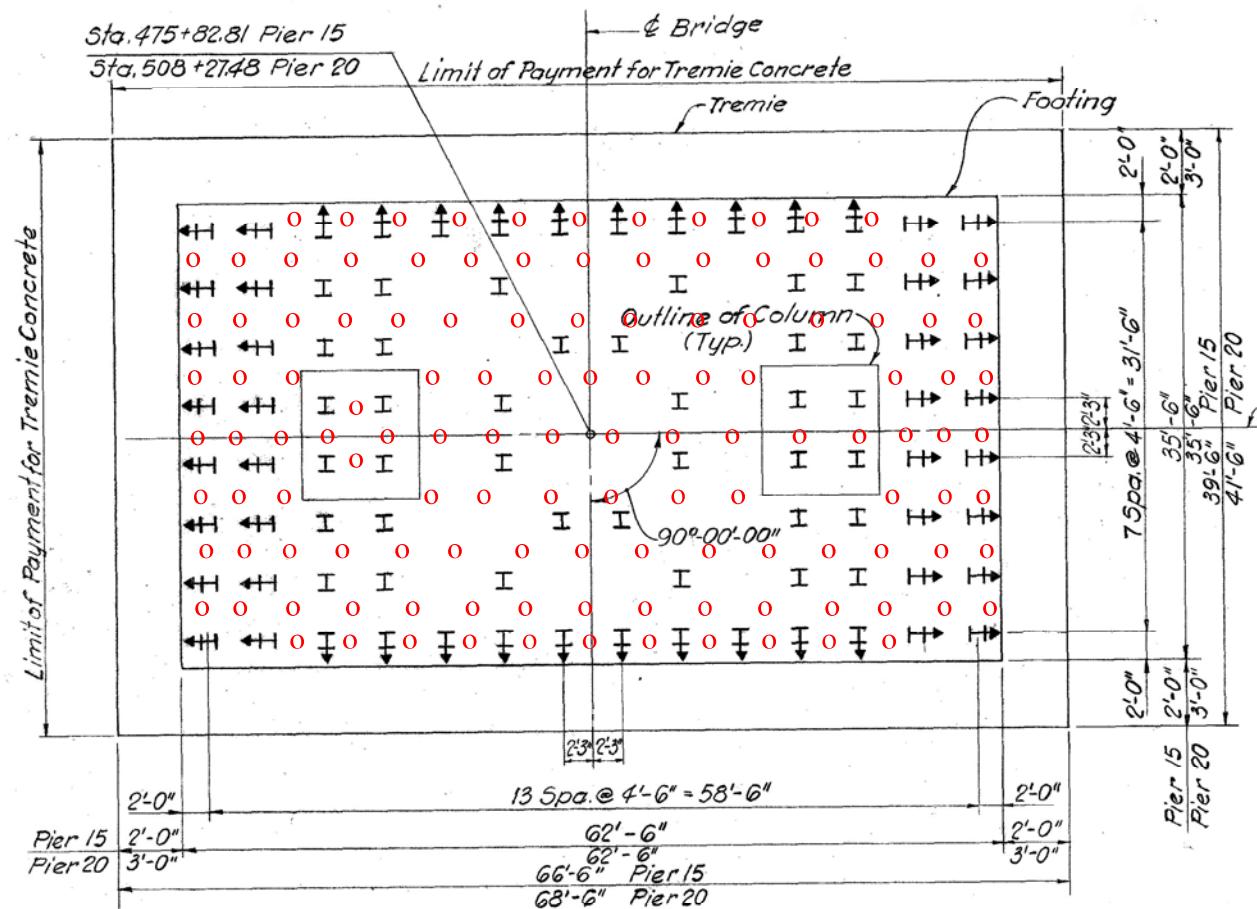

PILE PLAN PIERs 15 & 20

24-WL-0607 and 24-WL-0653


24-WQC-0022

202460906


7/8/2024

9 of 45

PILE PLAN

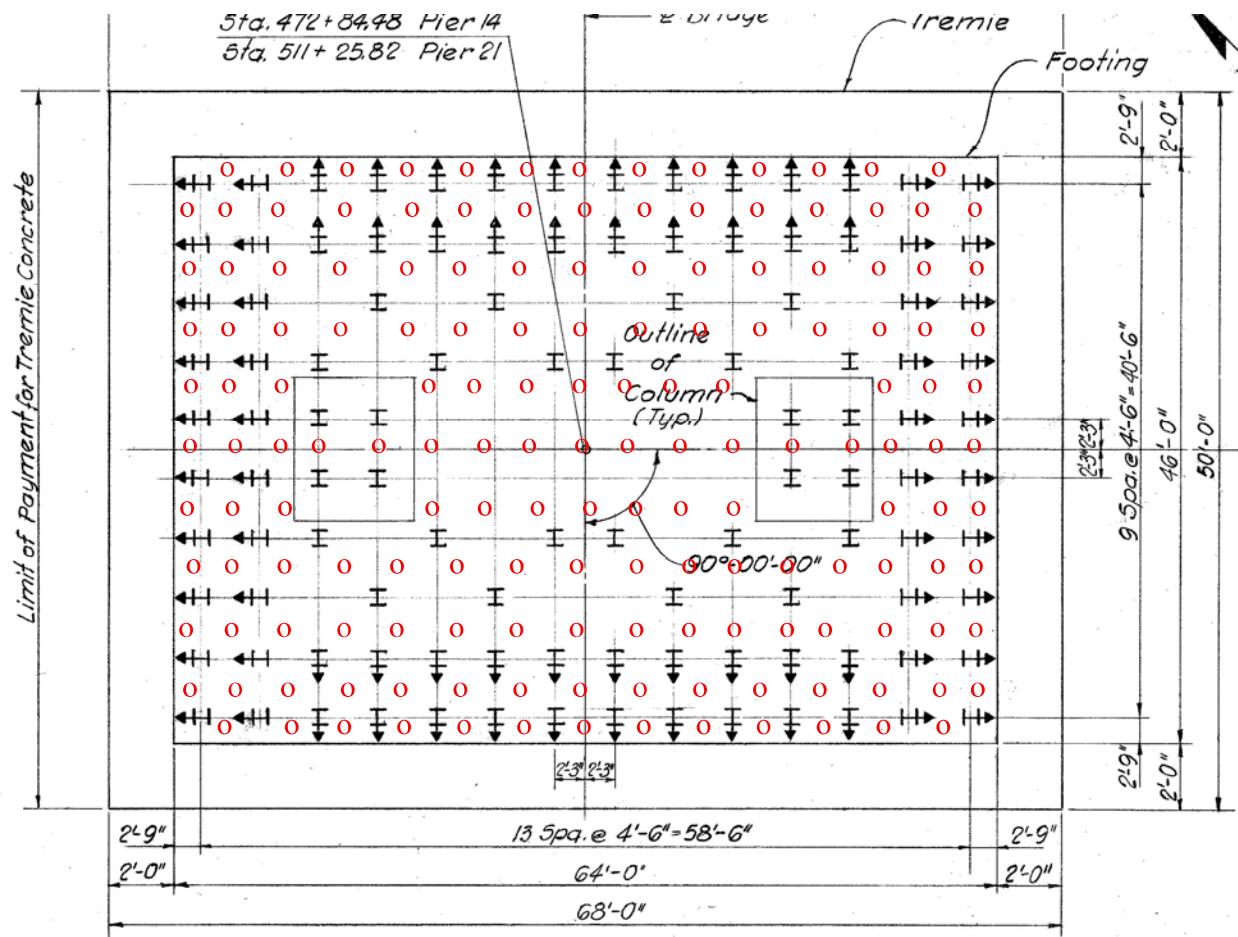


PILE PLAN PIERs 14 & 21

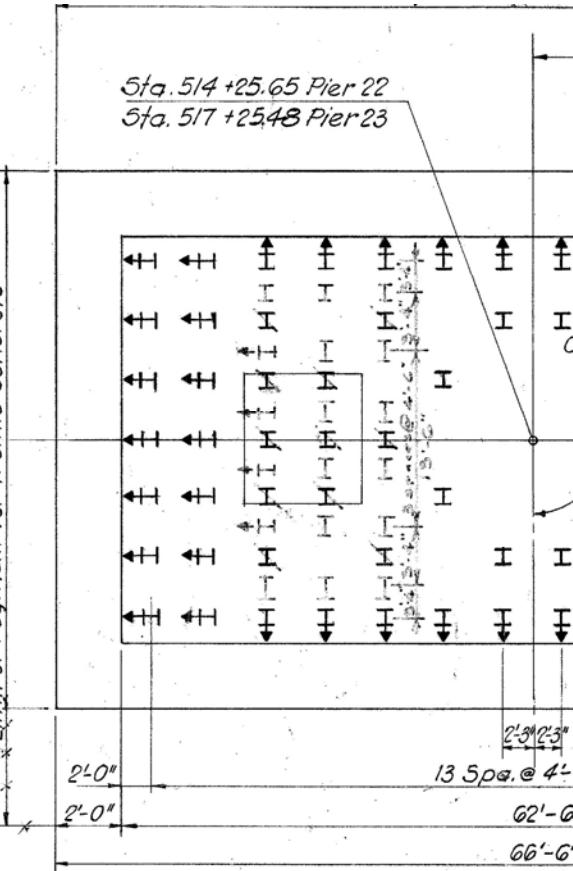

PILE PLAN PIERs

24-WL-0607 and 24-WL-0653
24-WQC-0022
202460906
7/8/2024
10 of 45


Typical cross sectional view of drilled piers

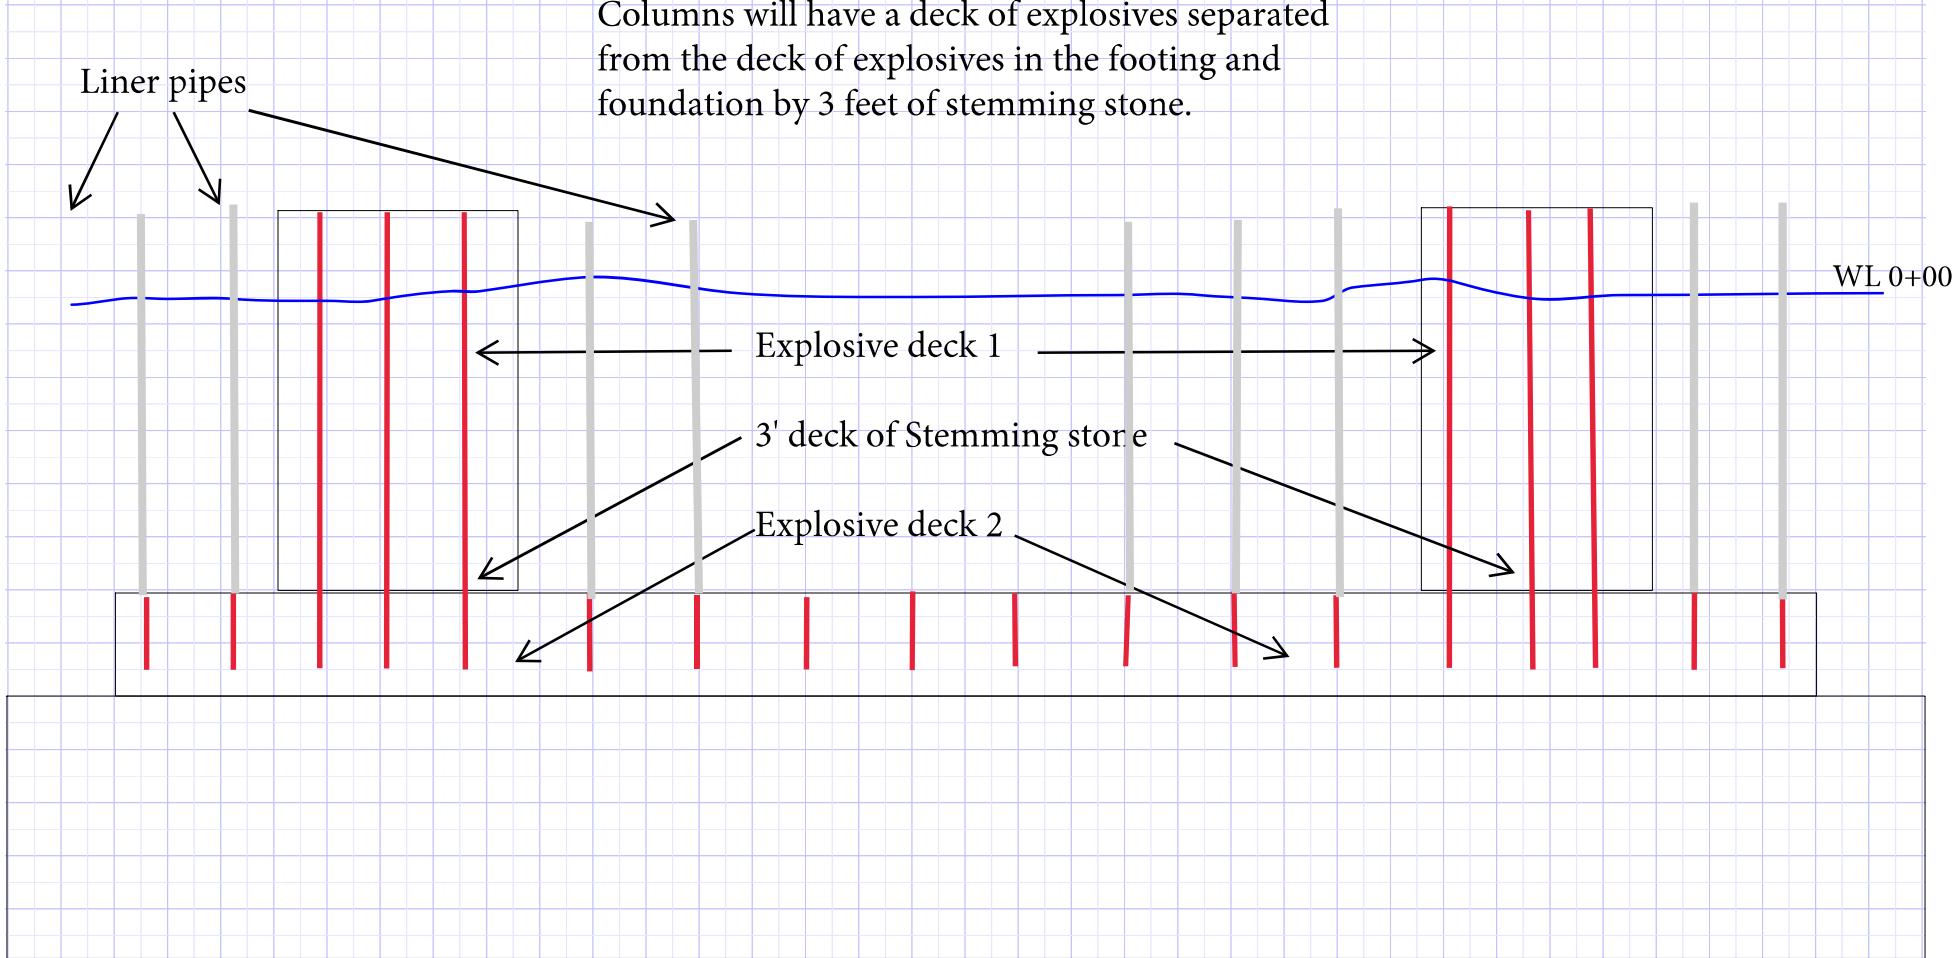

Holes in footing and foundation will be drilled using a template and casing pipes. Once the holes are drilled liner pipes will be placed in each hole to facilitate loading of explosives from above the water.

24-WL-0607 and 24-WL-0653
24-WQC-0022
202460906
7/8/2024

Typical Elevations

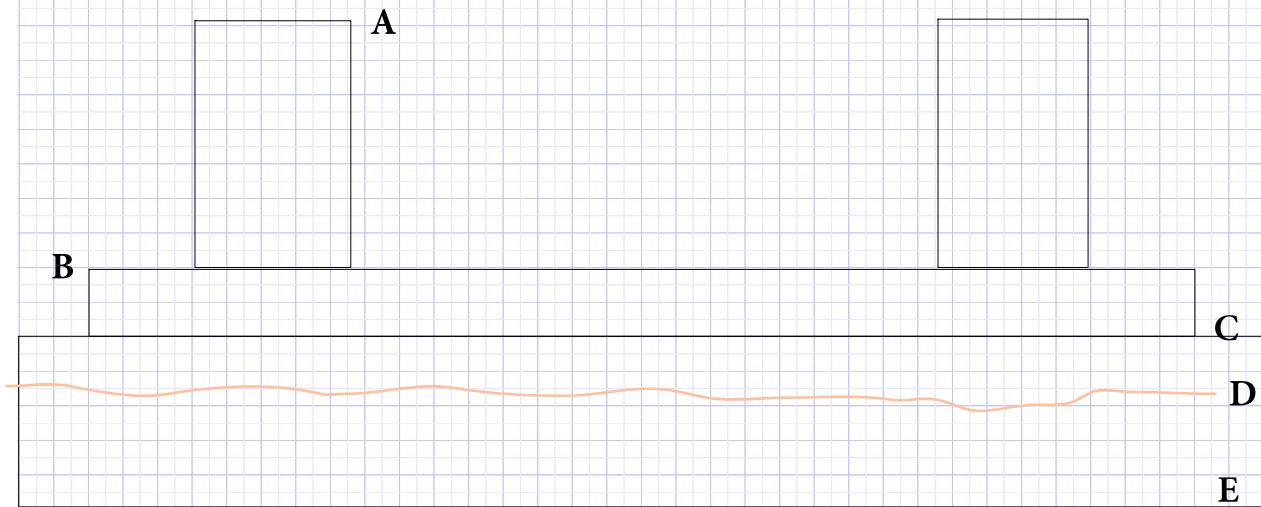

A - Top of pier

P19 = ~+4

P20 = ~+1

P21 = ~+1

B - Top of footing

P19 = -15

P20 = -15

P21 = -15

C - Top of foundation

P19 = -21

P20 = -23

P21 = -23

D - Mud line (per as built)

P19 = -25

P20 = -24

P21 = -24


E - Bottom of foundation

P19 = -35

P20 = -26


P21 = -36

DOLPHIN B

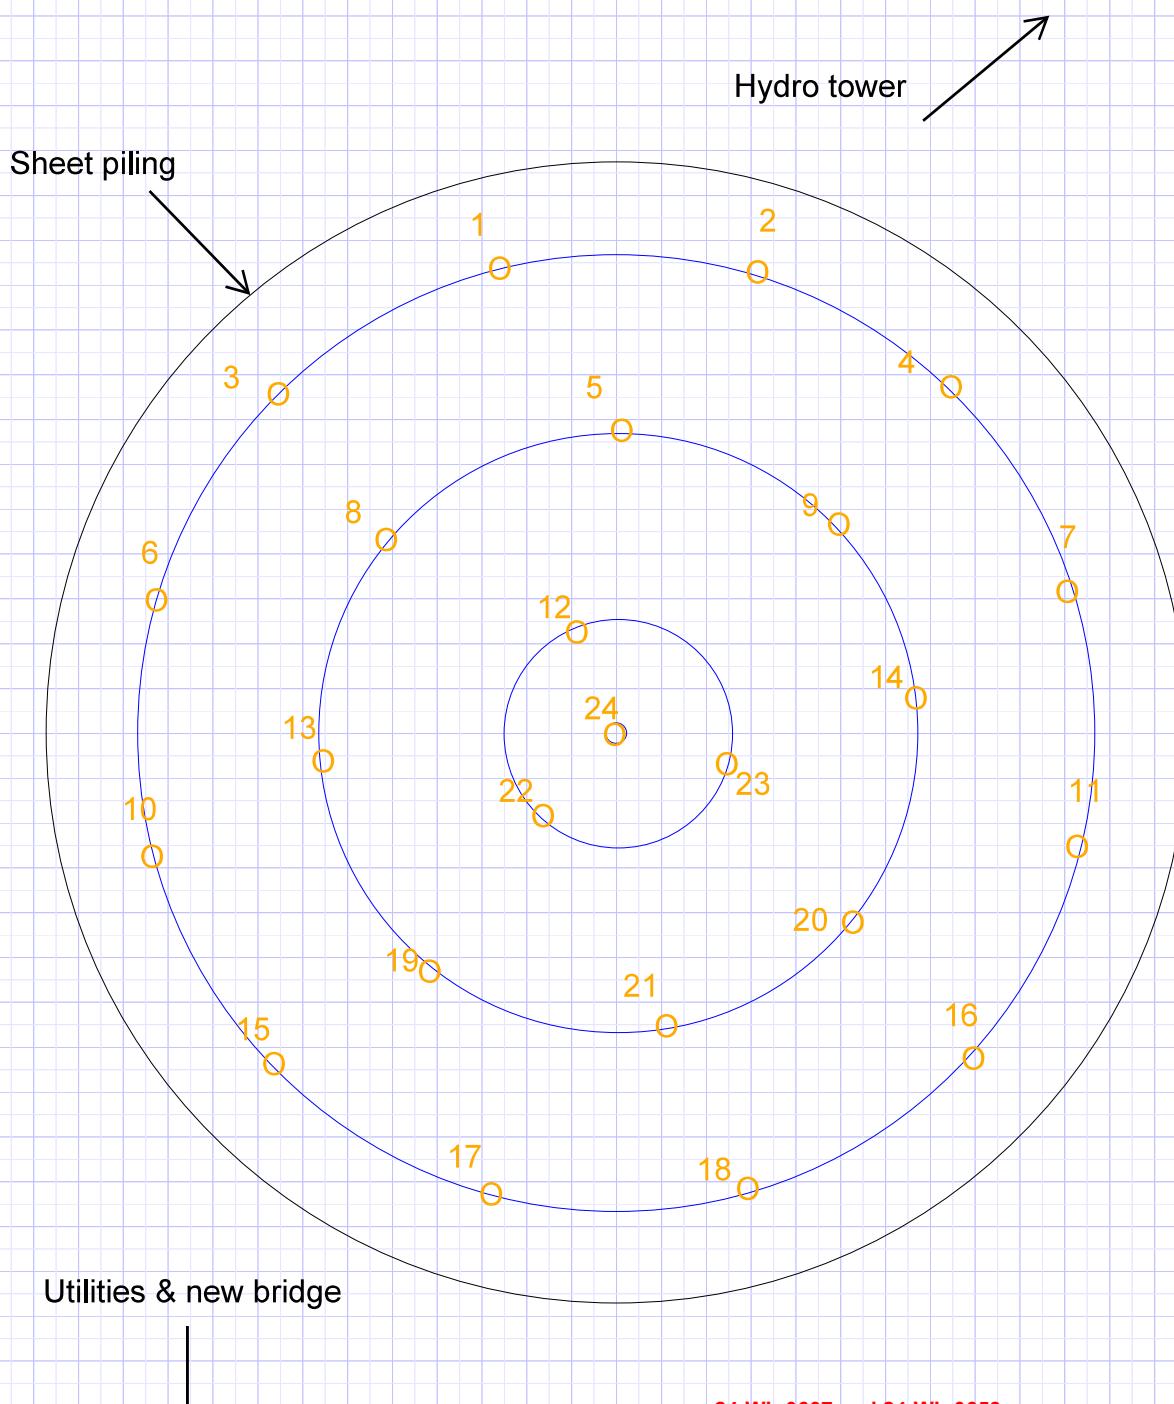

Blast Parameters

Number of holes = 24
 Hole diameter = 2.75"
 Hole depth = 32'
 Spacing = 5.5'
 Burden = 4 - 4.5'
 Collar height = 4'
 Explosive column = 28'
 Approx. total explosives wt. = ~1123 lb
 Max. explosive / delay = 47 lb
 Overall powder factor = 1.8 (ranges 1 - 2)
 Delay between detonations = 17ms Total shot duration = 391ms
 Initiation - Nonel dual delay detonators.
 Explosive - Dynomax Pro.
 Shot sequence as numbered on sketch.
 All explosive columns will be double primed, one detonator in bottom and one near the top for redundancy.
 Sheet pile to be Pre-cut.

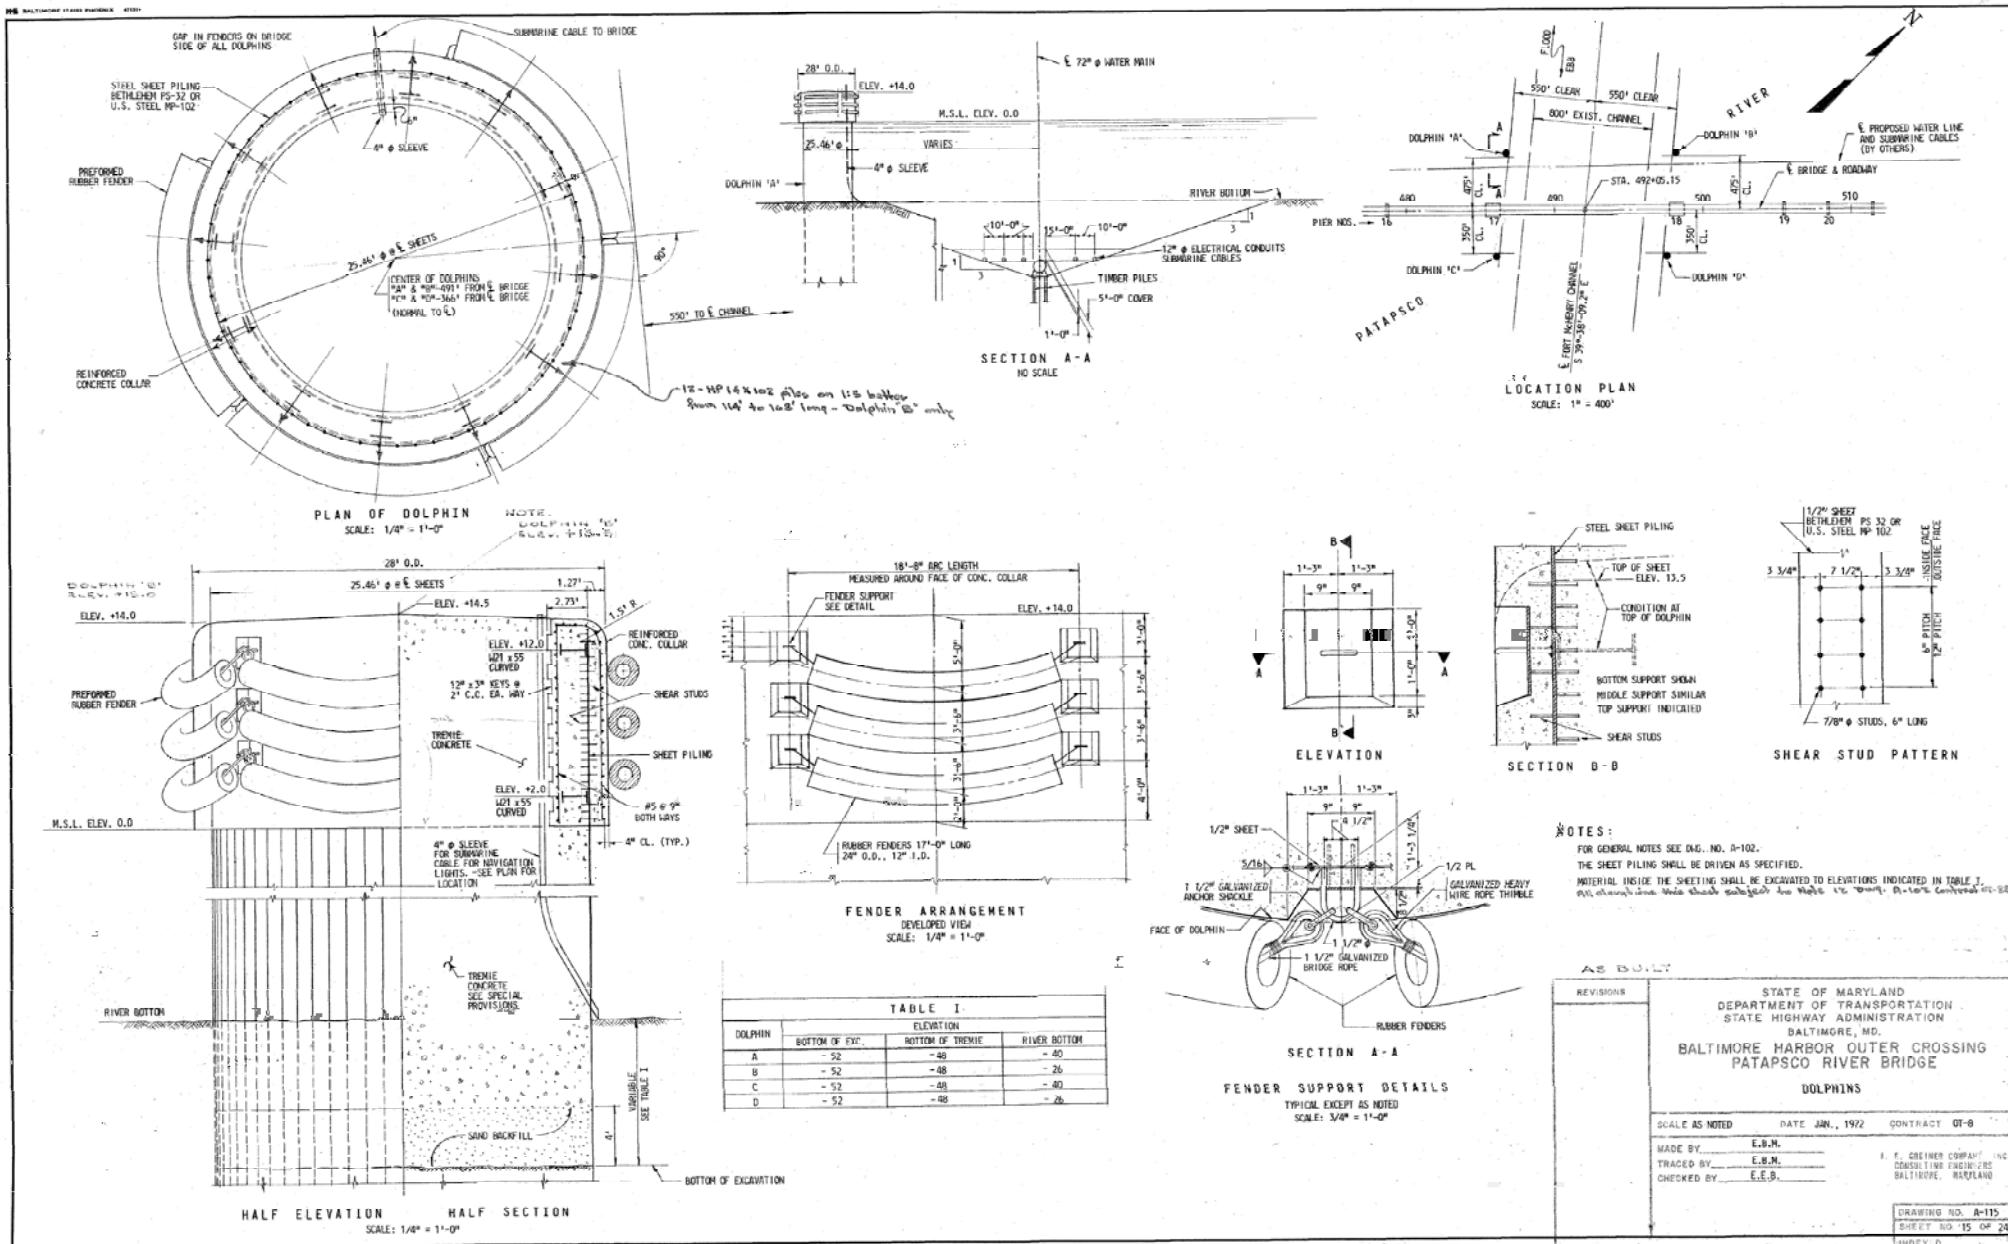


24-WL-0607 and 24-WL-0653

24-WQC-0022

202460906

7/8/2024

14 of 45

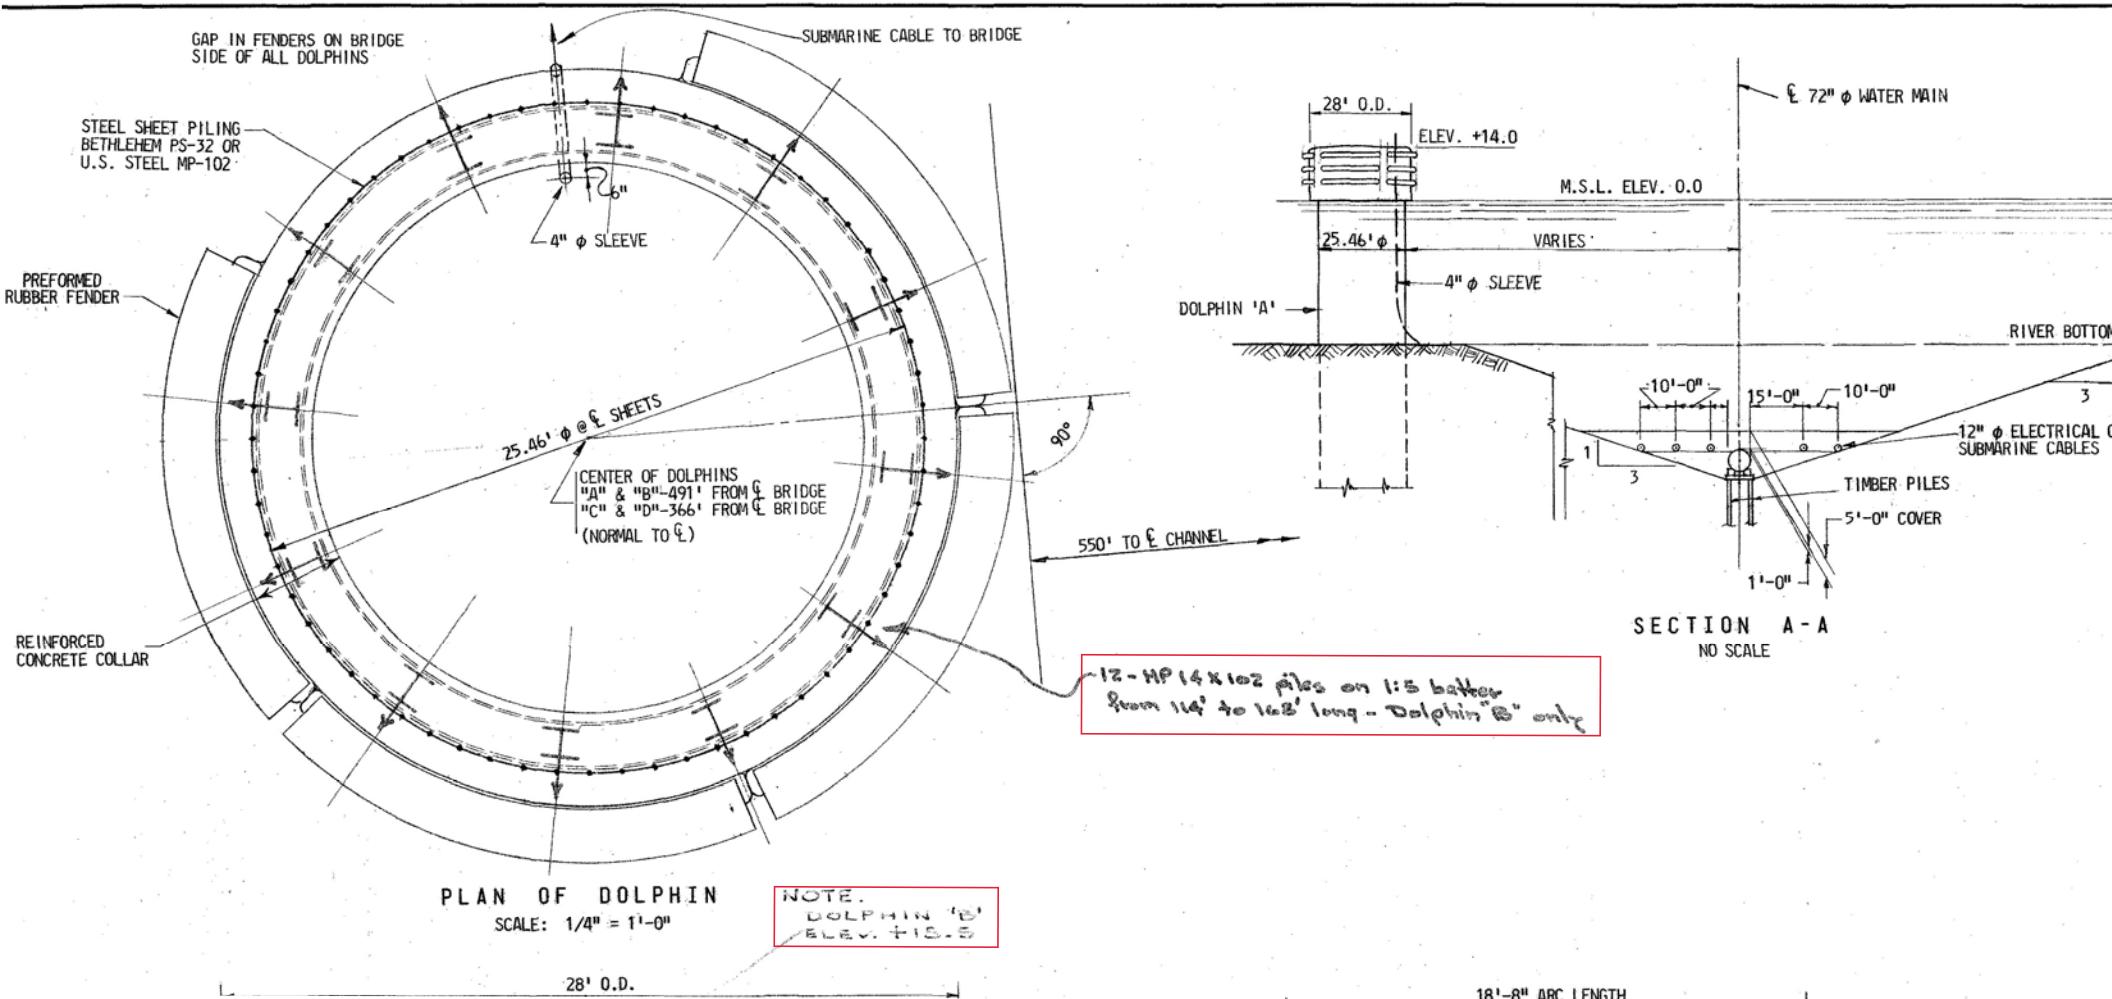


24-WL-0607 and 24-WL-0653

24-WQC-0022

202460906

7/8/2024

15 of 45

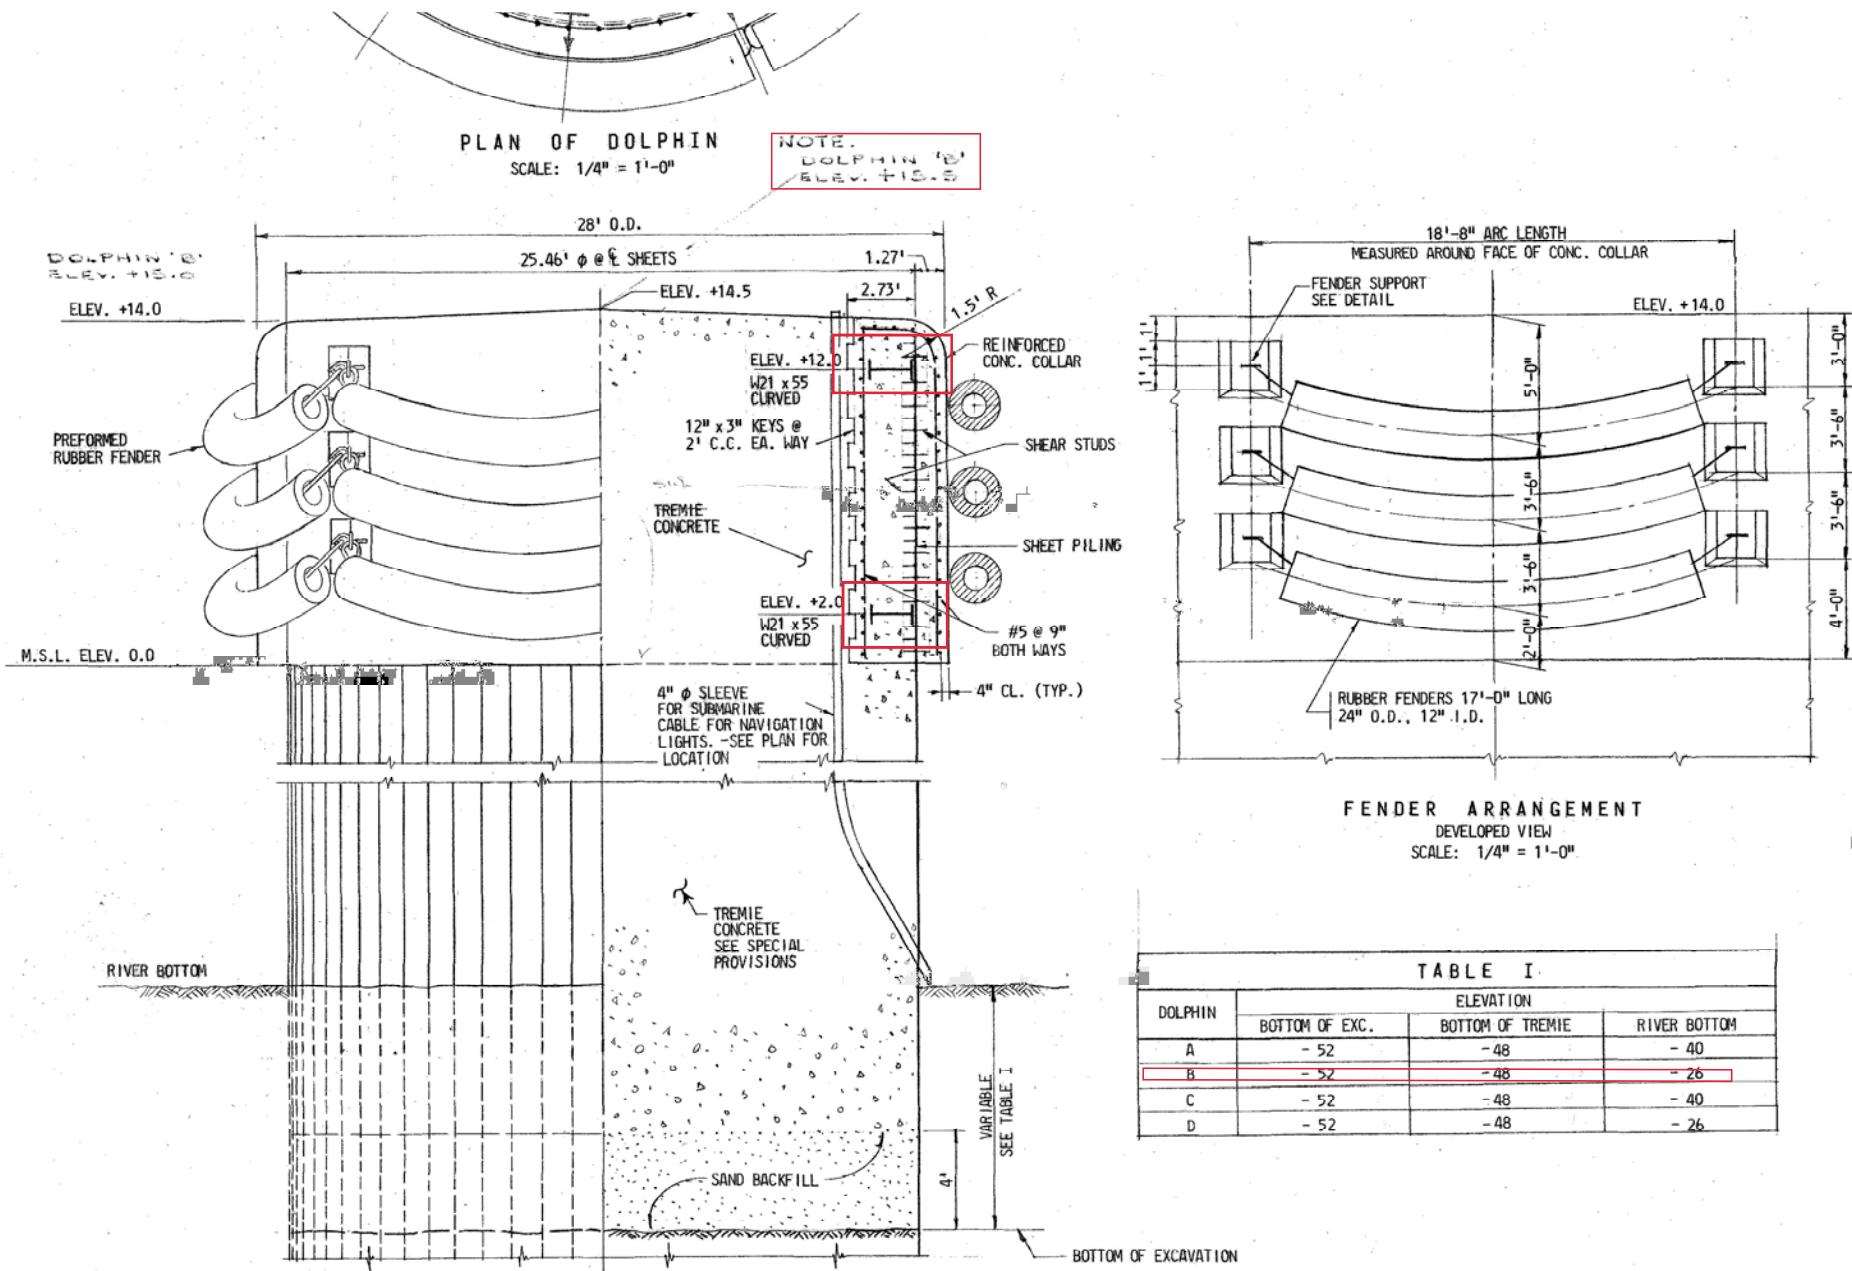



24-WL-0607 and 24-WL-0653

24-WQC-0022


202460906

7/8/2024


16 of 45

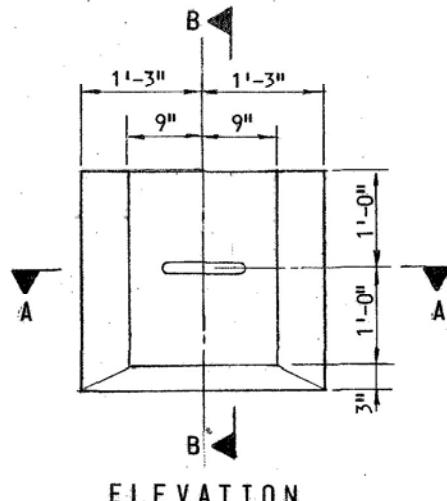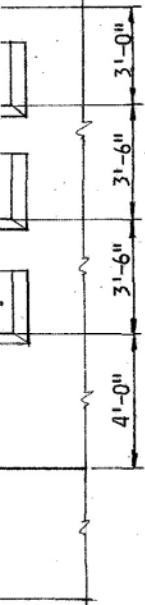


ELEVATION

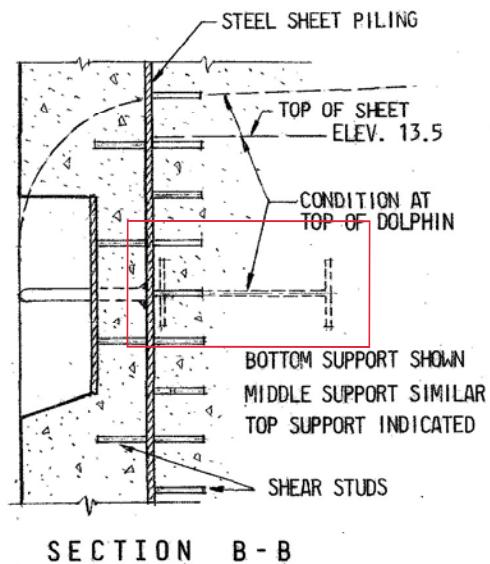

SECTION B-B

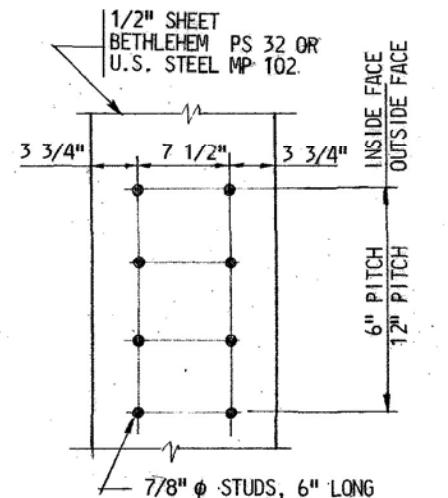

SHEAR STUD PATTERN

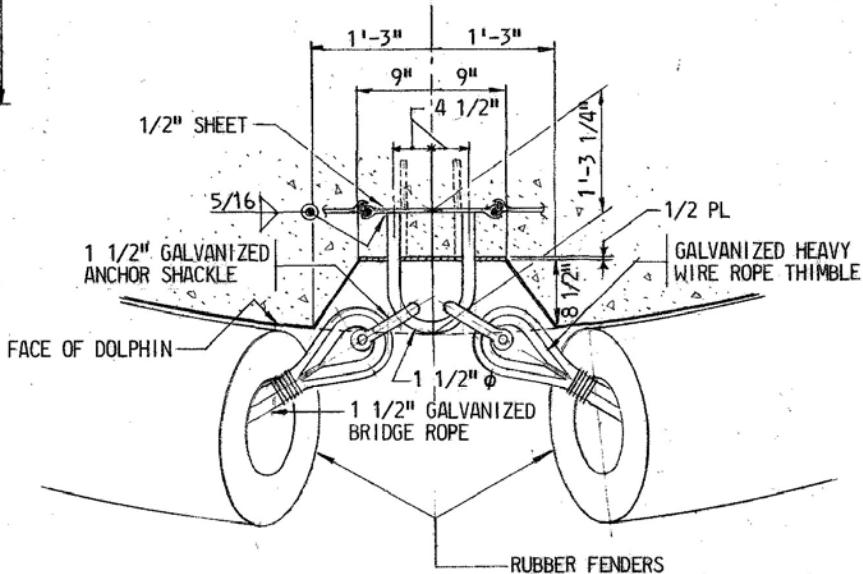

SECTION A-A

NOTES:

FOR GENERAL NOTES SEE DWG. NO. A-102.

THE SHEET PILING SHALL BE DRIVEN AS SPECIFIED.

~~MATERIAL INSIDE THE SHEETING SHALL BE EXCAVATED TO ELEVATIONS INDICATED IN TABLE I.~~
~~All elevations this sheet subject to Note 12 Drawing A-102 Contract #349.~~

AS BUILT

REVISIONS

STATE OF MARYLAND
DEPARTMENT OF TRANSPORTATION
STATE HIGHWAY ADMINISTRATION
BALTIMORE, MD.

BALTIMORE HARBOR OUTER CROSSING

24-WL-0607 and 24-WL-0653



24-WQC-0022

202460906

7/8/2024

17 of 45

2" ϕ WATER MAIN

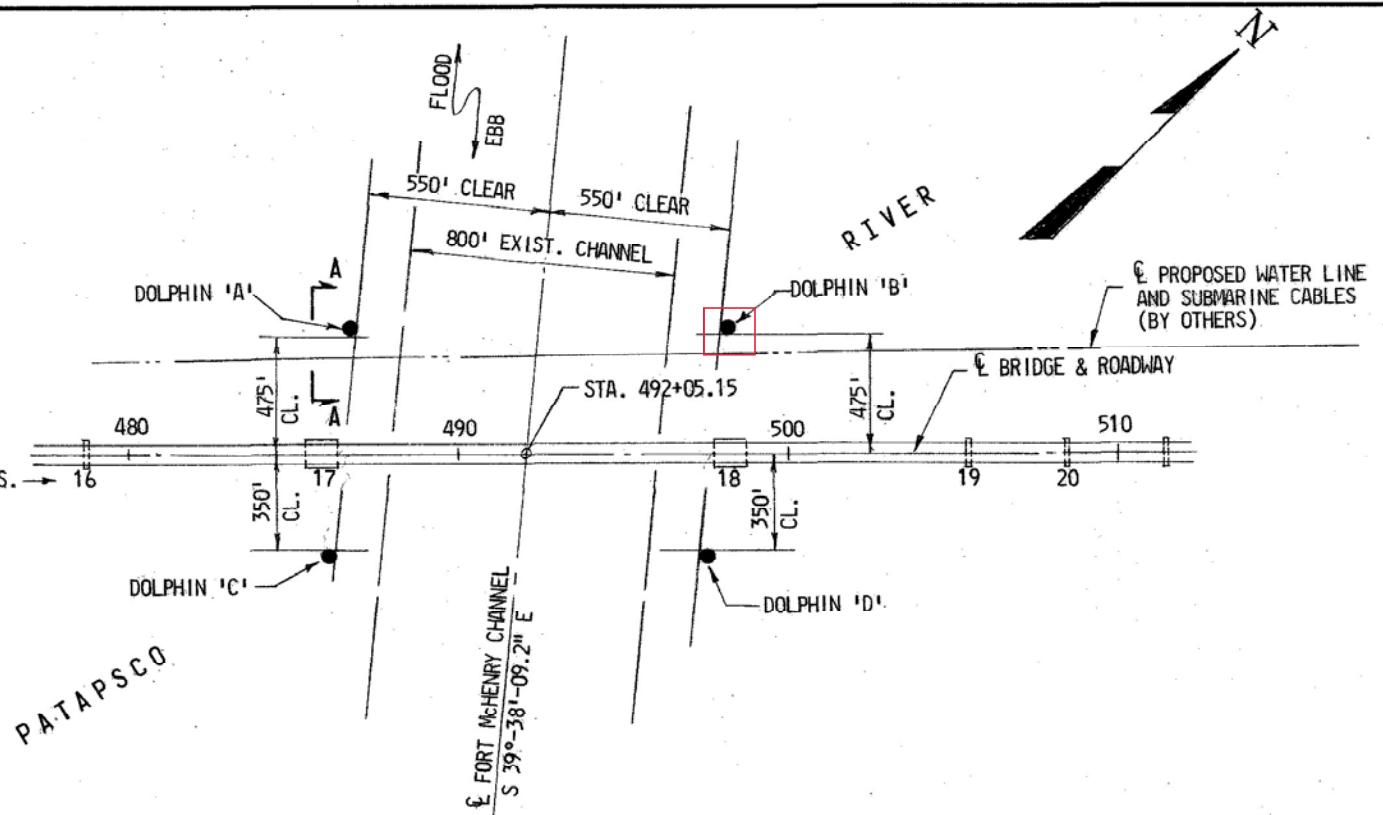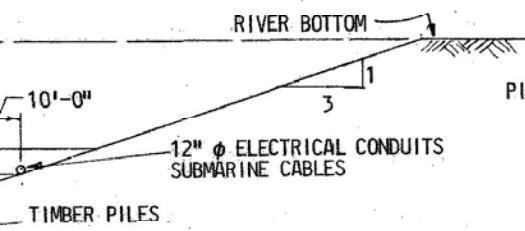

24-WL-0607 and 24-WL-0653

24-WQC-0022


202460906

7/8/2024

18 of 45

1/2" SHEET
BETHLEHEM PS 32 OR
U.S. STEEL MP 102

E FACE
E FACE

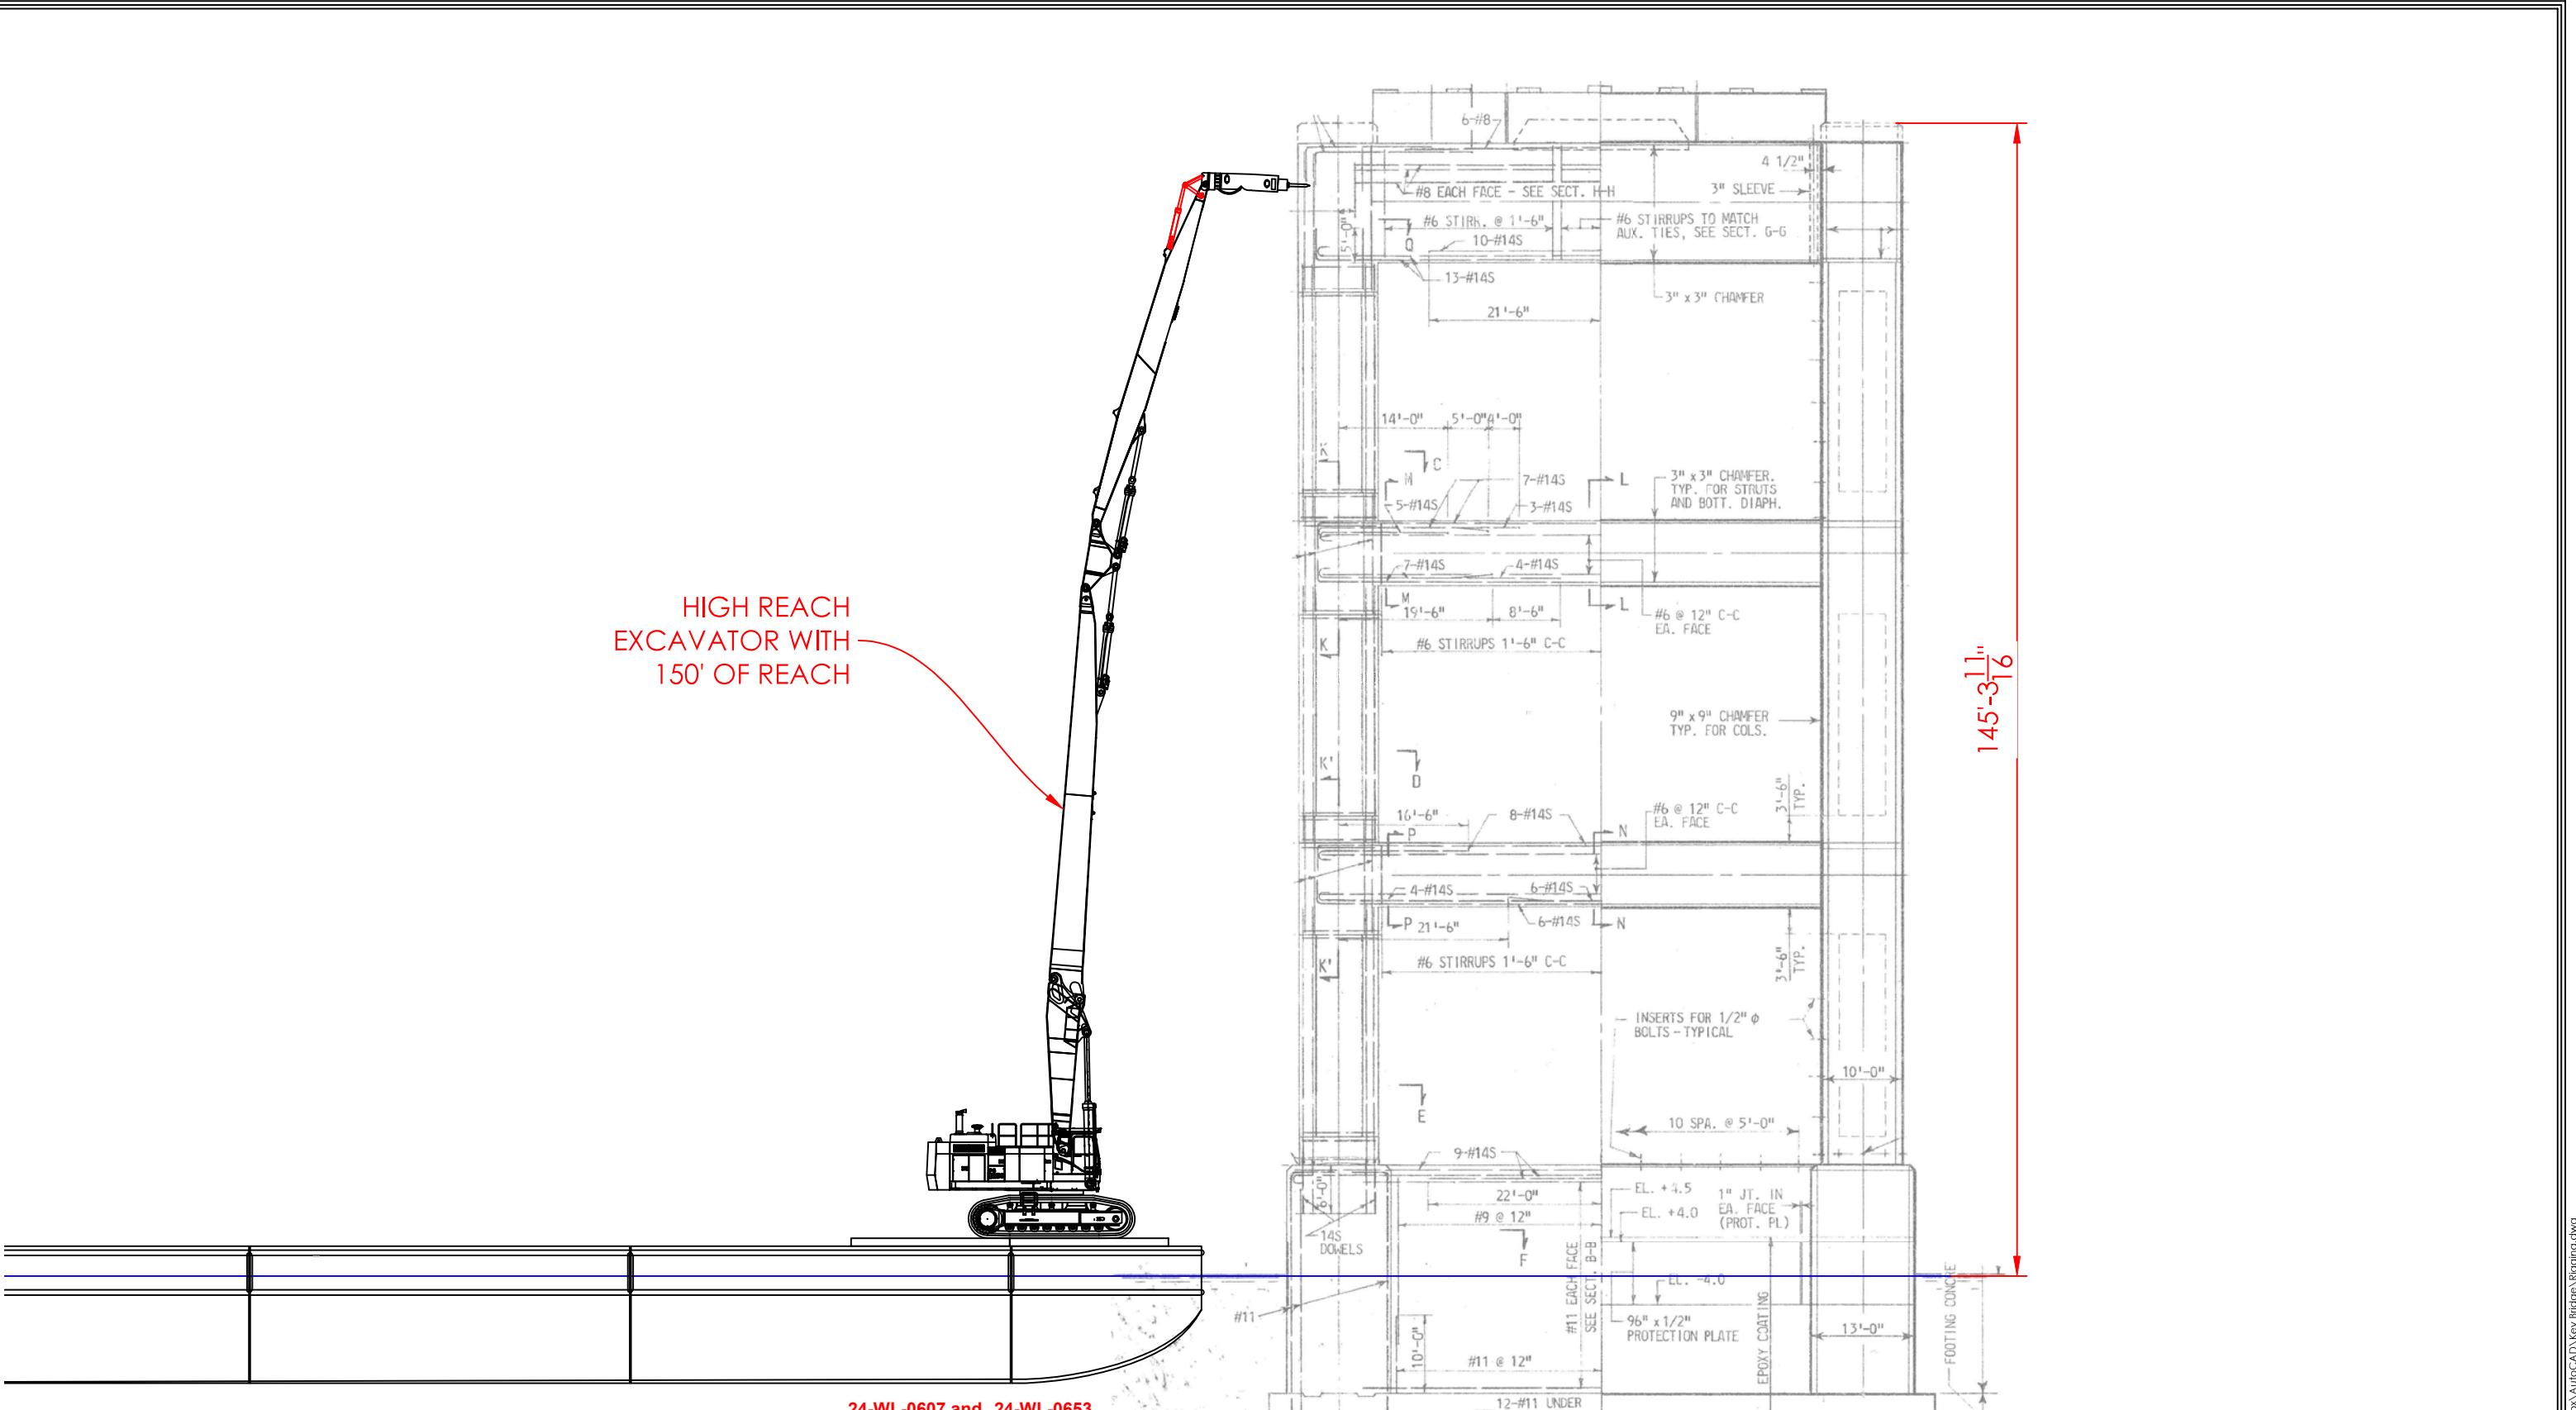

24-WL-0607 and 24-WL-0653
24-WQC-0022
202460906
7/8/2024
19 of 45

SCALE 1" = 20'

IT IS A VIOLATION OF THE PROFESSIONAL LICENSE LAW FOR ANY PERSON TO
ALTER THE DRAWING IN ANY WAY, UNLESS ACTING UNDER THE DIRECTION OF
A LICENSED PROFESSIONAL ENGINEER/ARCHITECT AS APPLICABLE. THE
ALTERING ENGINEER/ARCHITECT SHALL AFFIX HIS/HER SEAL AND THE NOTATION
'ALTERED BY' FOLLOWED BY HIS/HER SIGNATURE AND DATE OF ALTERATION.

OWNER:
MDTA
2310 BROENING HIGHWAY
BALTIMORE, MD 21224

DEMOLITION CONTRACTOR:

DRAFTER

CHECKER

SUPERVISOR

4

3

2

1

0


NO.

DATE


FRANCIS SCOTT KEY BRIDGE
REMAINING DEMOLITION
PIER 16 SHOWN

PIER REMOVAL
HAMMERING

DWG. NO.
D-1

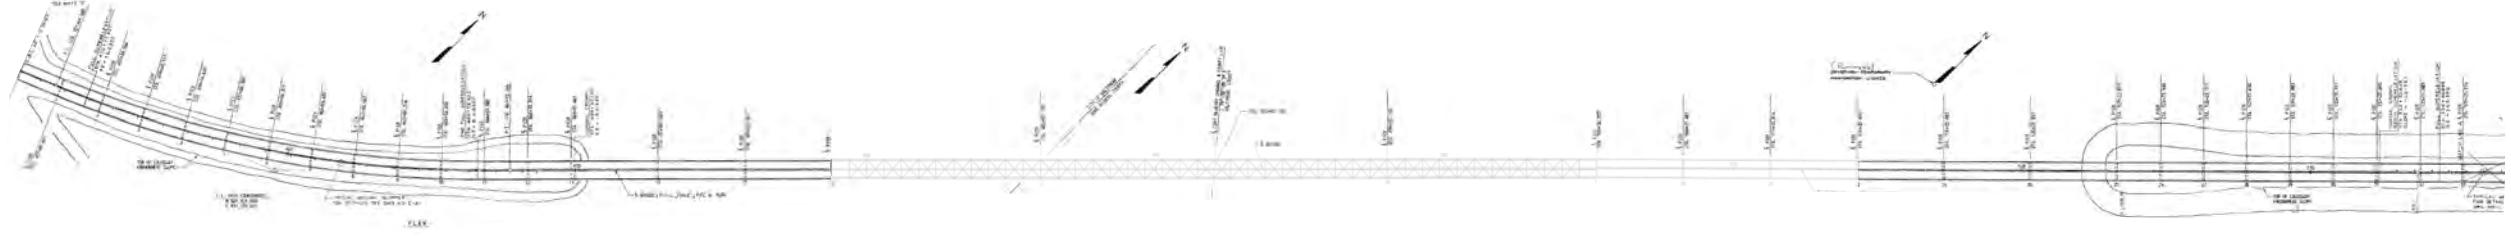

PLAN

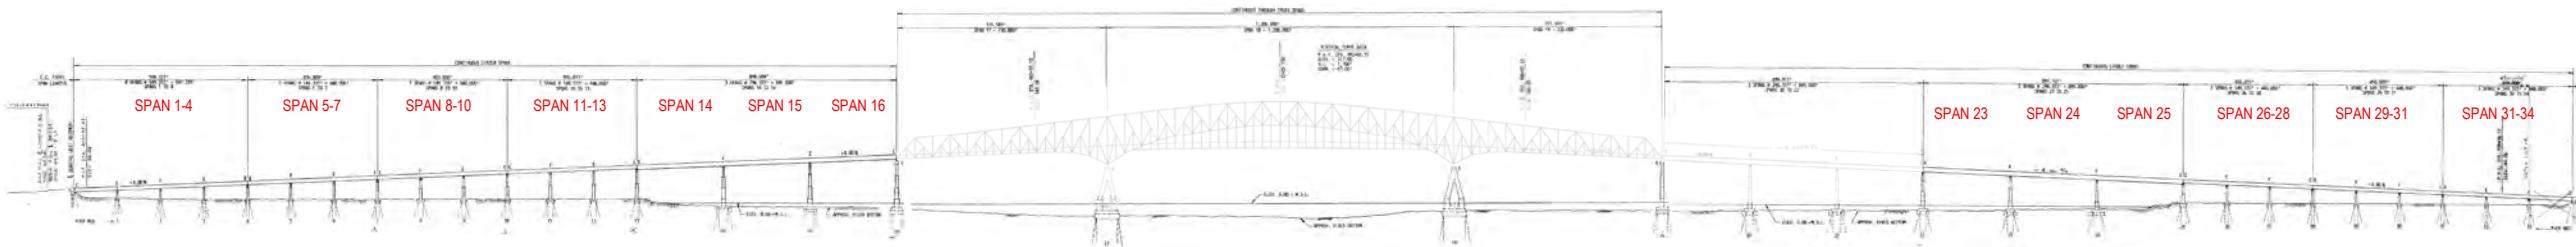



ELEVATION

**PRELIMINARY
NOT FOR CONSTRUCTION**

24-WL-0607 and 24-WL-0653
24-WQC-0022
202460906

△			
△			
△			
NO.	DATE	REMARKS	BY

GENERAL LAYOUT KEY BRIDGE DEMOLITION			
		DRAWN BY	CHCK'D BY
		DATE	
PROJECT	SHEET NO.		

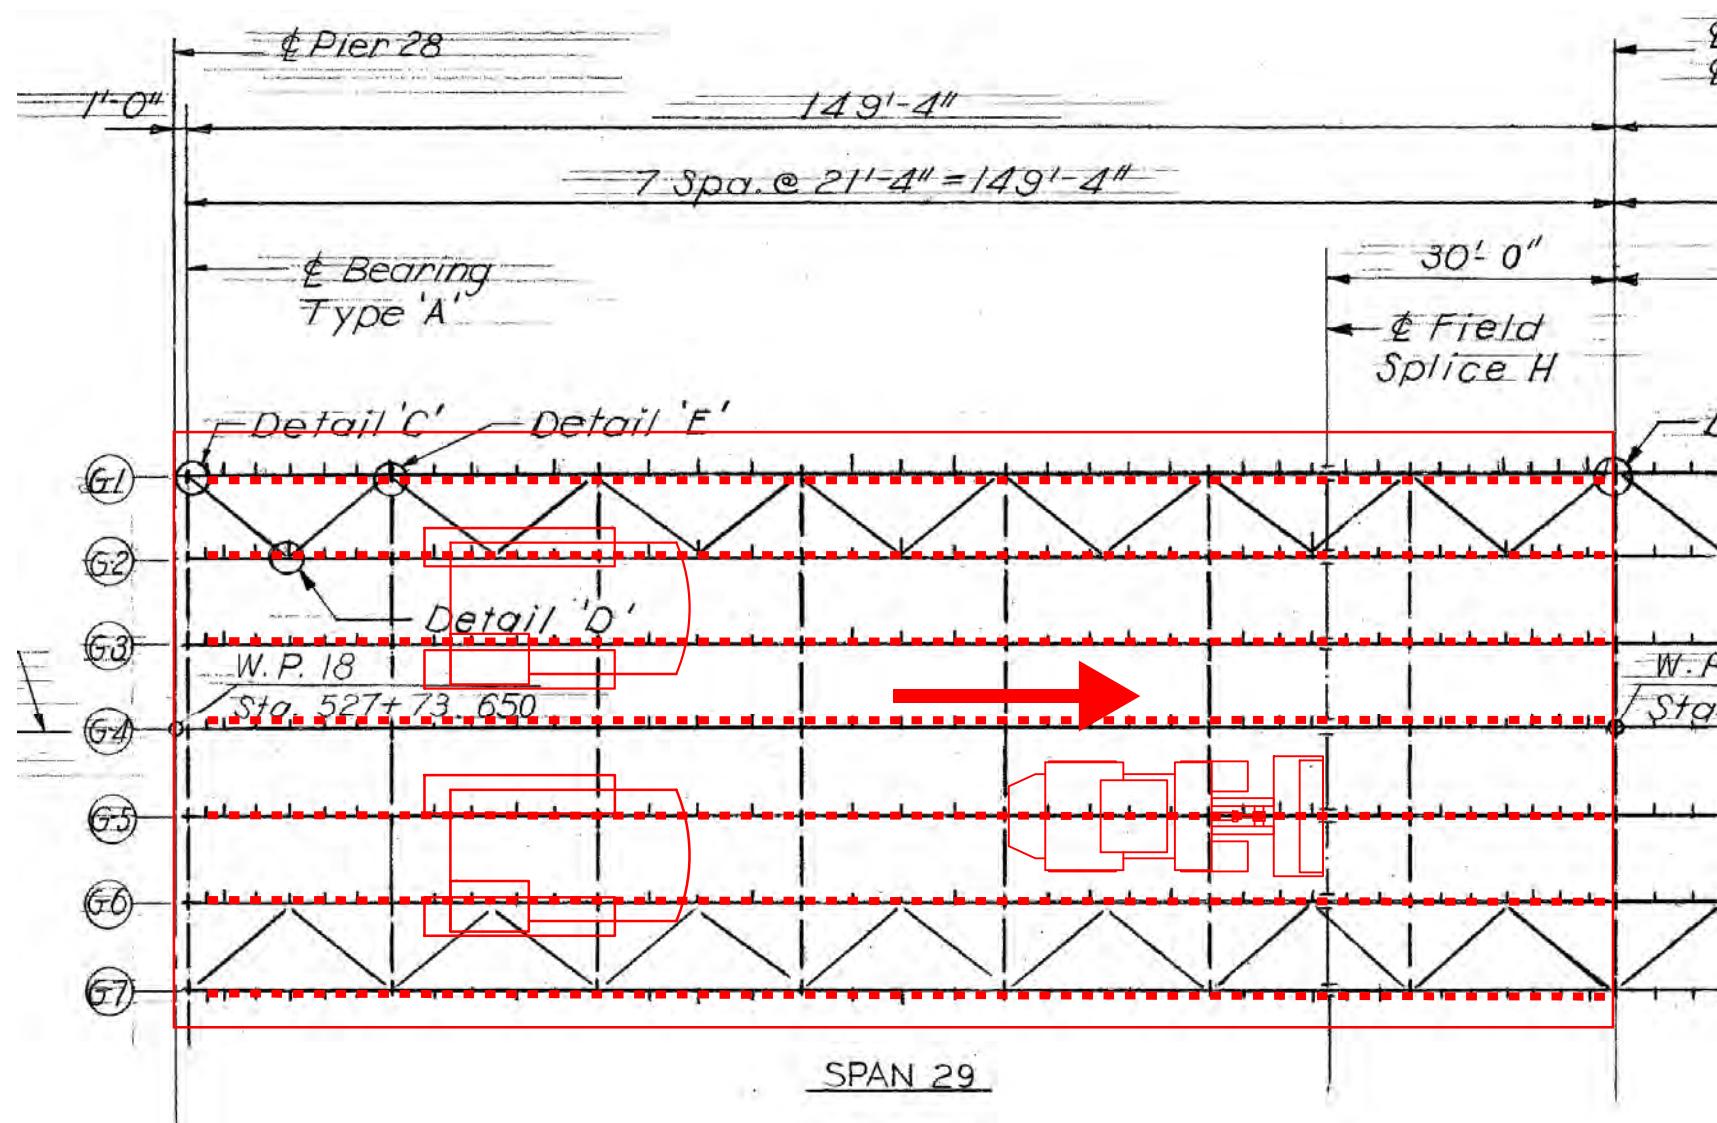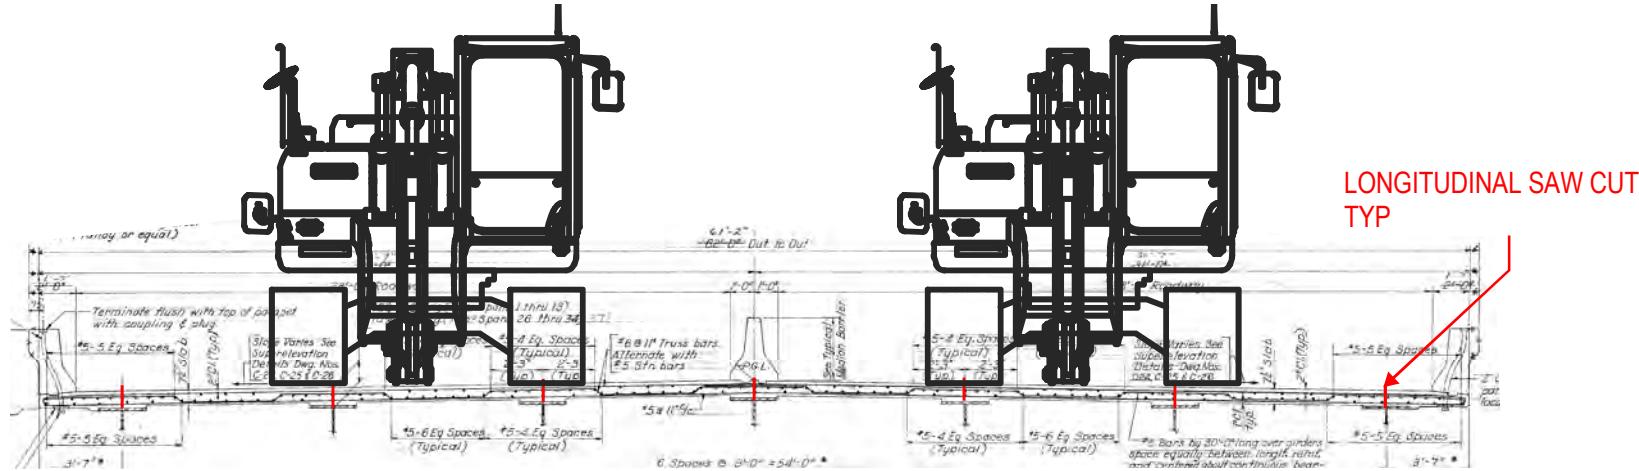

LONGITUDINAL SAW CUT,
TYP

DECK DEMOLITION SEQUENCE
 1. SAW AND REMOVE OVERHANG BARRIER AND DECK
 2. LONGITUDINAL SAW DECK
 3. WITH EXCAVATOR, PULL BACK SECTION OF DECK,
 CUT/BREAK REBAR, HAUL PANEL OFF DECK WITH
 LOADER

REPEAT FOR ENTIRE DECK

PRELIMINARY
NOT FOR CONSTRUCTION

24-WL-0607 and 24-WL-0653
24-WQC-0022
202460906

7/8/2024
21 of 45

△			
△			
△			
NO.	DATE	REMARKS	BY

GENERAL DECK DEMOLITION
KEY BRIDGE DEMOLITION

DRAWN BY CHCK'D BY

DATE

PROJECT


SHEET NO.

SPAN 23

SPAN 24

SPAN 25

STEP 1 -
CUT CROSSFRAMES BETWEEN G6 & G5
HOIST G6&G7. APPROX WT = 100 TNS

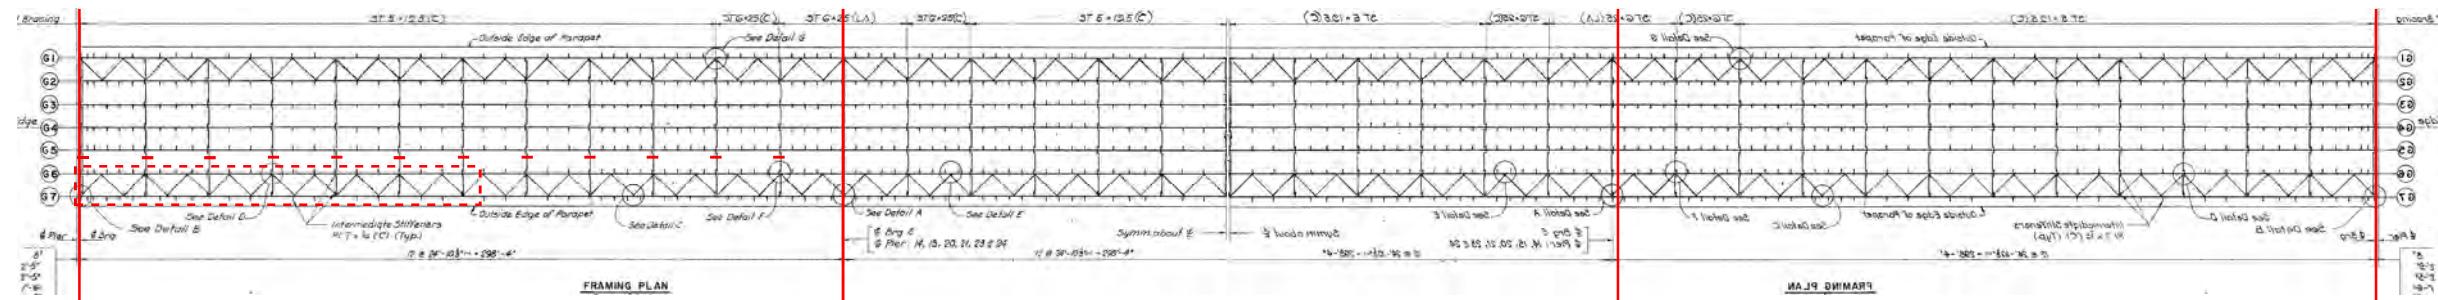


SPAN 23

SPAN 24

SPAN 25

STEP 2 -
CUT CROSSFRAMES BETWEEN G6 & G5
HOIST G6&G7. APPROX WT = 75 TNS

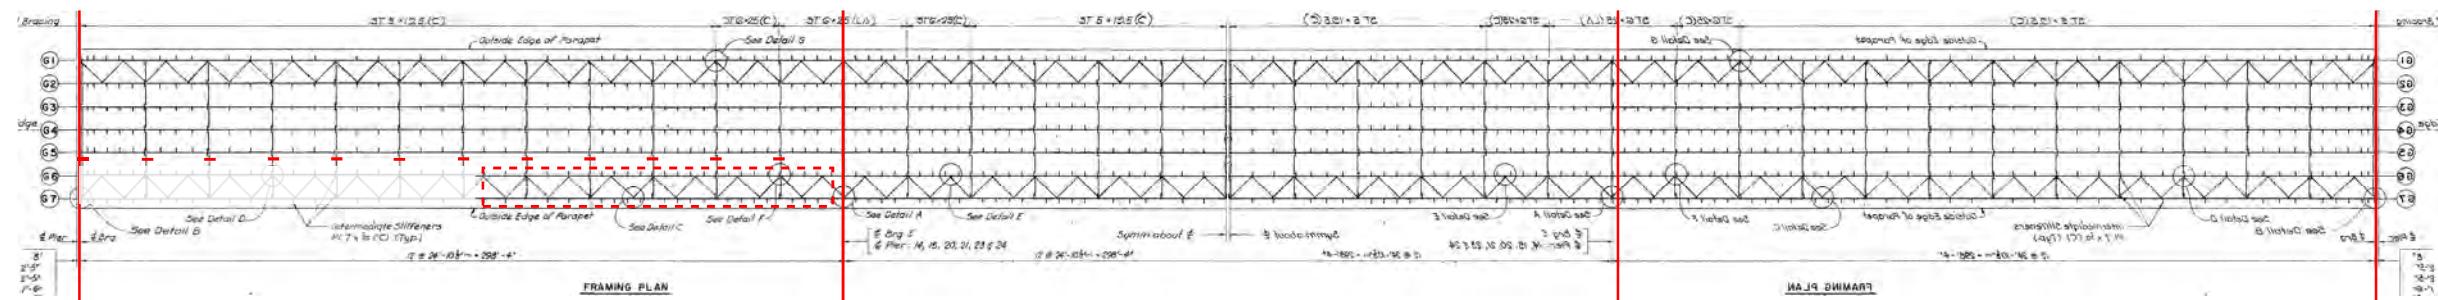


SPAN 23

SPAN 24

SPAN 25

STEP 3 -
CUT CROSSFRAMES BETWEEN G3 & G4
HOIST G4&G5. APPROX WT = 100 TNS

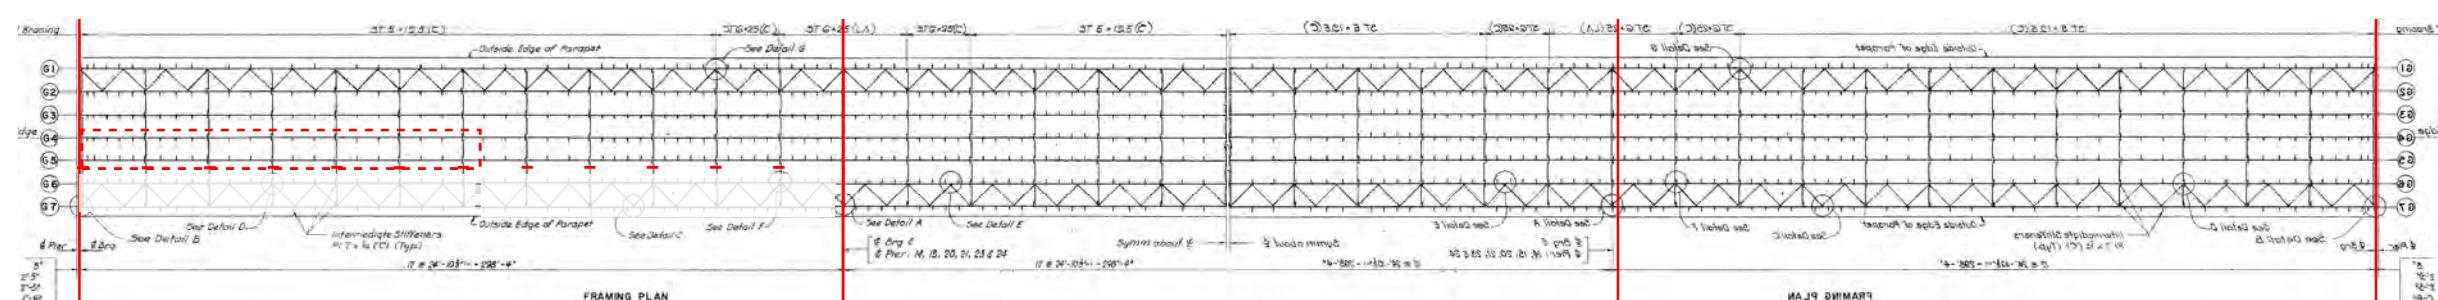


SPAN 23

SPAN 24

SPAN 25

STEP 4 -
CUT CROSSFRAMES BETWEEN G3 & G4
HOIST G4&G5. APPROX WT = 75 TNS

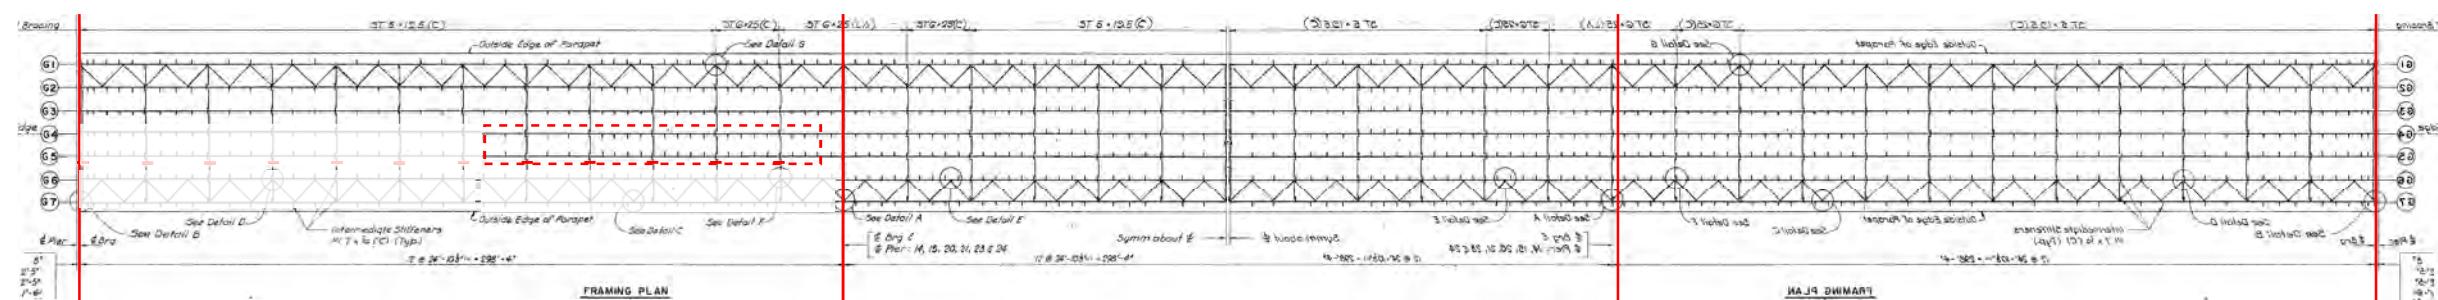

PRELIMINARY
NOT FOR CONSTRUCTION

24-WL-0607 and 24-WL-0653
 24-WQC-0022
 202460906


PROJECT	SHEET NO.


STEEL DEMOLITION SPANS 23-25
KEY BRIDGE DEMOLITION


DRAWN BY CHCK'D BY

DATE


SHEET NO.

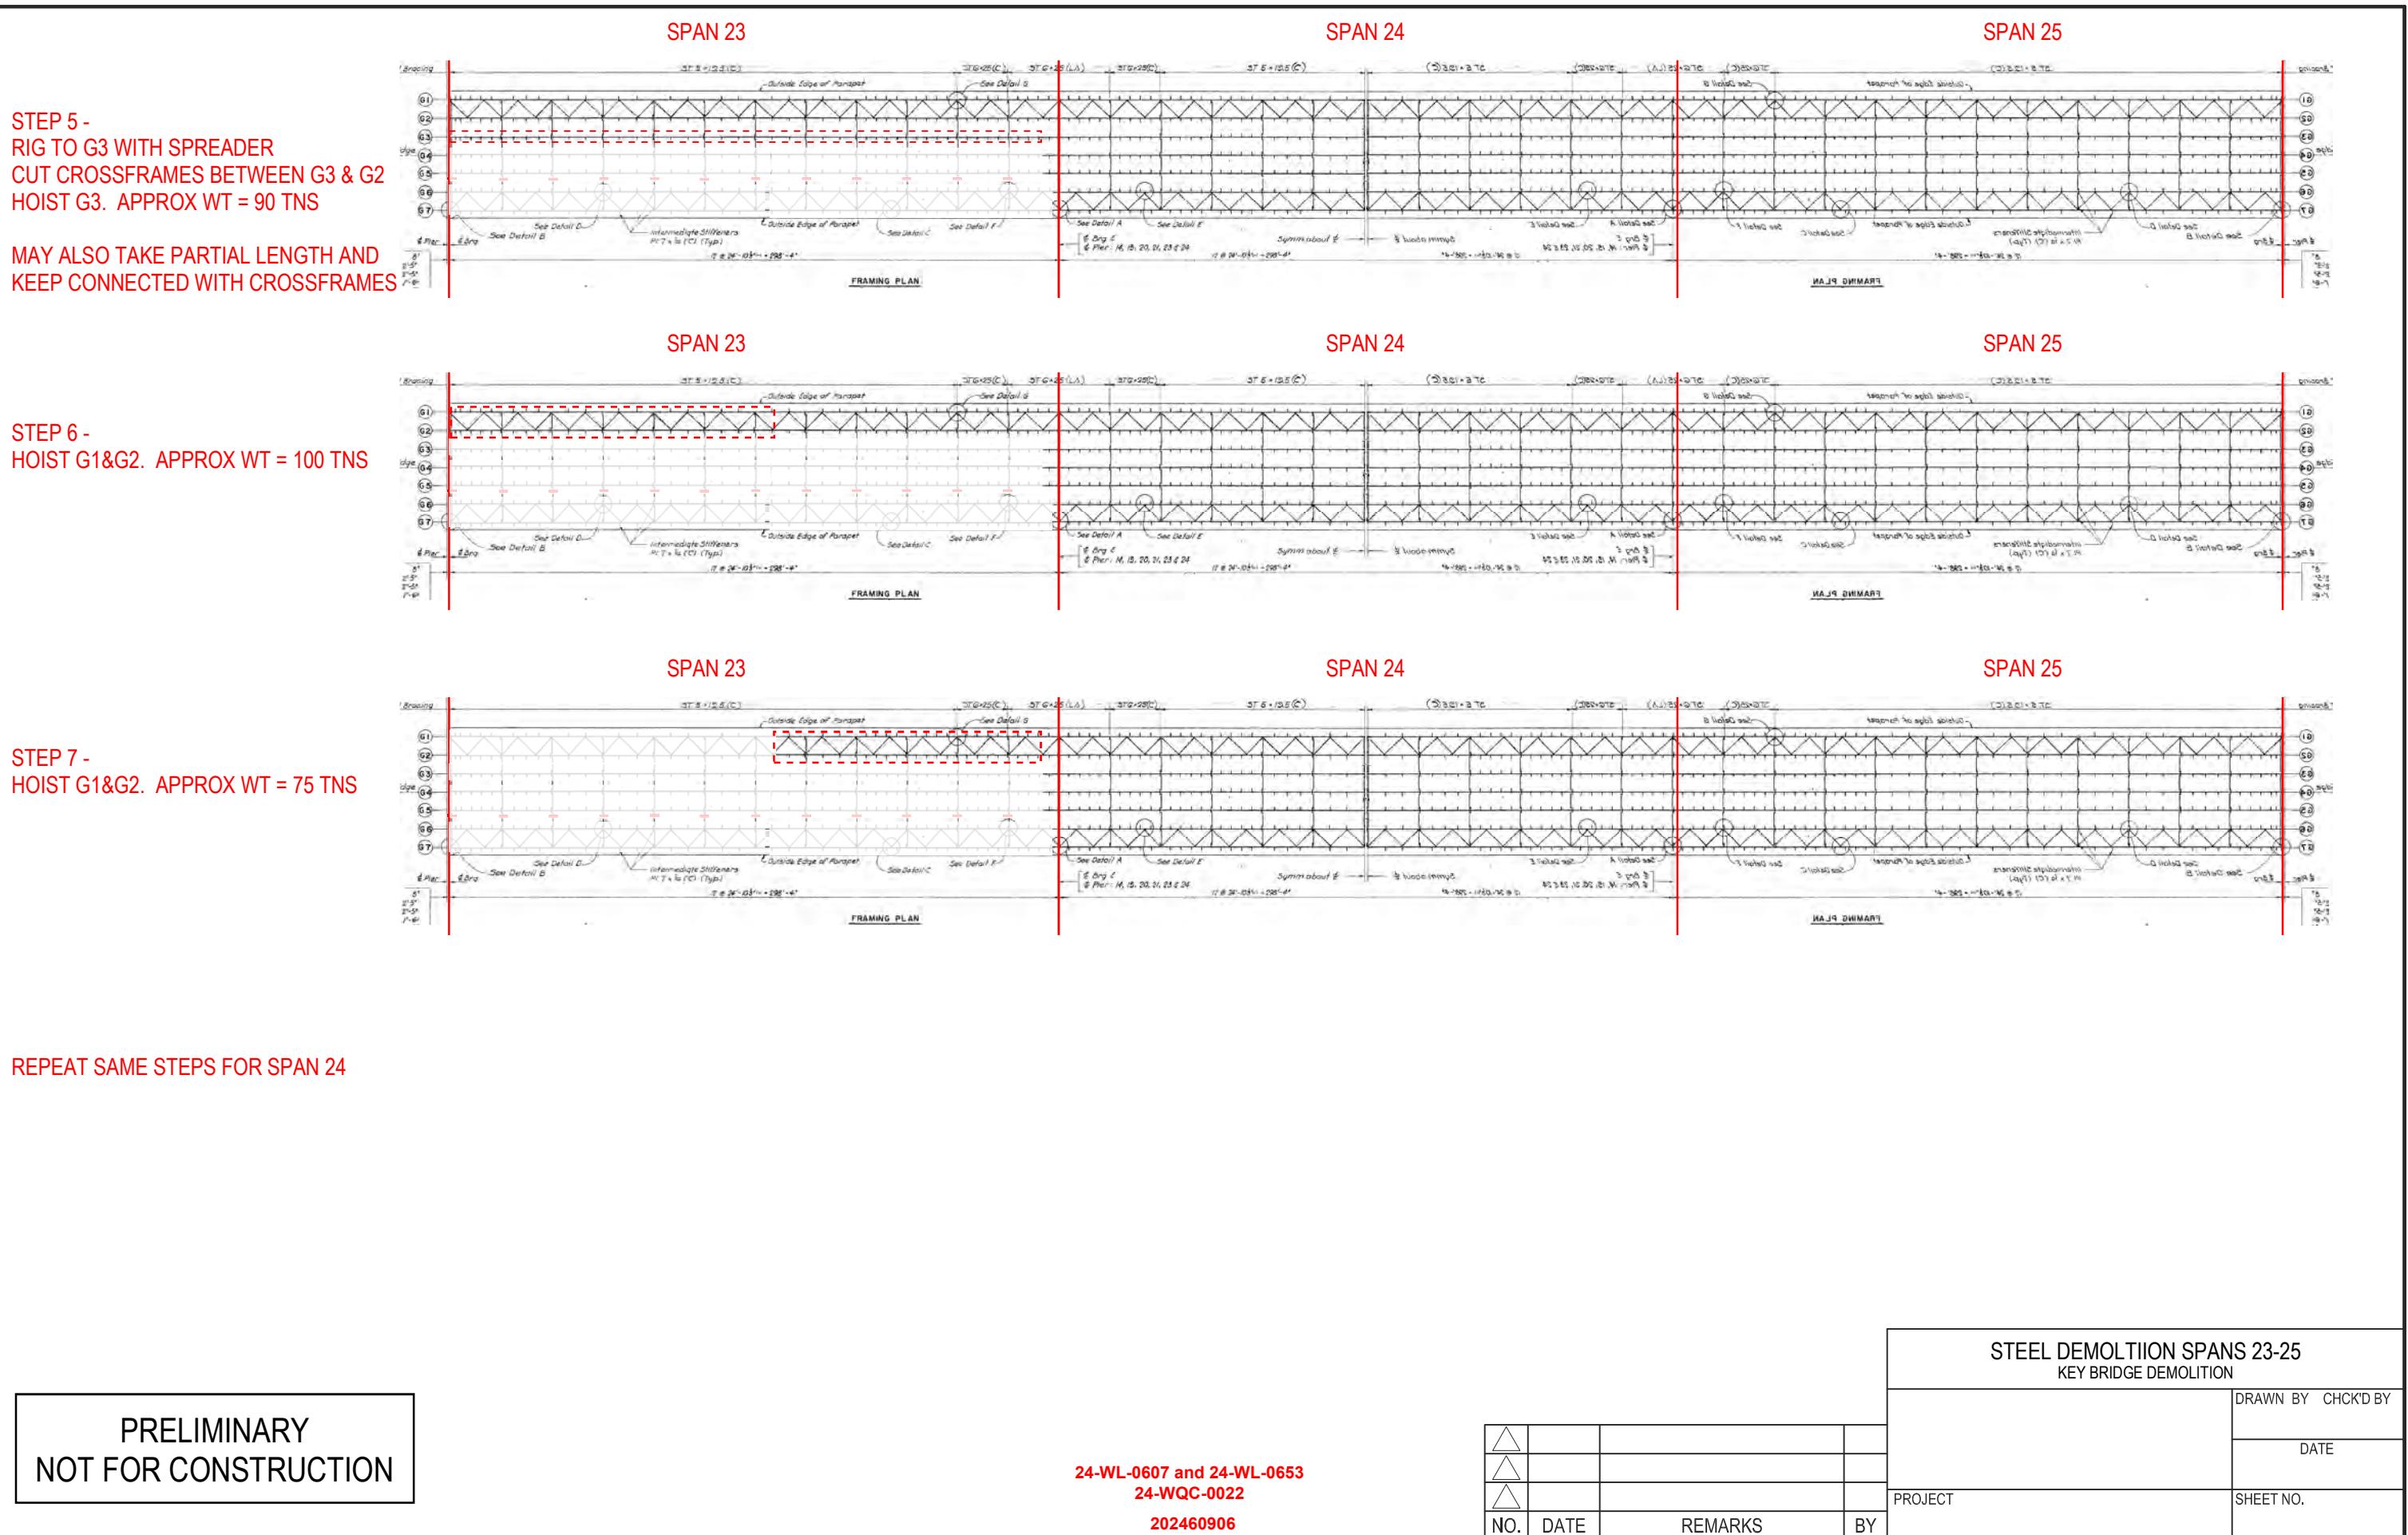

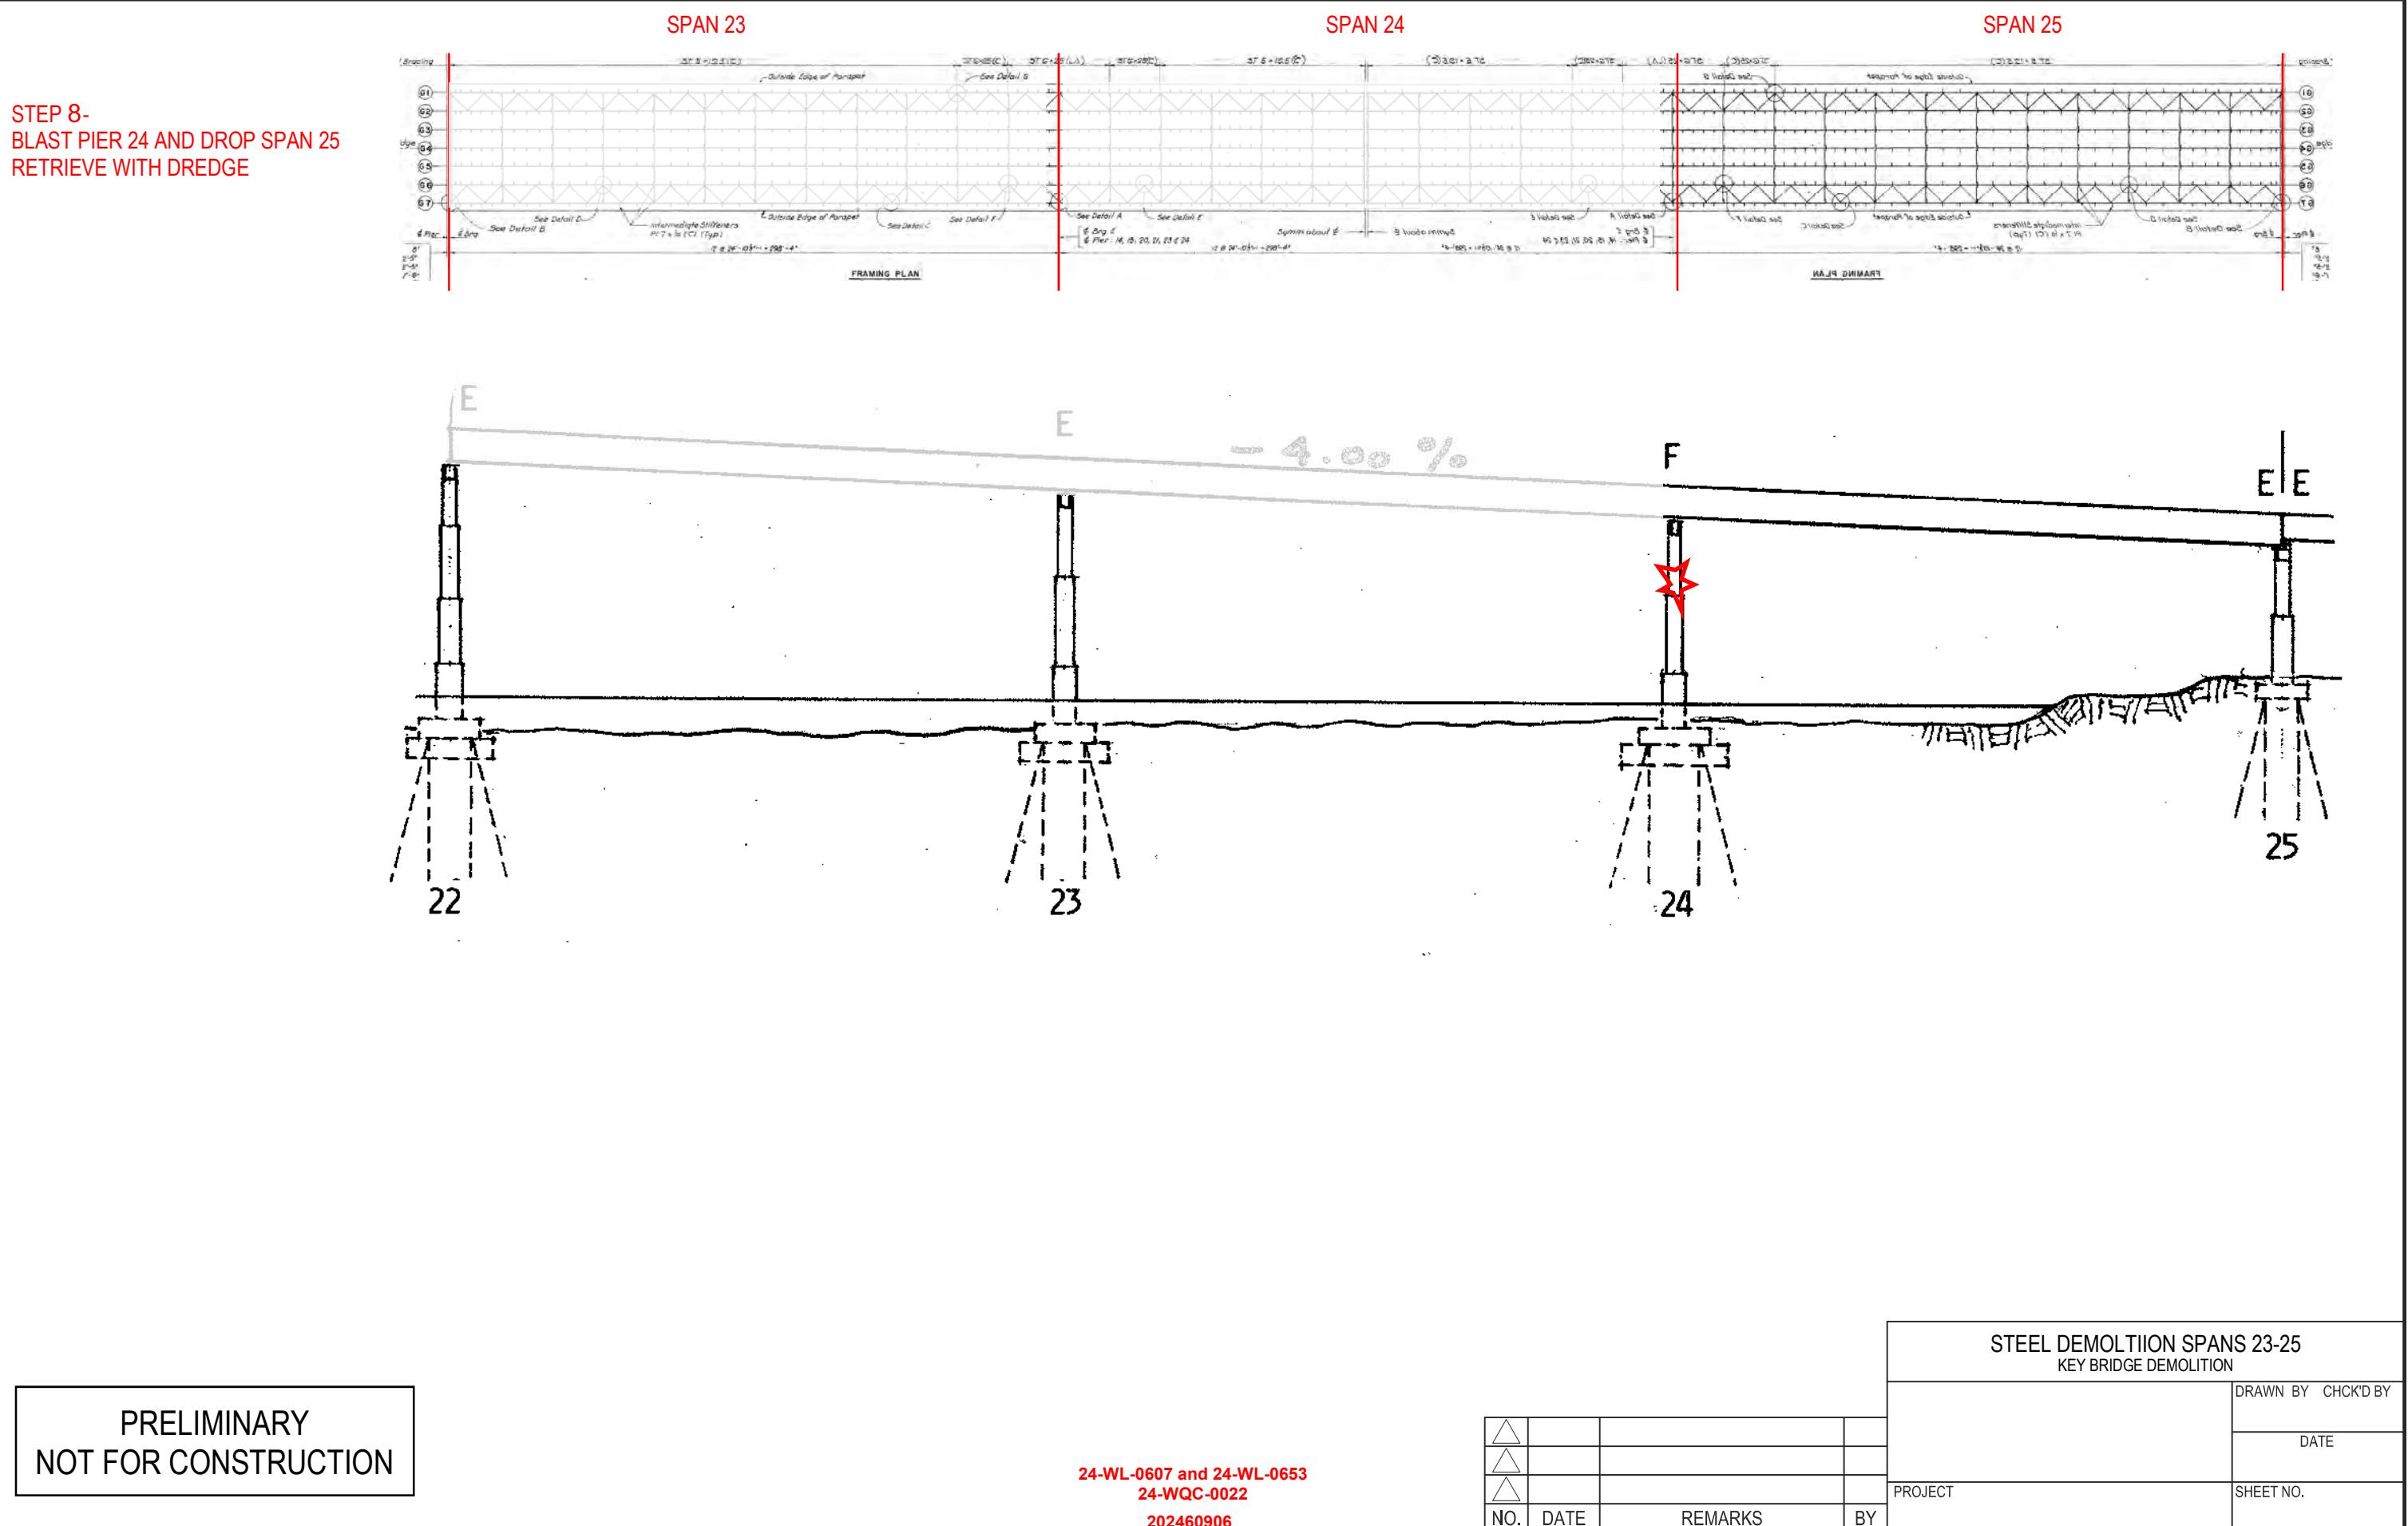

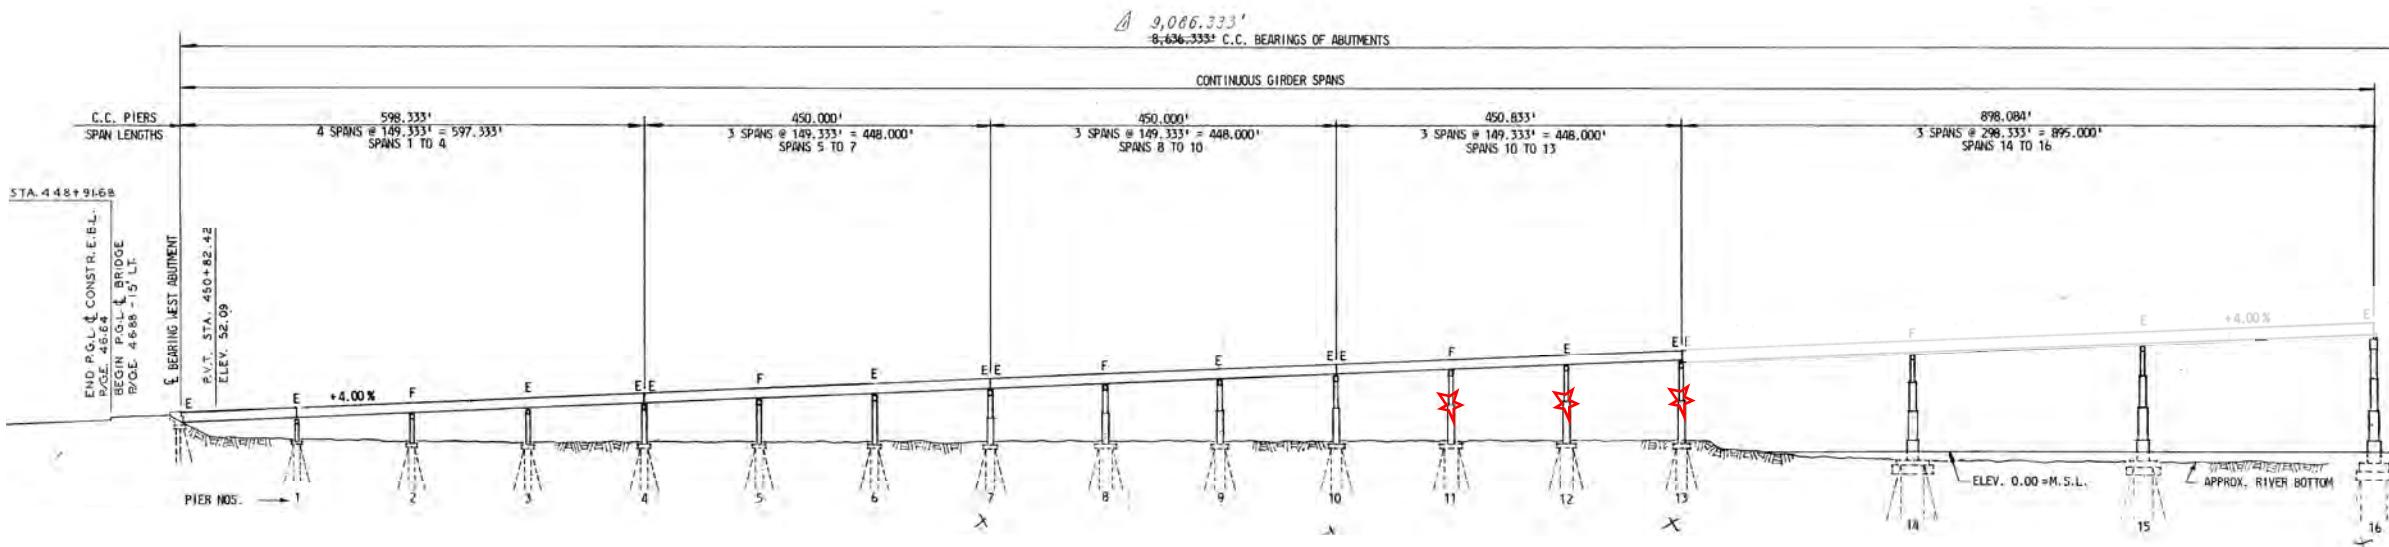

STEP 1
BLAST PIERS 11, 12, 13 TO
DROP SPANS 11, 12, & 13
RETRIEVE WITH DREDGE

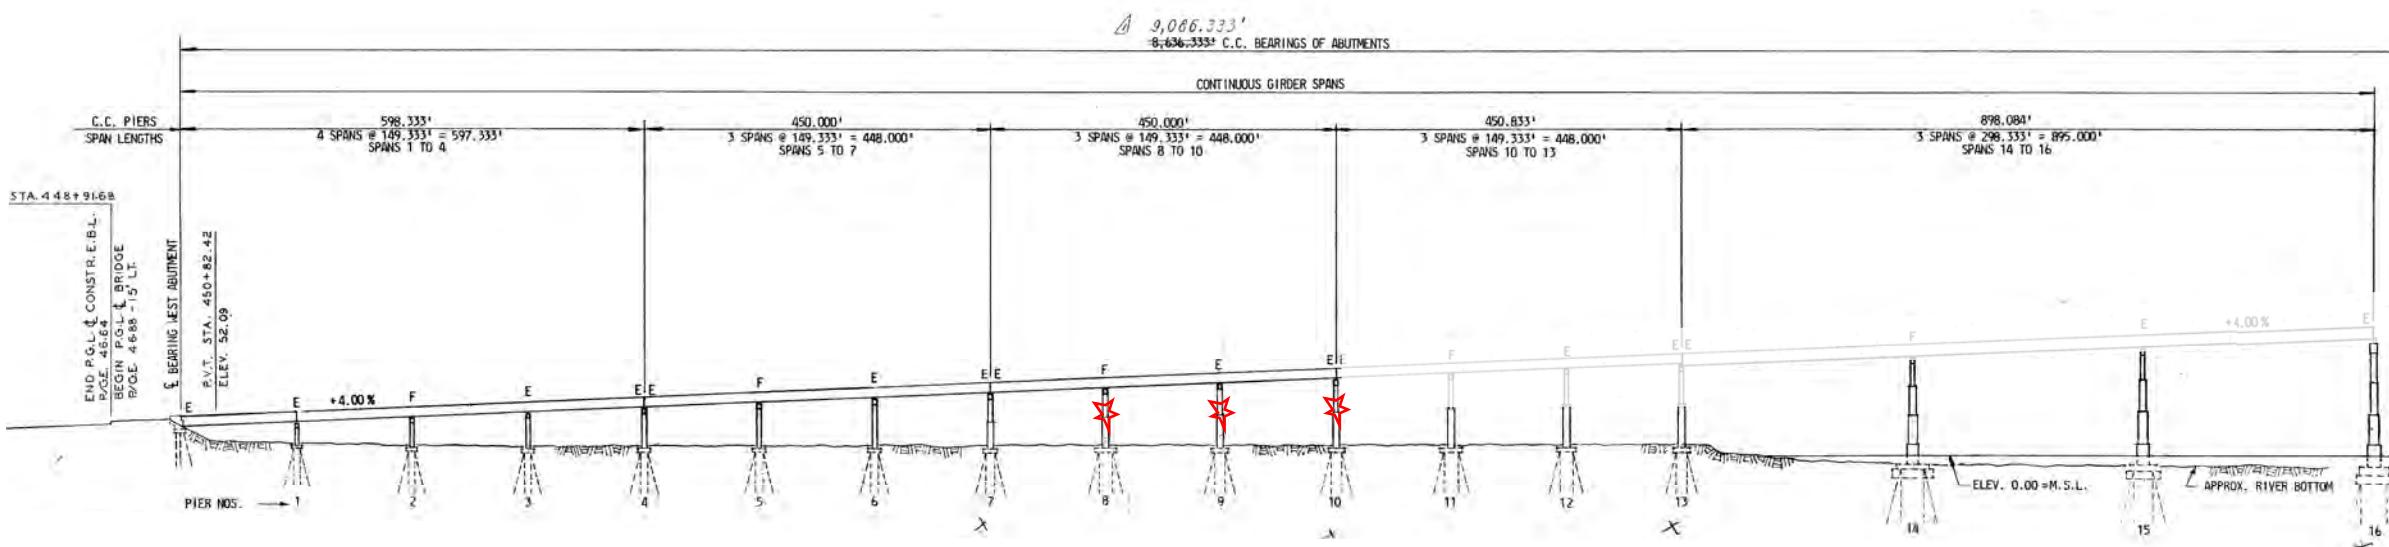

STEP 2
BLAST PIERS 8, 9, 10 TO
DROP SPANS 8, 9, & 10
RETRIEVE WITH DREDGE

REPEAT FOR ALL REMAINING
APPROACH SPANS

SIMILAR FOR SPANS 26 - 34

24-WL-0607 and 24-WL-0653

24-WQC-0022

202460906

PRELIMINARY
NOT FOR CONSTRUCTION

STEEL DEMOLITION SPANS 1-13
KEY BRIDGE DEMOLITION


DRAWN BY CHCK'D BY

DATE

PROJECT

SHEET NO.

△			
△			
△			
NO.	DATE	REMARKS	BY

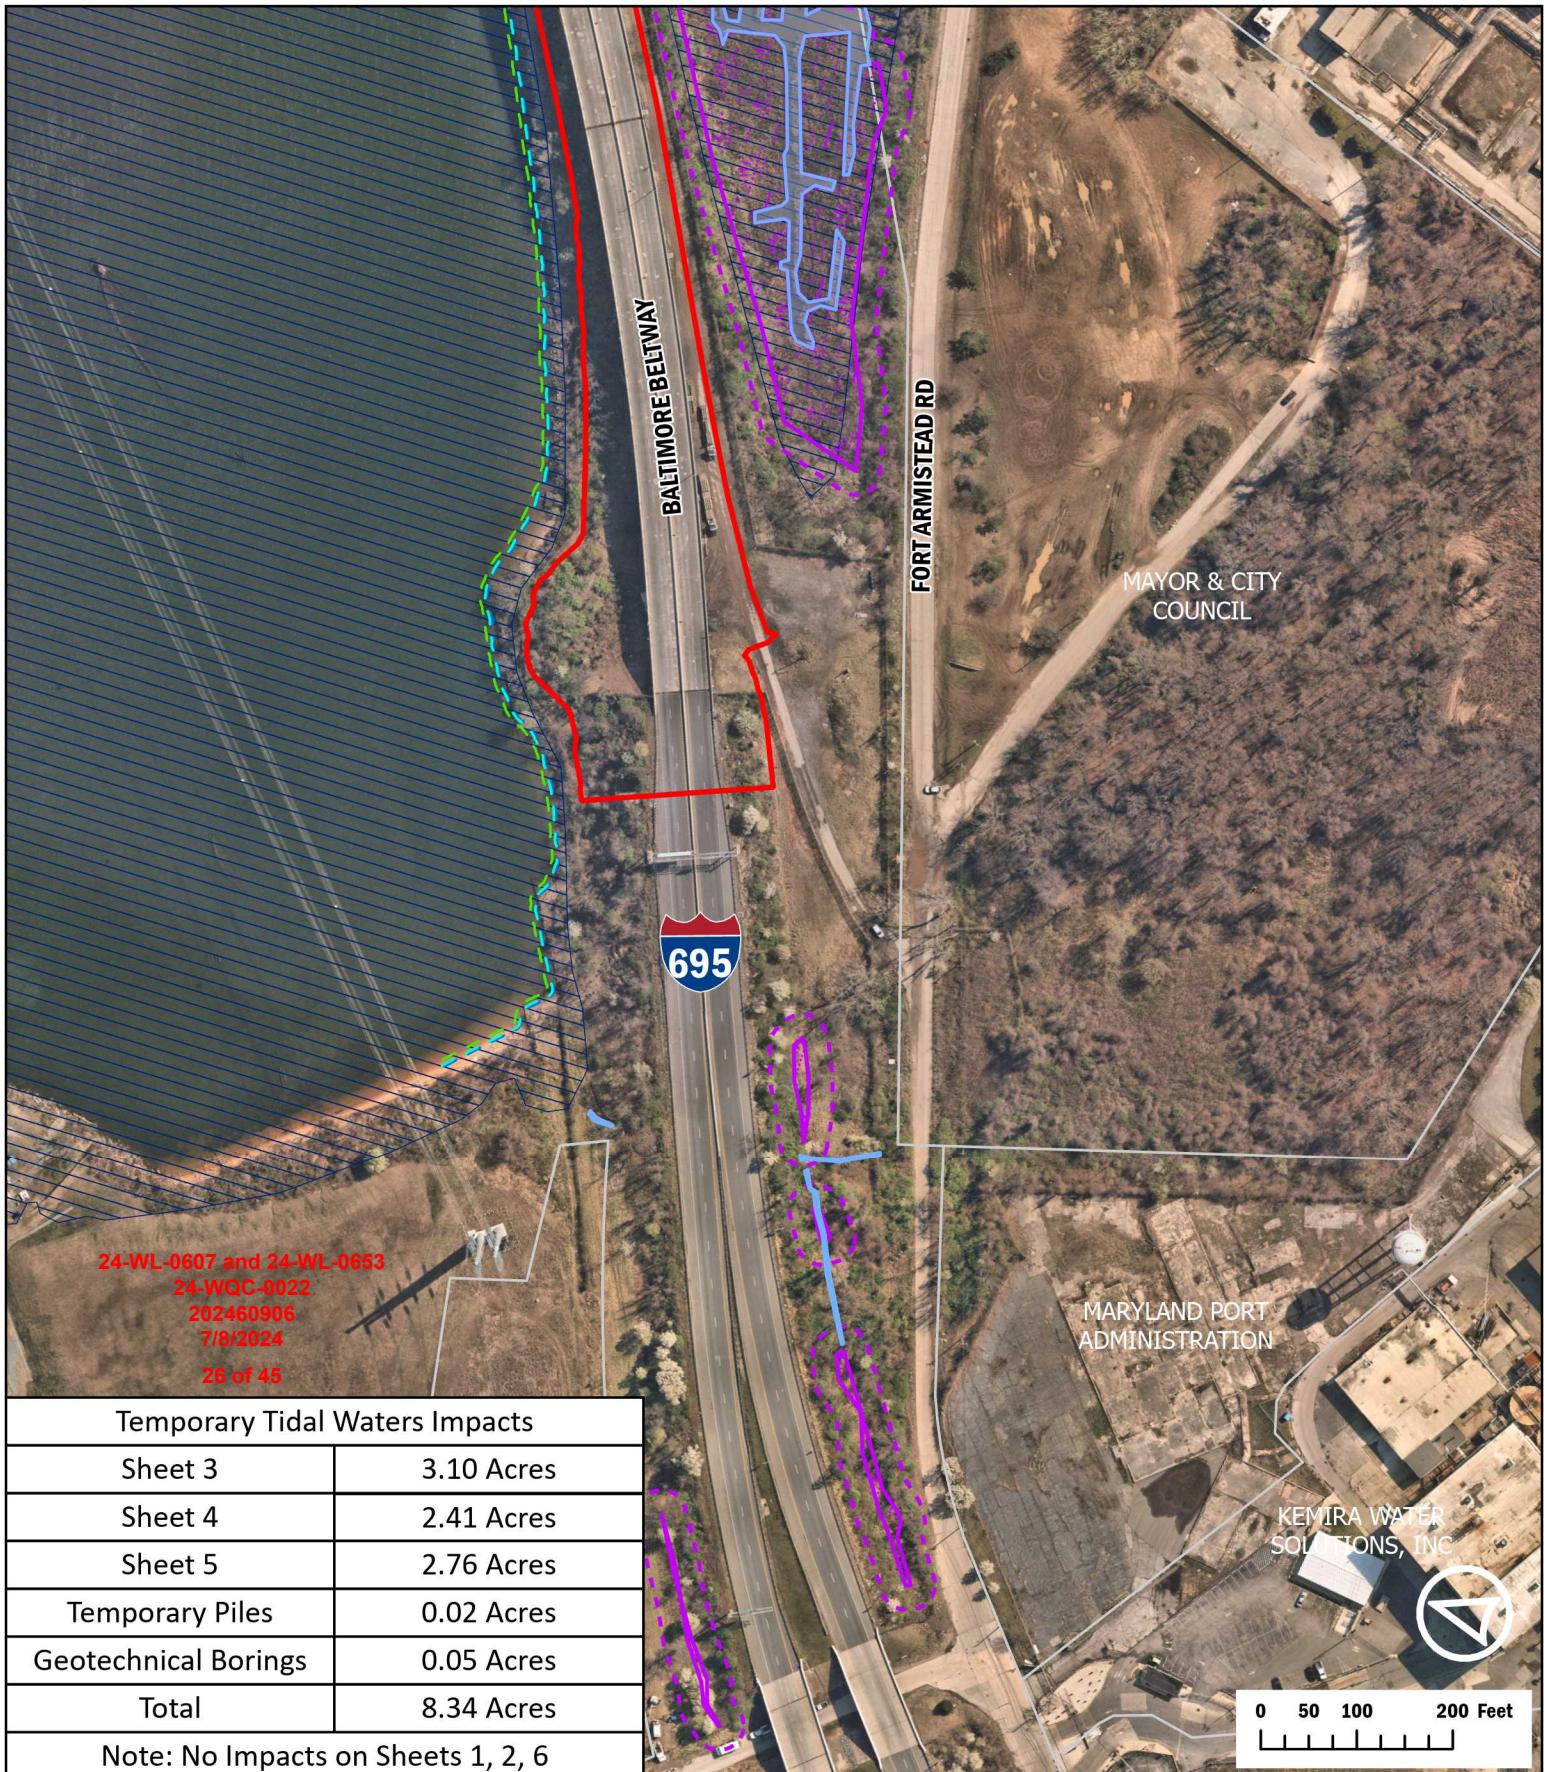

	Limits of Disturbance
	Potential Temporary Pile Area
	Streams
	Wetlands
	25ft Wetland Buffer
	100-Year Floodplain
	Approximate MLW Line
	MHHW Line
	MHW Line
	Property Parcels
	Municipal Boundaries



**Francis Scott Key
Bridge
Demolition
Impact Plates**

**POTENTIAL
TEMPORARY
PILE AND SOIL
BORING AREA**

695

BALTIMORE BELTWAY

E BELTWAY

Patapsco River

Fort Armistead
Park

MAYOR & CITY
COUNCIL

24-WL-0607 and 24-WL-0653
24-WQC-0022
202460906
7/8/2024
27 of 45

MARYLAND PORT
ADMINISTRATION




0 50 100 200 Feet

■ Limits of Disturbance	— Approximate MLW Line
■ Potential Temporary Pile Area	— MHHW Line
■ Streams	— MHW Line
■ Wetlands	■ Property Parcels
■ 25ft Wetland Buffer	■ Municipal Boundaries
■ 100-Year Floodplain	




**Francis Scott Key
Bridge
Demolition
Impact Plates**

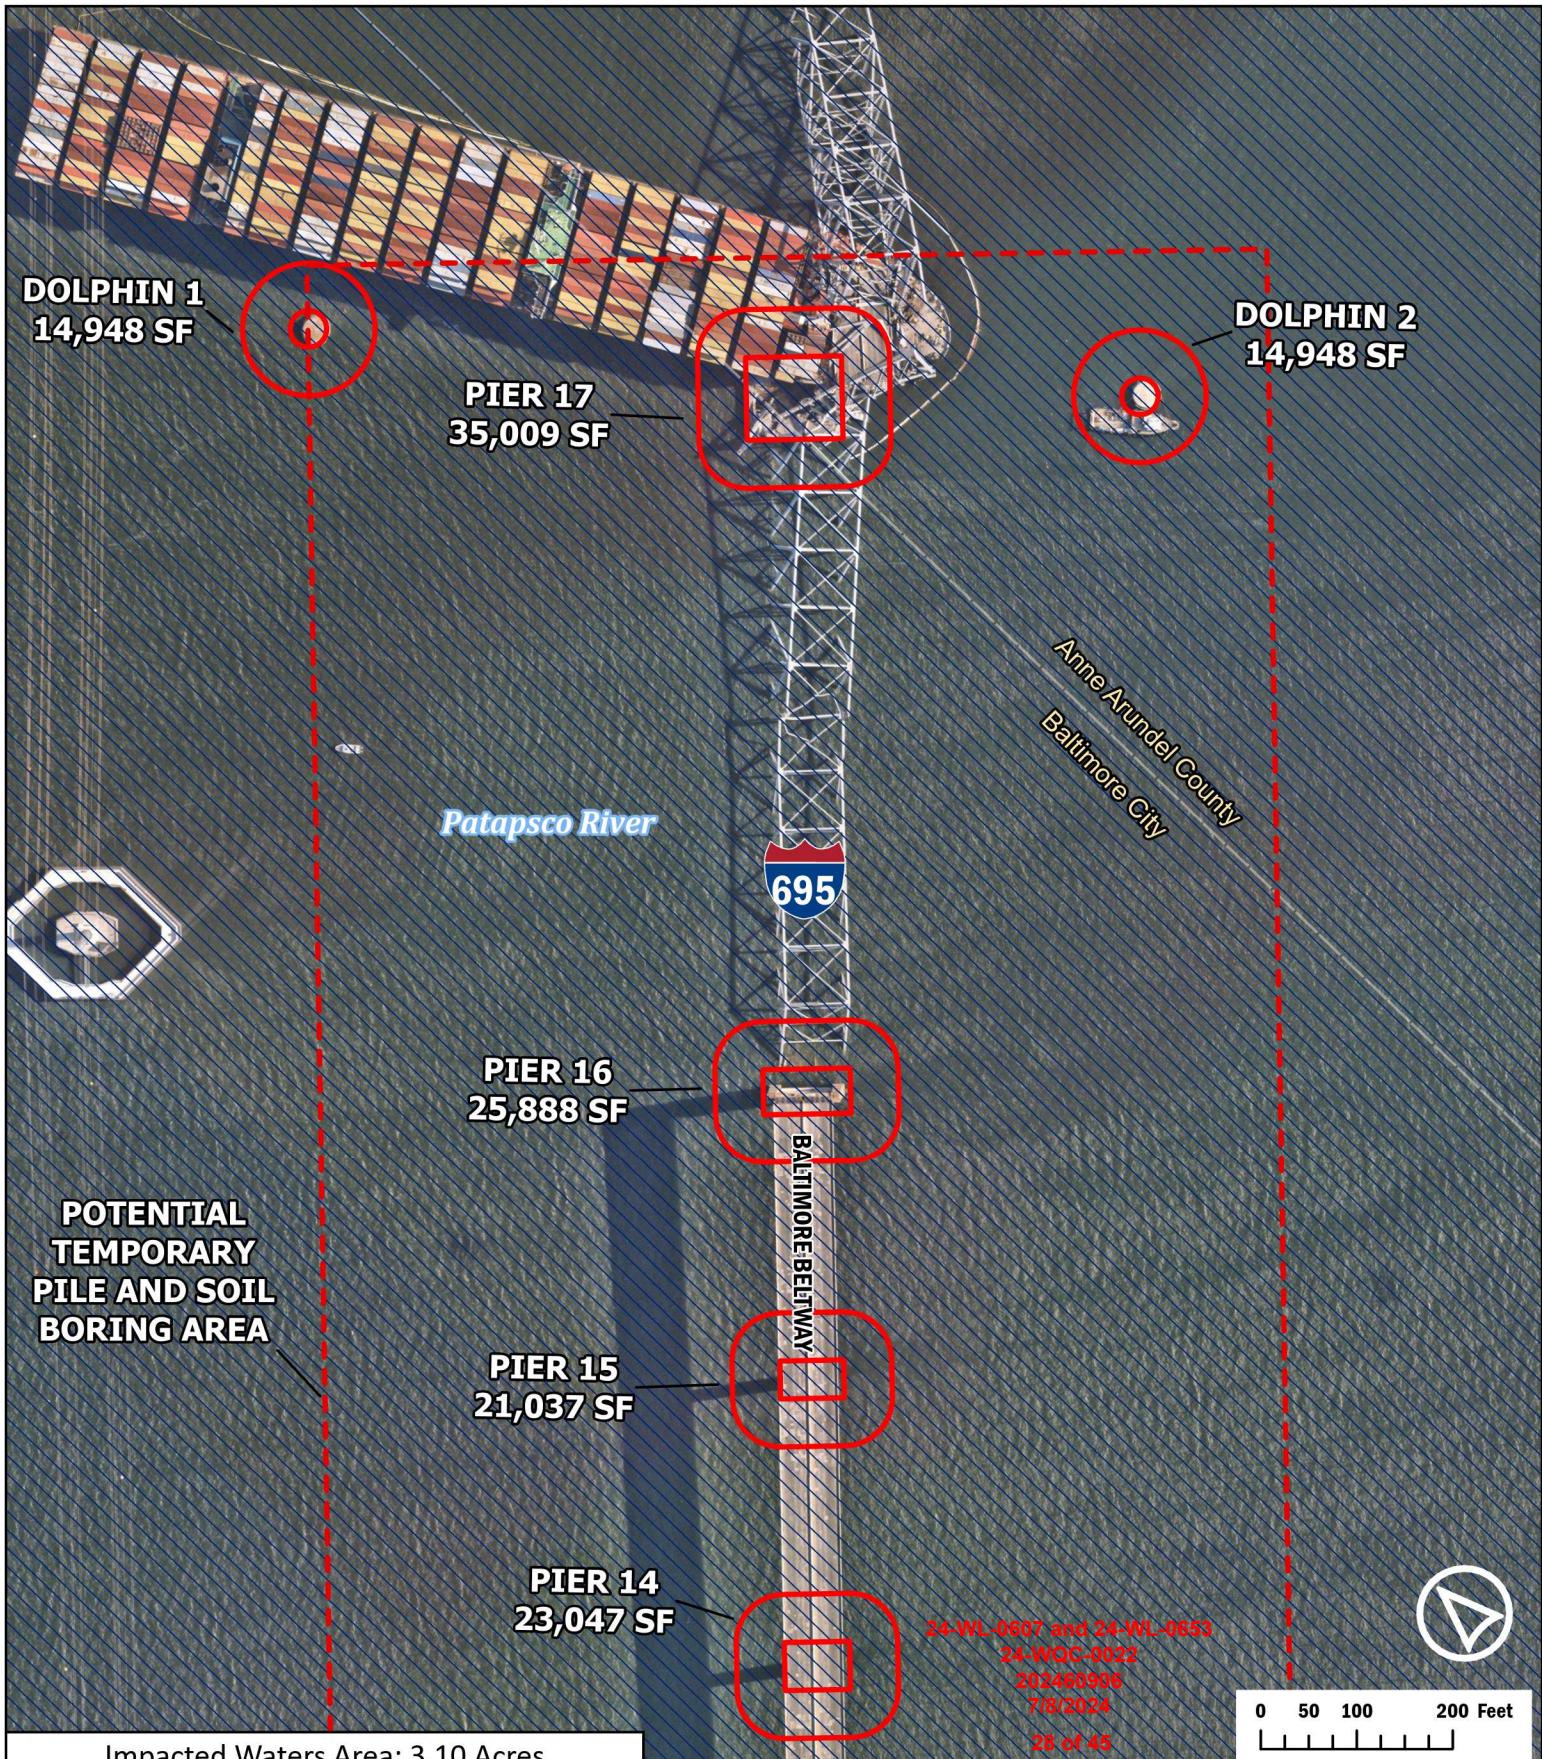

	Limits of Disturbance		Approximate MLW Line
	Potential Temporary Pile Area		MHHW Line
	Streams		MHW Line
	Wetlands		Property Parcels
	25ft Wetland Buffer		Municipal Boundaries
	100-Year Floodplain		



**Francis Scott Key
Bridge
Demolition
Impact Plates**

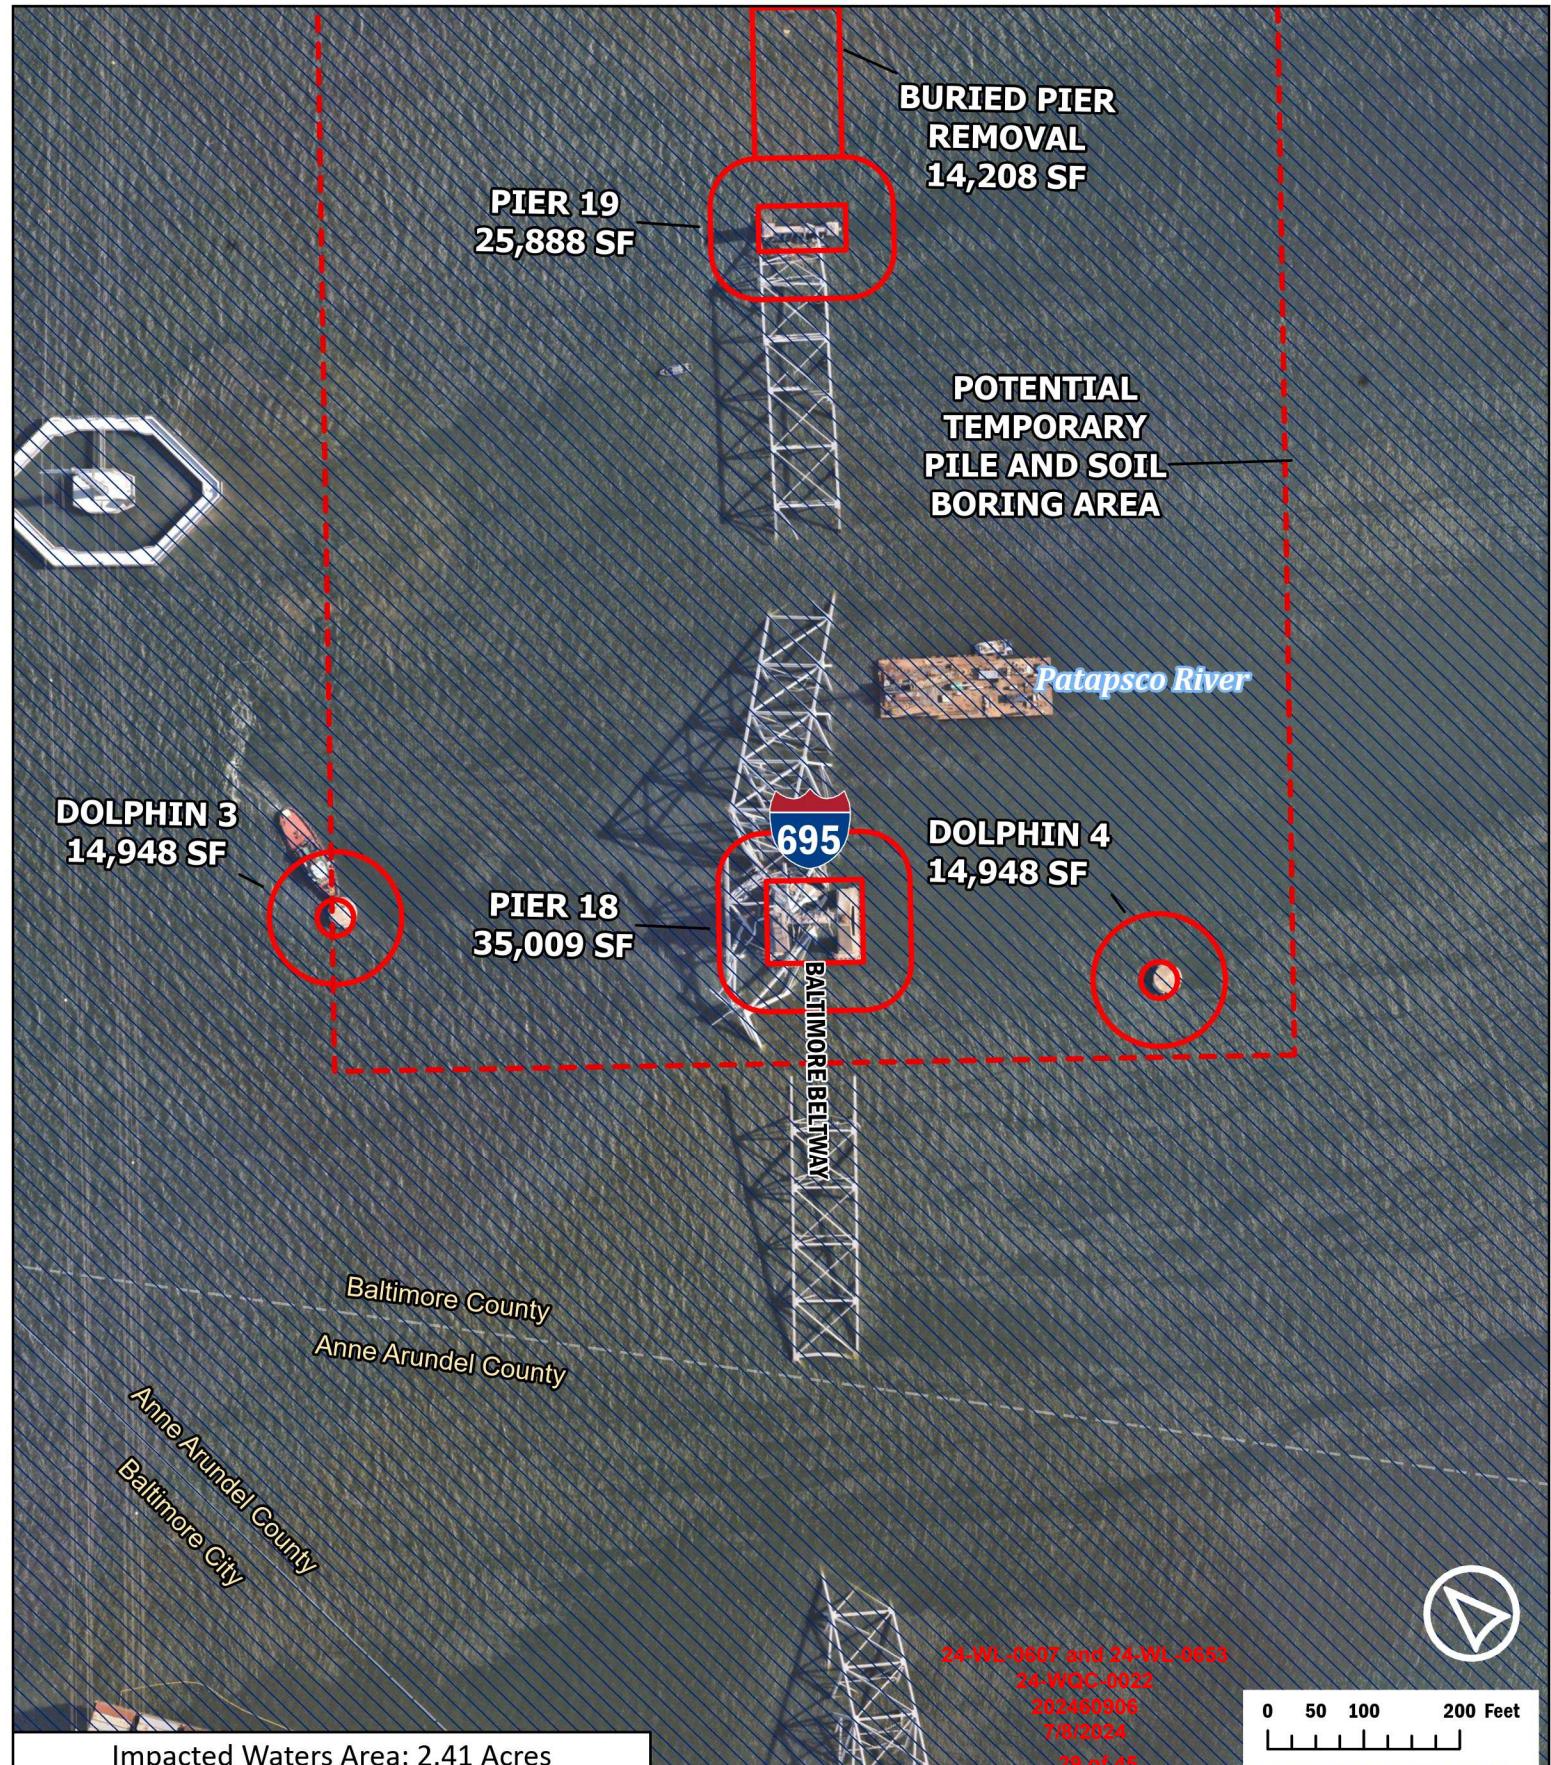

■ Limits of Disturbance	— Approximate MLW Line
□ Potential Temporary Pile Area	— MHHW Line
■ Streams	— MHW Line
■ Wetlands	□ Property Parcels
■ 25ft Wetland Buffer	□ Municipal Boundaries
■ 100-Year Floodplain	



Francis Scott Key Bridge Demolition Impact Plates

**POTENTIAL
TEMPORARY
PILE AND SOIL
BORING AREA**

**PIER 24
& GIRDERS
29,911 SF**

**PIER 23
20,288 SF**

**PIER 22
20,288 SF**

**PIER 21
23,012 SF**

**PIER 20
21,653 SF**

Patapsco River

BALTIMORE BELTWAY

695

24-WL-0607 and 24-WL-0653
24-WQC-0022
2024060906
7/8/2024
30 of 45



0 50 100 200 Feet


**BURIED PIER
REMOVAL
5,168 SF**

Impacted Waters Area: 2.76 Acres

■ Limits of Disturbance	— Approximate MLW Line
□ Potential Temporary Pile Area	— MHHW Line
■ Streams	— MHW Line
■ Wetlands	■ Property Parcels
■ 25ft Wetland Buffer	■ Municipal Boundaries
■■■ 100-Year Floodplain	




**Francis Scott Key
Bridge
Demolition
Impact Plates**

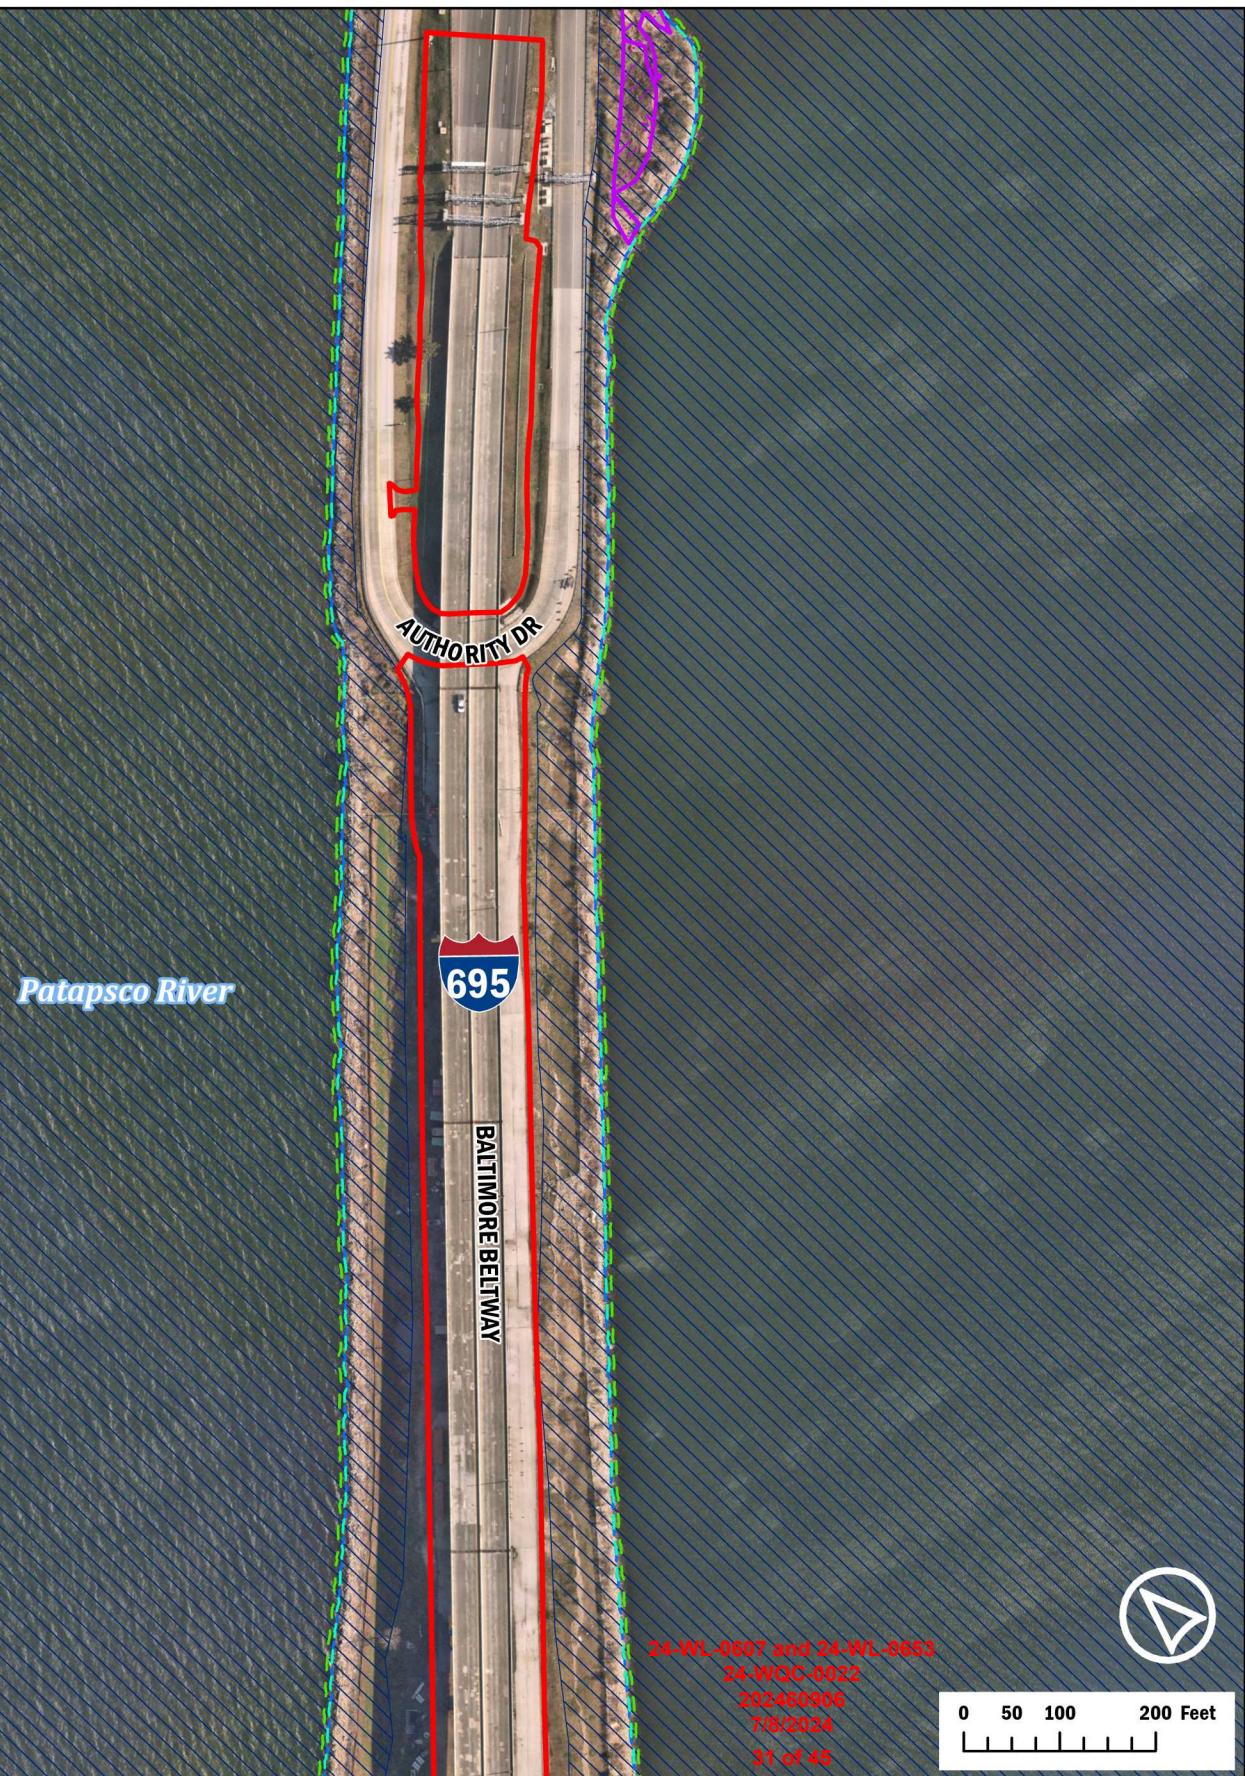

 Limits of Disturbance	 Approximate MLW Line
 Potential Temporary Pile Area	 MHHW Line
 Streams	 MHW Line
 Wetlands	 Property Parcels
 25ft Wetland Buffer	 Municipal Boundaries
 100-Year Floodplain	



**Francis Scott Key
Bridge
Demolition
Impact Plates**

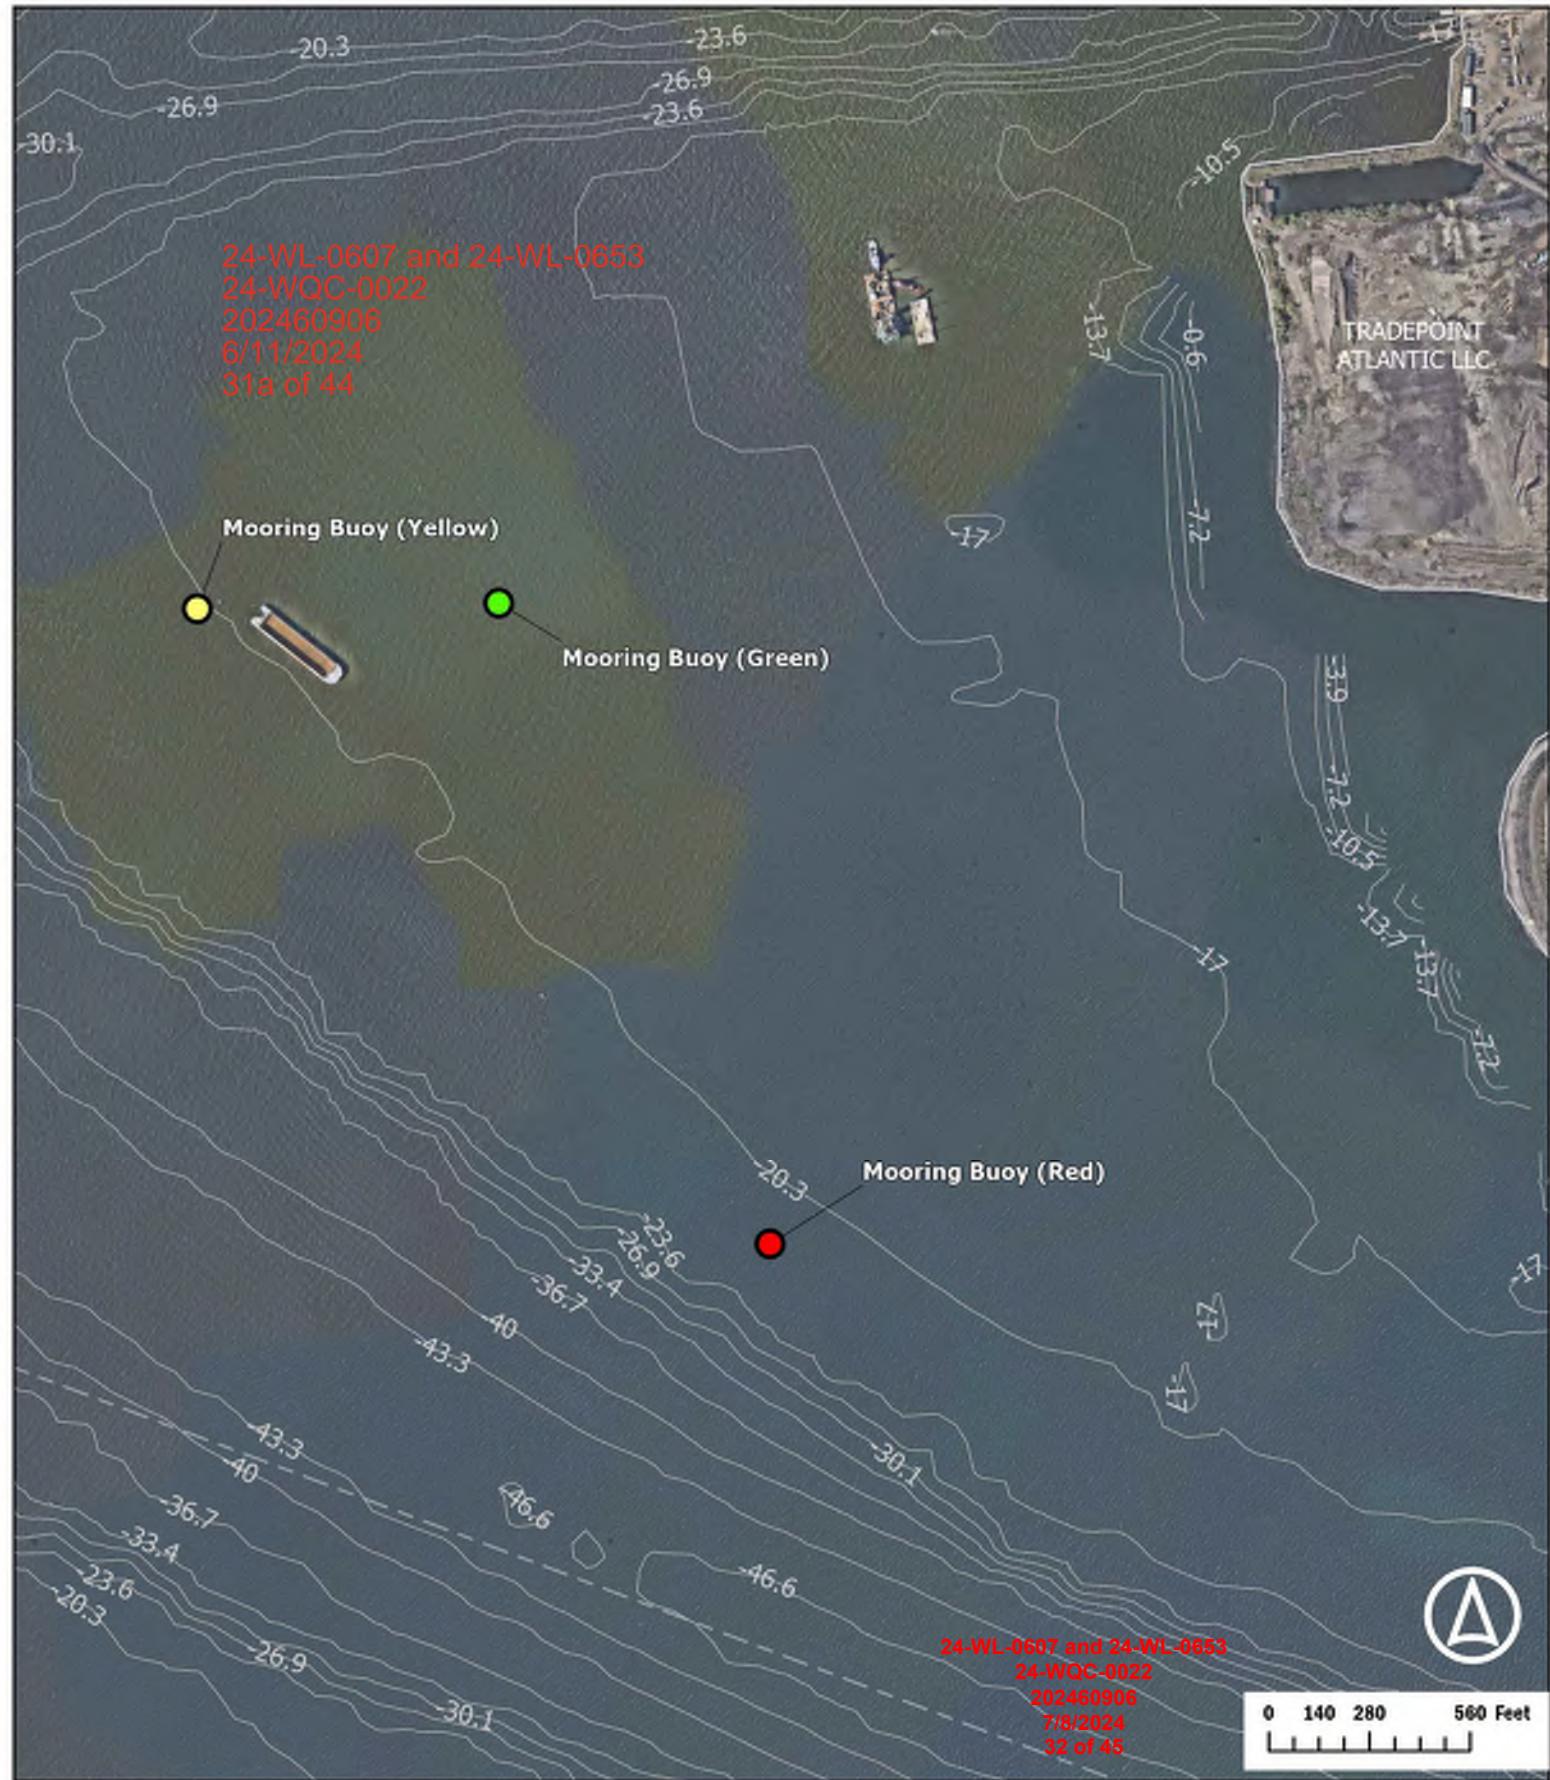

Limits of Disturbance
 Temporary Pile Area
 Streams
 Wetlands
 25ft Wetland Buffer
 Approximate MLW Line


MHHW Line
 MHW Line
 Bathymetry Contours
 Property Parcels
 Municipal Boundaries

Mooring Buoy
 Yellow
 Green
 Red




**Francis Scott Key
 Bridge
 Demolition
 Emergency Authorization
 Plates**

DEMOLITION LIMITS SHOWN IN
RED


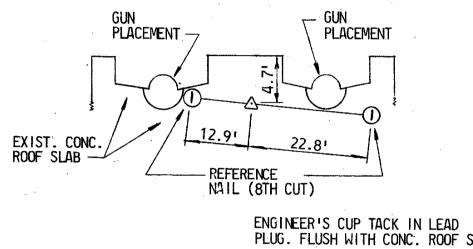


MONUMENT - "HARP"

MONUMENT 'FORT'
+ CUT IN TOP OF
CONCRETE WALL.
BOOK #1 PAGE 28
N 39° 33.0' 15"
E 76° 49.9' 77"

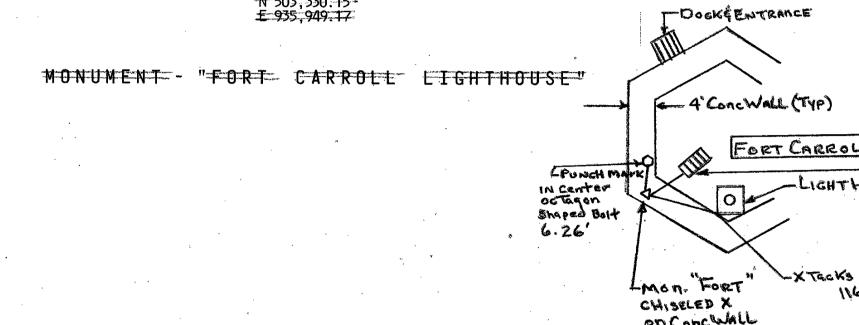


MONUMENT - "PARKS"
(DESTROYED)

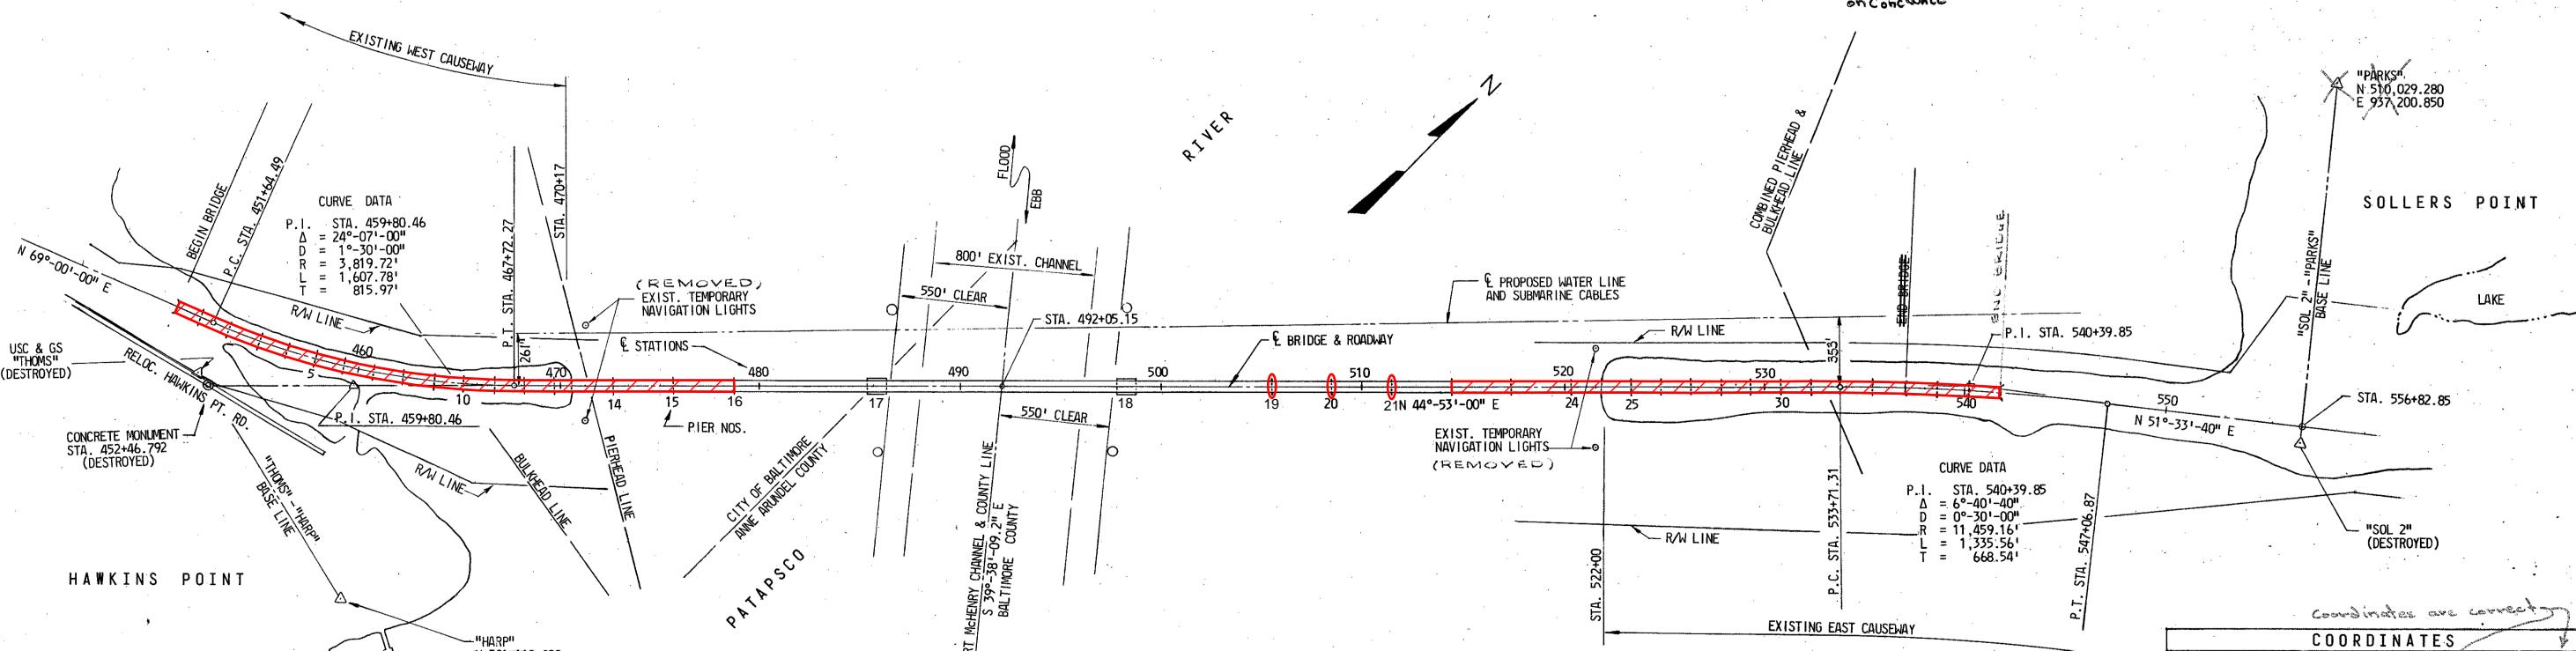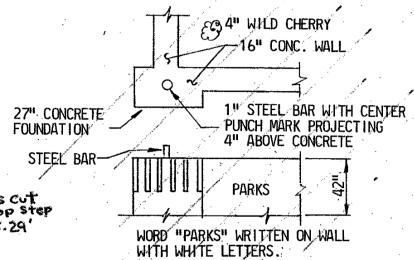

Truss Spans and Bridge Superstructure from Span 17 through
Span 22 Salvage Operations/Demolition by Others

DATUM: -ALL ELEVATIONS ARE IN FEET AND ARE BASED ON
U.S. COAST AND GEODETIC SURVEY MEAN SEA LEVEL
DATUM, 1929 ADJUSTMENT.

HORIZONTAL CONTROL: THIS PROJECT IS ORIENTED TO CONFORM
TO THE MARYLAND GRID SYSTEM.

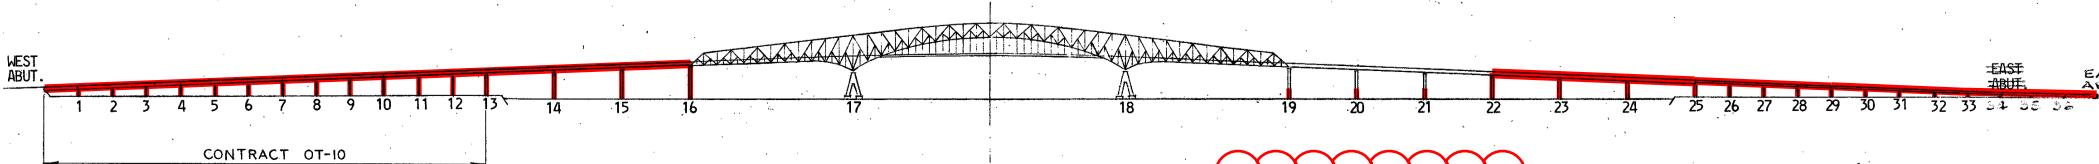

Demolition Limits include Bridge Deck and
Piers from West Abutment through Pier 16

REMOVE TREMIE CONCRETE
AND PILES TO 2 FEET BELOW
MUDLINE AS REQUIRED BY
USCG BRIDGE PERMIT.


Demolition Limits
include Remaining
Portions of Piers 19,
20 and 21


Demolition Limits include Bridge Deck and
Piers from Pier 22 to East Abutment

24-WL-0607 and 24-WL-0653
24-WQC-0022
202460906
7/8/2024



AS BUILT		REVISIONS	
STATE OF MARYLAND DEPARTMENT OF TRANSPORTATION STATE HIGHWAY ADMINISTRATION BALTIMORE, MD.		BALTIMORE HARBOR OUTER CROSSING PATAPSCO RIVER BRIDGE	
BRIDGE DEMOLITION PLAN			
SCALE: 1" = 400' DATE: JAN. 1972 CONTRACT OT-10			
MADE BY _____	E.R.A.	ZOLMAN ASSOC. INC. AND SINGSTAD, KEHART NOVEMBER AND HURKA A JOINT VENTURE Baltimore, Md.	
TRACED BY _____	E.R.A.		
CHECKED BY _____	S.J.S.		
DRAWING NO. C-2			
SHEET NO. OF _____			
INDEXED			

File No. _____ Pocket No. _____ Folder No. _____

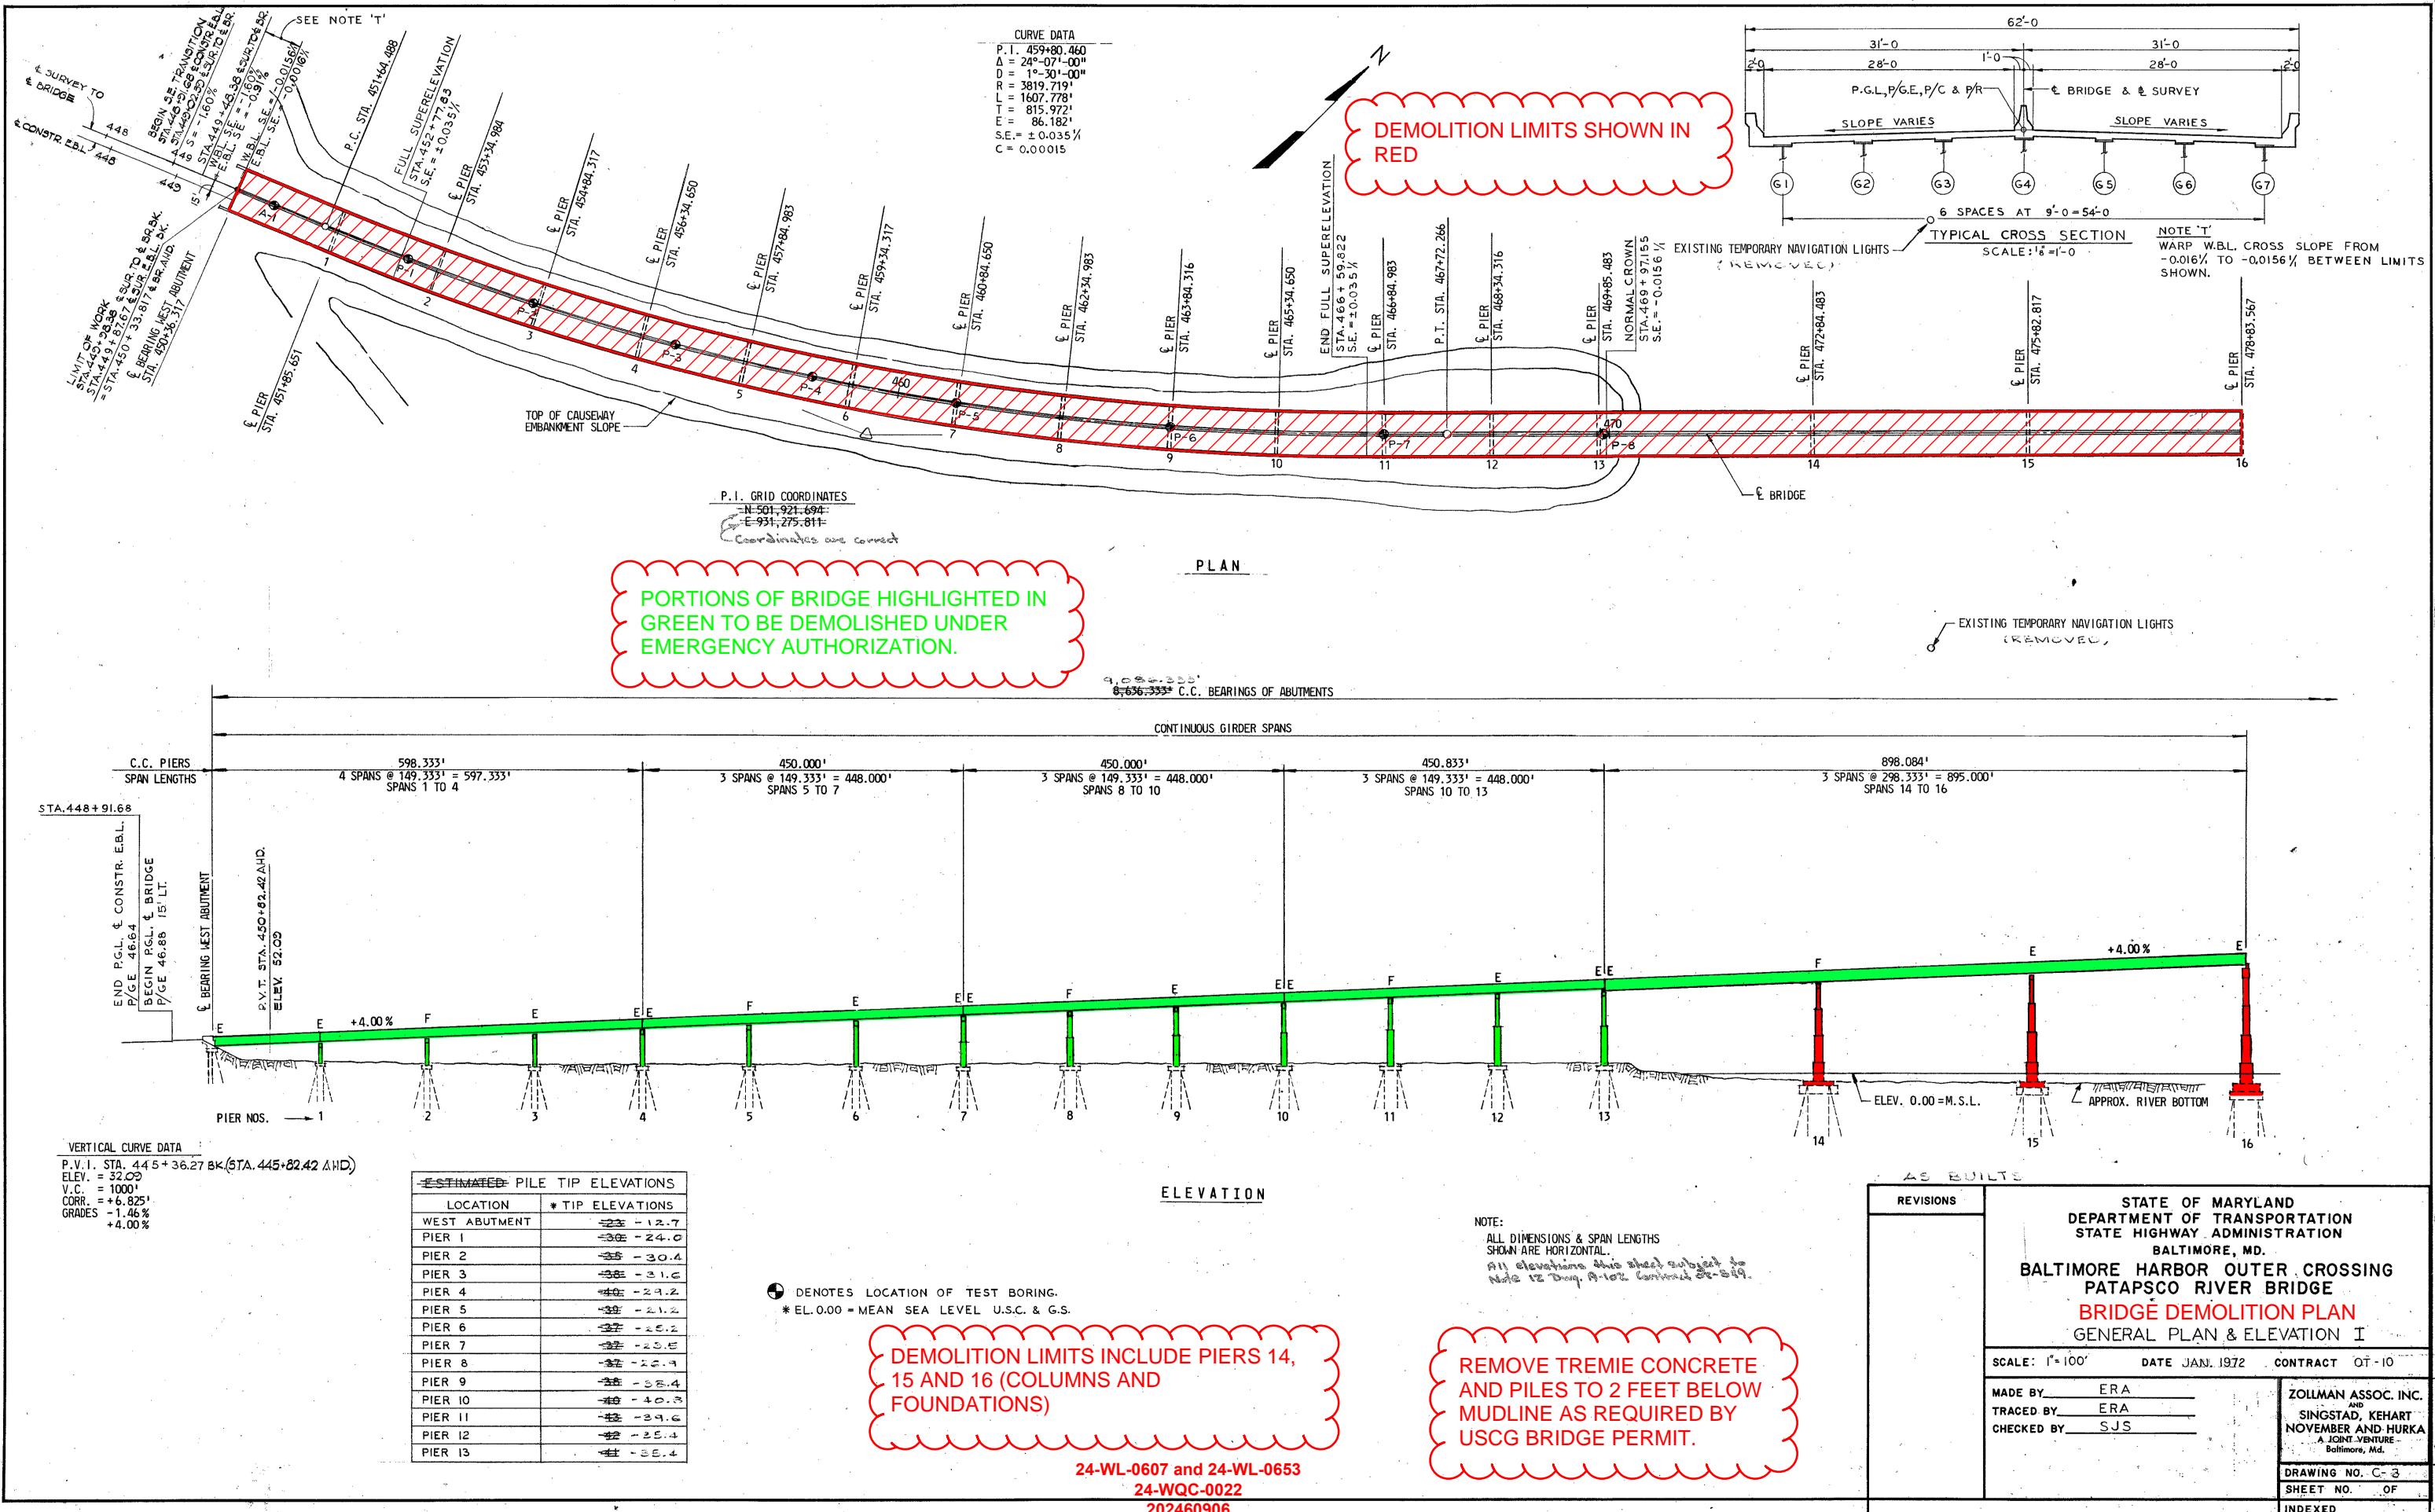

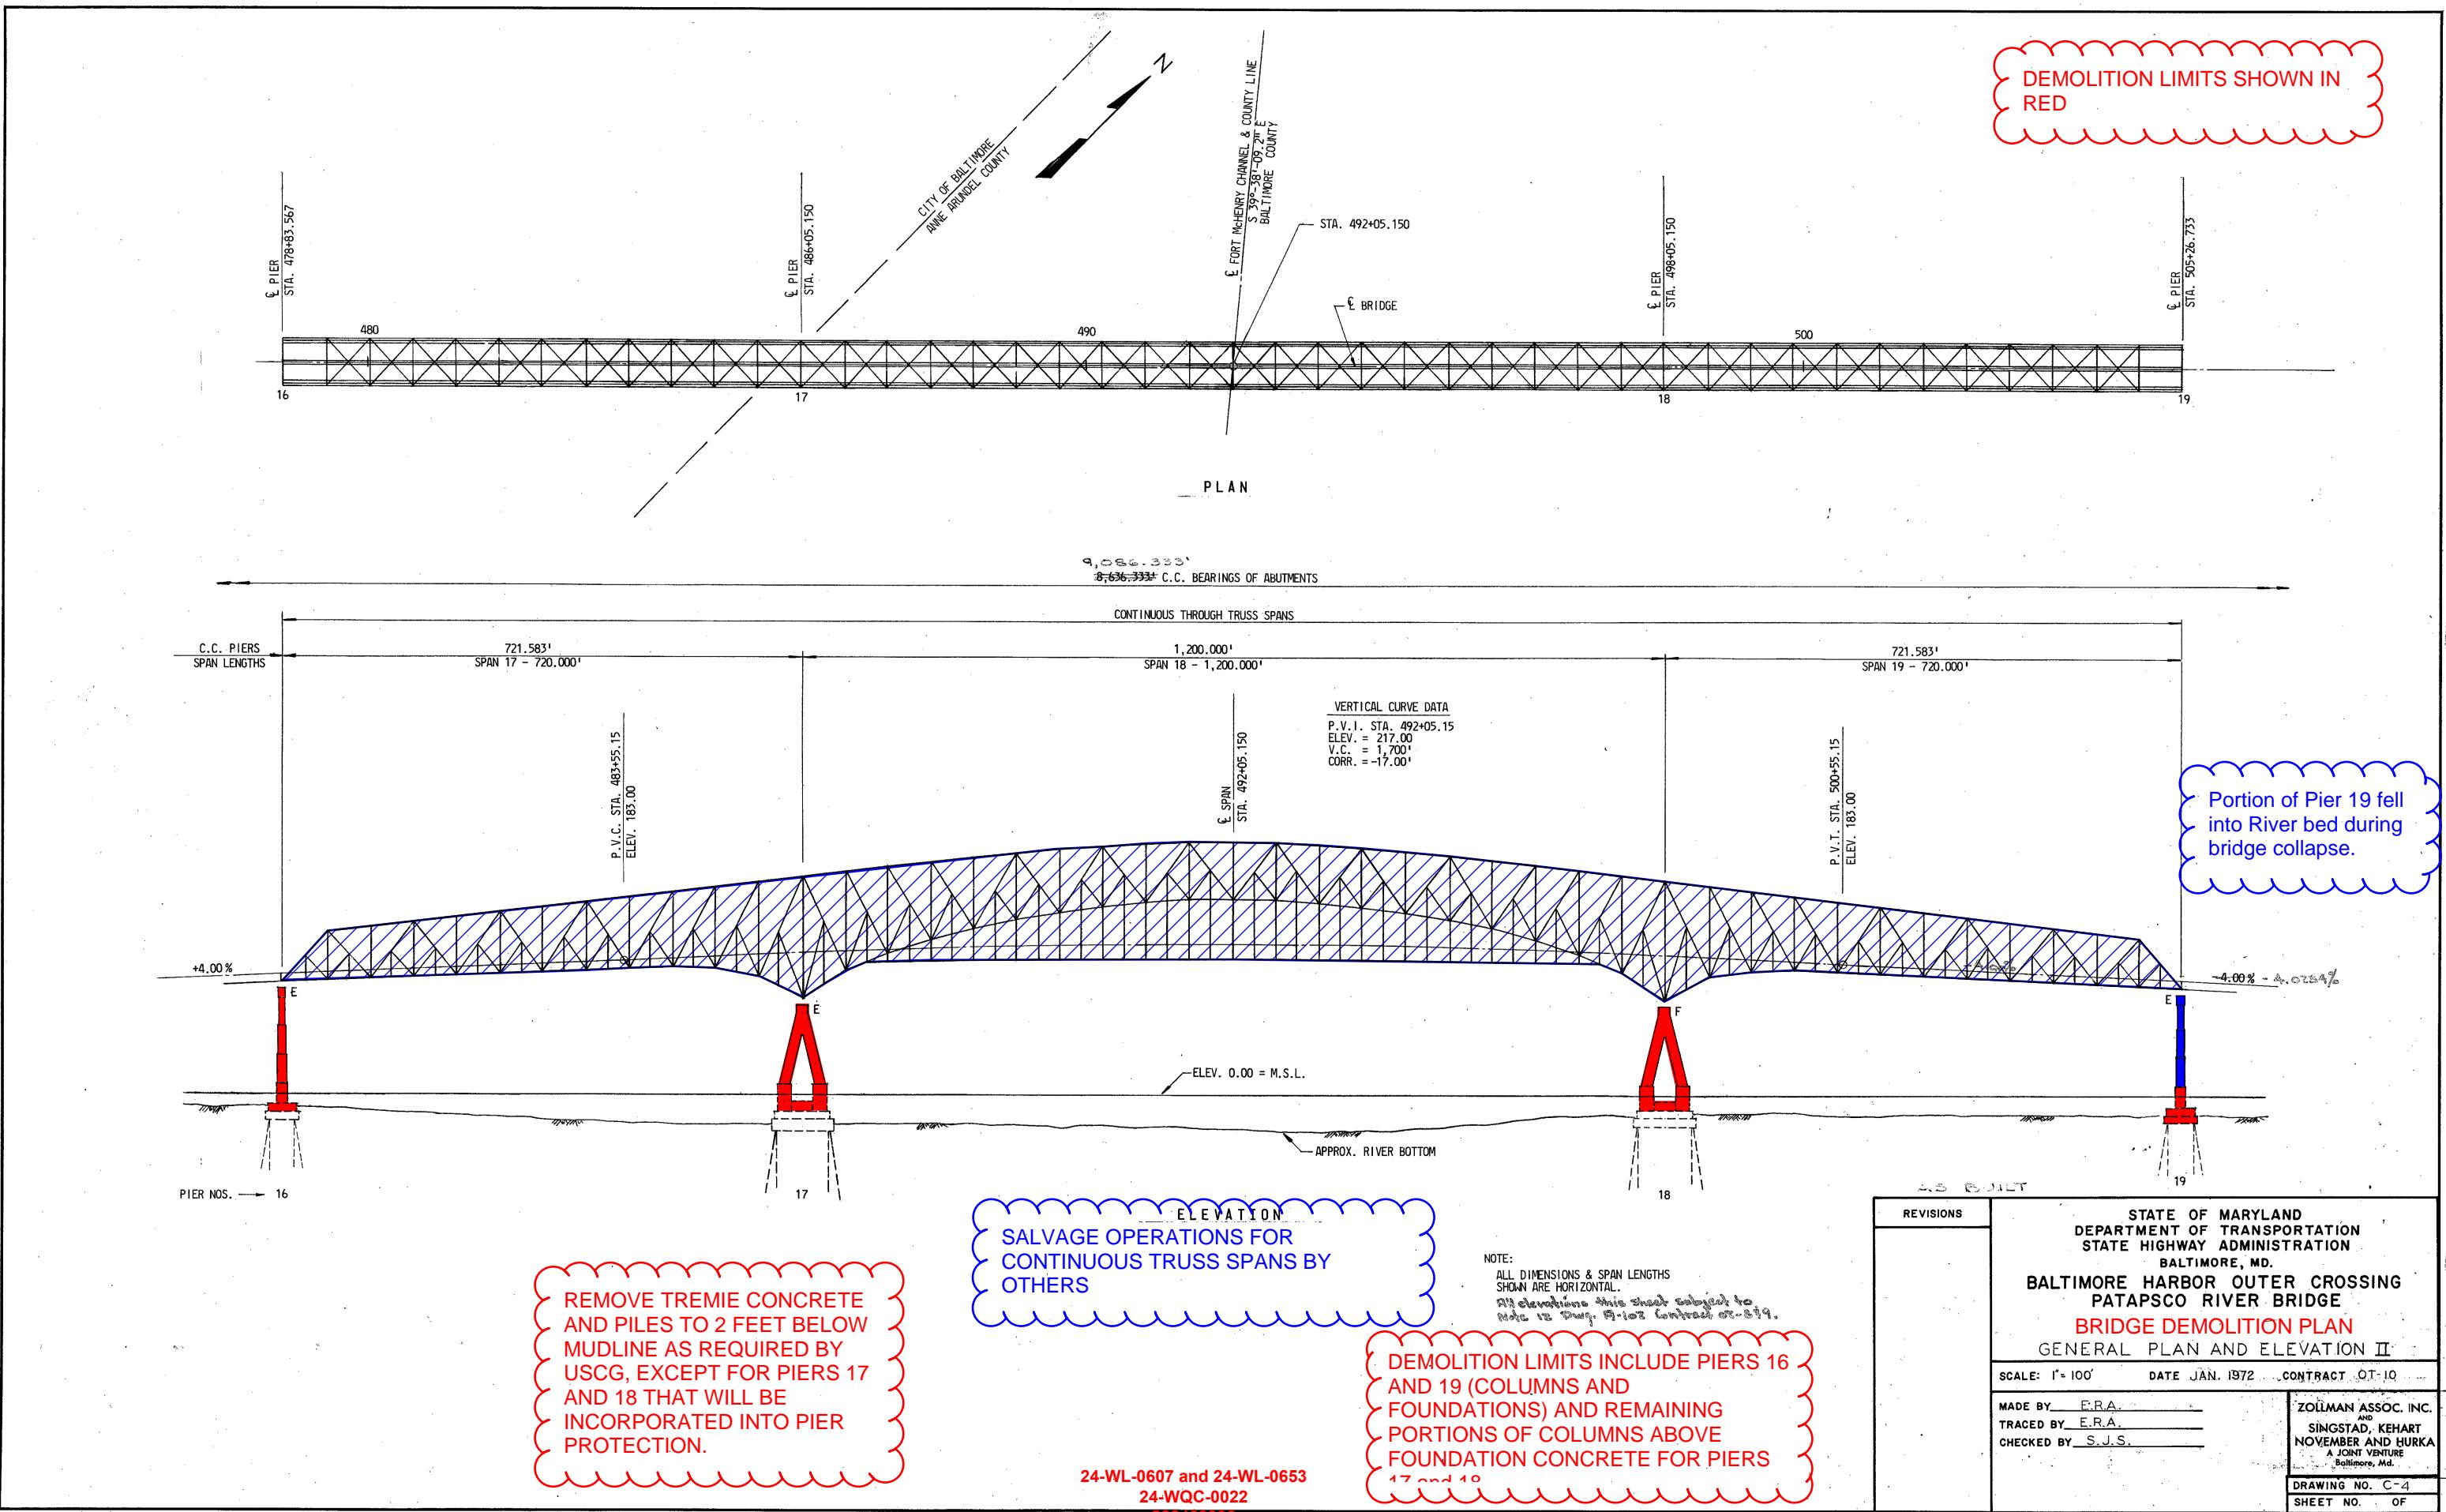


DEMOLITION LIMITS SHOWN IN RED

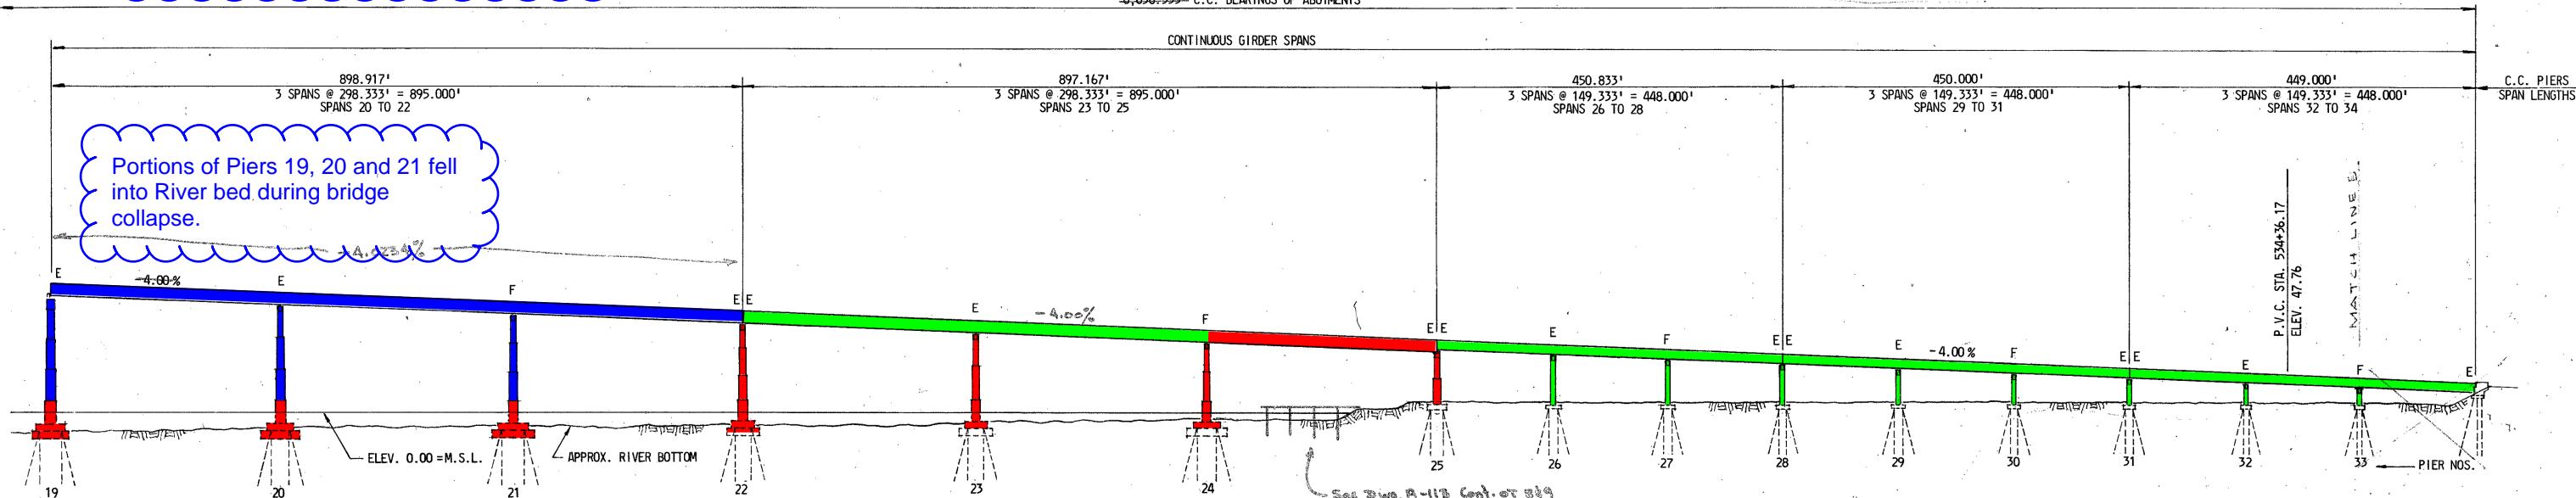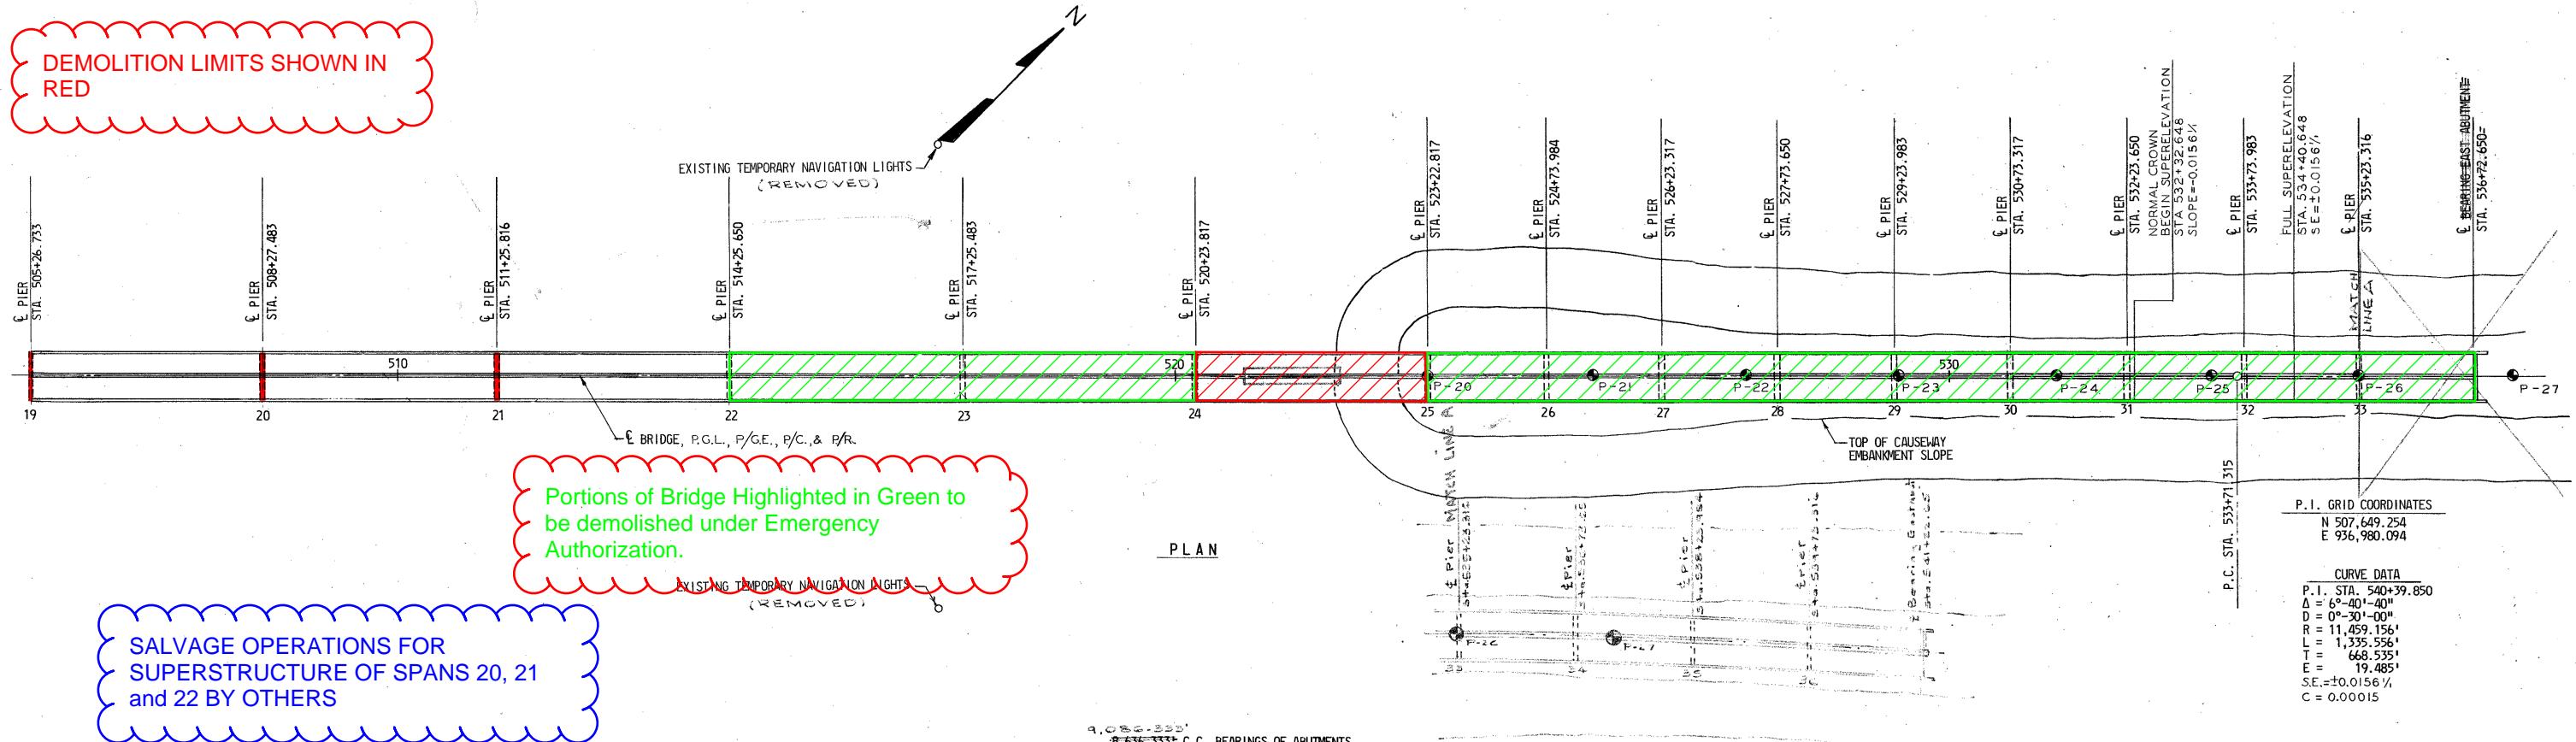



REMOVE TREMIE CONCRETE
AND PILES TO 2 FEET BELOW
MUDDLINE AS REQUIRED BY
USCG BRIDGE PERMIT.

24-WL-0607 and 24-WL-0653
24-WQC-0022
202460906
7/8/2024

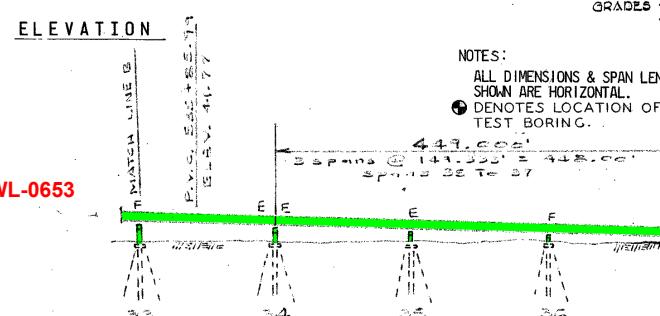

REVISIONS	STATE OF MARYLAND DEPARTMENT OF TRANSPORTATION STATE HIGHWAY ADMINISTRATION BALTIMORE, MD. BALTIMORE HARBOR OUTER CROSSING PATAPSCO RIVER BRIDGE BRIDGE DEMOLITION PLAN GENERAL PLAN AND ELEVATION III		
SCALE: 1' = 100'		DATE JAN. 1972	CONTRACT OT-10
MADE BY E.R.A.		ZOLLMAN ASSOC. INC. AND SINGSTAD, KEHART NOVEMBER AND HURKA A JOINT VENTURE Baltimore, Md.	
TRACED BY E.R.A.		DRAWING NO. C-5	
CHECKED BY S.J.S.		SHEET NO. 1 OF	
INDEXED			

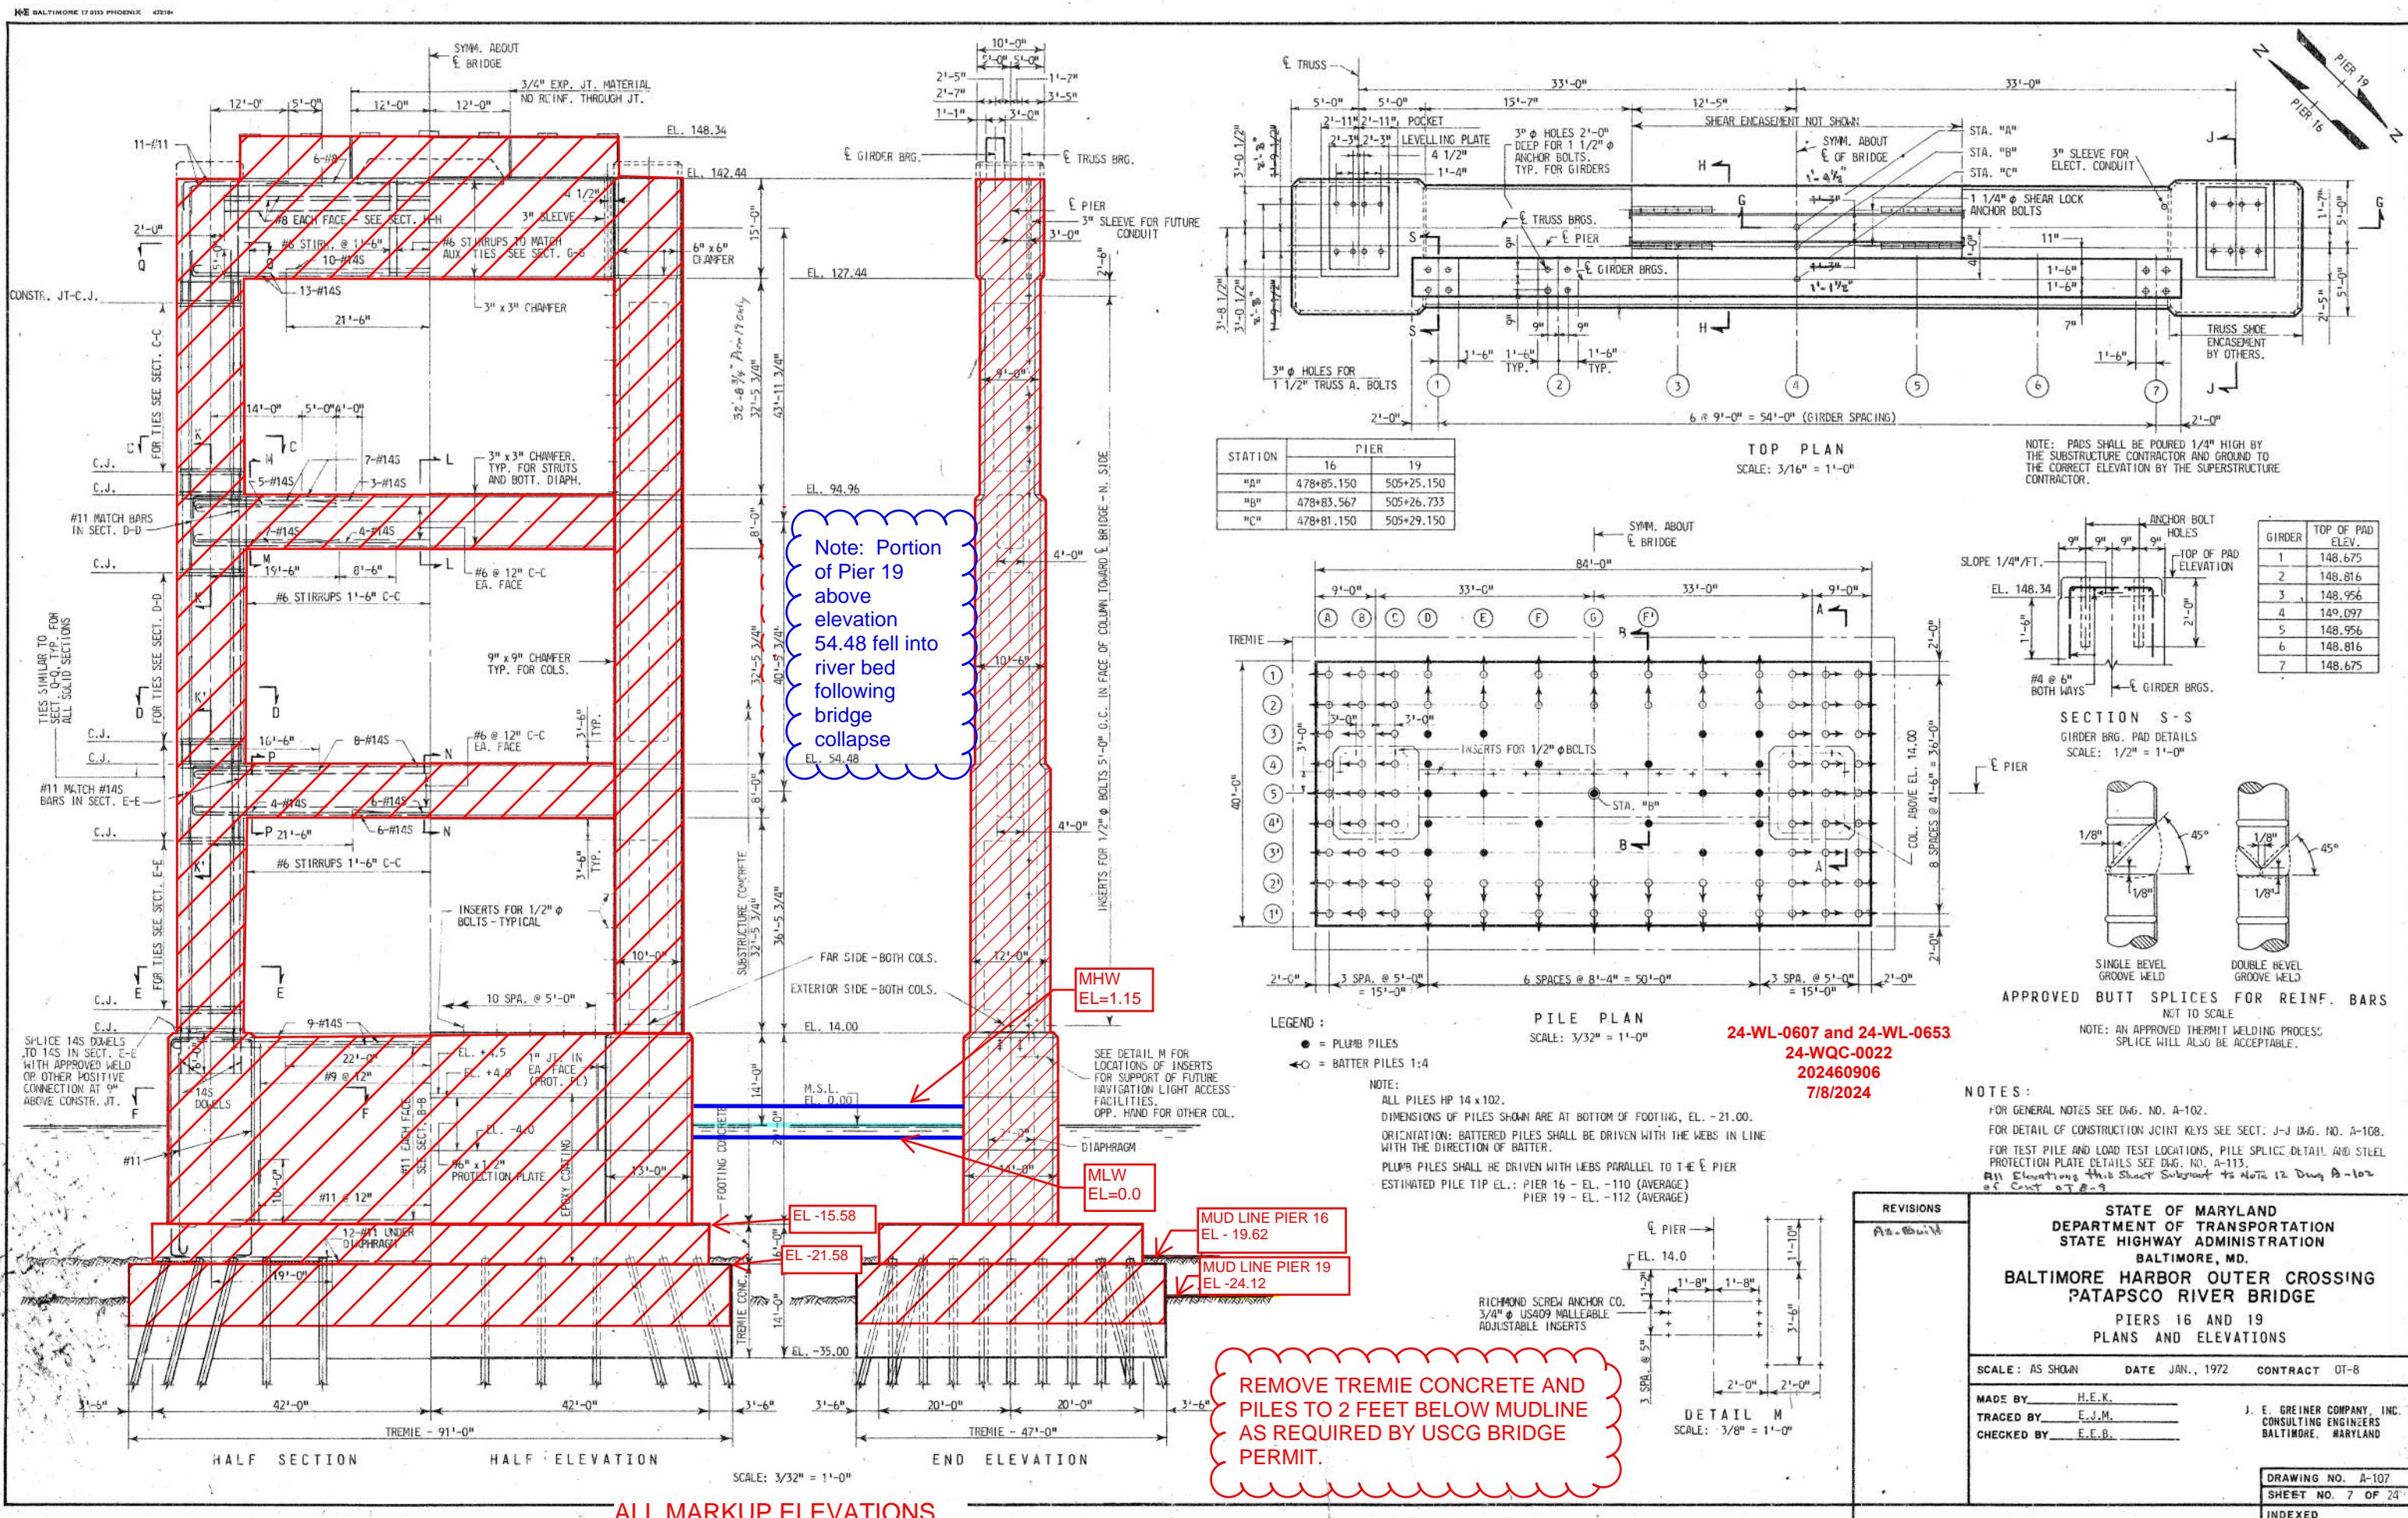

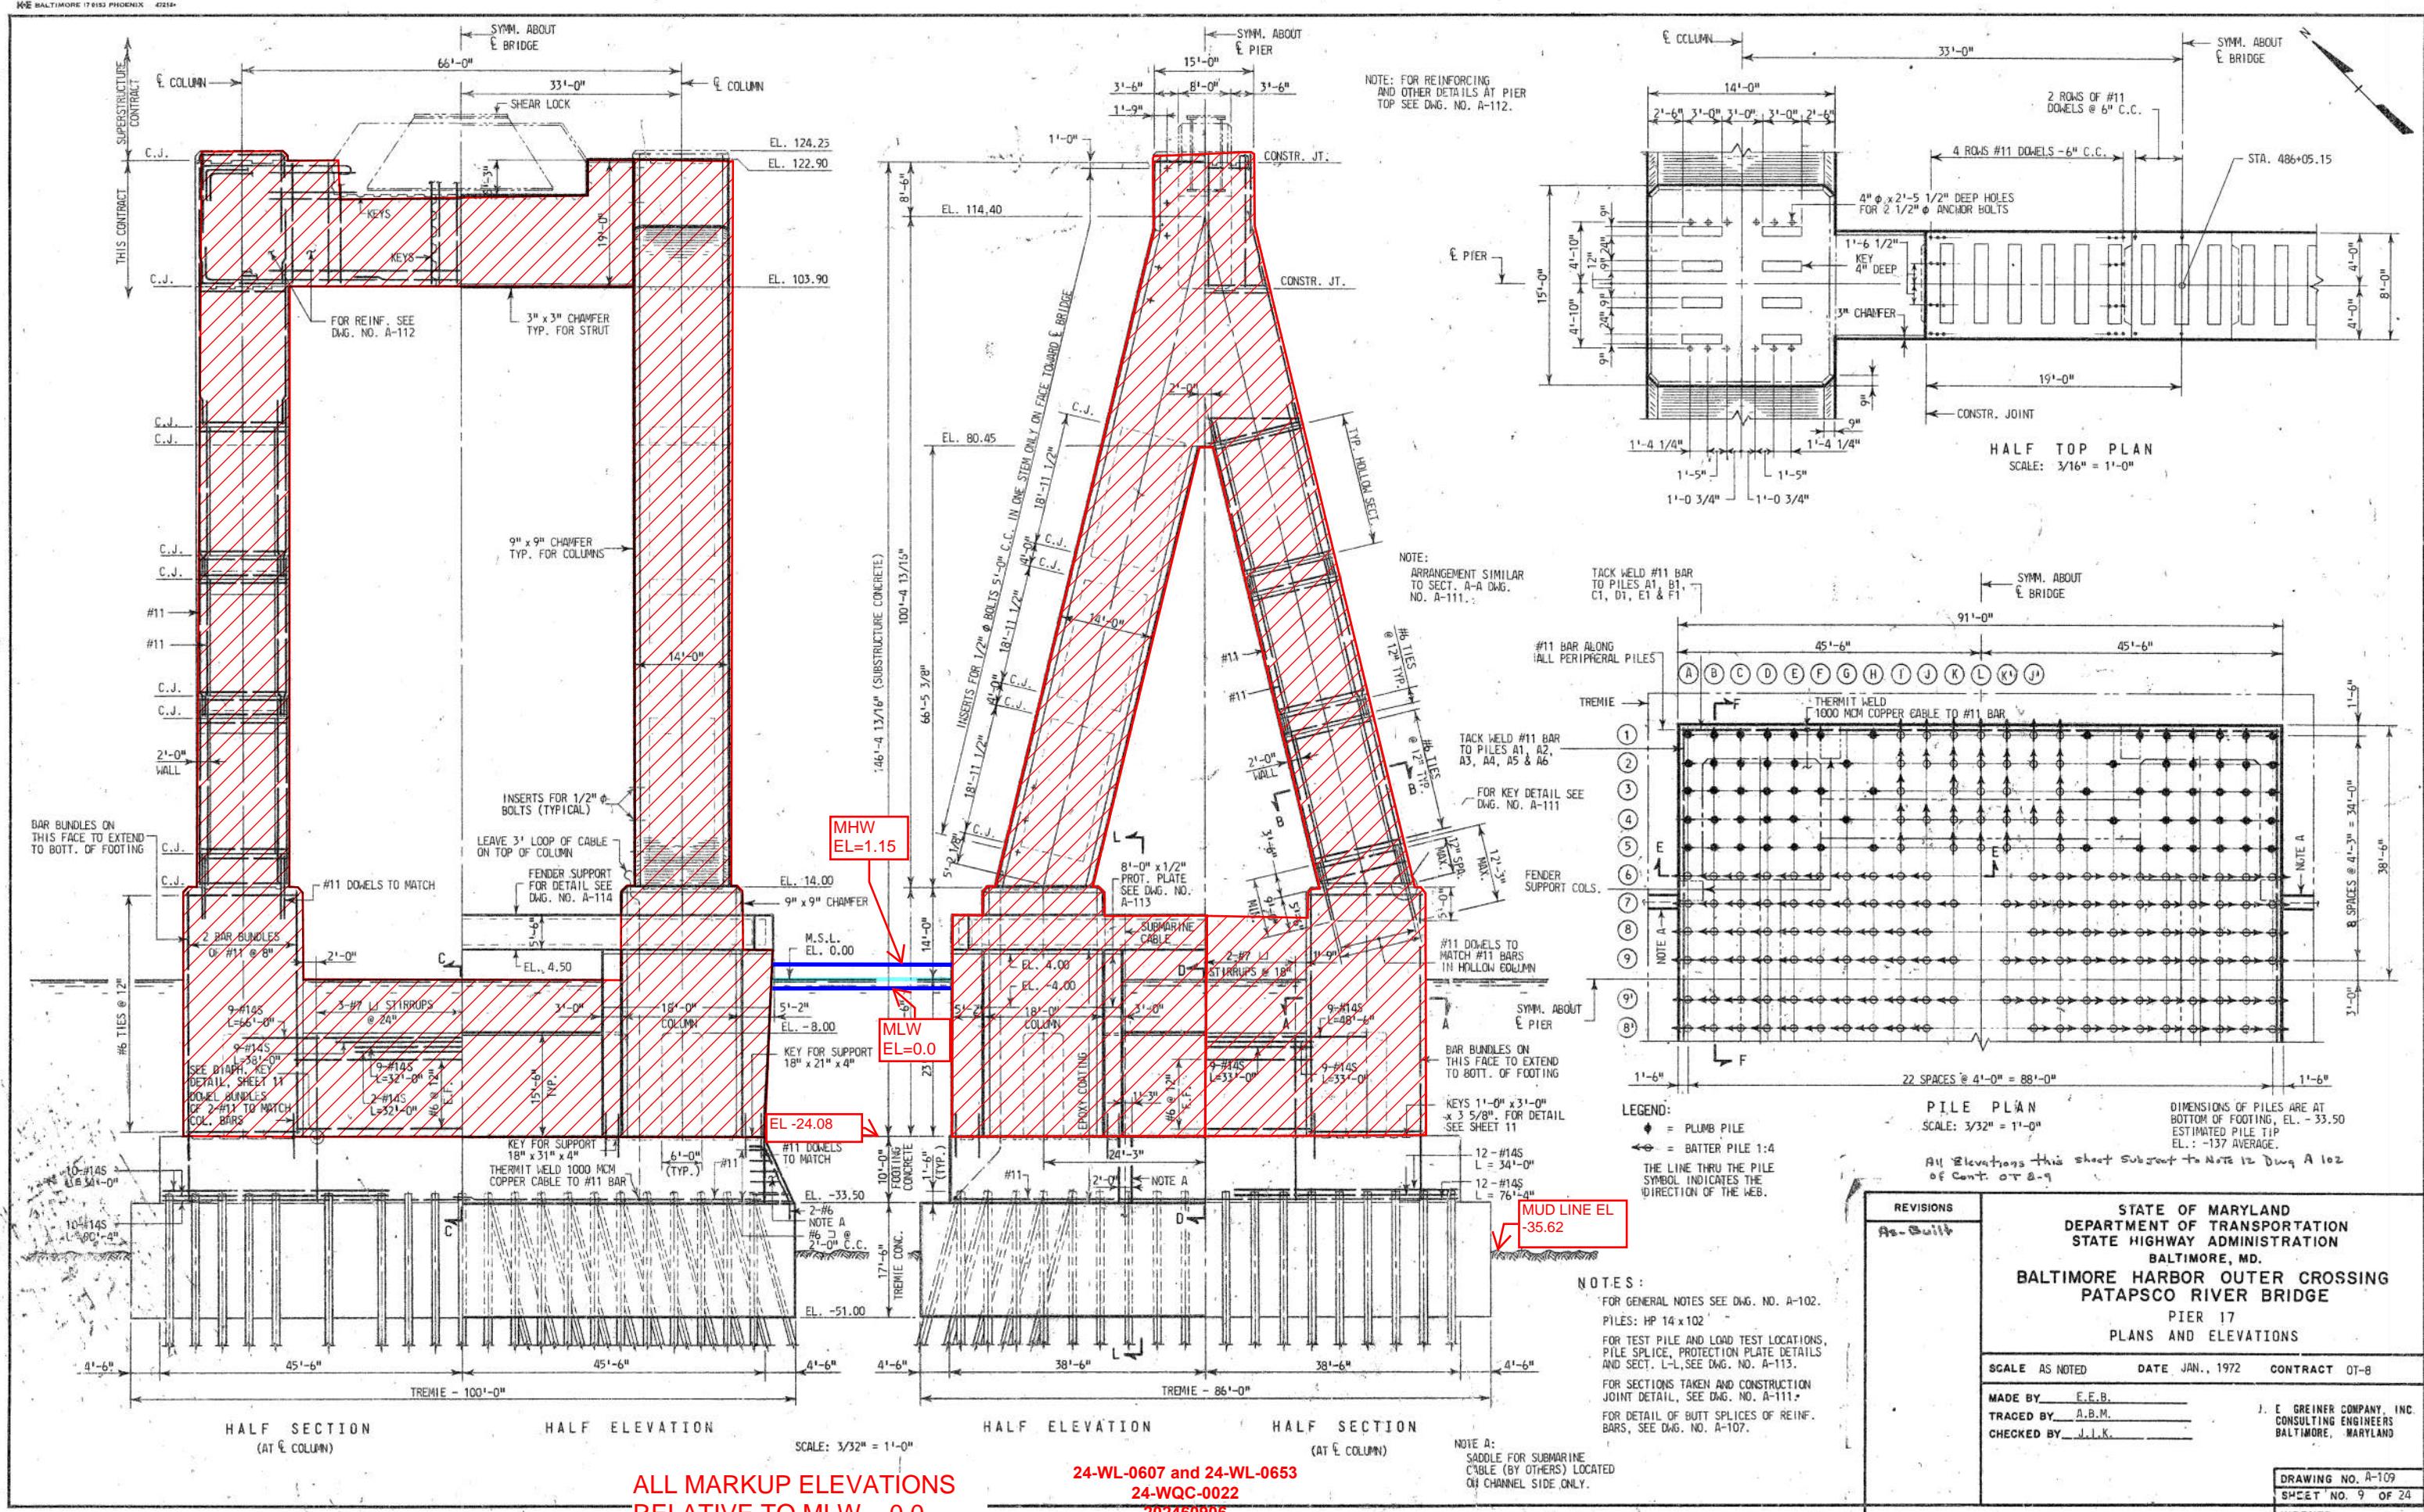



**ALL MARKUP ELEVATIONS
RELATIVE TO MLW = 0.0**


**24-WL-0607 and 24-WL-0653
24-WQC-0022
202460906
7/8/2024
38 of 45**

NOTE A:
SADDLE FOR SUBMARINE
CABLE (BY OTHERS) LOCATED
ON CHANNEL SIDE ONLY.

File No. Pocket No. Folder No. INDEXED

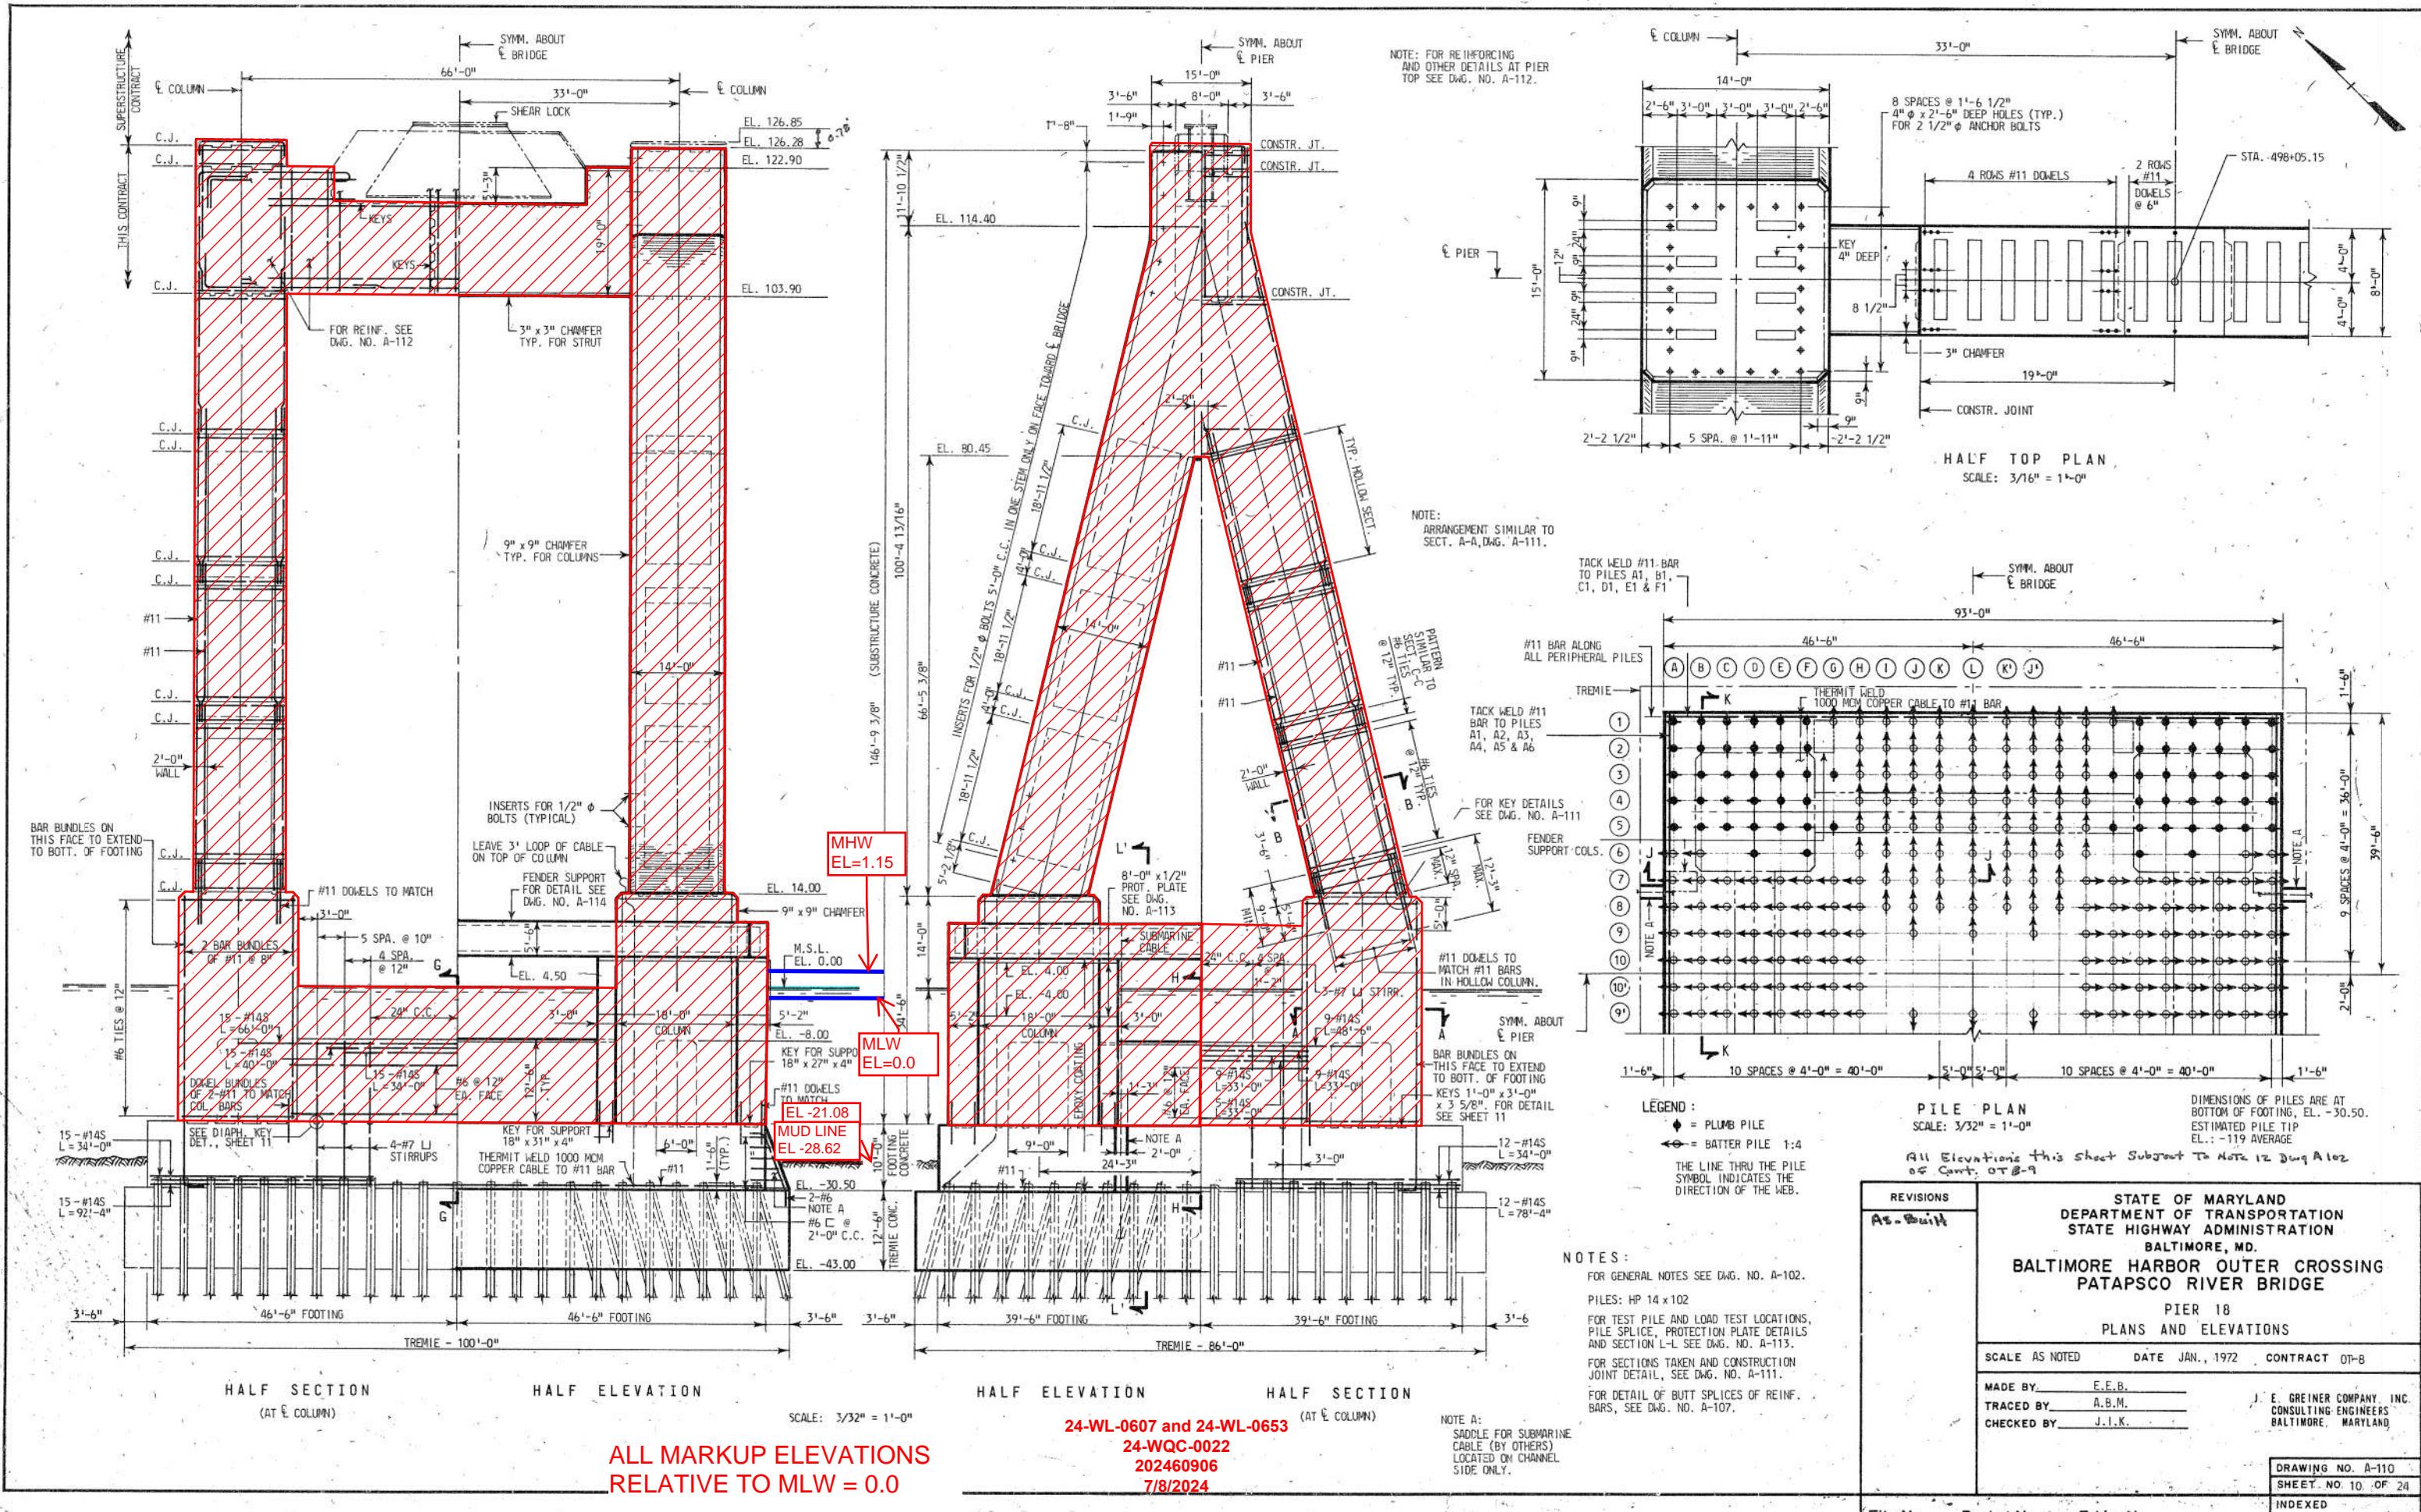

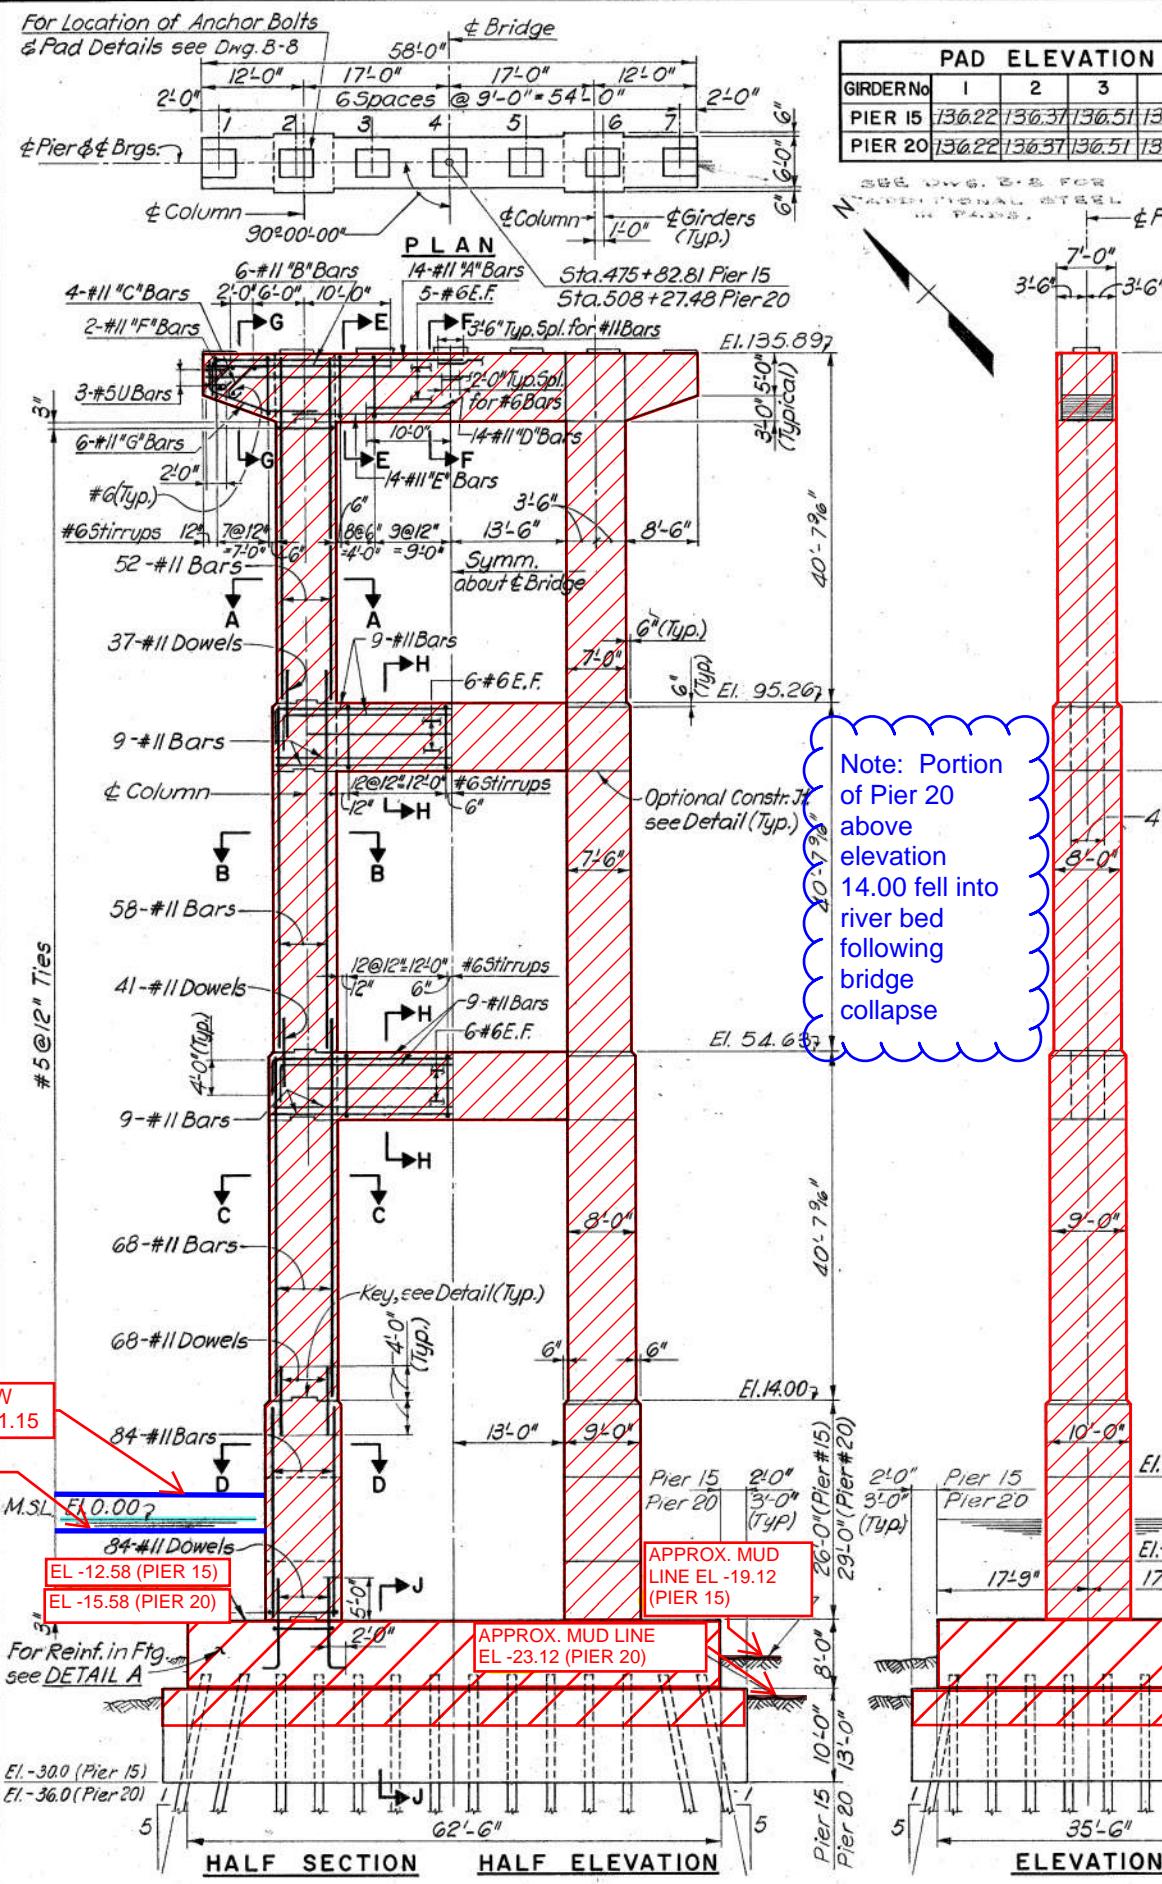

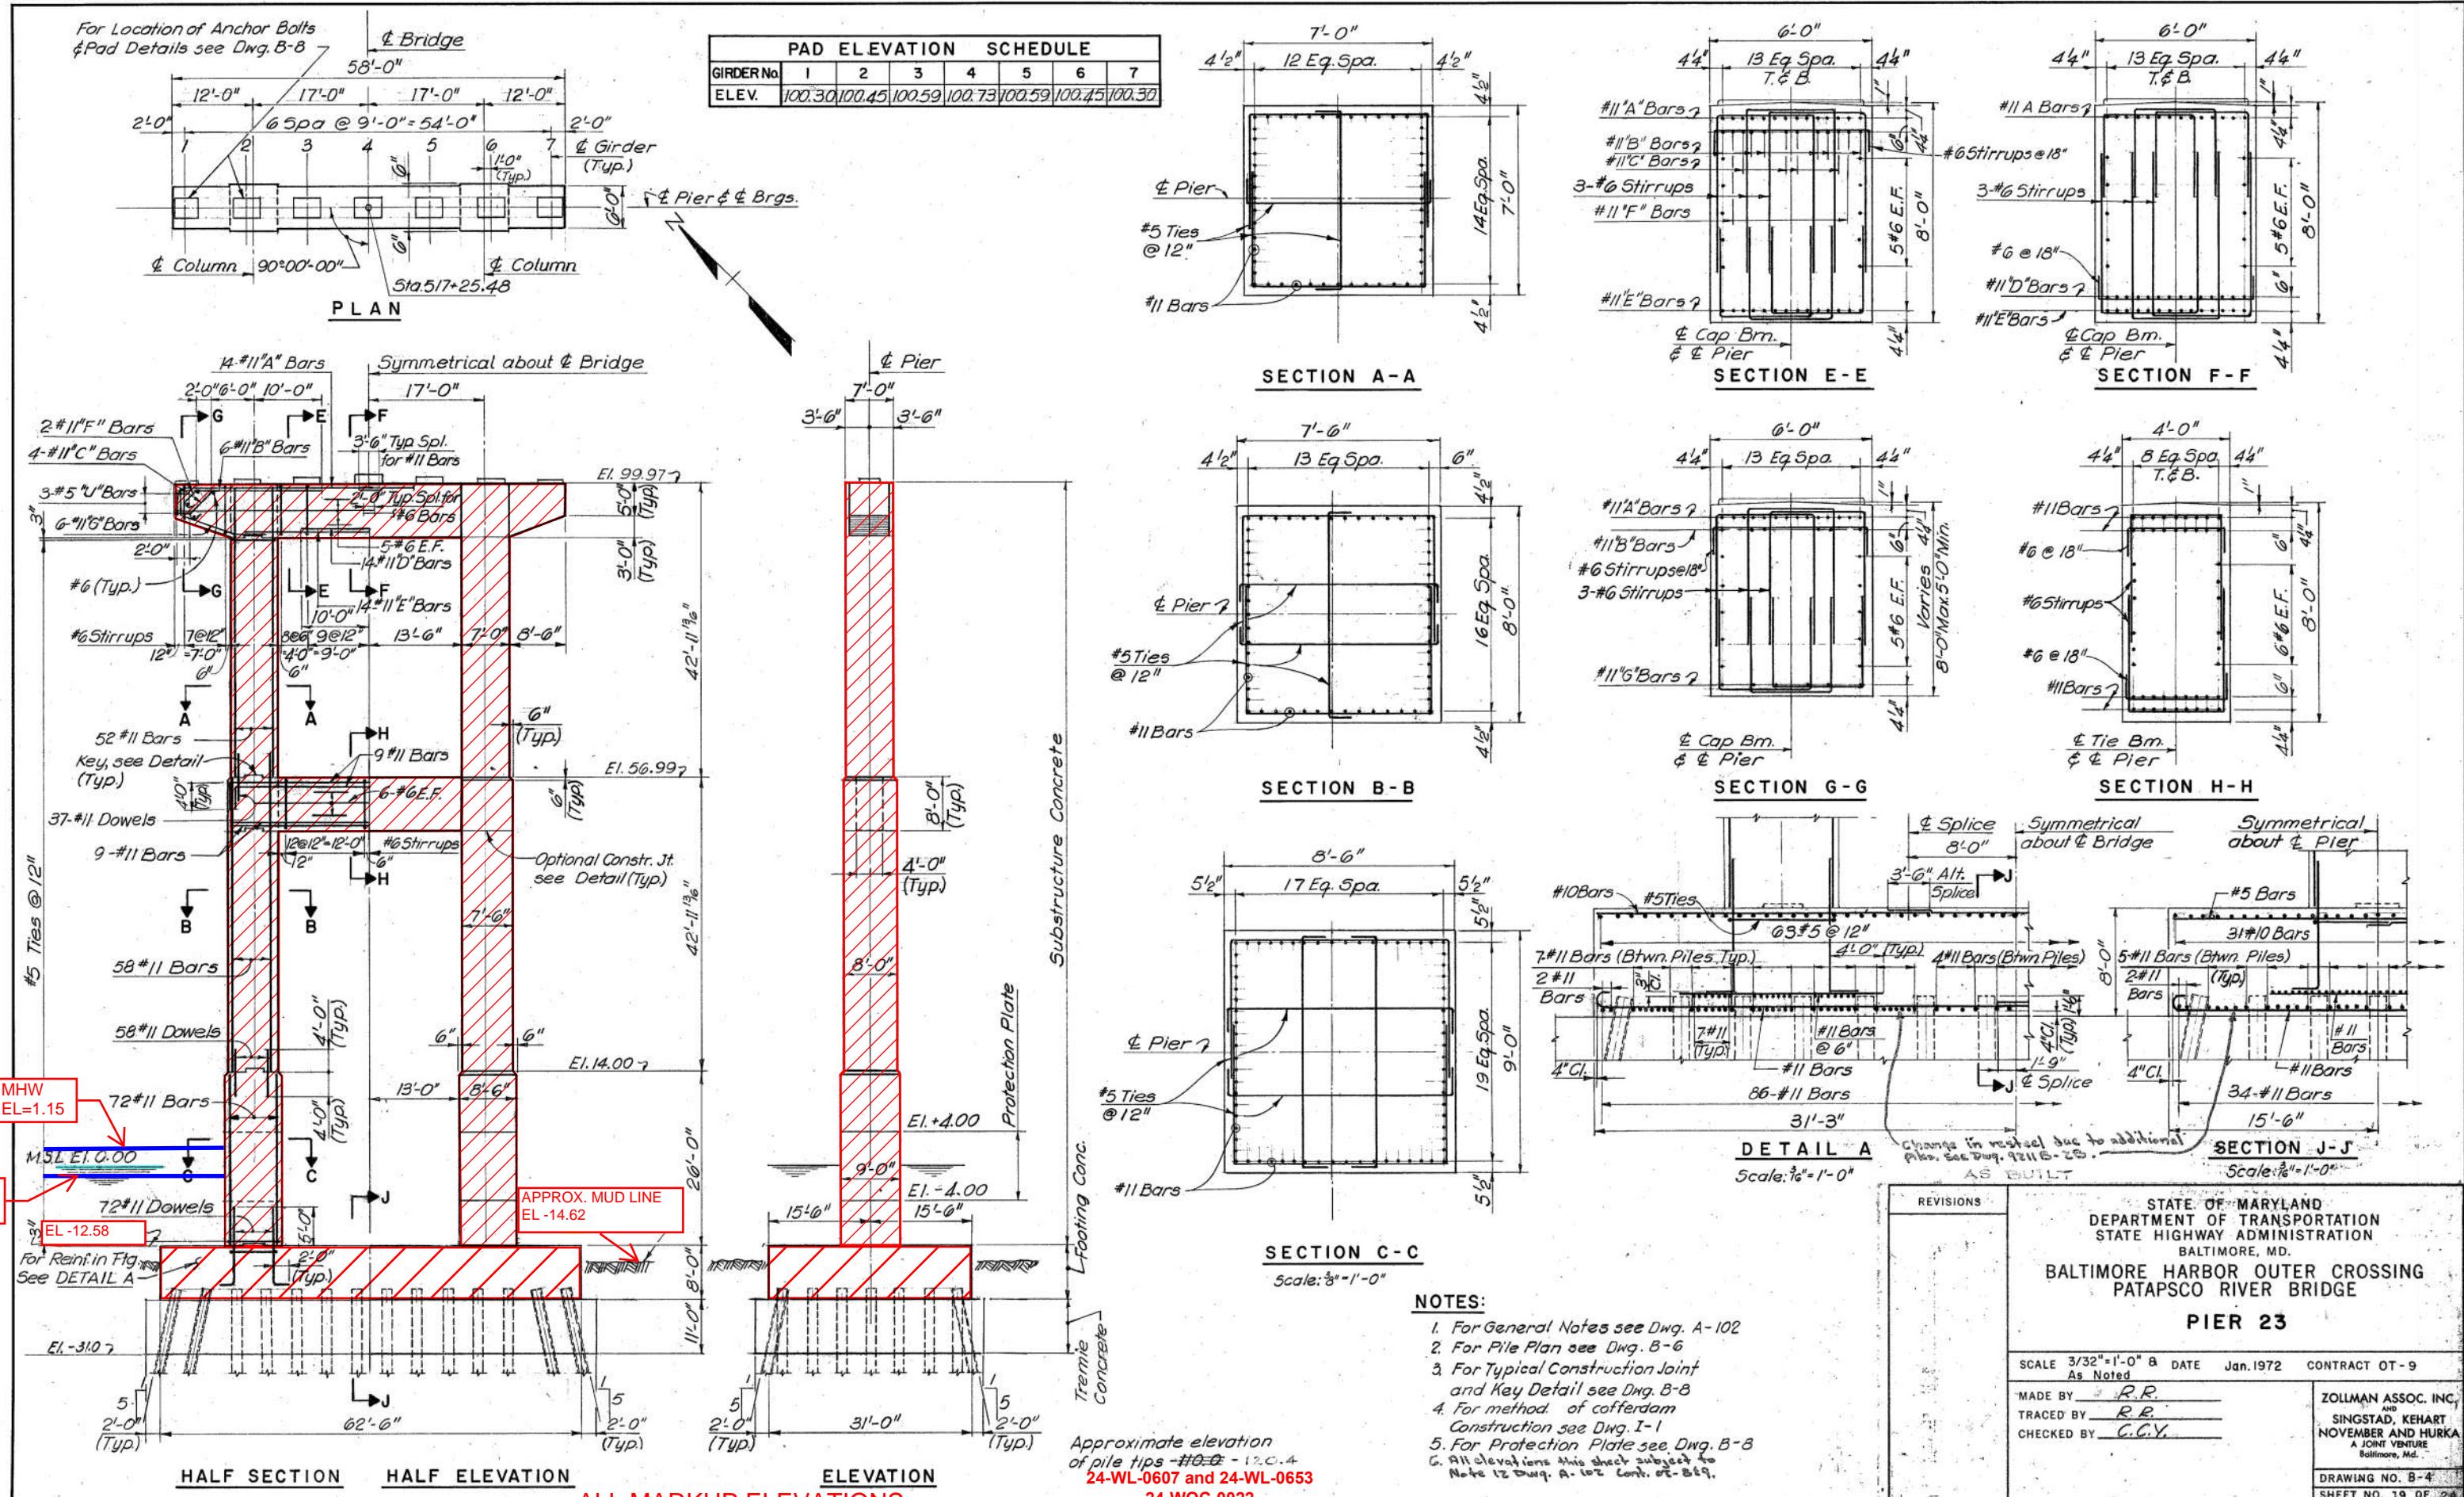


Approximate elevation
of pile tips - #10 - 12.0.4
24-WL-0607 and 24-WL-0653

24-WQC-0022


202460906


7/8/2024

43 of 45

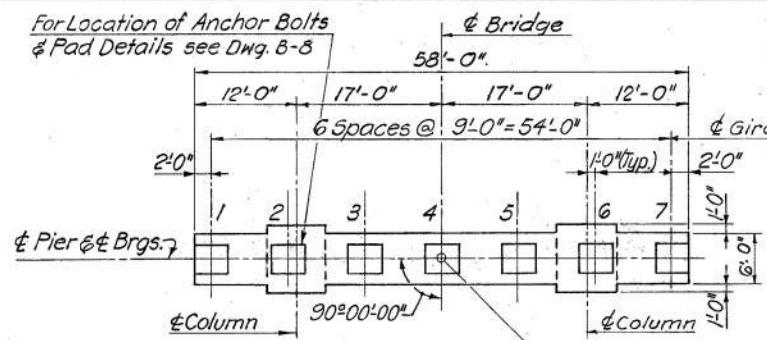

PAD ELEVATION SCHEDULE							
GIRDERO NO	1	2	3	4	5	6	7
ELEV.	88.37	88.51	88.65	88.79	88.65	88.51	88.37

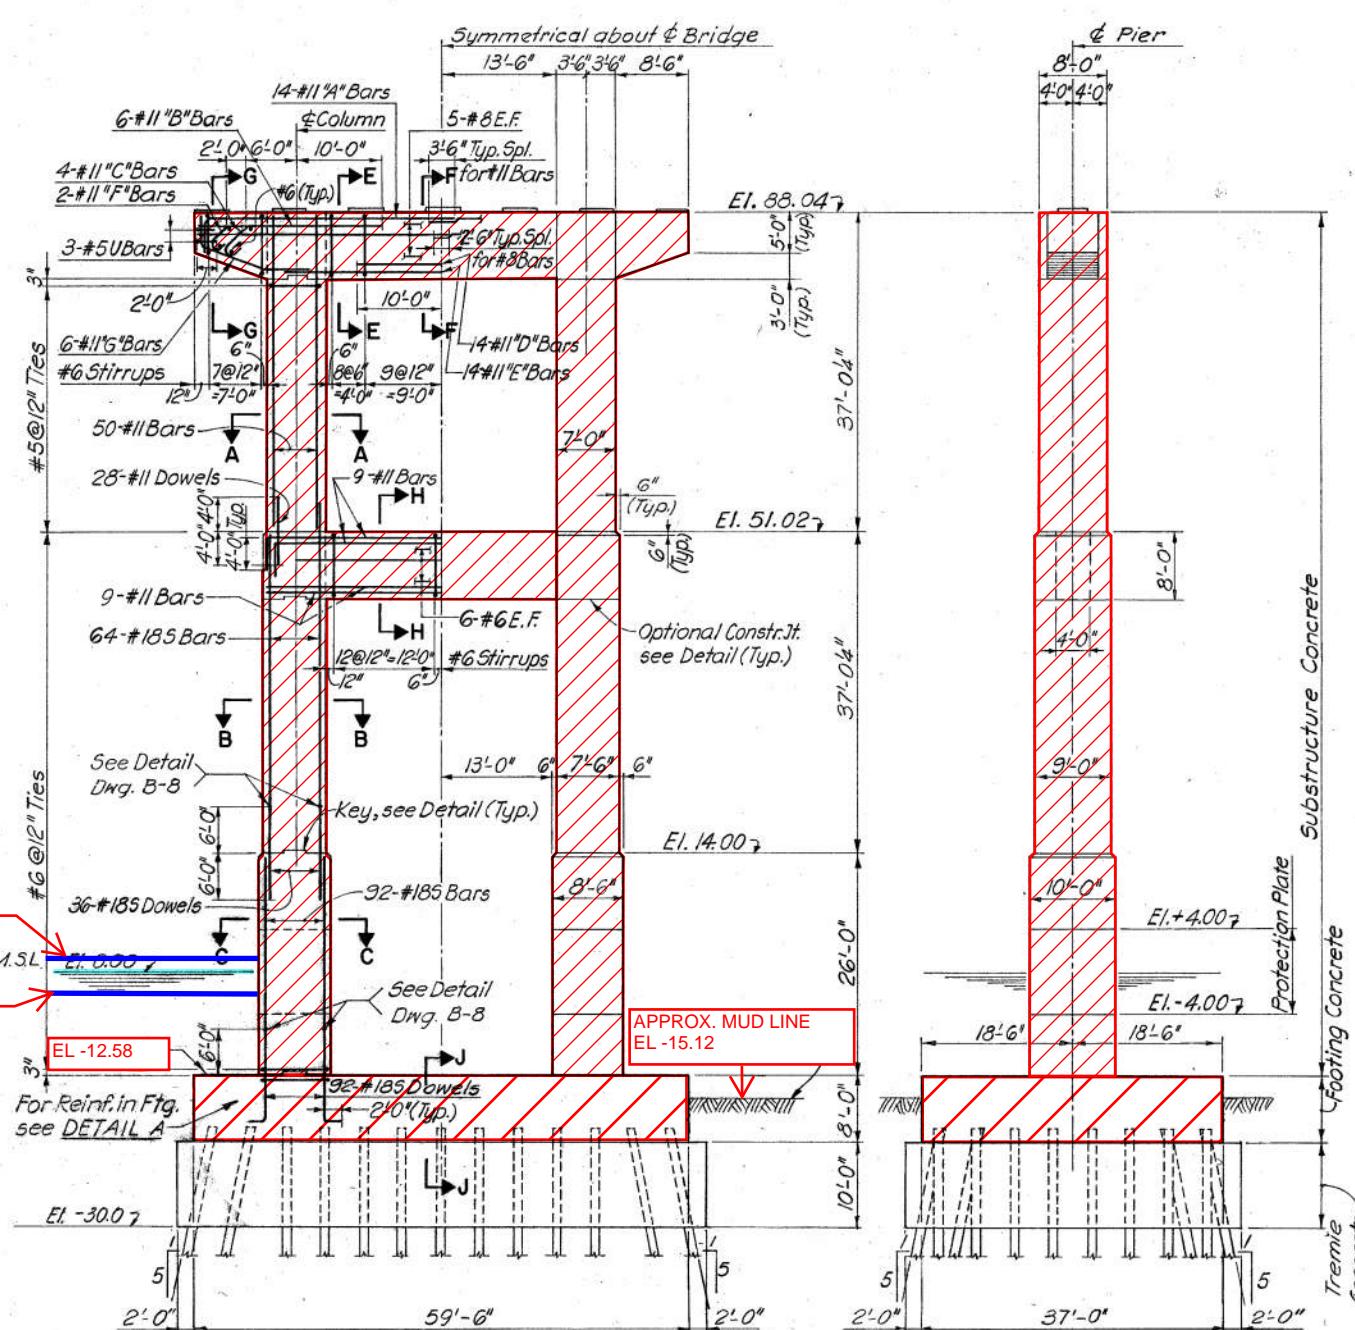

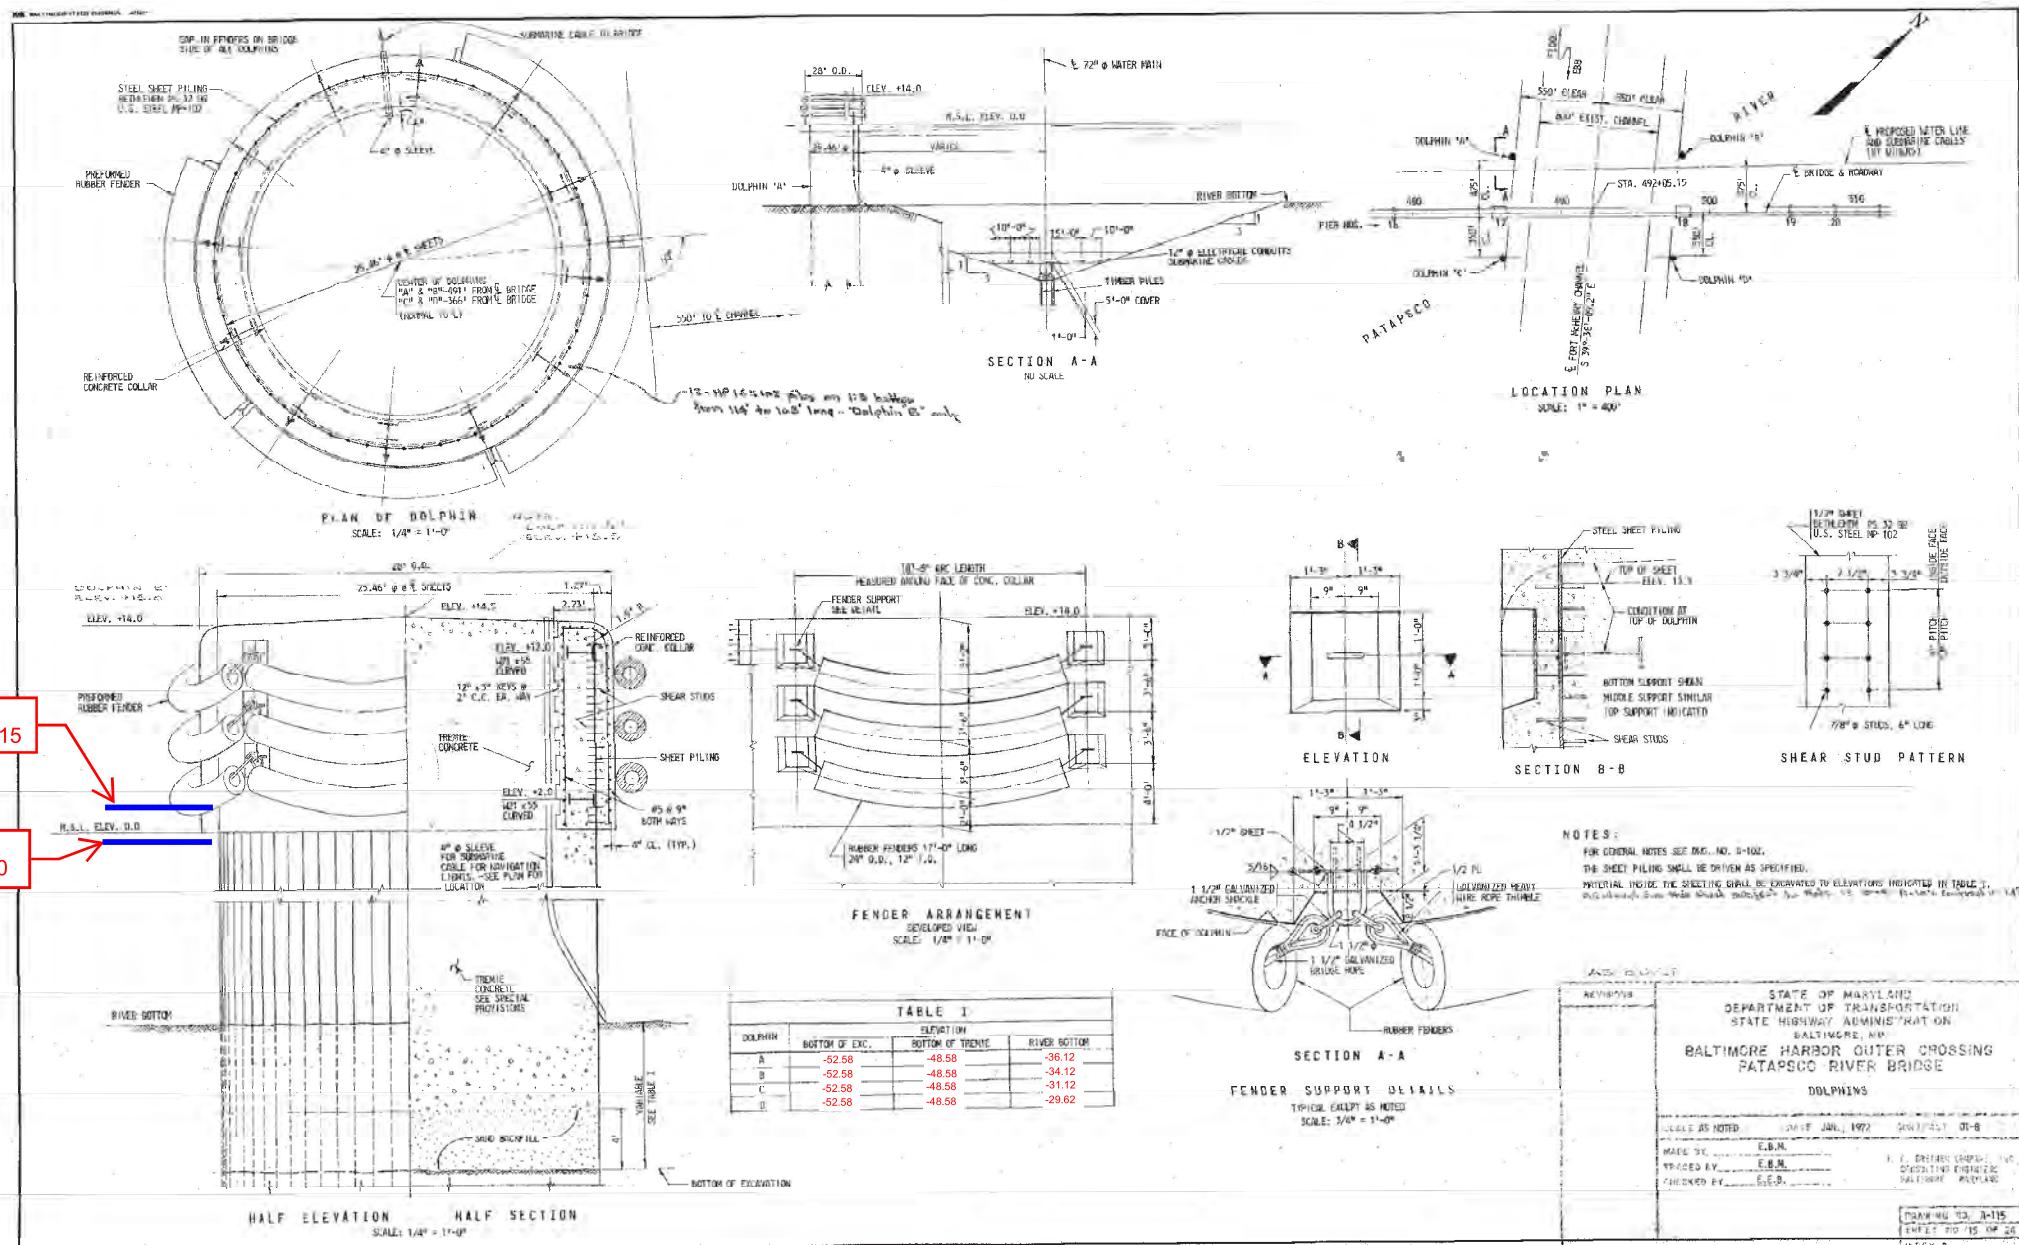

24-WL-0607 and 24-WL-0653
24-WQC-0022
202460906
7/8/2024

ALL MARKUP ELEVATIONS
RELATIVE TO MLW = 0.0